


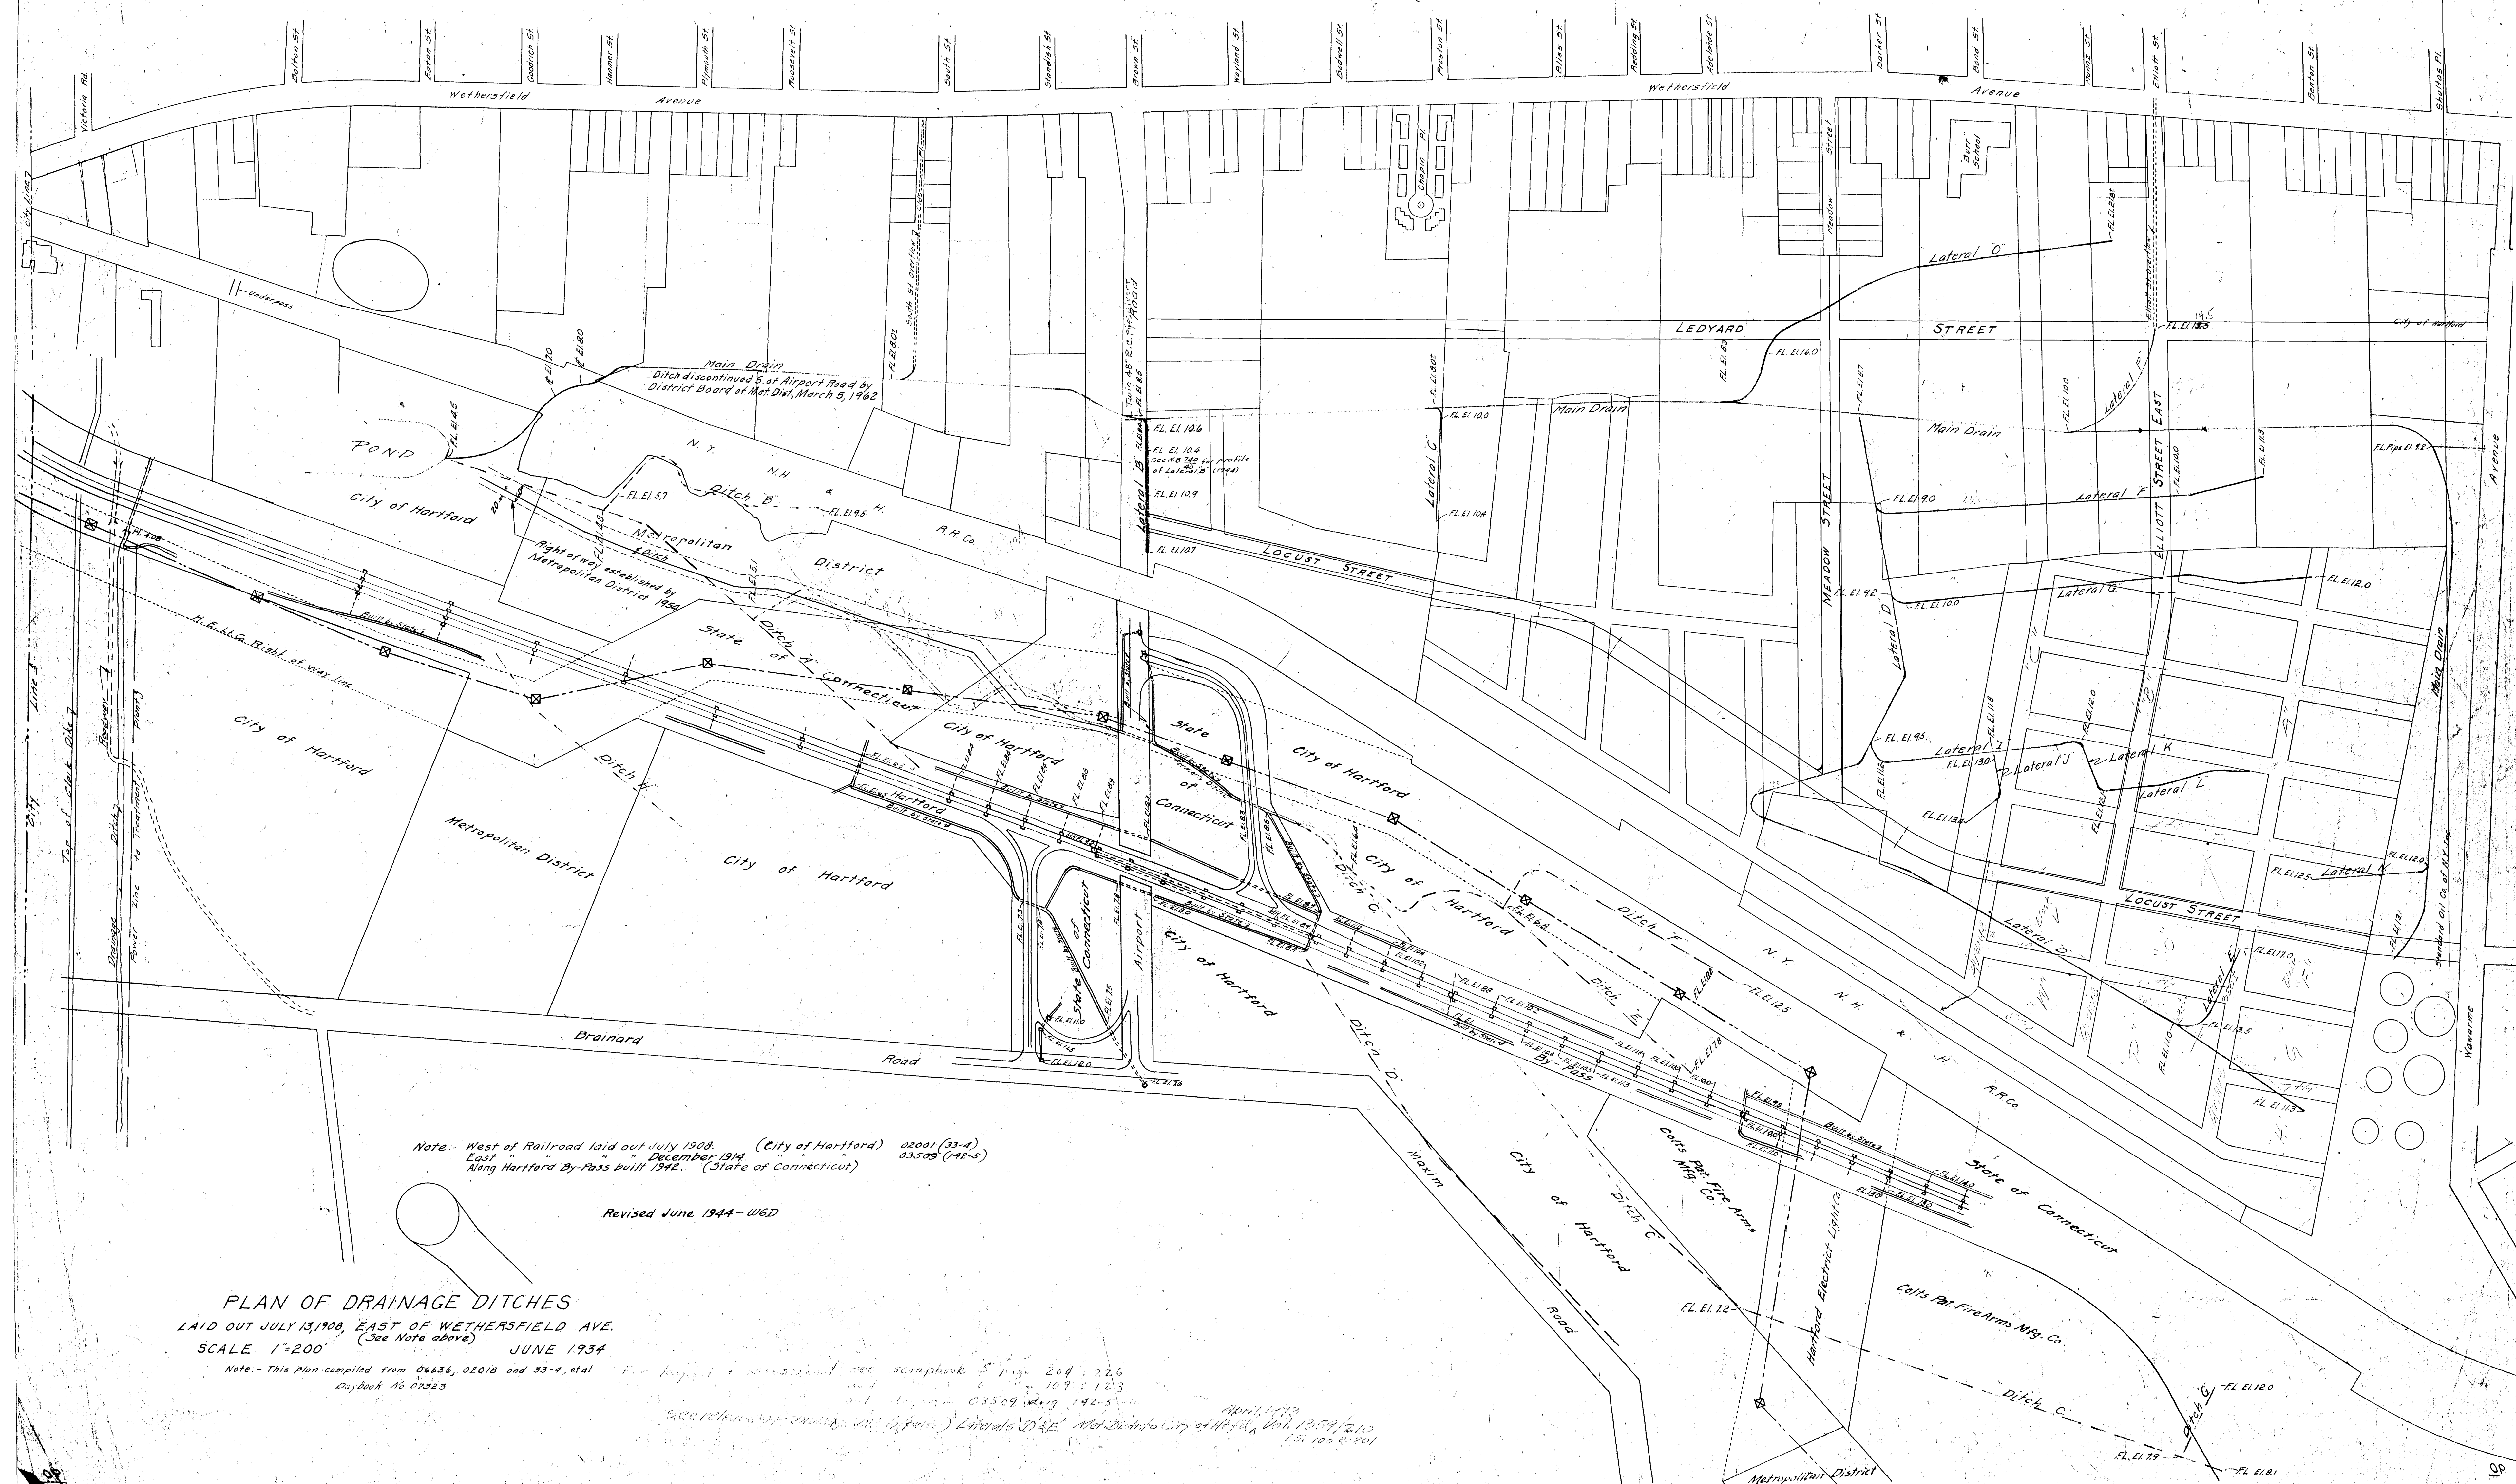

Note: West of Railroad laid out July 1908. (City of Hartford) 02001 (33-4)
East " " December 1914. 03509 (42-5)
Along Hartford By-Pass built 1942. (State of Connecticut)

Revised June 1944 - WGD

PLAN OF DRAINAGE DITCHES
LAID OUT JULY 13, 1908, EAST OF WETHERSFIELD AVE.
SCALE 1"=200' (See Note above) JUNE 1934

Note: This plan compiled from 02636, 02018 and 33-4, et al
Citybook No 07323

See plan of drainage ditches (from) Lateral D & E Met Dist to City of Hartford Vol. 1359/210
April 1973
FL 100 & 201