


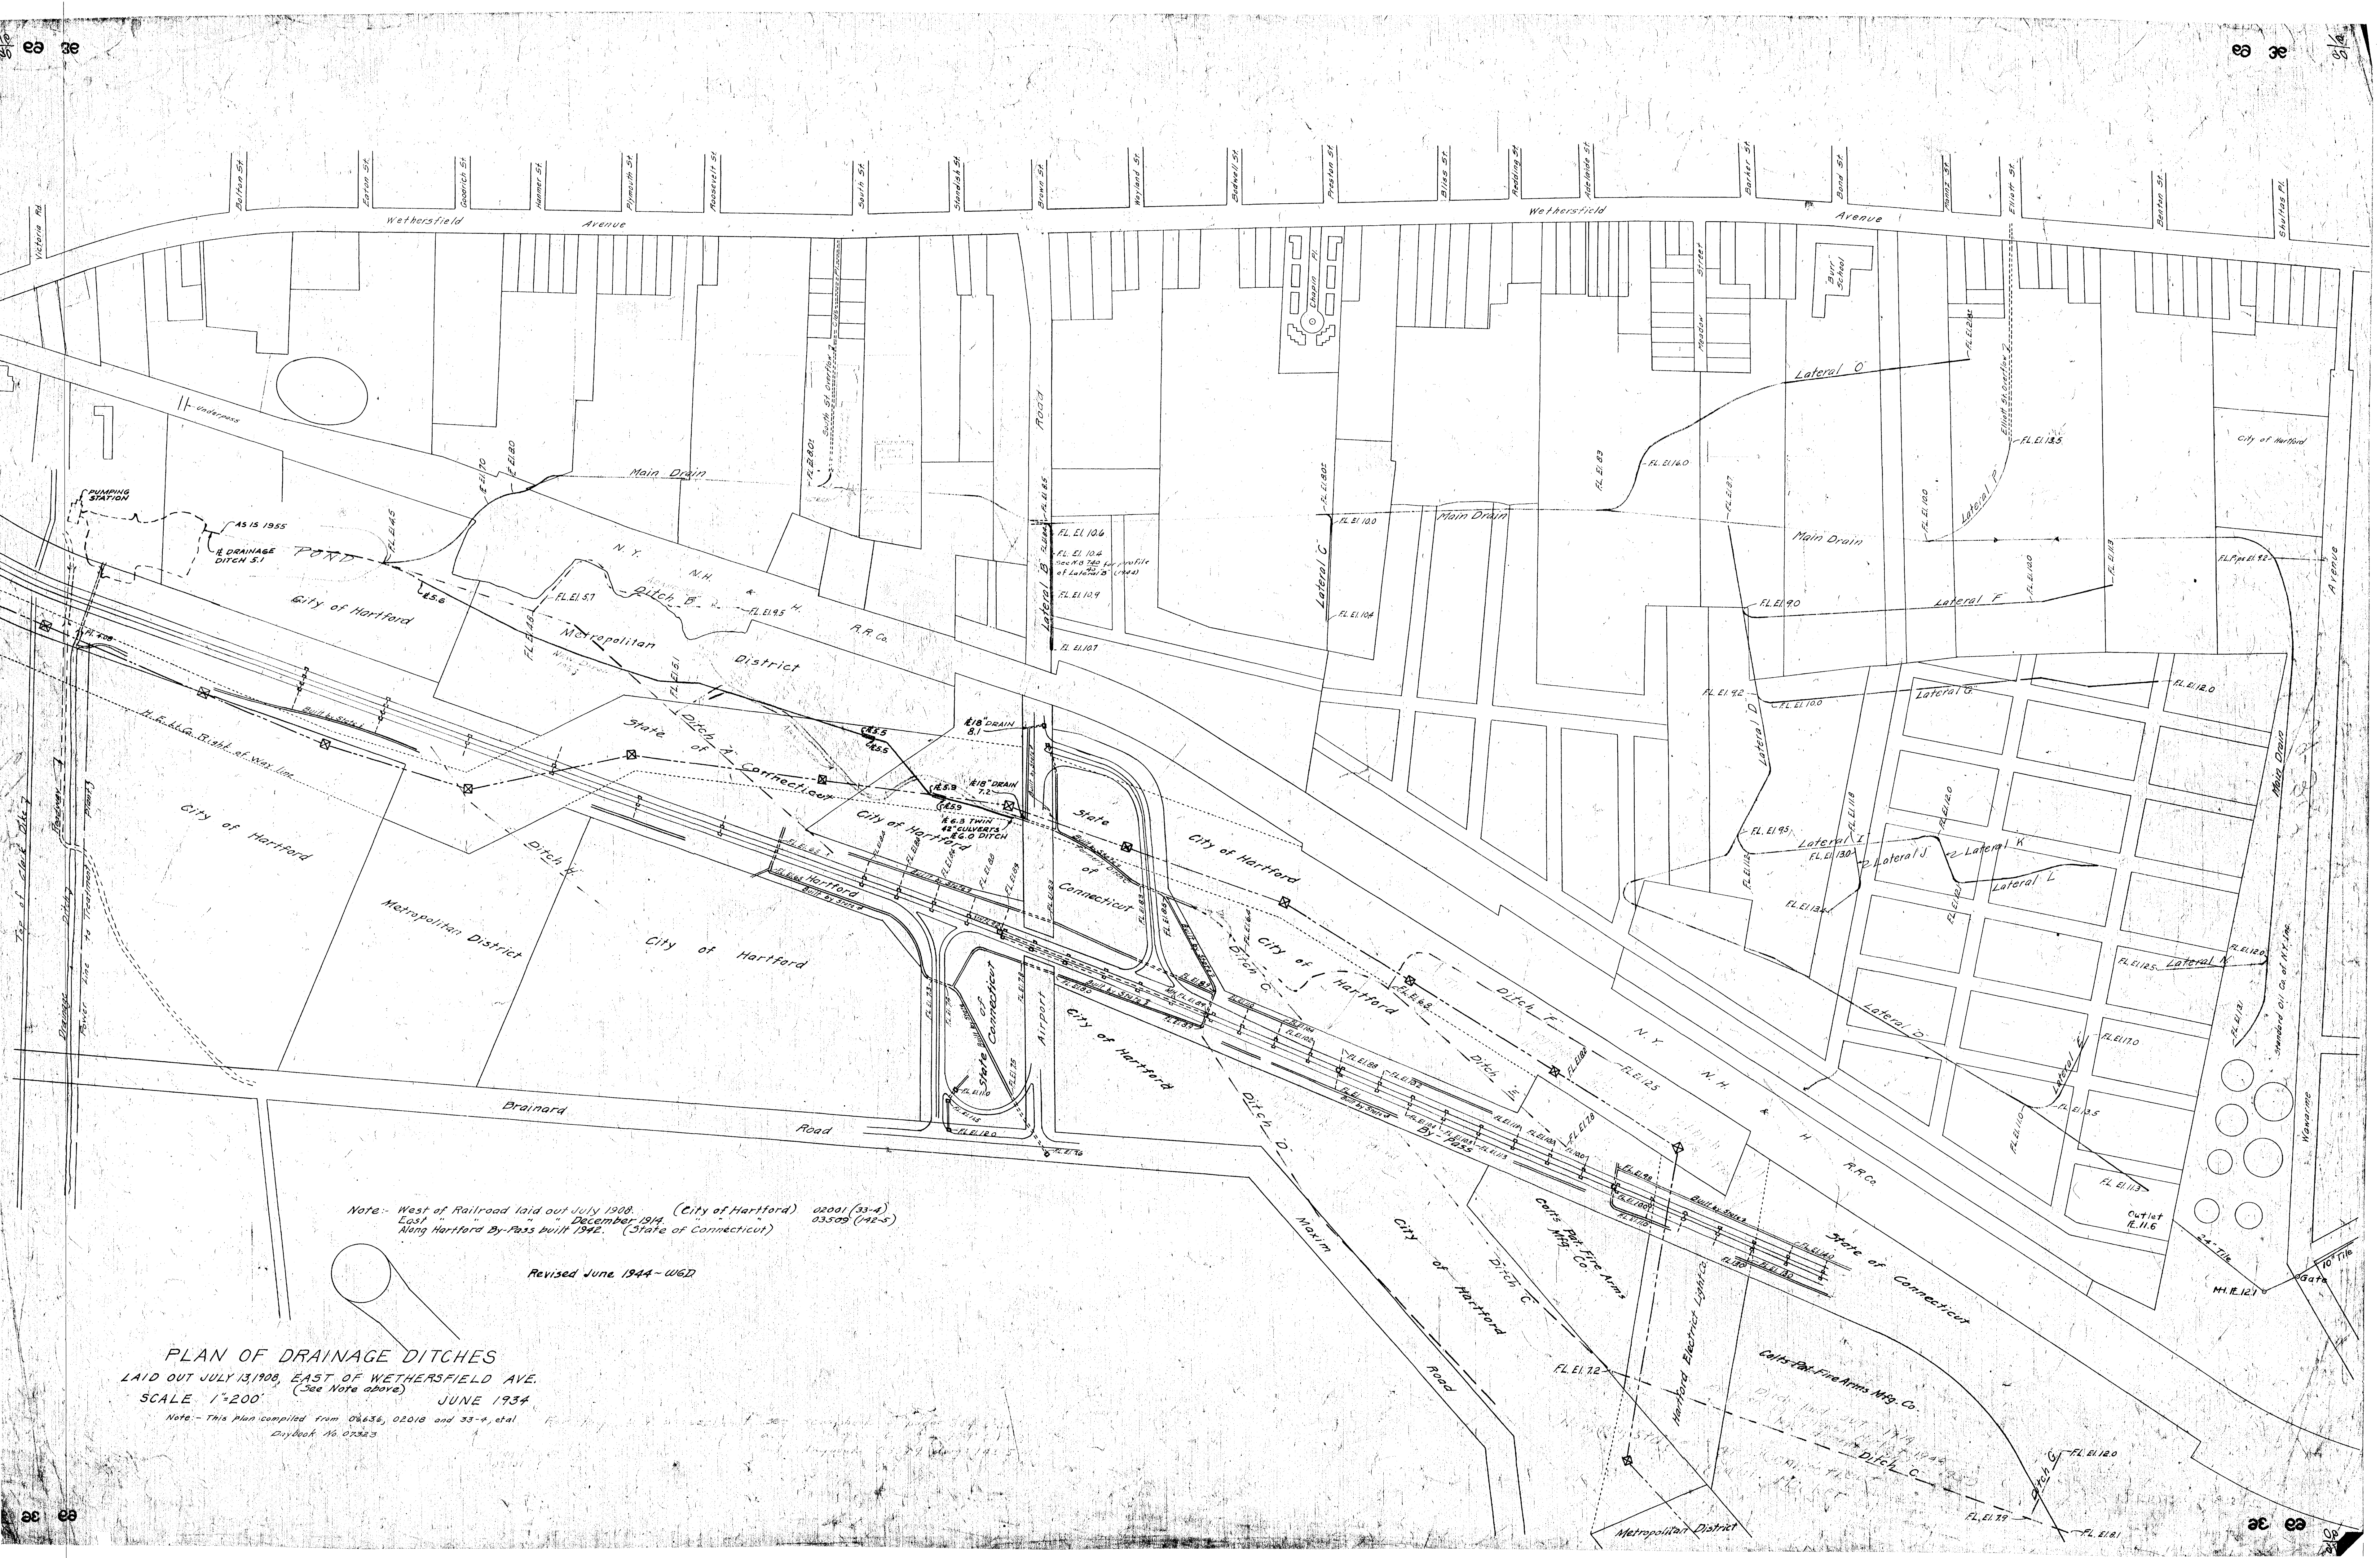

Note: West of Railroad laid out July 1908. (City of Hartford) 02001 (33-4)
East " " " " December 1914. 03509 (142-5)
Along Hartford By-Pass built 1942. (State of Connecticut)

Revised June 1944-WGD

PLAN OF DRAINAGE DITCHES
LAID OUT JULY 13/1908, EAST OF WETHERSFIELD AVE.
SCALE 1"=200' (See Note above) JUNE 1934

Note: This Plan compiled from 04634, 02018 and 33-4, et al.
Daybook 16 07323