


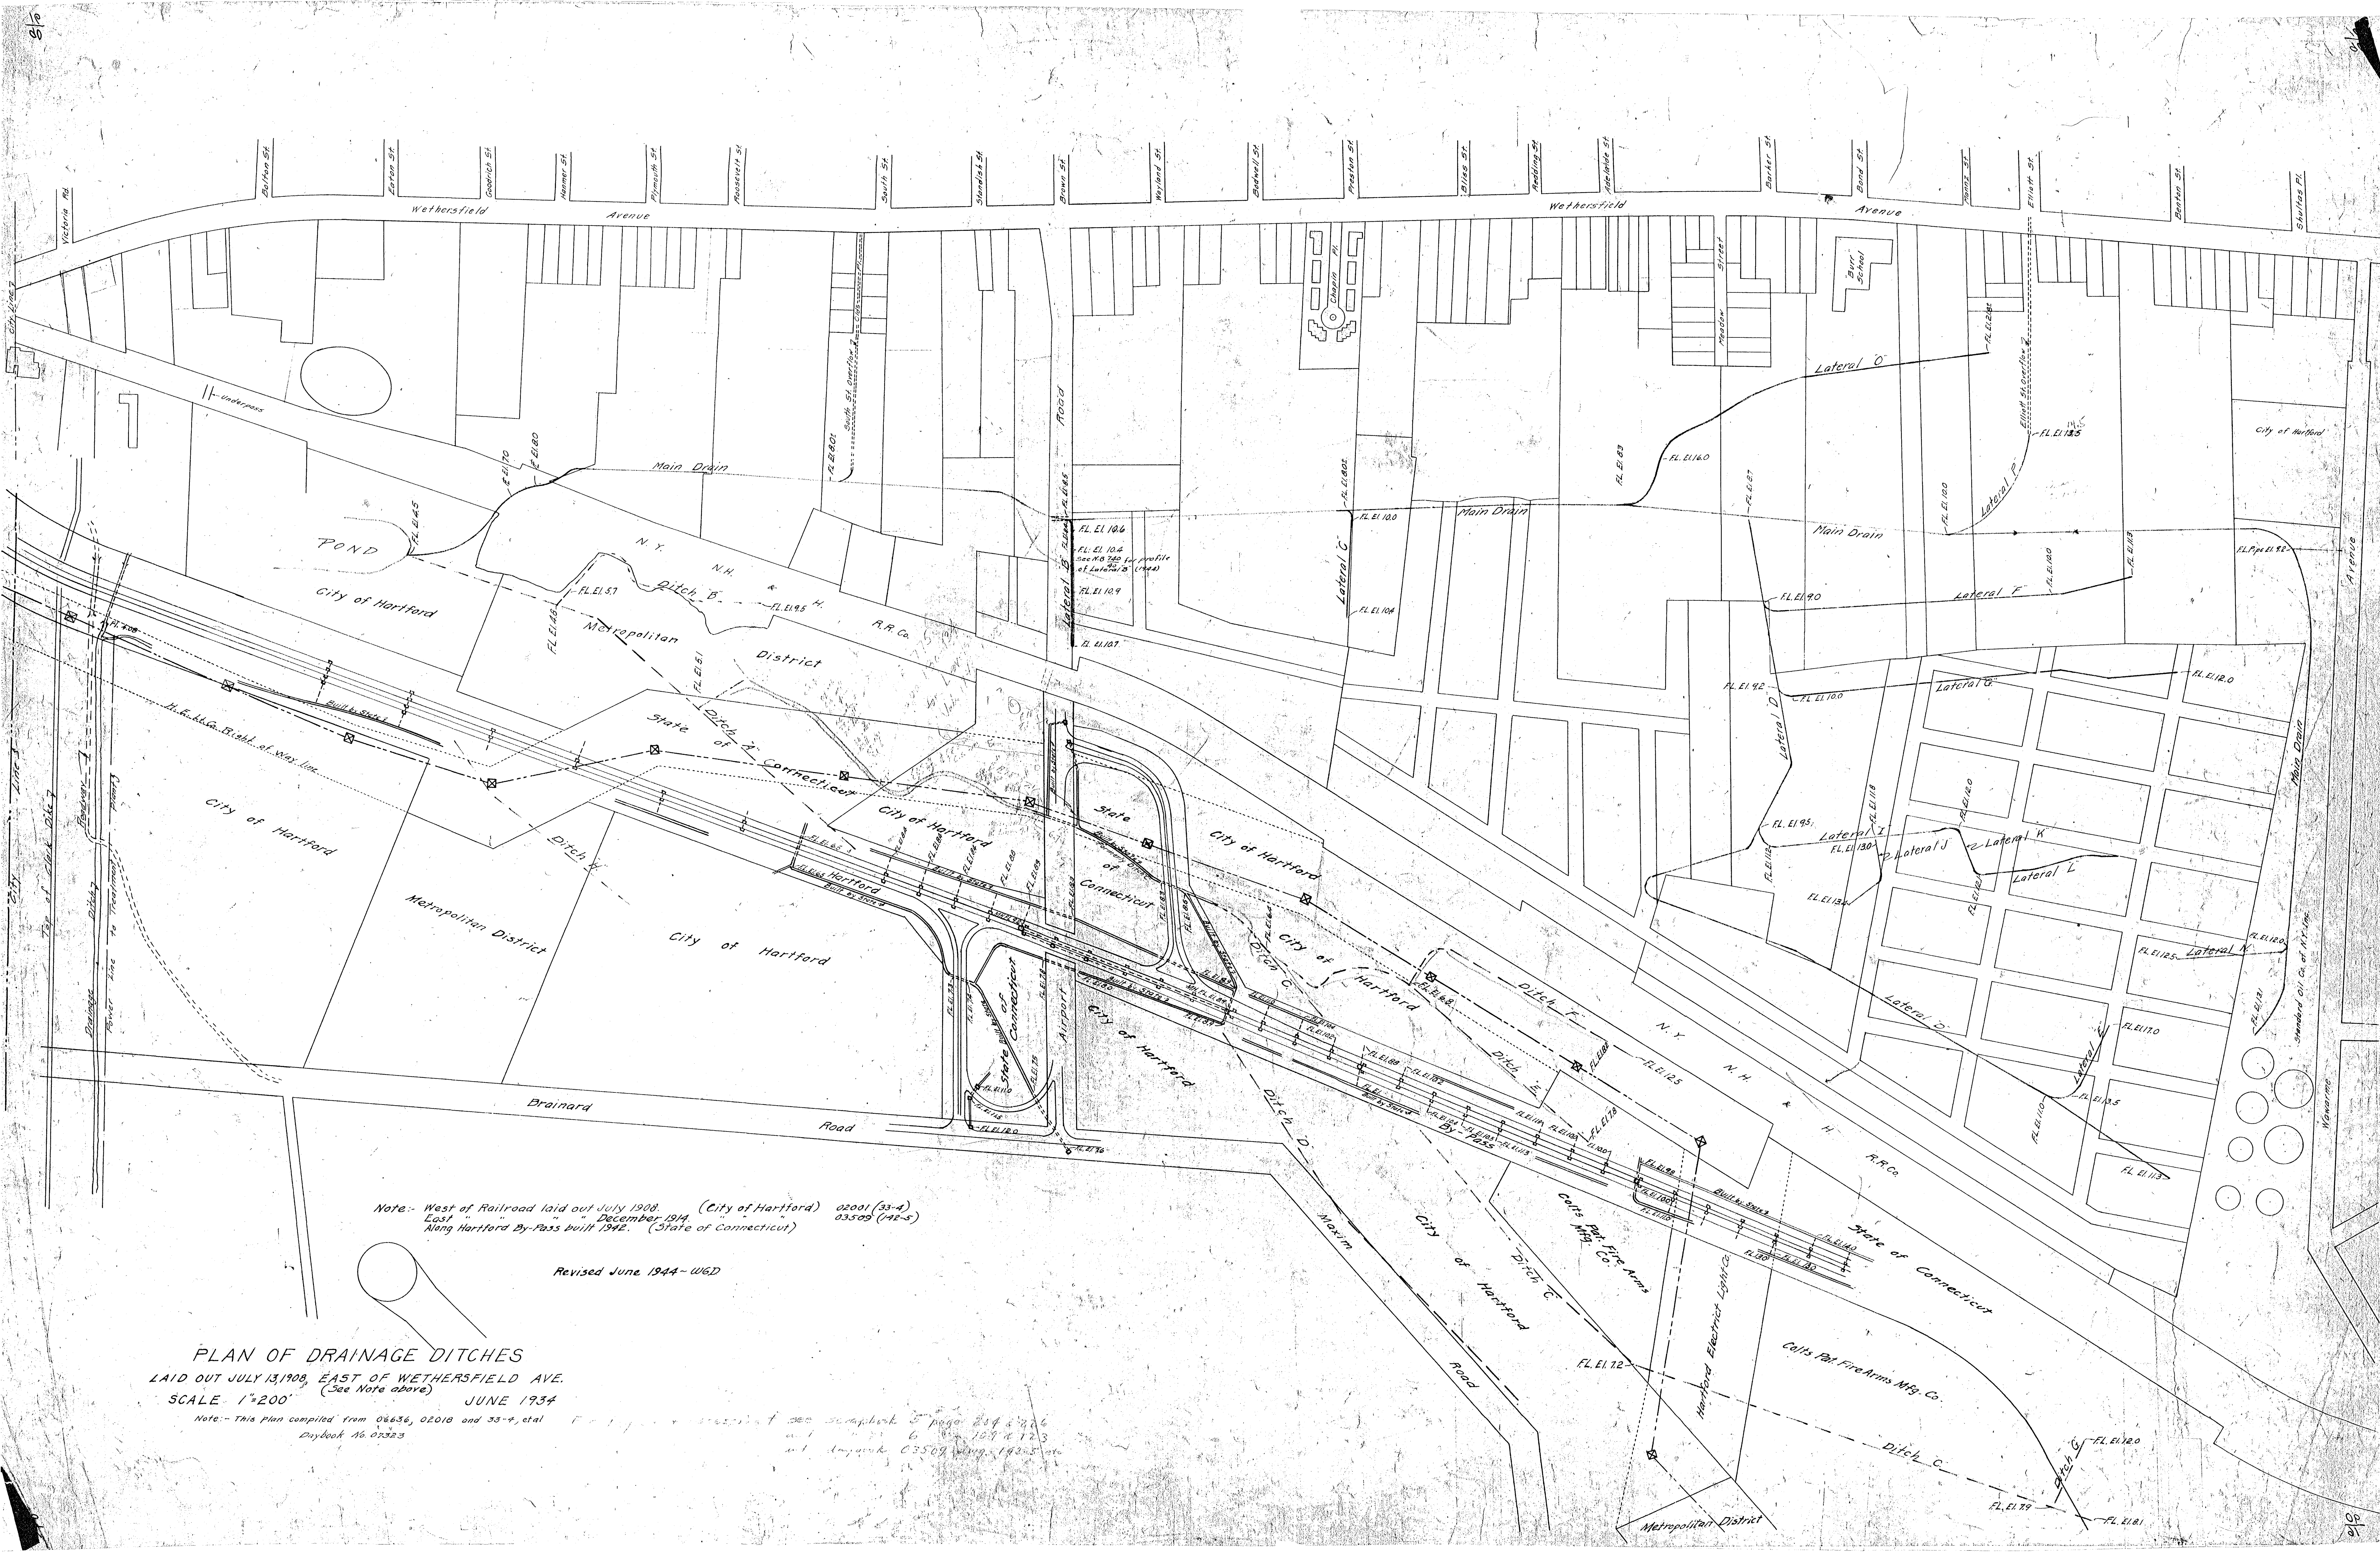

Note: West of Railroad laid out July 1908. (City of Hartford) 02001 (33-4)
East " " " " December 1914. 03509 (142-5)
Along Hartford By-Pass built 1942. (State of Connecticut)

Revised June 1944-WGD

PLAN OF DRAINAGE DITCHES
LAID OUT JULY 13, 1908, EAST OF WETHERSFIELD AVE.
(See Note above)
SCALE 1"=200' JUNE 1934

Note: This plan compiled from 06636, 02010 and 33-4, et al
Daybook No. 07323
See scrapbook page 254 & 256
and 1934 & 1935
and Daybook 03509, June 1934 & 1935