


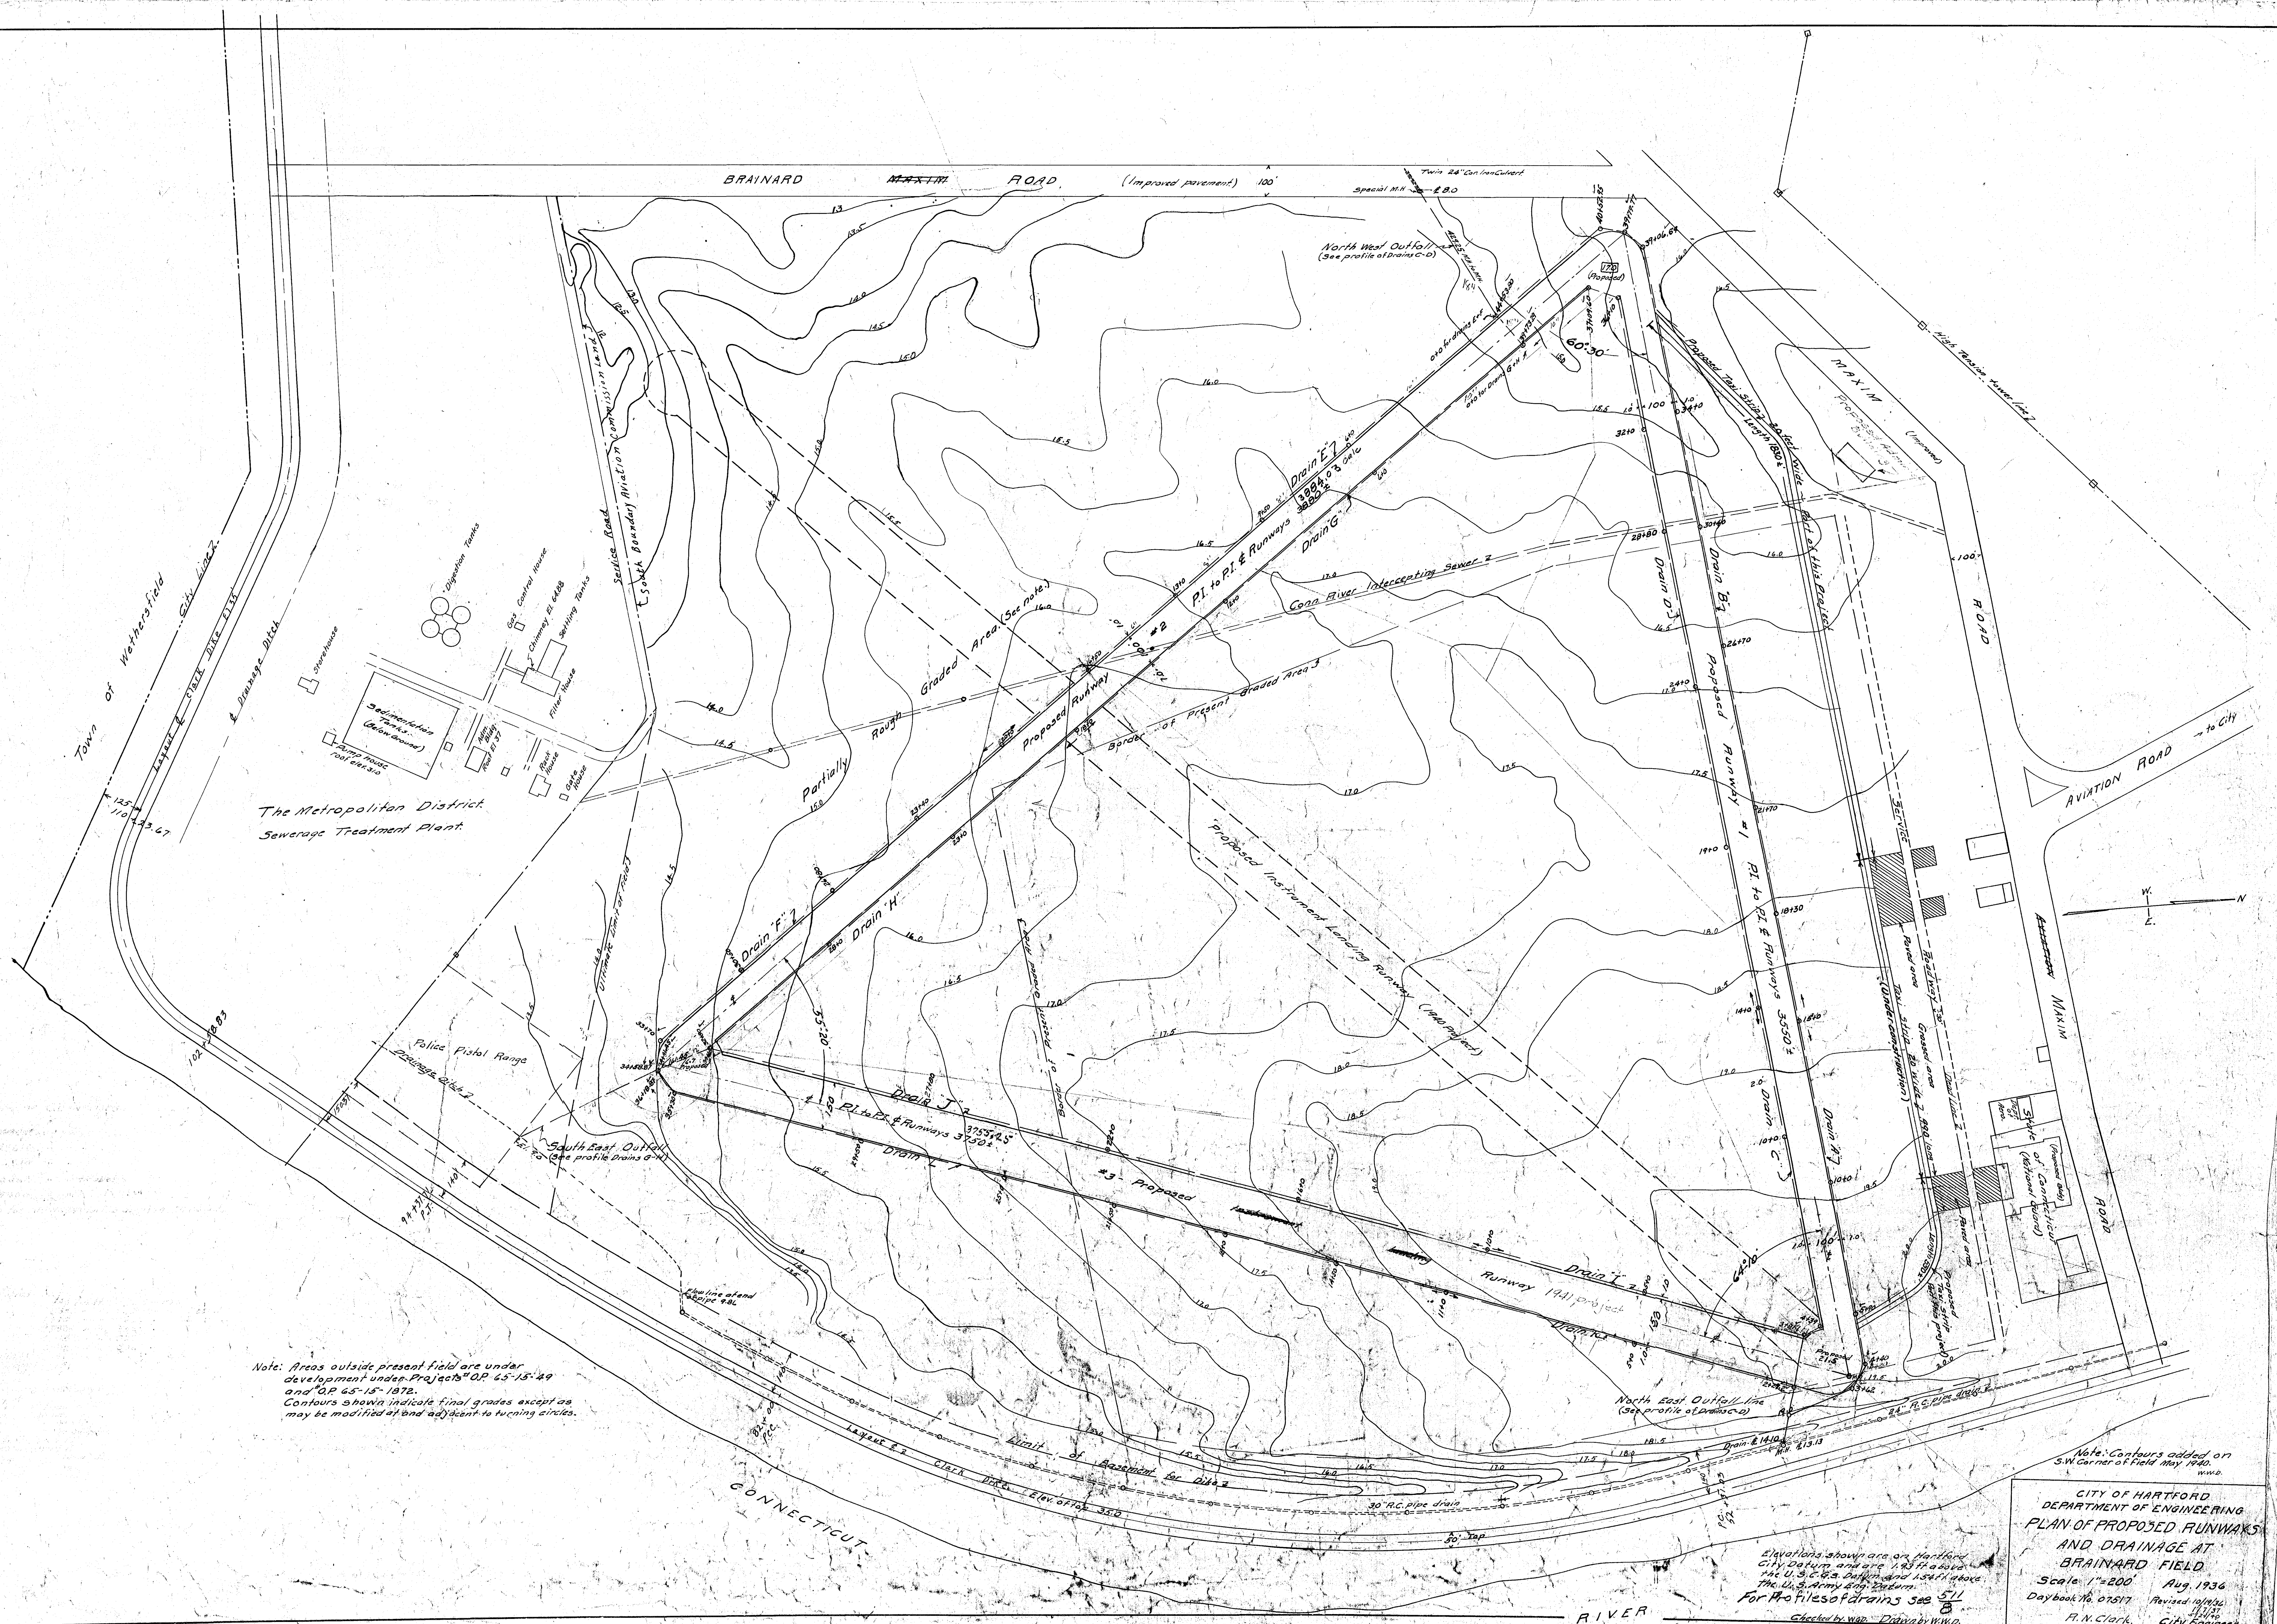

Note: Areas outside present field are under development under Projects O.P. 65-15-49 and O.P. 65-15-1872. Contours shown indicate final grades except as may be modified at and adjacent to turning circles.

Note: Contours added on SW corner of field May 1940.

Elevations shown are on Hartford City Datum and are 1.23 ft above the U.S.C. & G.S. Datum and 1.54 ft above the U.S. Army 800 Datum. For Profiles of drains see 511.

CITY OF HARTFORD
DEPARTMENT OF ENGINEERING
PLAN OF PROPOSED RUNWAYS
AND DRAINAGE AT
BRAINERD FIELD
Scale: 1"=200'
Aug. 1936
Daybook No. 07517
R. N. Clark, City Engineer