
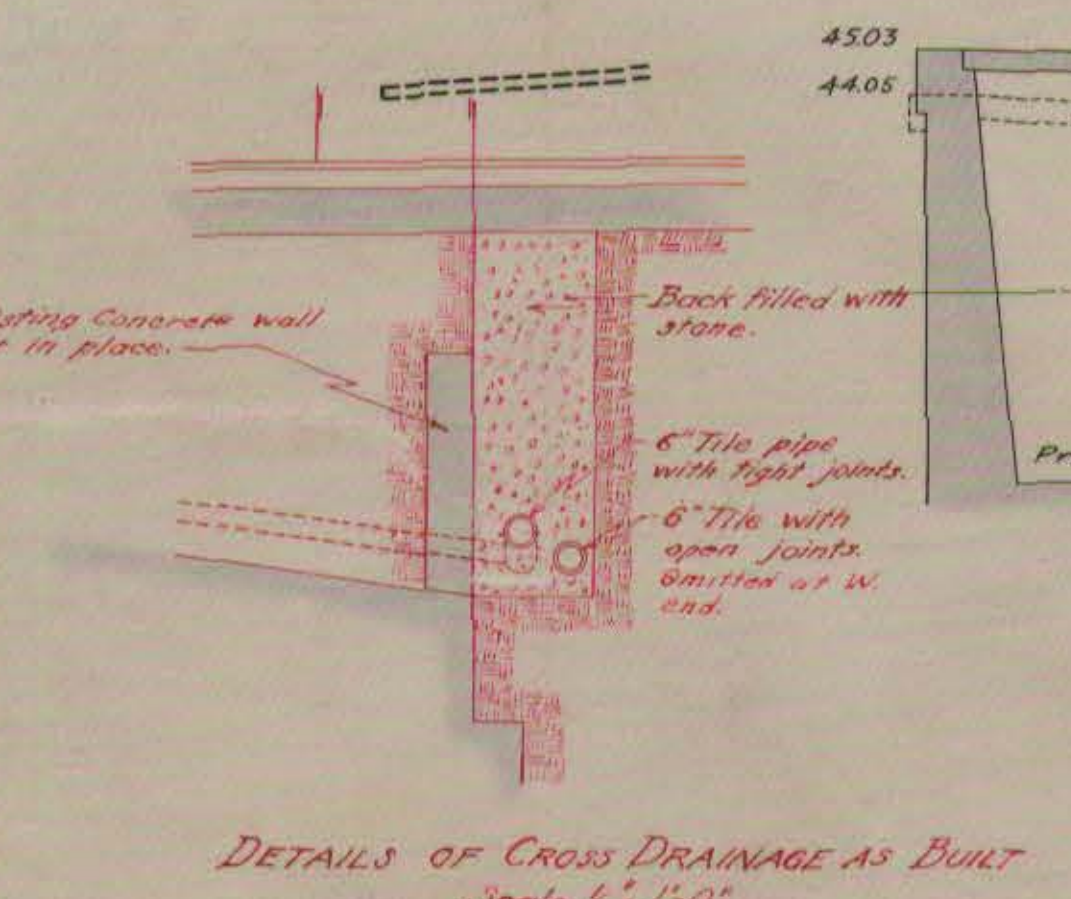
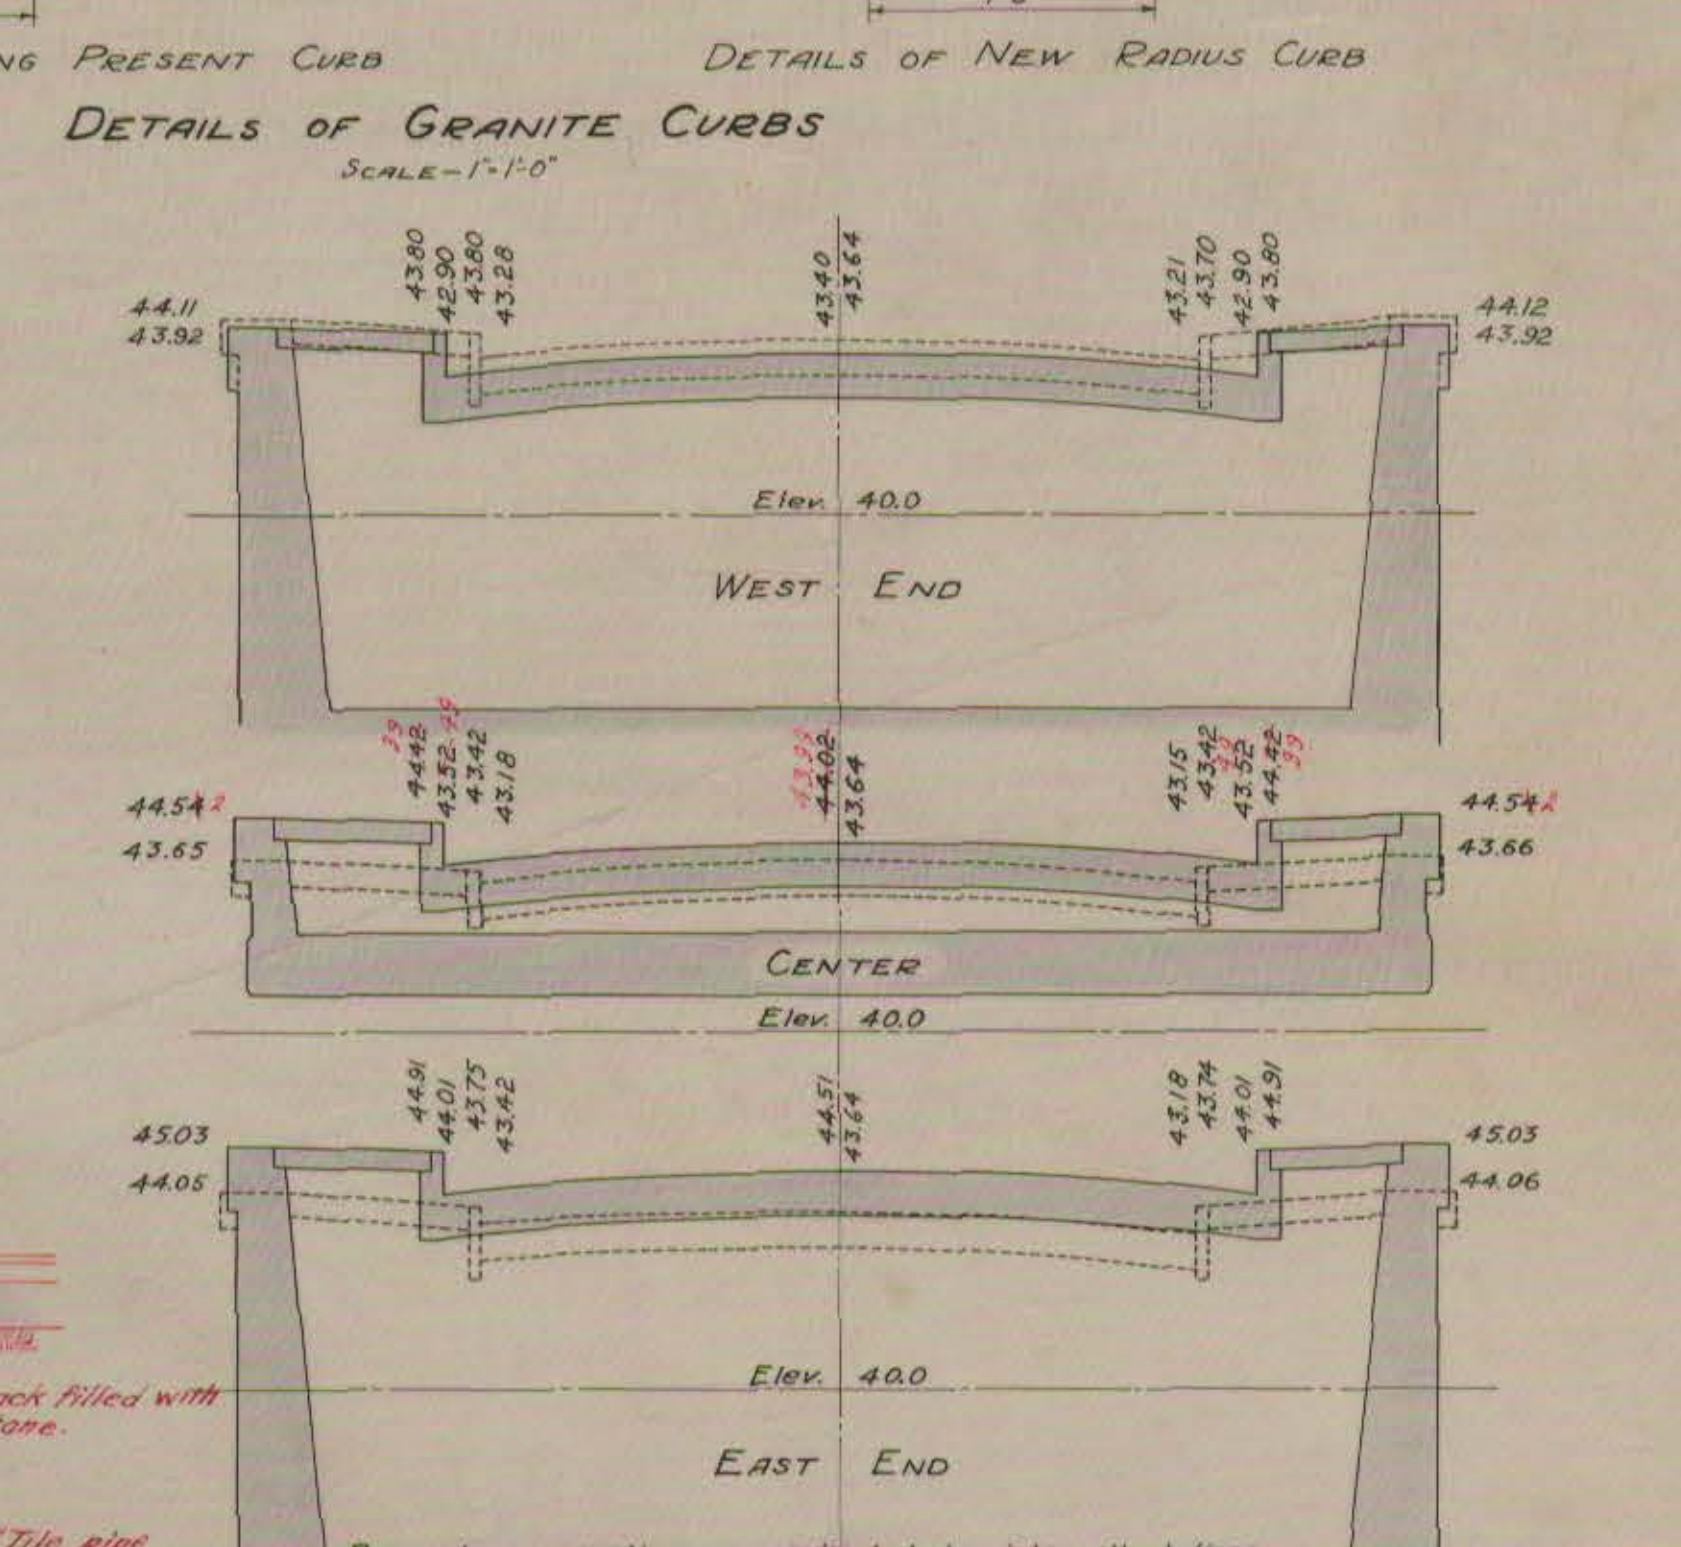
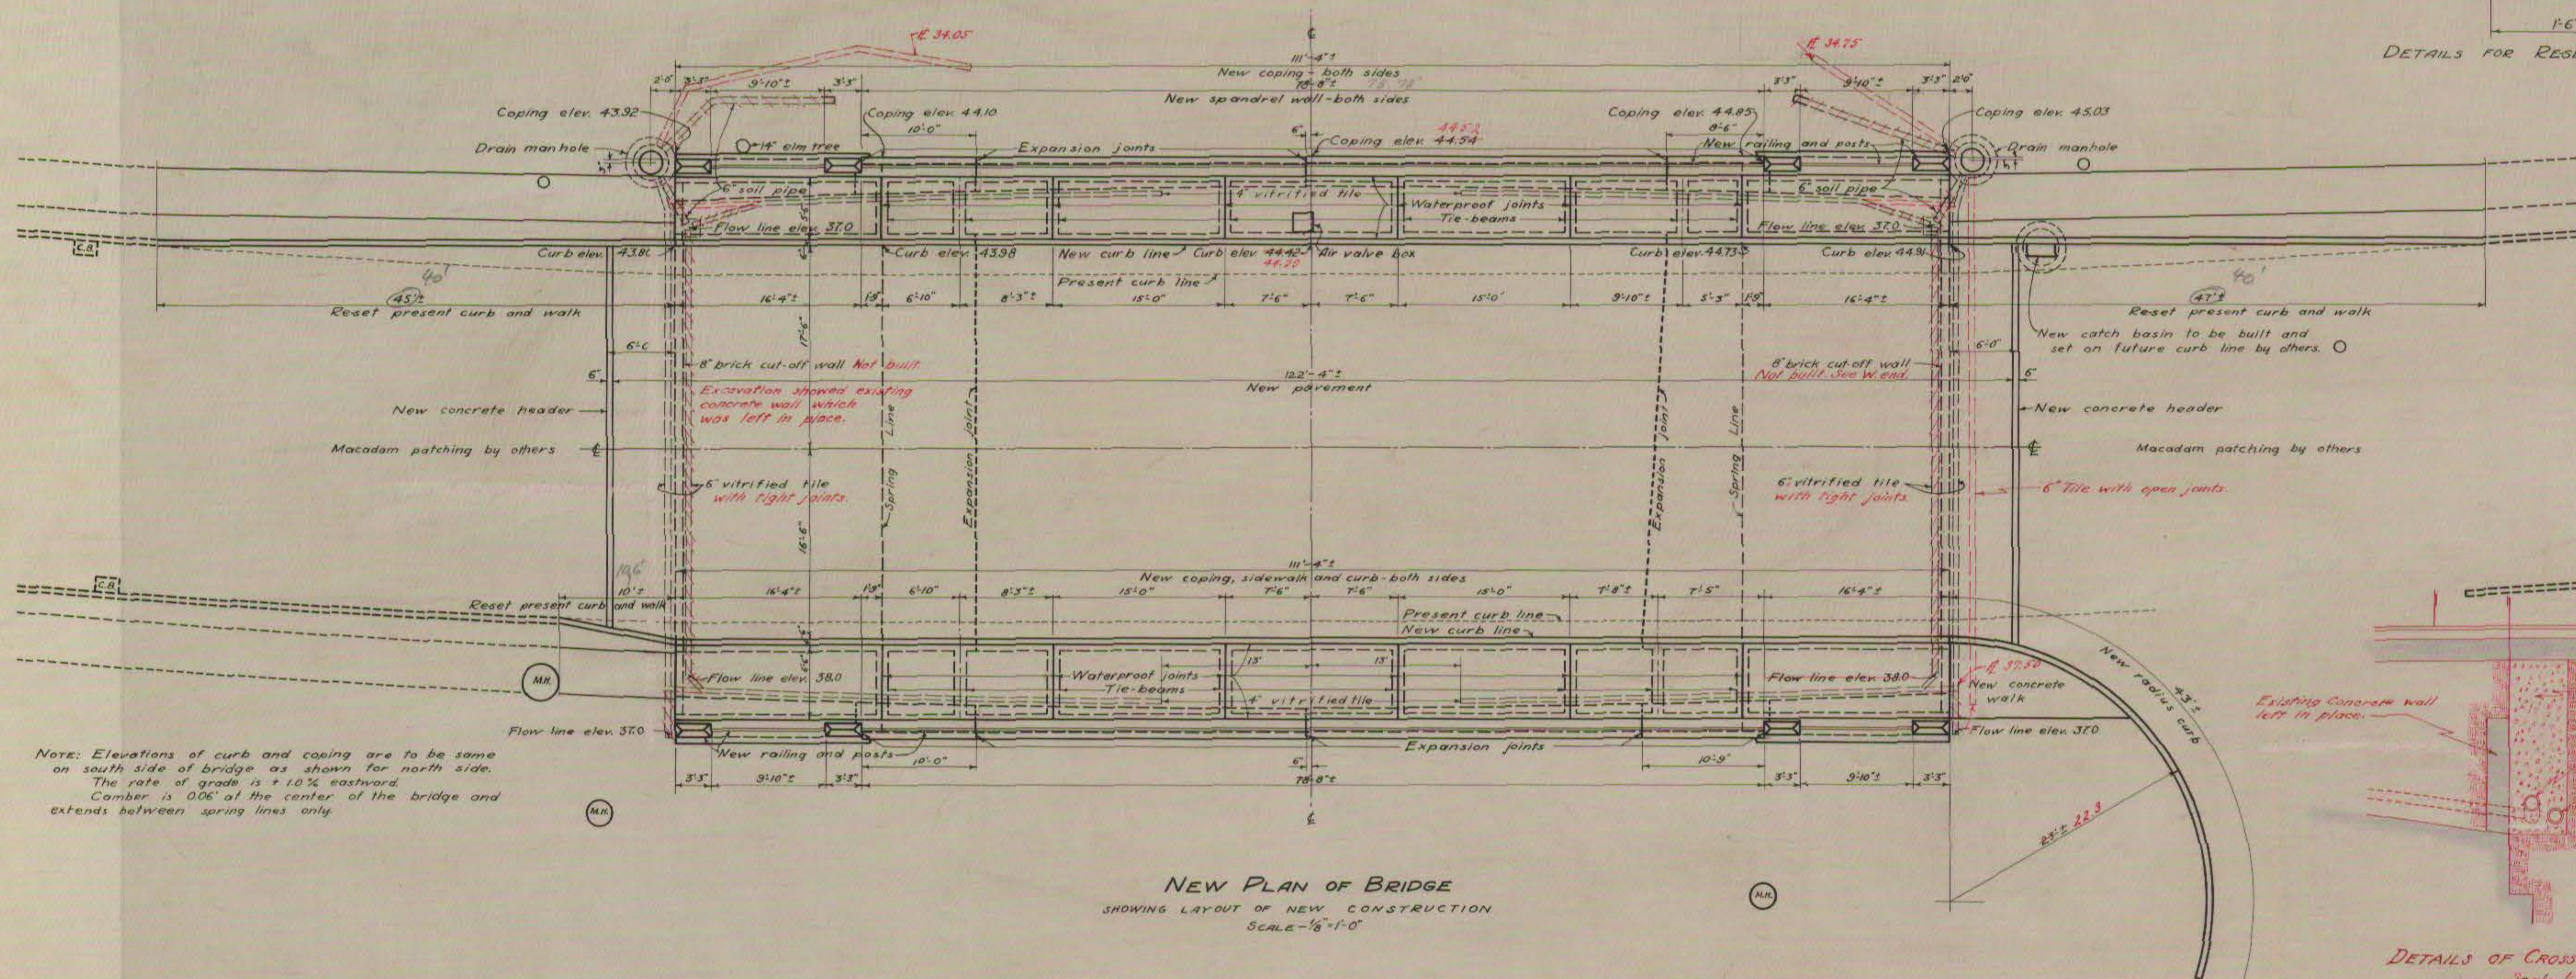
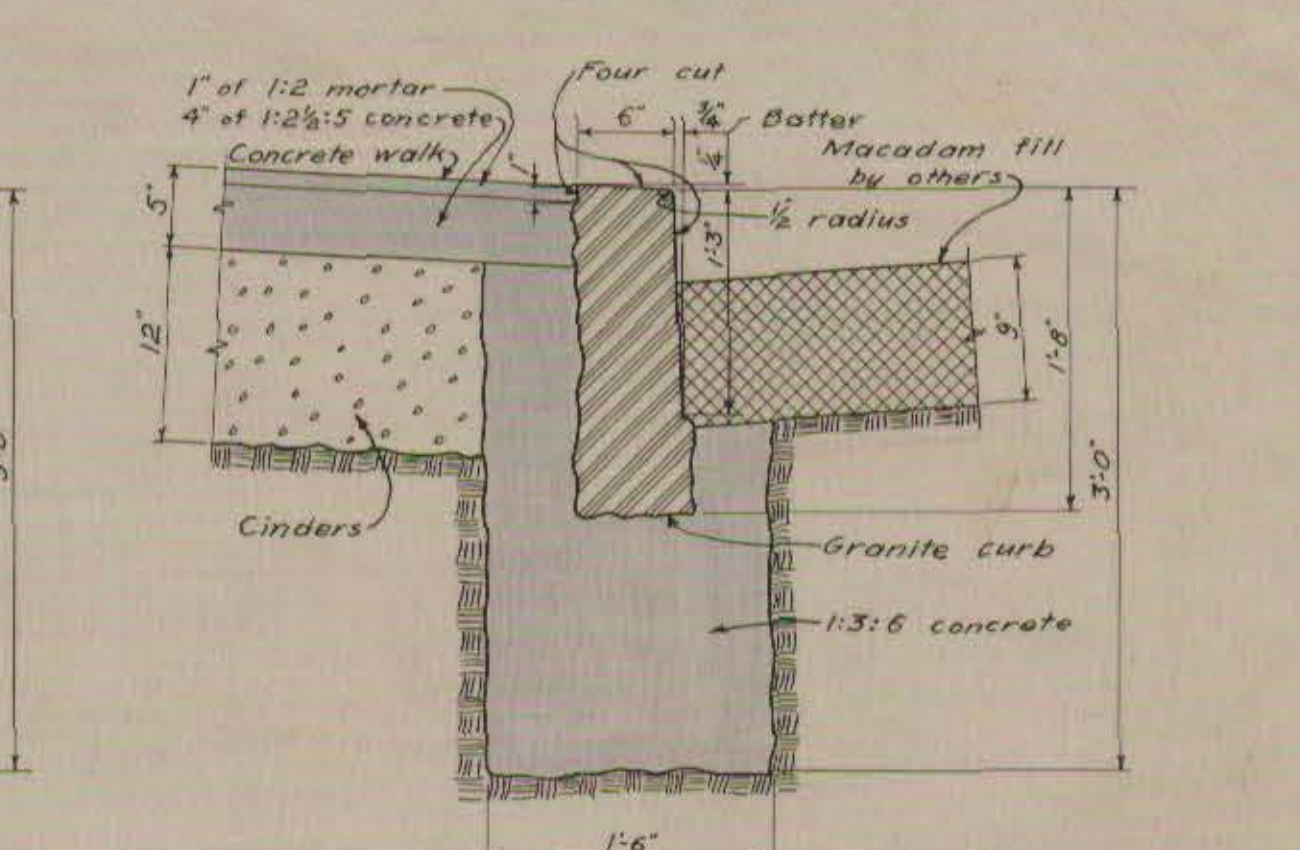
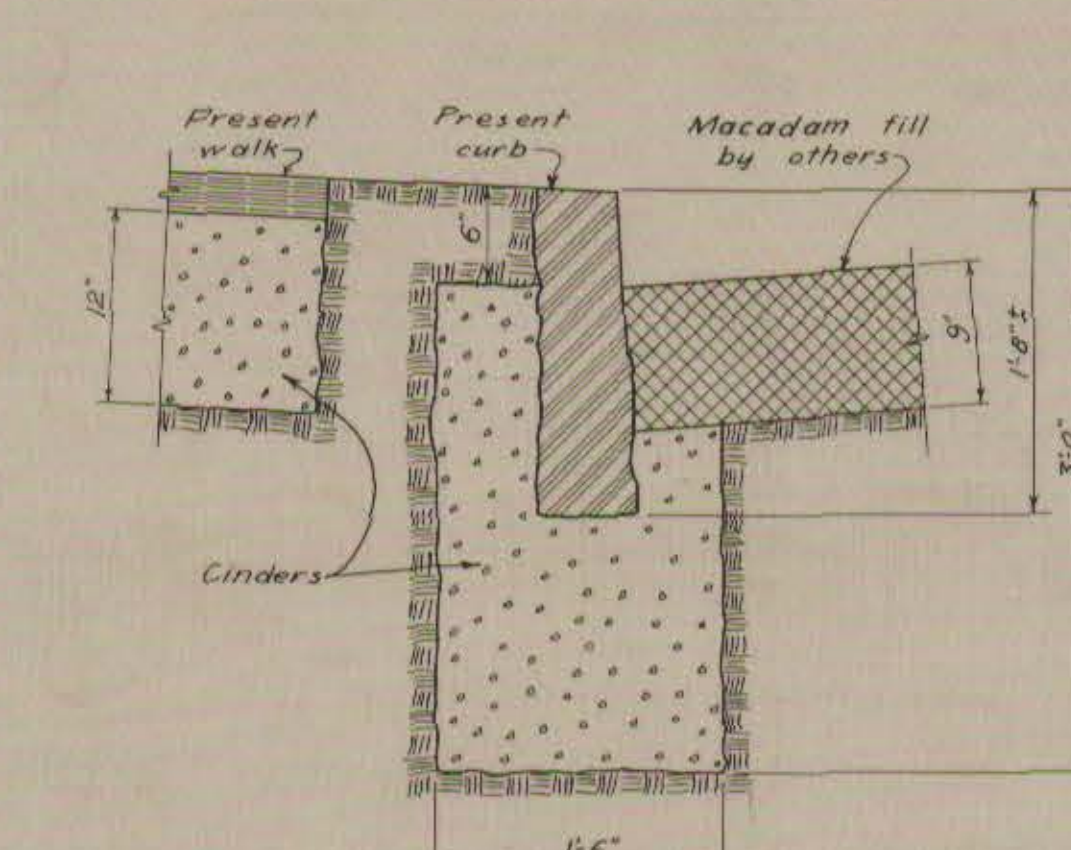
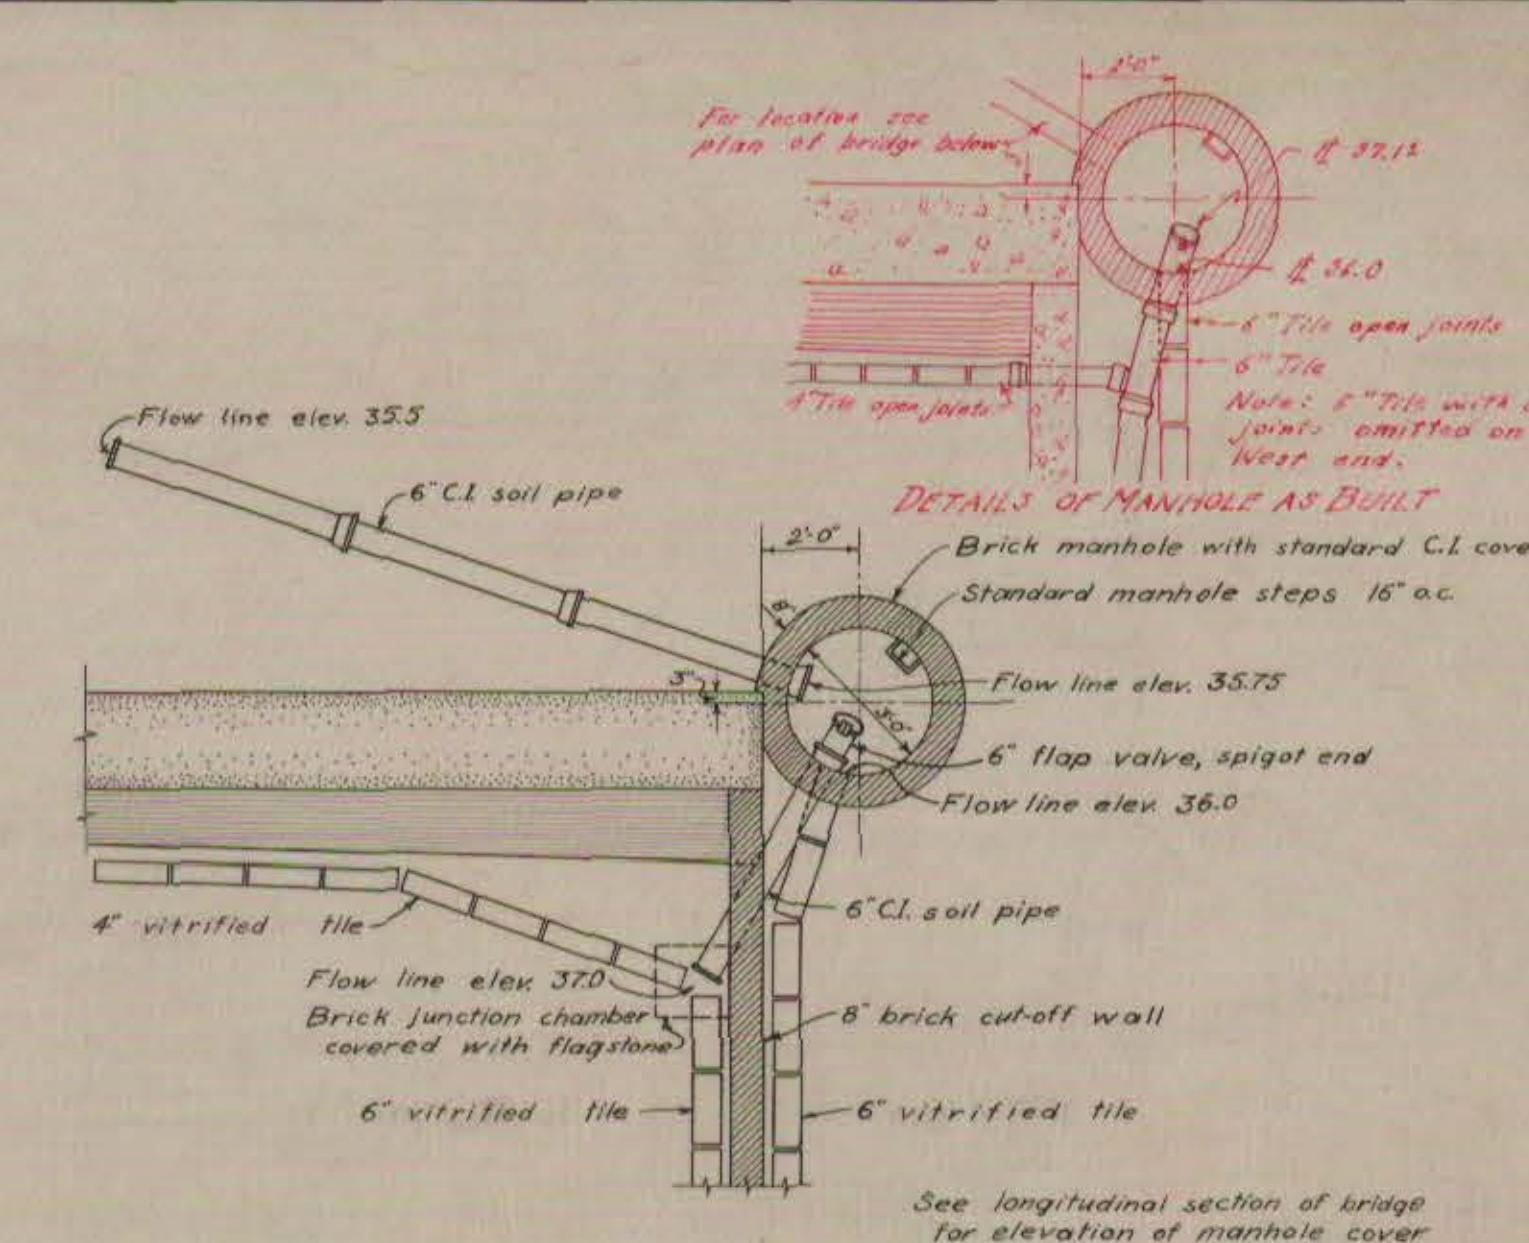


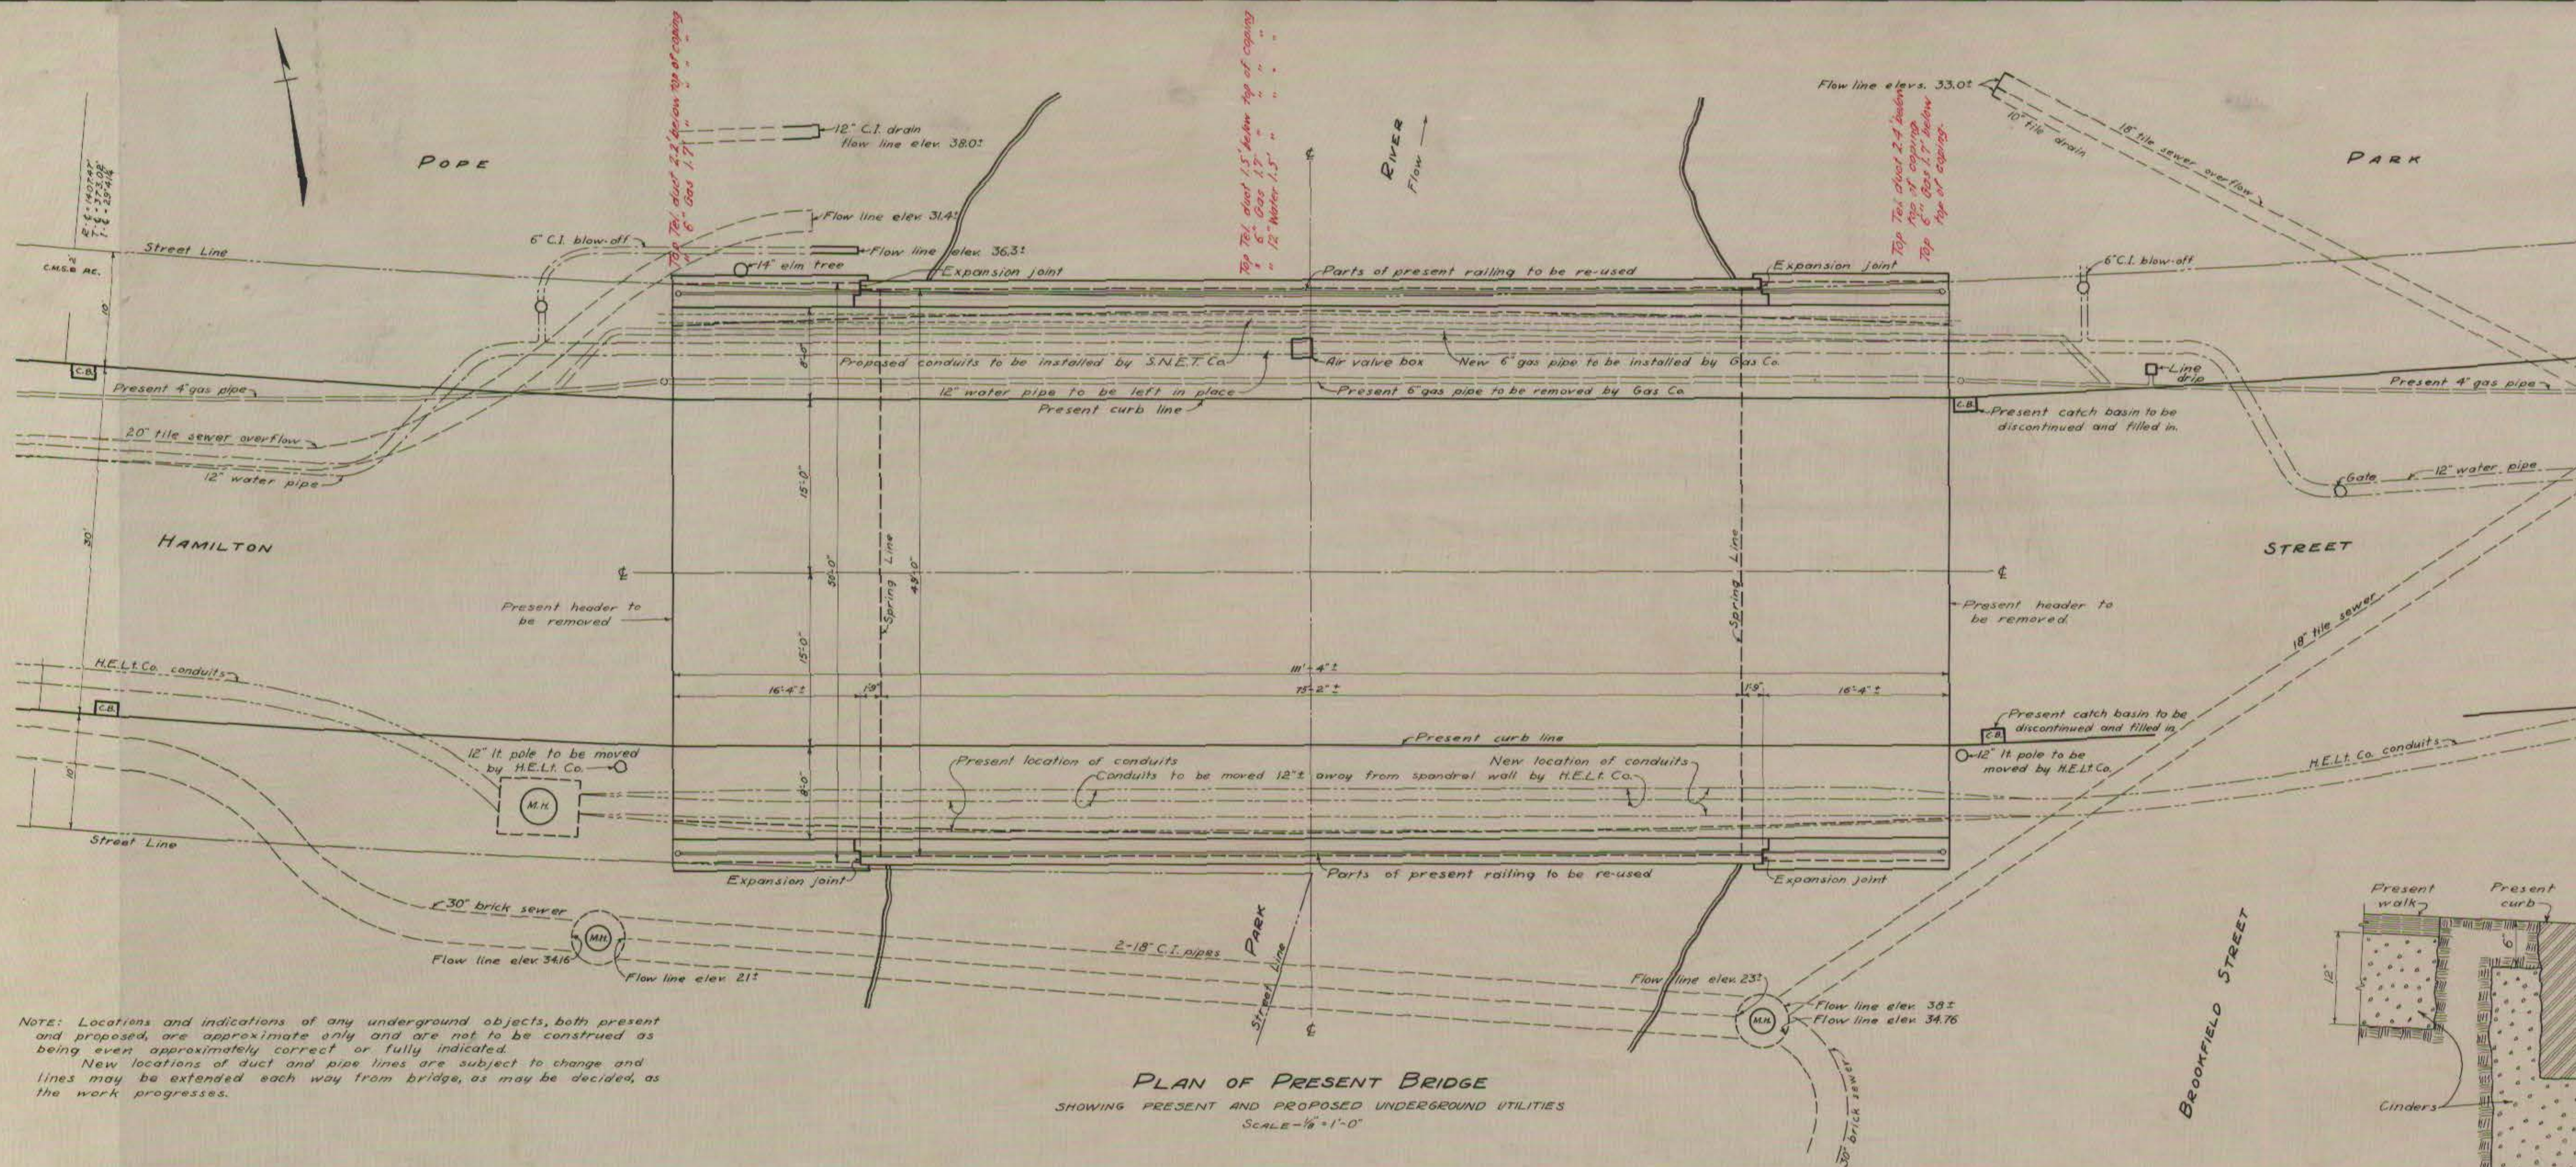

Notes in red were added Dec. 1939 to show construction changes.
Notes by T.C.T. Checked by J.B.R.

DEPARTMENT OF ENGINEERING, CITY OF HARTFORD	
RECONSTRUCTION OF HAMILTON STREET BRIDGE	
PRESENT AND NEW PLANS, DETAILS OF DRAIN MANHOLES, AND CURB SECTIONS	
Drawn by: B.M.P.	DATE: June 30, 1939
Approved: J. L. Brewster	CHECKED BY: B.A.T.
DATE: July 25, 1939	
CITY ENGINEER	