FIRE HOUSE NO. 6
HUYSHOPE AVENUE
HARTFORD FIRE DEPT.

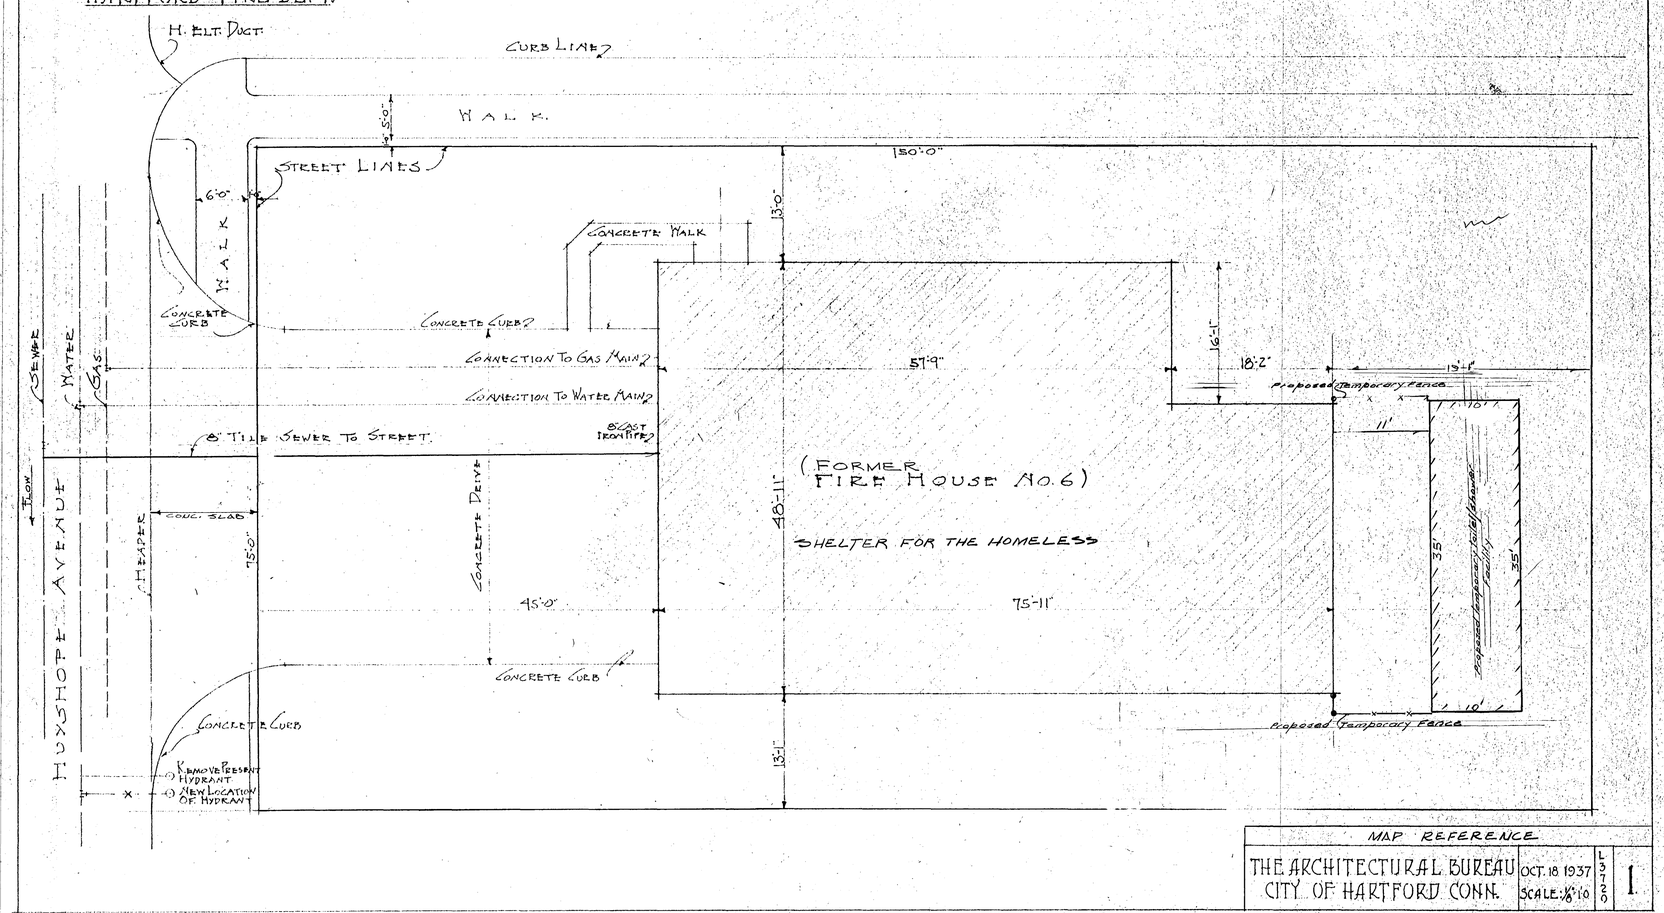

MAP REFERENCE			
THE ARCHITECTURAL BUREAU CITY OF HARTFORD CONN.	OCT. 18 1937 SCALE: 1/8" = 1'0	L 3 7 2 0	1.

ZONING INFORMATION

ZONE: I-2	REQUIRED	PROPOSED
BUILDING AREA	5625 S F	3772 SF
LOT AREA	15000 SF	11250* SF
RES. DENSITY	N. A.	
F.A.R.	N. A.	
LOT OCCUPANCY	50%	33.5%
LOT WIDTH	100 FT	150 FT.
FRONT YARD	0 FT.	45.0 FT.
SIDE YARD	N.R.	13.0 FT.
REAR YARD	N.R.	8.1 FT.
HEIGHT	N.R.	
USABLE SPACE	N.A.	
PARKING SPACES		
USE (See Note)	IND.	HOMLS. SHELTER

* DENOTES NON-CONFORMING

NOTE: Transient lodgings permitted in I-2 district.

STATE OF CONNECTICUT
OSWALD H. BLANT
No. 12048
LICENSED
LAND SURVEYOR

CERTIFIED SUBSTANTIALLY CORRECT

Revised 7-12-90

CITY OF HARTFORD, CONNECTICUT
DEPARTMENT OF PUBLIC WORKS
BUREAU OF ENGINEERING SERVICES

PLOT PLAN OF
FIRE HOUSE No. 6
HUYSHOPE AVE.
HARTFORD, CONNECTICUT

SUBMITTED	RECOMMENDED	APPROVED
PROJECT ENGINEER	DIVISION MANAGER	CITY ENGINEER, ESB

DRAWN	SCALE	DAYBOOK NO. 011081
CHECKED	1" = 8'	DATE 6-10-87