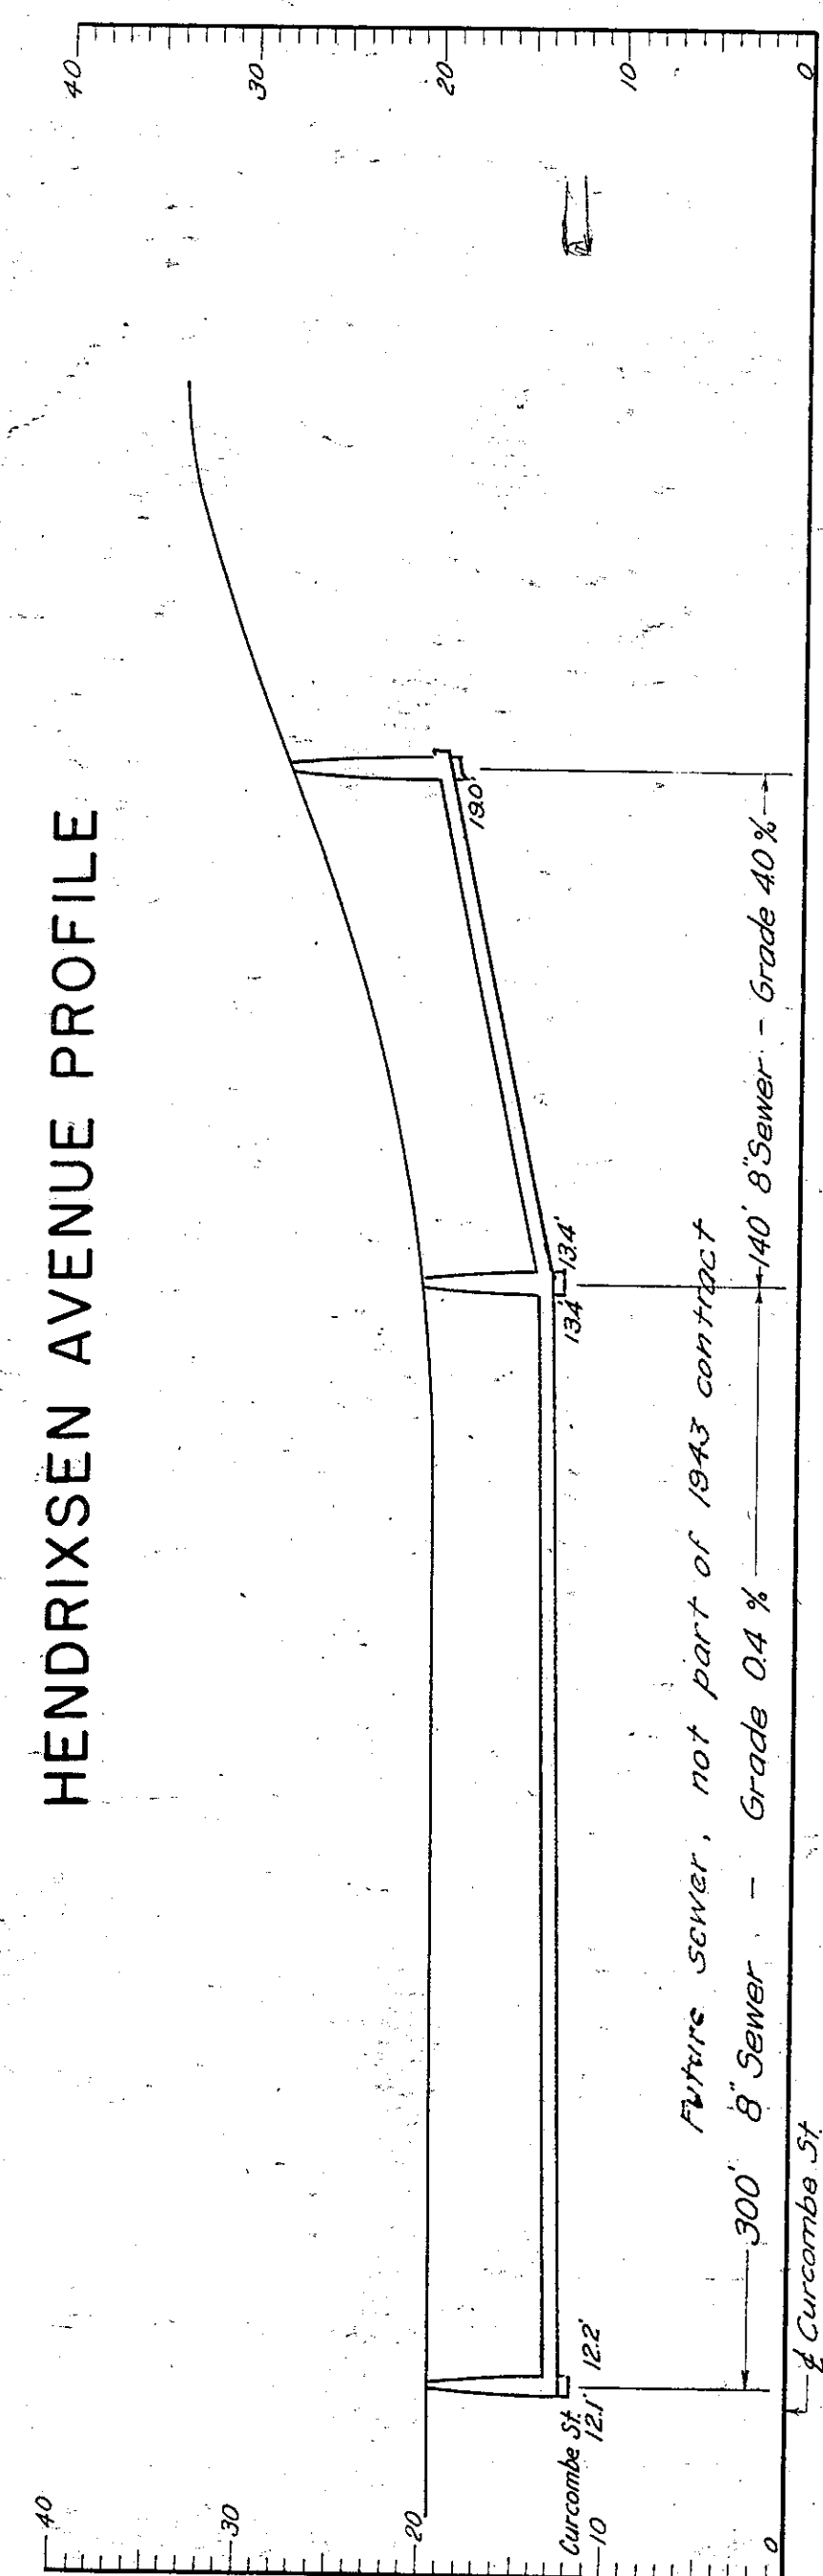
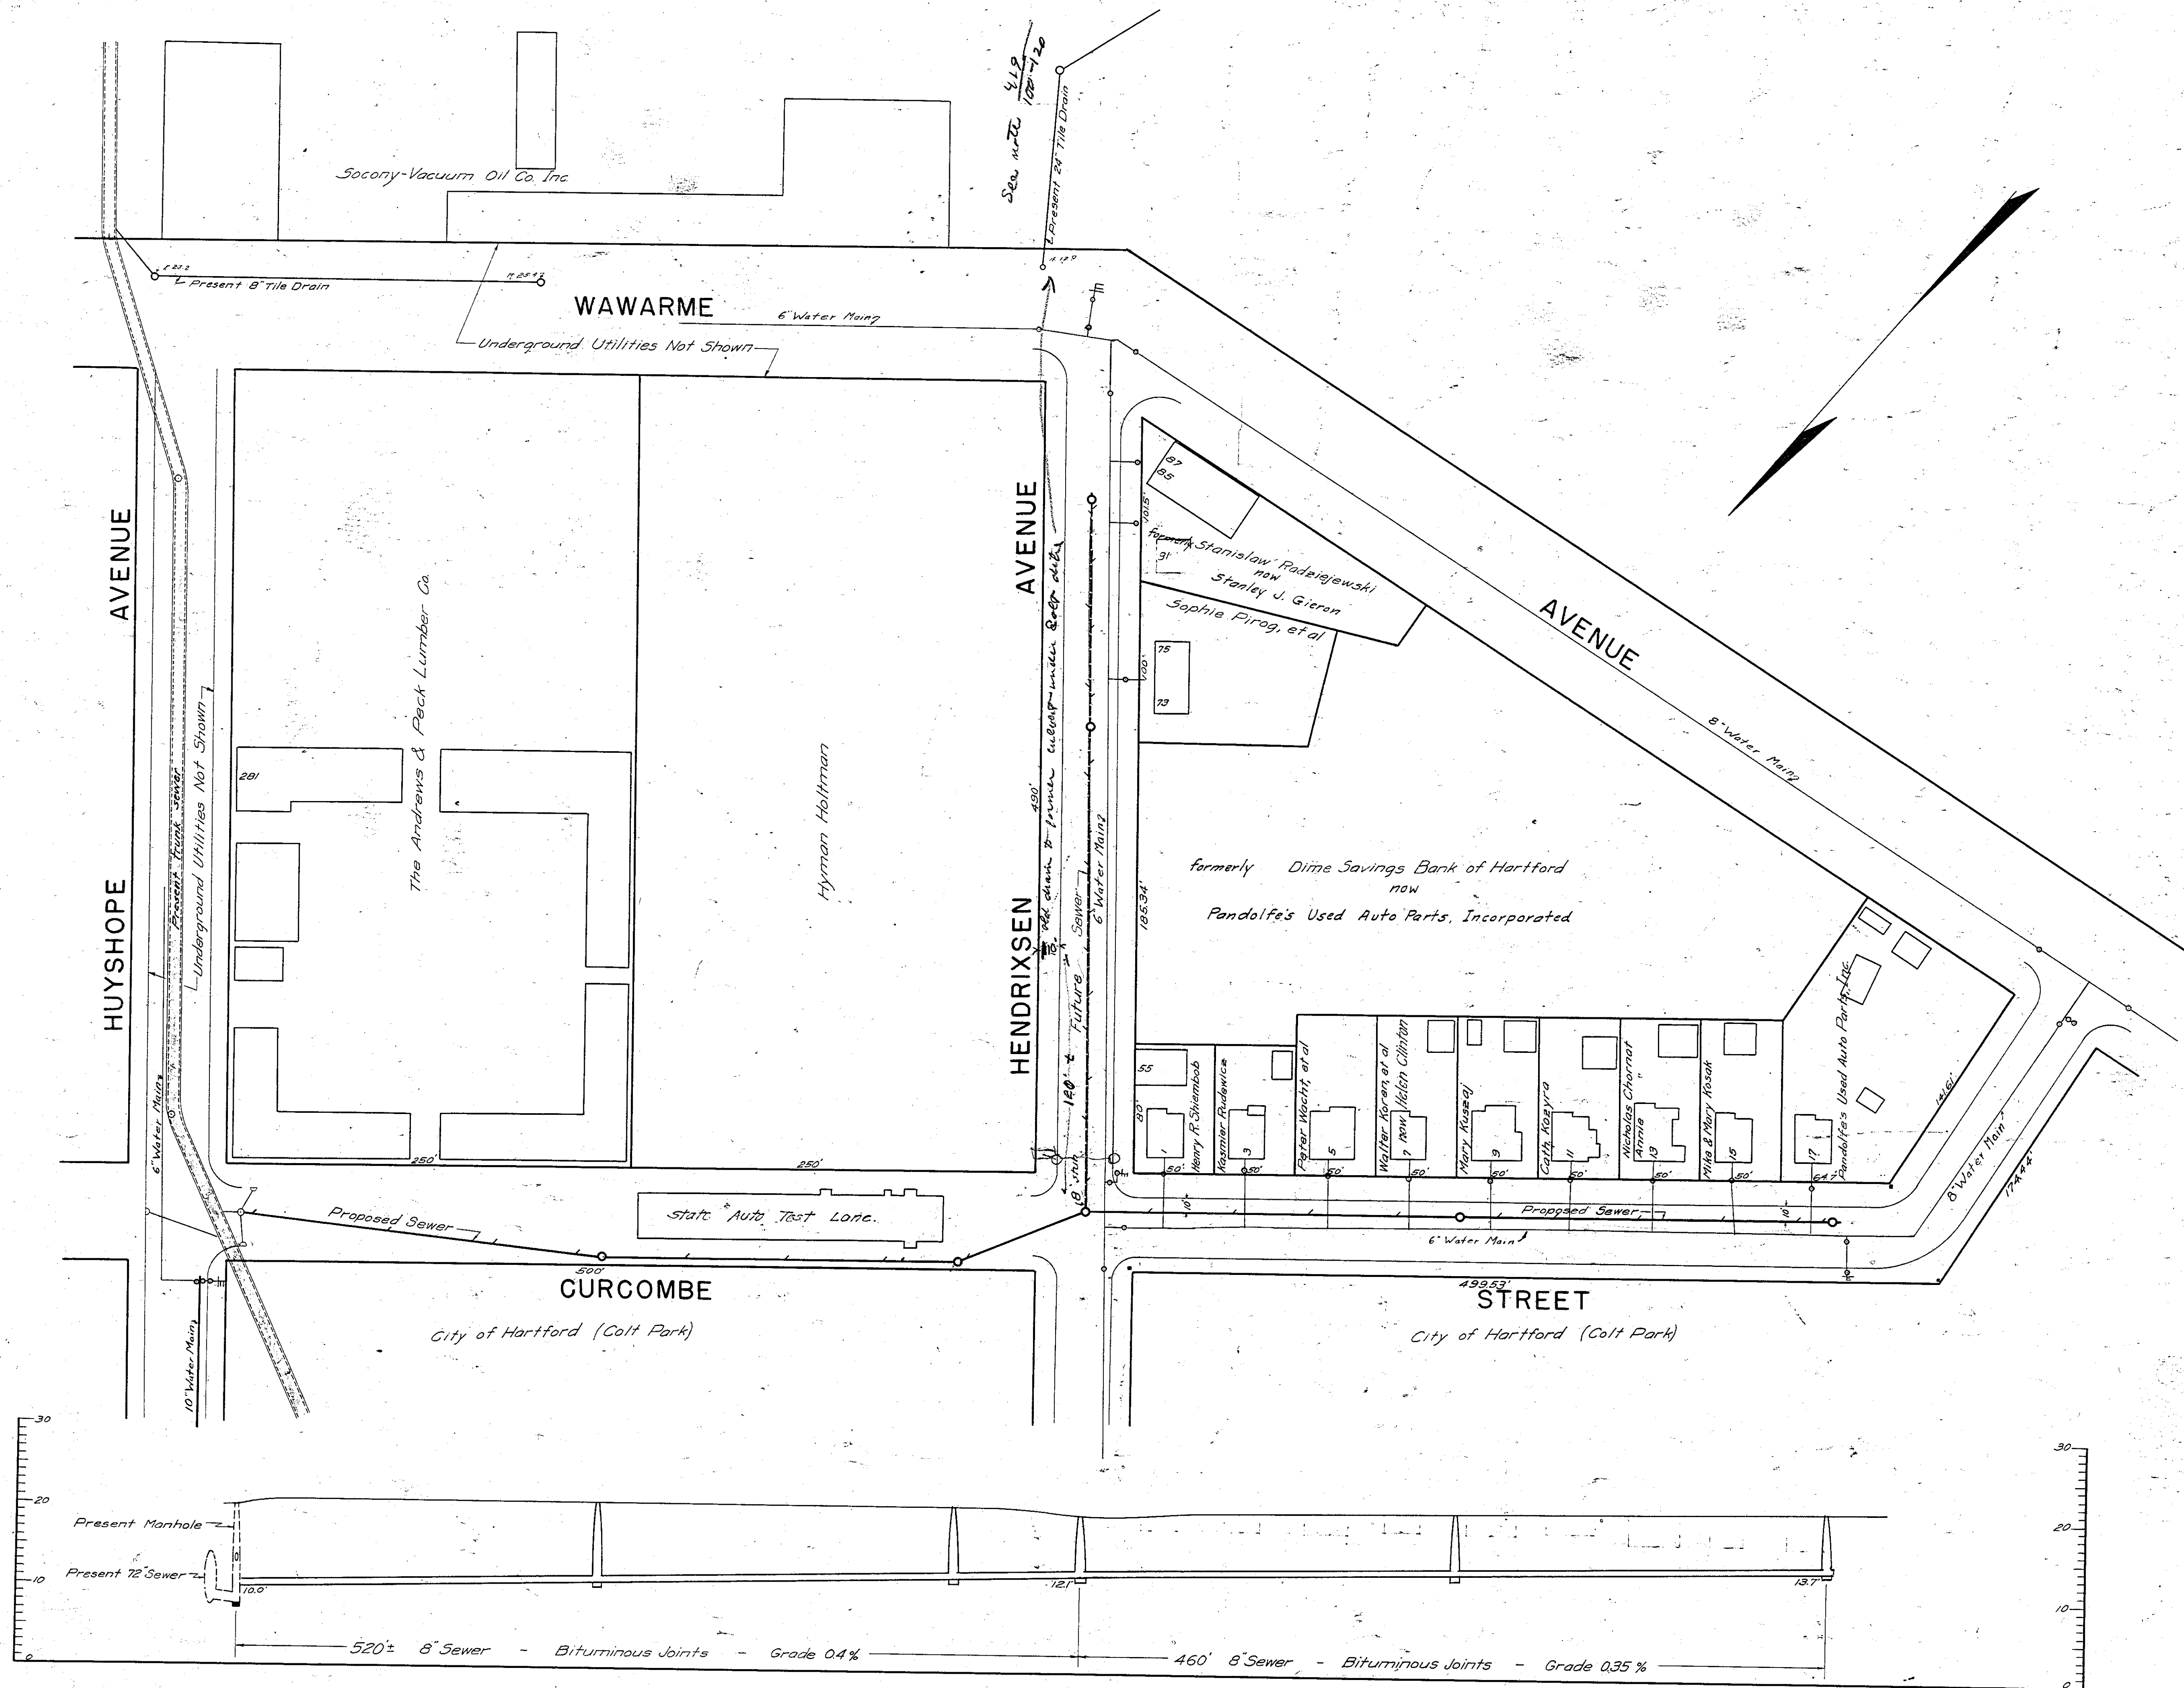


Manholes to have reinforced concrete top frames and covers as shown on plan No. 02452 and concrete block steps as in plan No. 02453 or equivalent. Except as above manholes will be in accordance with standard manhole plan No. 02425 (180-71).

FIELD NOTES

Cellar Levels F.B. 565 p. 70
Profile F.B. 647 pp. 139, 140
Old Manhole F.B. 647 p. 120
State Lane F.B. 647

DEPT. OF ENGINEERING, HARTFORD CONN.		
ROBERT J. ROSS, CITY ENGINEER & MANAGER, MET. DIST. BUR. OF PUBLIC WKS.		
FOR THE BUREAU OF PUBLIC WORKS		
METROPOLITAN DISTRICT		
CONSTRUCTION PLAN OF		
PROPOSED SEWER IN		
CURCOMBE ST. & HENDRIXSEN AV.		
SCALES: HOR. 1"=50', VERT. 1"=10'		
CERTIFIED	SUBMITTED	APPROVED
DIVISION ENGINEER	DEPUTY MANAGER	MANAGER
DESIGN	DRAWN	DAYBOOK NO. 08295
TRACED	CHECK	JANUARY 1942