




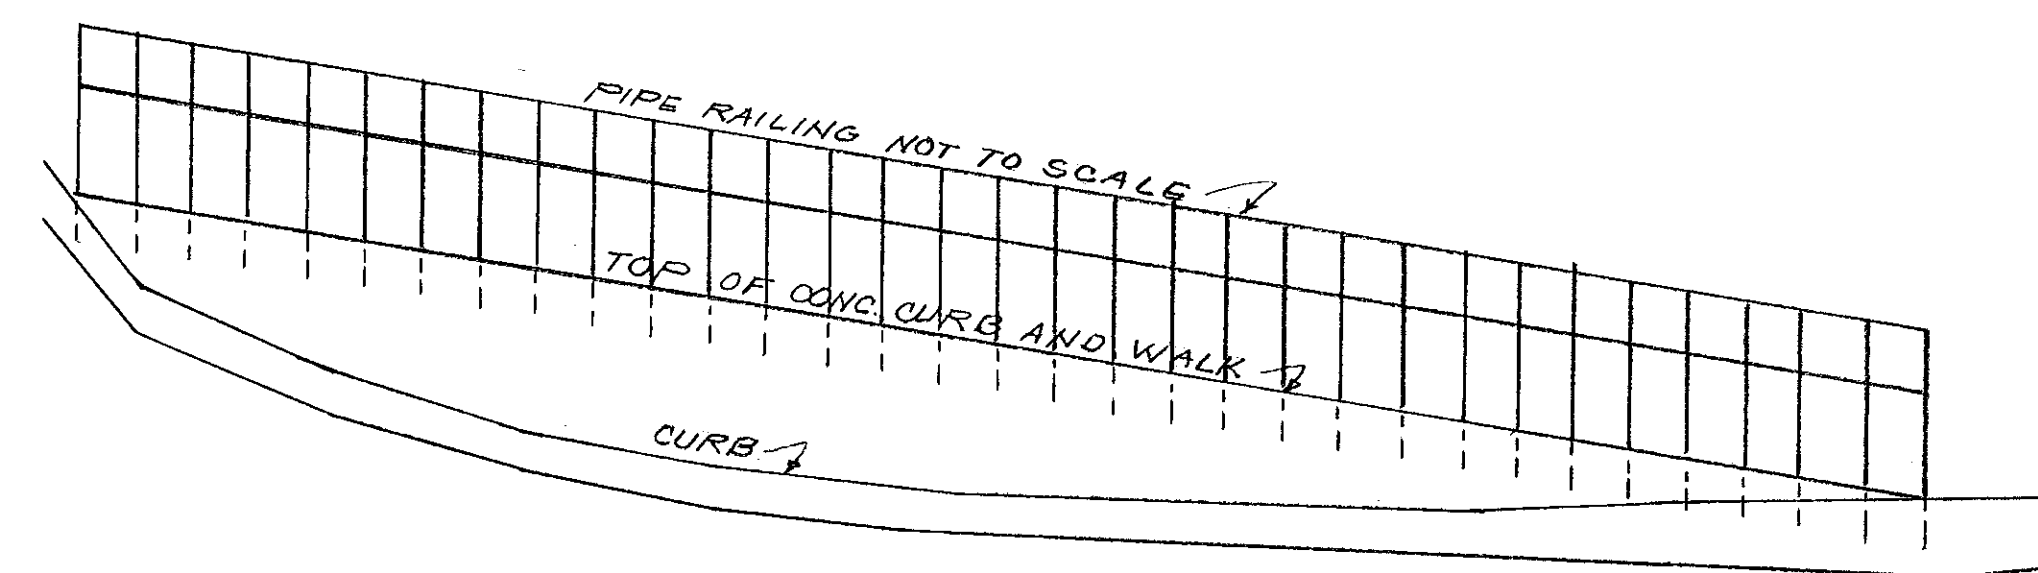


PROFILE NORTH CURB
SCALE: HOR. 1"=20'
VER. 1"=2'

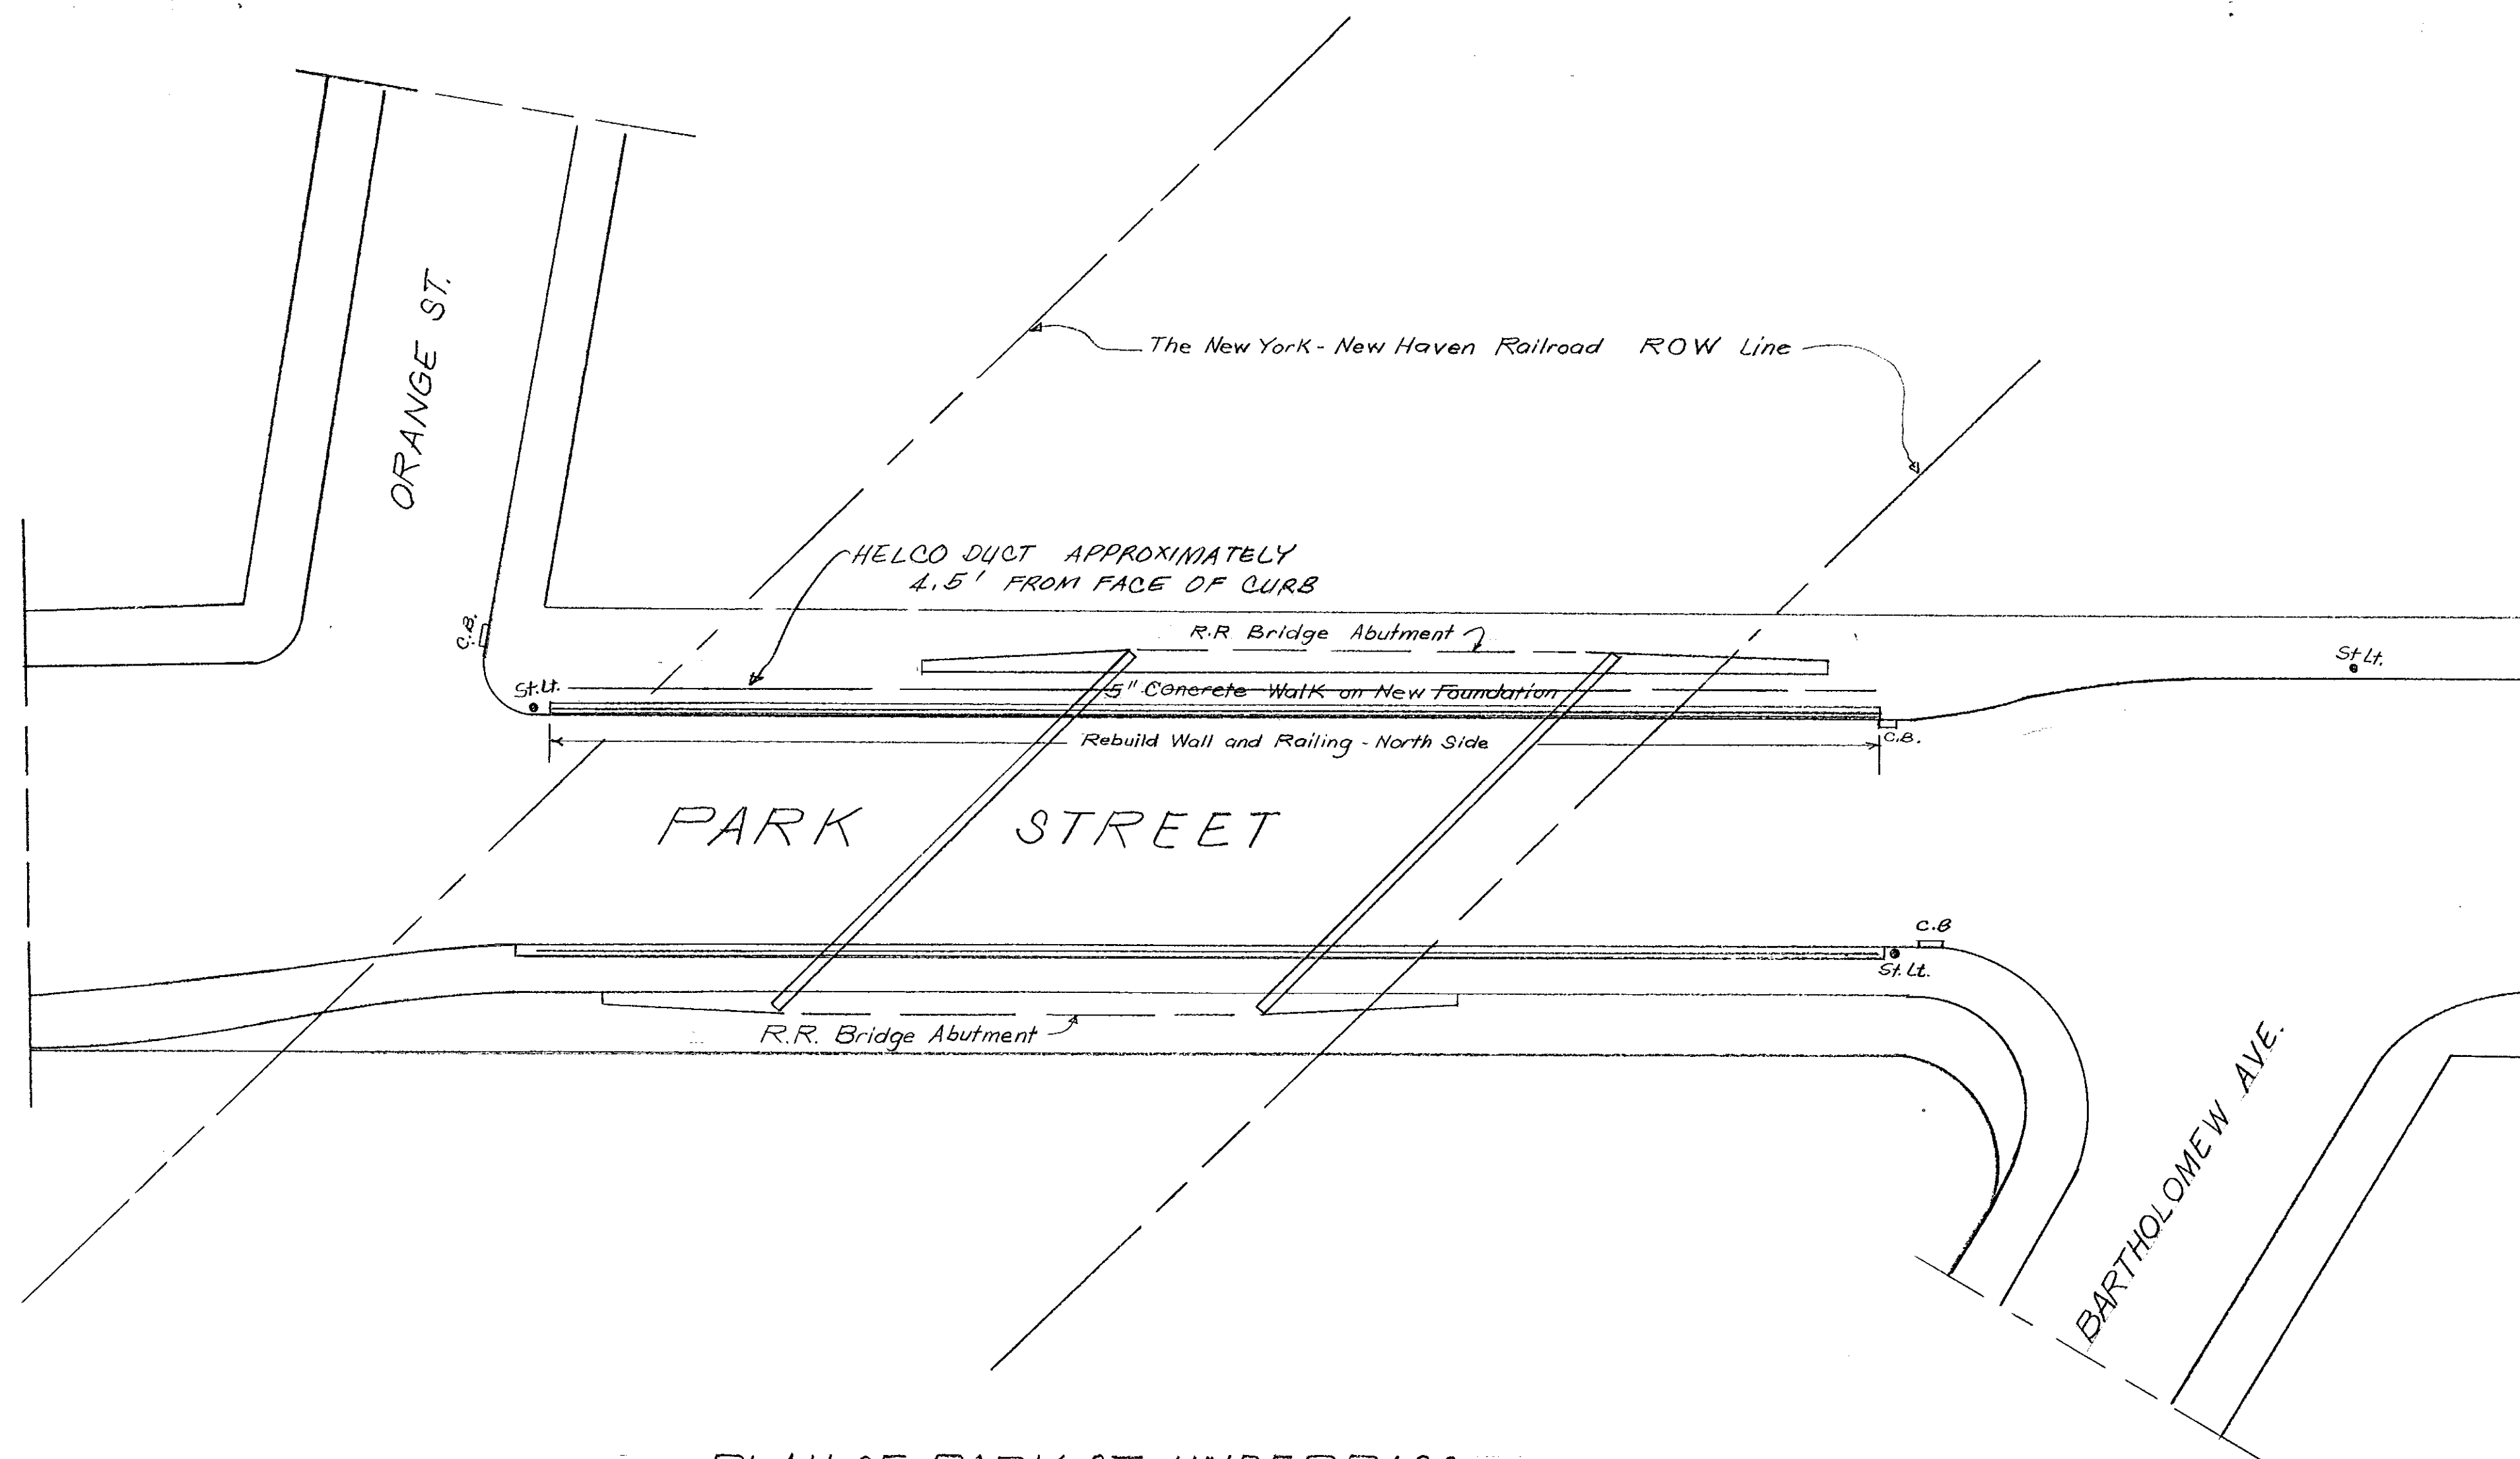

PLAN OF PARK ST. UNDERPASS
SCALE 1"=20'

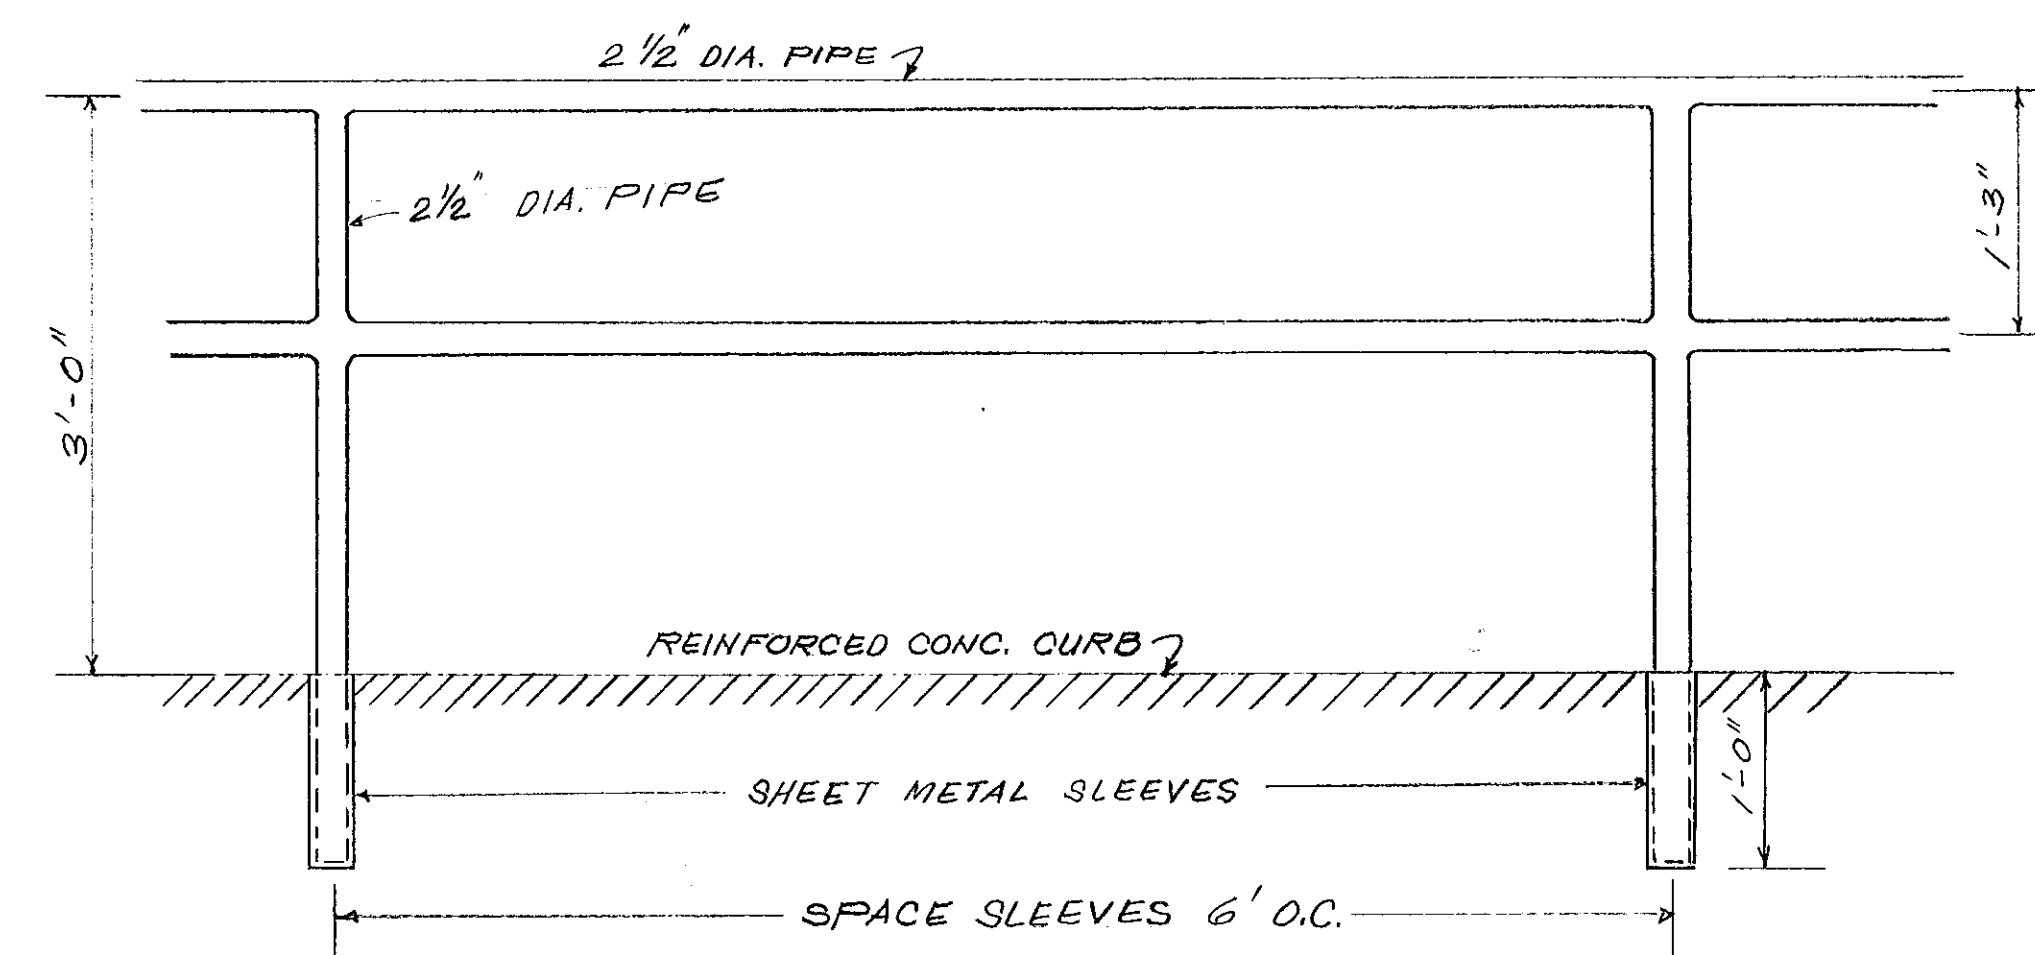

PIPE RAILING DETAIL
SCALE 1"=1'

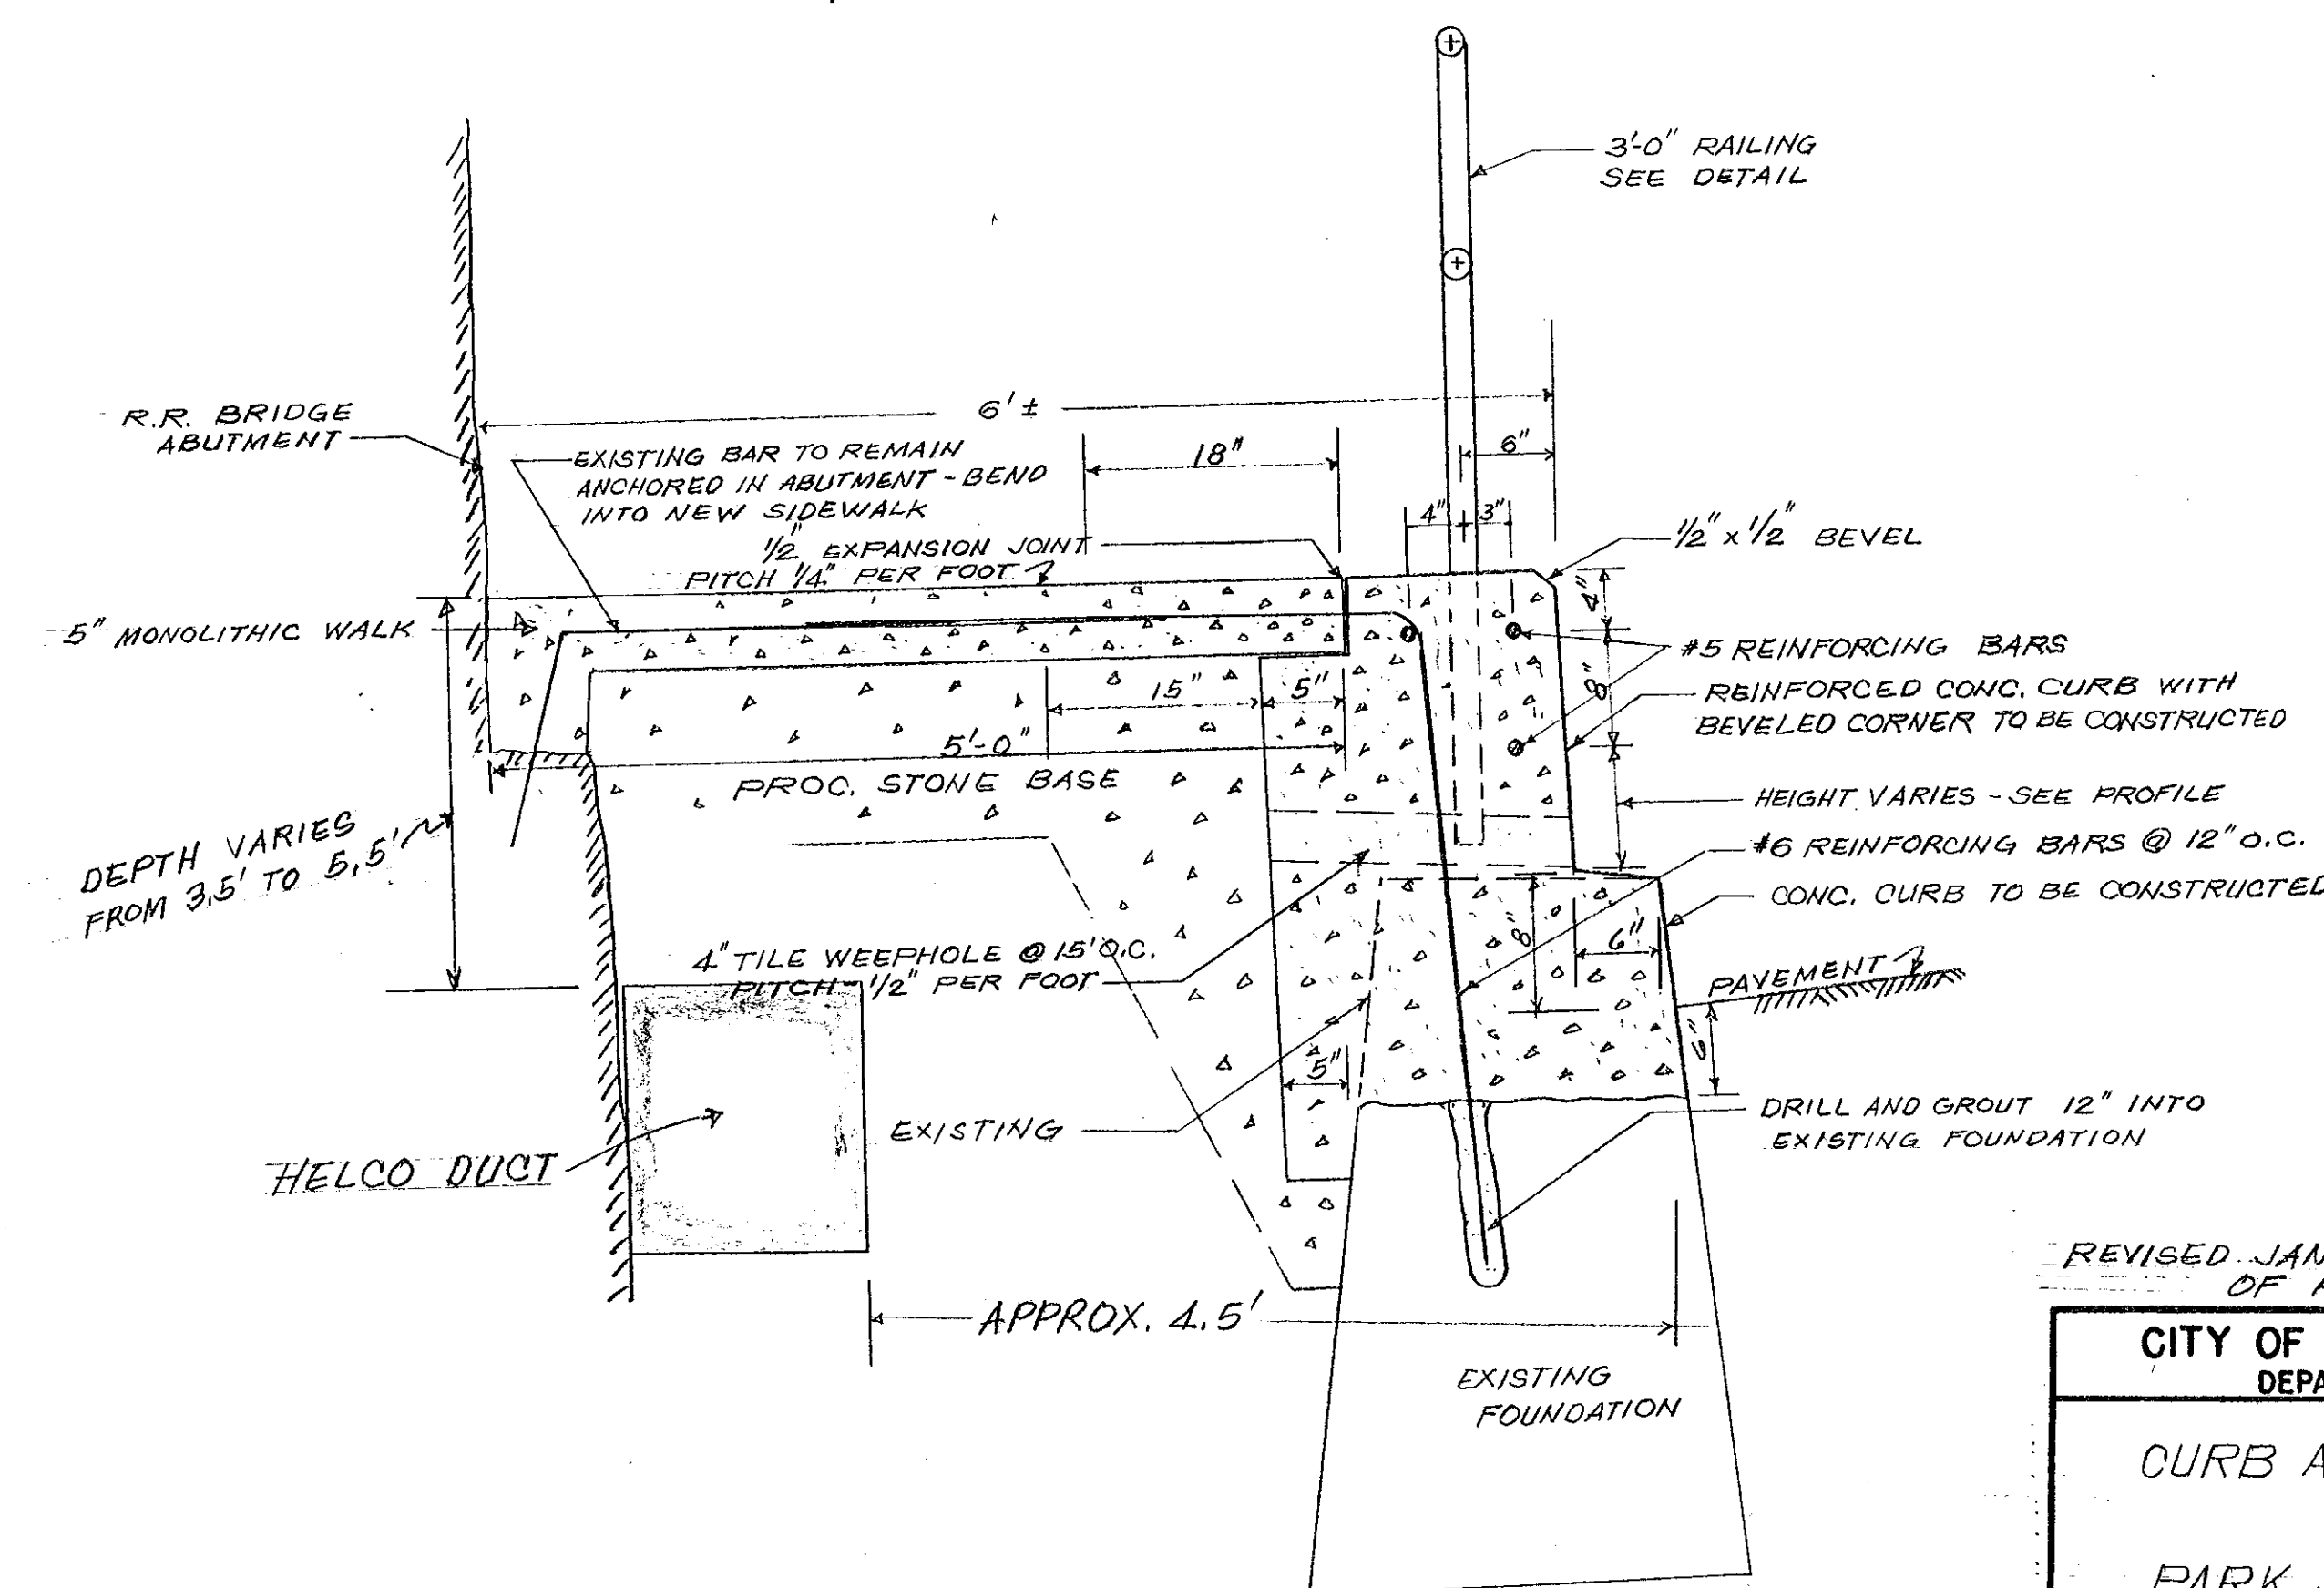

TYPICAL SECTION OF PROPOSED CURB AND WALK
SCALE 1"=1'

REVISED JAN. 24, 1972 TO SHOW LOCATION OF HELCO DUCT.

CITY OF HARTFORD, CONNECTICUT DEPARTMENT OF ENGINEERING			
CURB AND WALK REPAIRS AT PARK STREET UNDERPASS			
SUBMITTED M.M. (Name)	RECOMMENDED K.M. (Name)	APPROVED J.M. (Name)	
DIVISION ENGINEER	ASST. CITY ENG.	CITY ENGINEER	
DESIGN	DRAWN G.S.D.	DAYBOOK NO. 010319	
TRACED G.S.D.	CHECK M.M.C.	DATE DEC. 29, 1971	