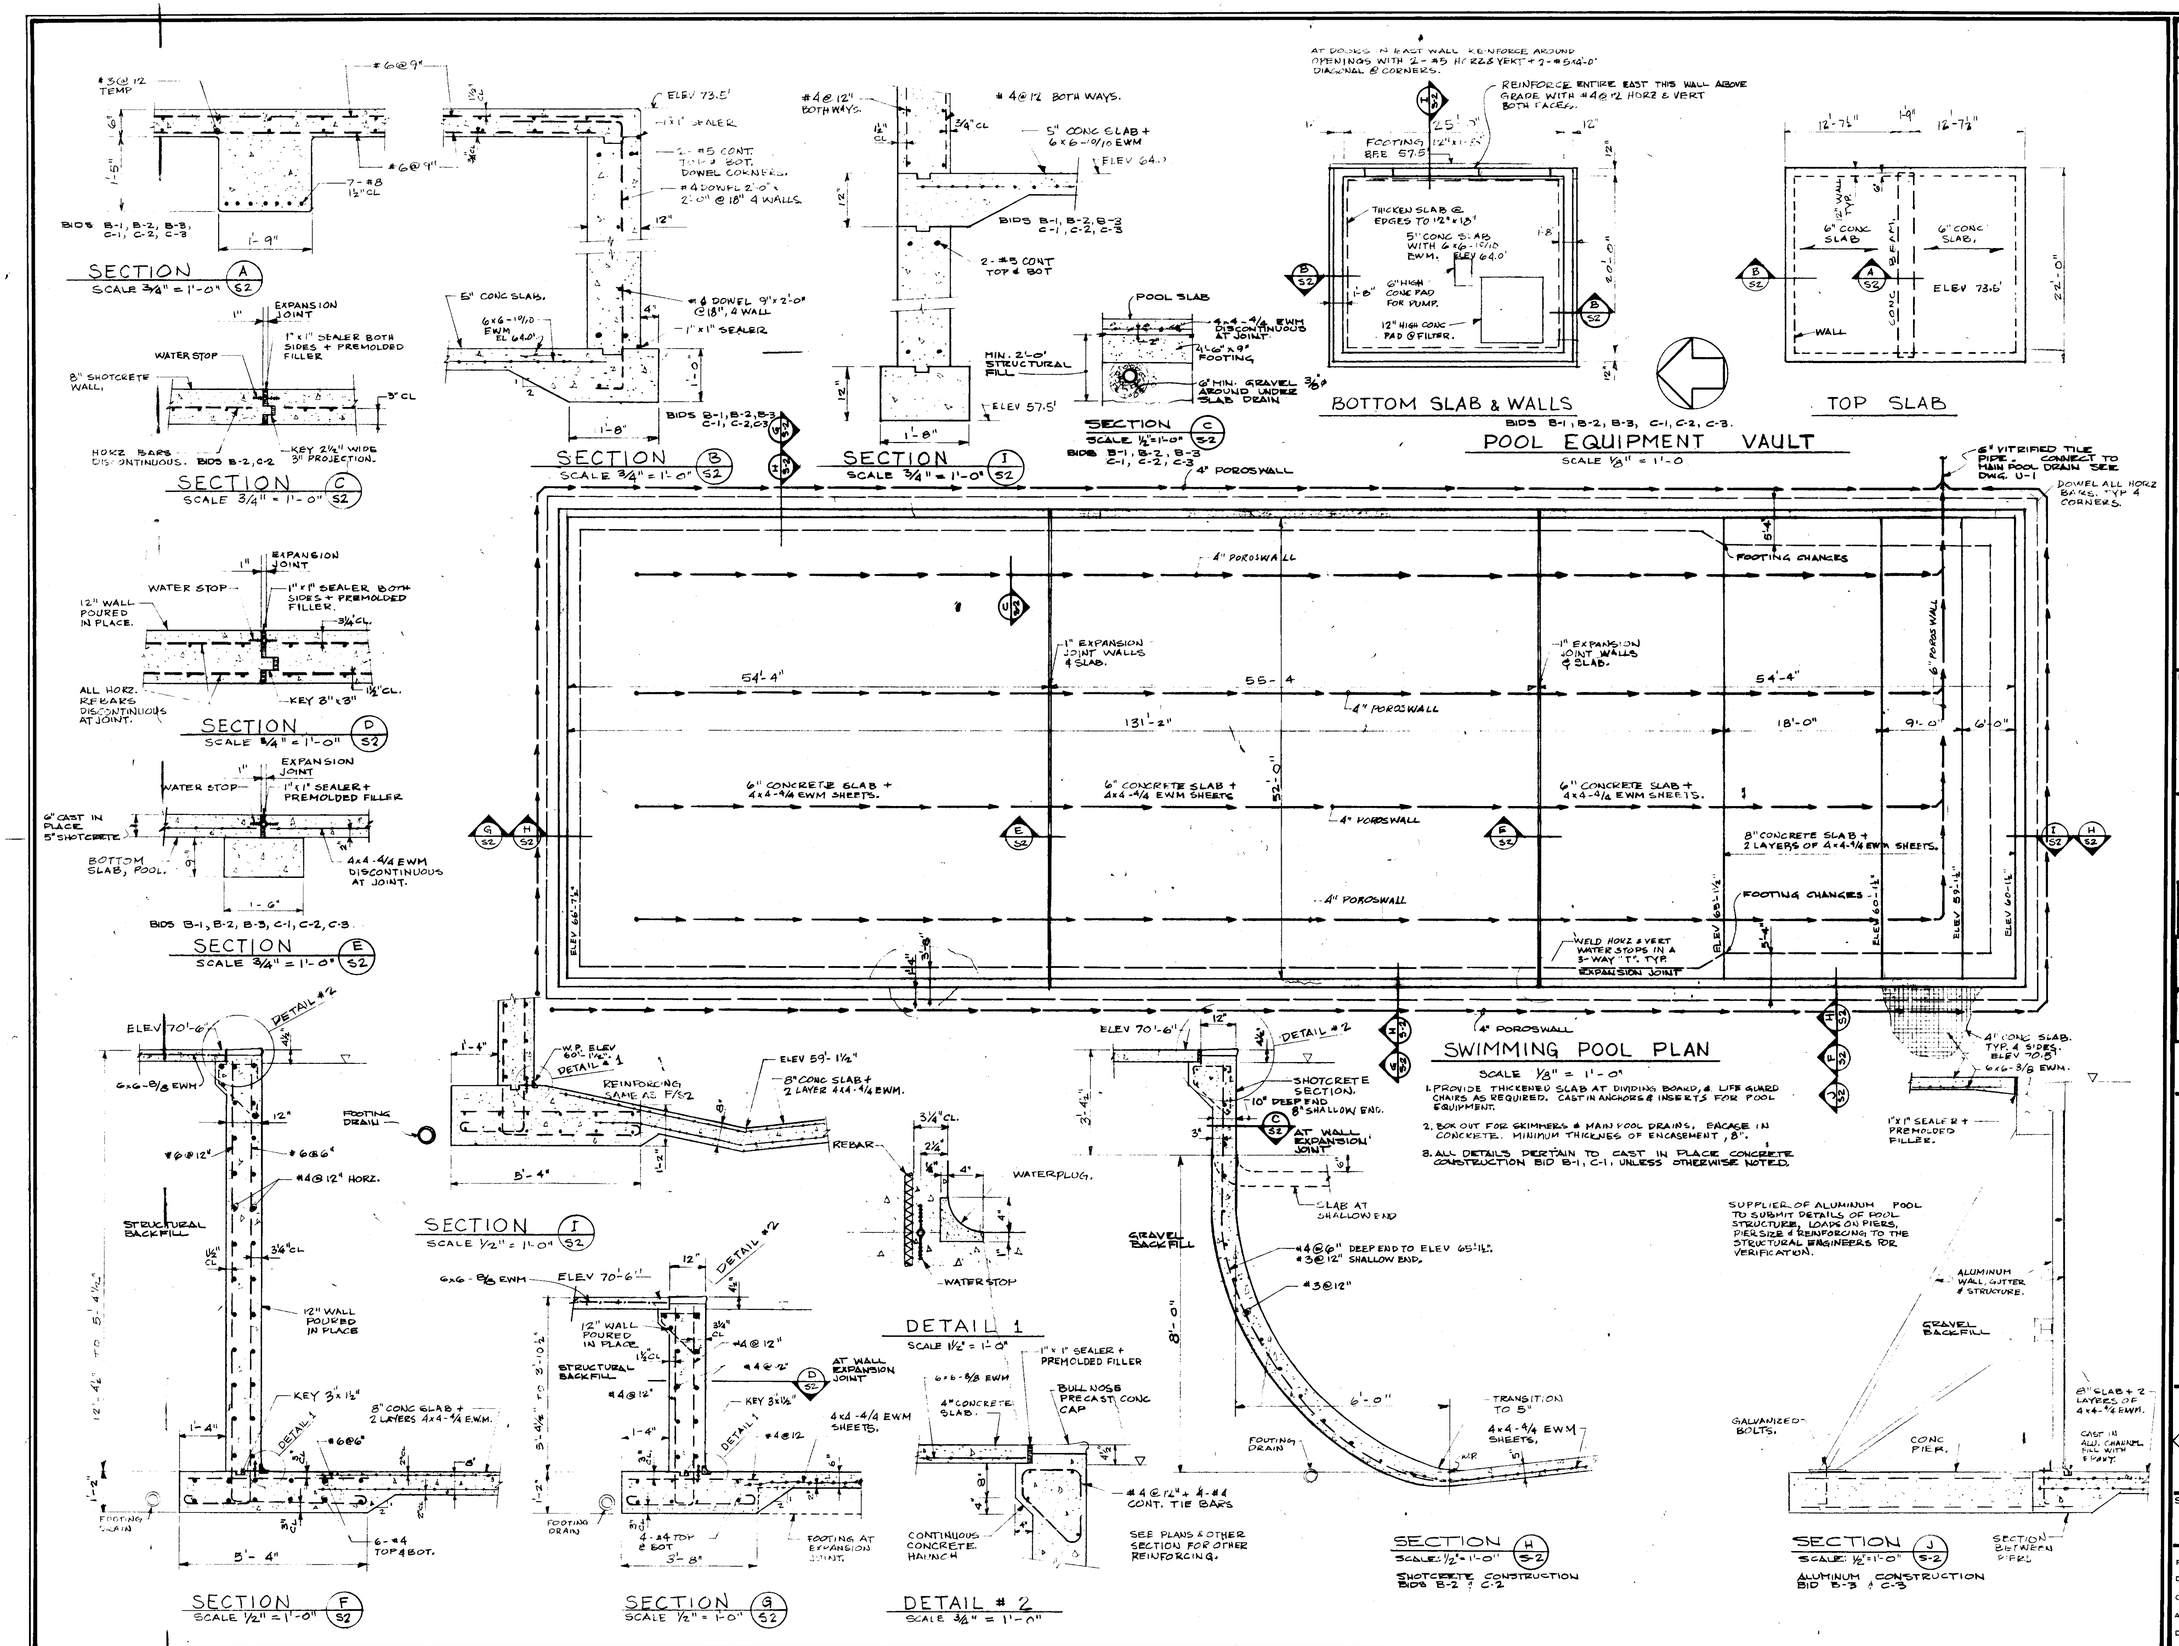

NO.	DATE	REMARKS

PROJECT TITLE

POPE PARK POOL & BATHHOUSE

ASSOCIATED ARCHITECTS
FARMINGTON · CONNECTICUT · 06032

STRUCTURAL ENGINEER
BURTON & VAN HOUTEN
WEST HARTFORD CONNECTICUT

MECHANICAL ENGINEER
BURTON & VAN HOUTEN
WEST HARTFORD CONNECTICUT

LAND PLANNER
MAINE & TILLAPAUGH
WEST HARTFORD CONNECTICUT

CORRECT AS BUILT DEC. 70-72

STATE OF CONNECTICUT · PHILIP A. BURTON · No. 4483 · REGISTERED PROFESSIONAL ENGINEER

SHEET TITLE
STRUCTURAL
SWIMMING POOL PLAN

PROJECT NO. 6047.70	SHEET NO.
DRAWN BY CB	S2
CHECKED BY CB	
APPROVED BY PAB	
DATE 11 SEPT. 1970	SHEET 2 OF 2

BRUNING 11533