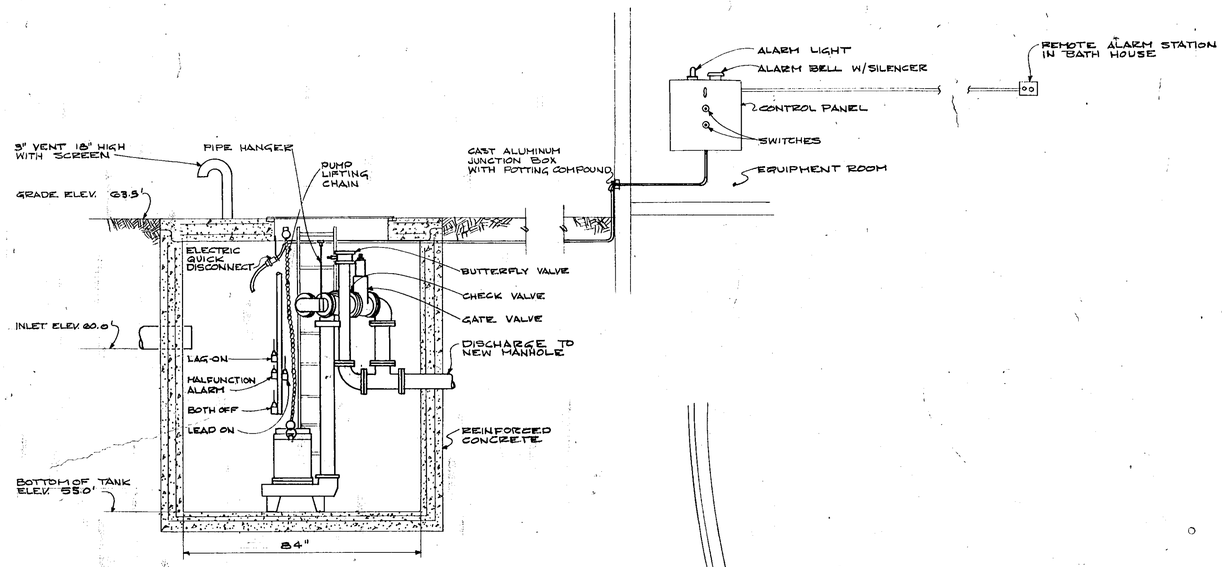

SEWAGE PUMPING DETAIL

NOT TO SCALE

(SECTION 15C)

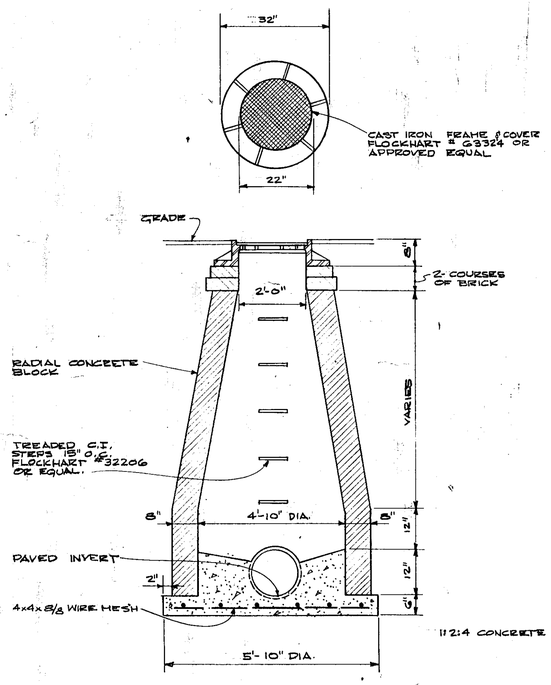

MANHOLE DETAIL

NOT TO SCALE.

(SECTION 15C)

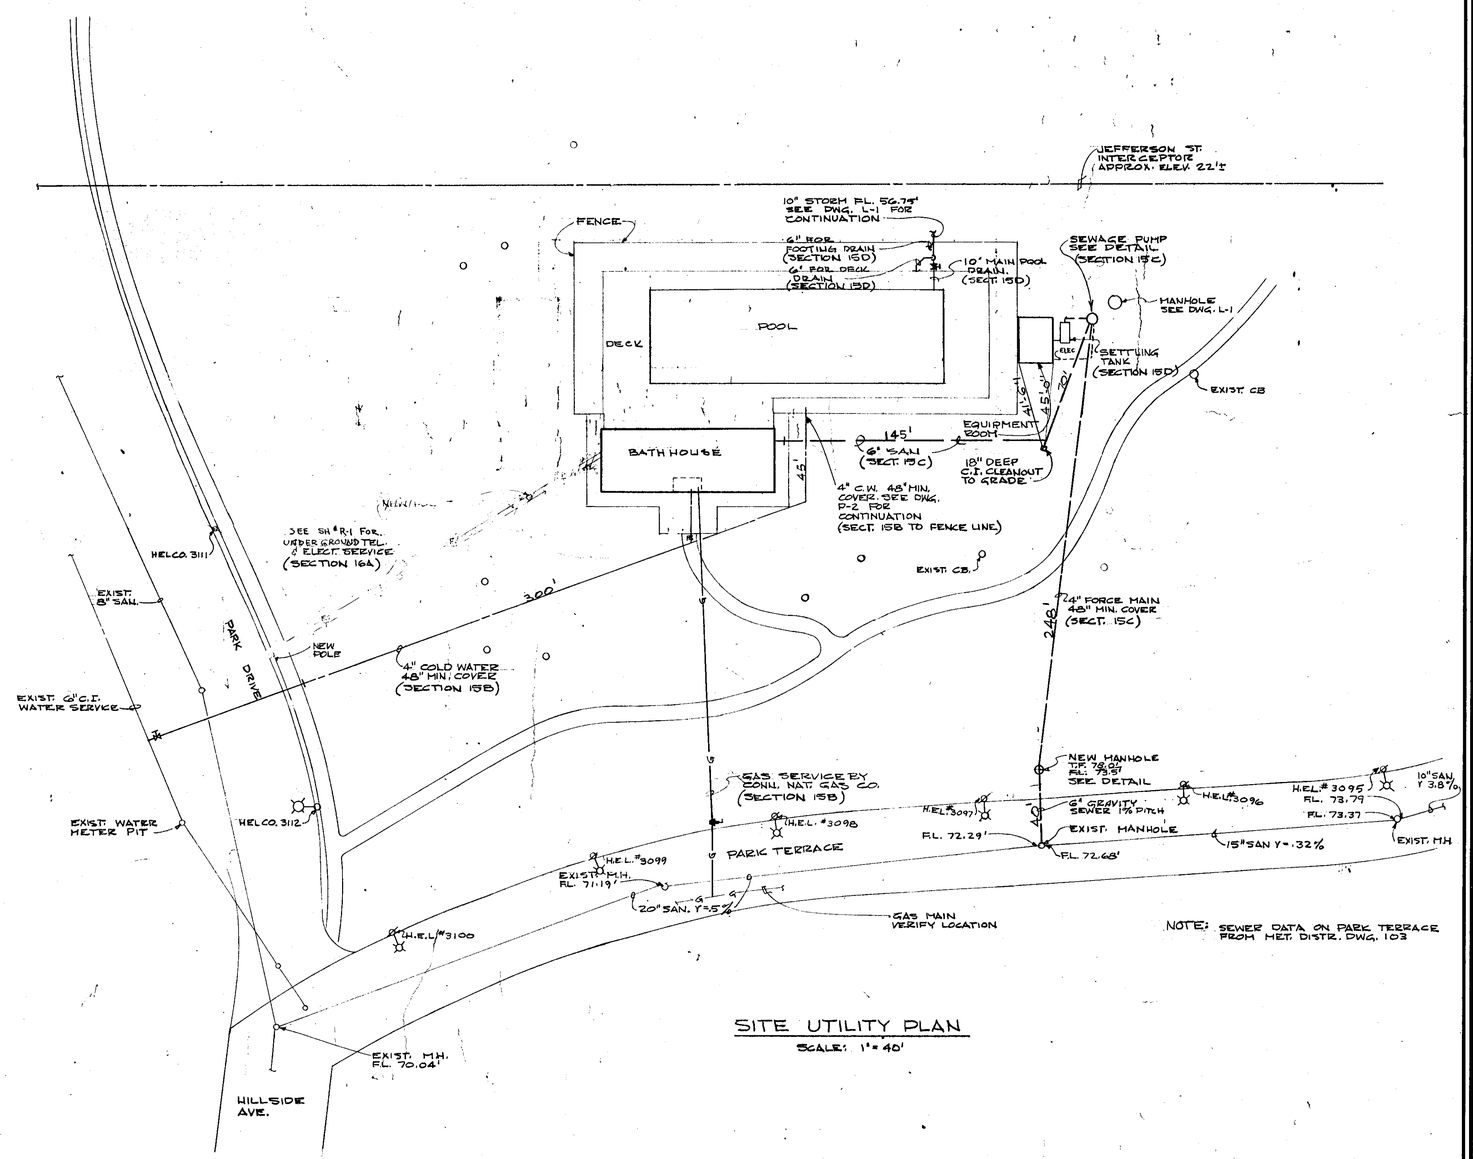

NOTE: SEWER DATA ON PARK TERRACE FROM MET. DISTR. DWG. 103

SITE UTILITY PLAN

SCALE: 1" = 40'

REVISIONS

NO.	DATE	REMARKS

PROJECT TITLE

POPE PARK POOL & BATHOUSE

ASSOCIATED ARCHITECTS

FARMINGTON · CONNECTICUT · 06032

STRUCTURAL ENGINEER
BURTON & VAN HOUTEN
WEST HARTFORD CONNECTICUT

MECHANICAL ENGINEER
BURTON & VAN HOUTEN
WEST HARTFORD CONNECTICUT

LAND PLANNER
MAINE & TILLAPAUGH
WEST HARTFORD CONNECTICUT

CORRECT AS BUILT DEL. 20-72

STATE OF CONNECTICUT ROBERT L. VAN HOUTEN No. 4433 REGISTERED PROFESSIONAL ENGINEER

SHEET TITLE

SITE UTILITY PLAN

PROJECT NO. 60470
DRAWN BY AY
CHECKED BY RSC
APPROVED BY RSC
DATE 11 SEPT. 1970

SHEET NO.

U1

SHEET 1 OF 1

BRUNING 11533