SYMBOL LIST	
(P)	Porcelain socket, Arrow-Hart #4350 or equal.
	Incandescent light fixture.
	Incandescent light fixture, wall mounted.
	Floodlight fixture.
	Fluorescent lighting fixture.
	Duplex receptacle, Arrow #6739, mount 12" above floor, "a" indicates 6" above counter.
WP	Weather proof receptacle, P & S #6307 with 4500-L cover plate, mount 24" above floor except as pool, mount 16" above deck.
	Telephone outlet flush in wall 12" above floor. Run 3/4" conduit up in wall from outlet to bushed end in ceiling space.
S	Single pole wall switch Arrow #1991.
S_3	Three way wall switch Arrow #1993.
	Electrical panel.
	Controller by others, wiring by Electrical Contractor.
	Clock outlet, Arrow #452.
(M)	Motor by others, wiring by Electrical Contractor.
	Disconnect switch.
	Home run to panel.
	Schematic switching.
	Schematic circuiting.

FIXTURE SCHEDULE

All fluorescent ballasts to be integral fuse protected & CBM certified, Type "P".

TYPE	DESCRIPTION	LAMP	MOUNT
A	Moldcast MPB-232 cast aluminum super bullet, swivel mount, two fixtures on #2 canopy. Equal by Stonco.	150W-PAR 38	Surface
A_1	Same as above except MPB-233 three fixtures or #3 canopy.	150W-PAR 38	Surface
B	McPhilben 7-11 cast aluminum with cast guard.	200W A-23	Wall
C	McPhilben 43-89 cast aluminum with guard and with cast aluminum finishing collar to permit surface wiring.	(2) 100W A-19	Surface
D	Lite Control #6928HO with steel guard and white finish or equal by Lightron.	(2) F48T12/CW/HO	Surface

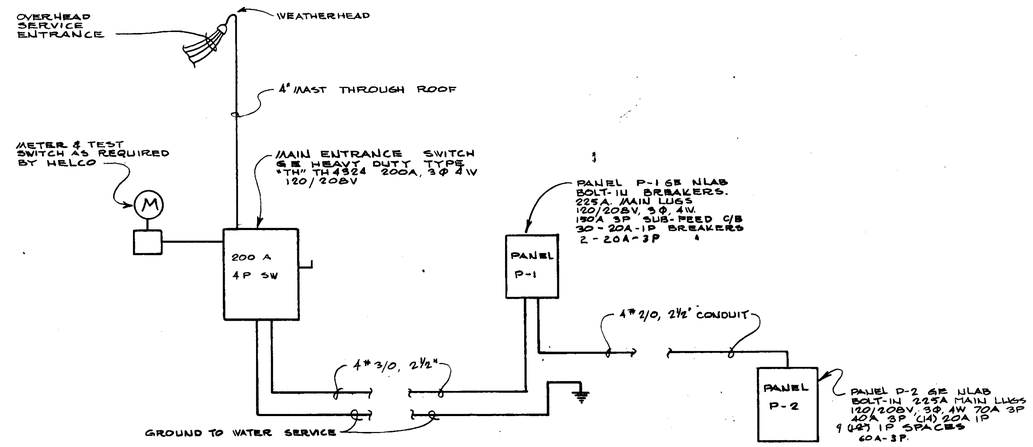

ELECTRIC RISER DIAGRAM

NOT TO SCALE

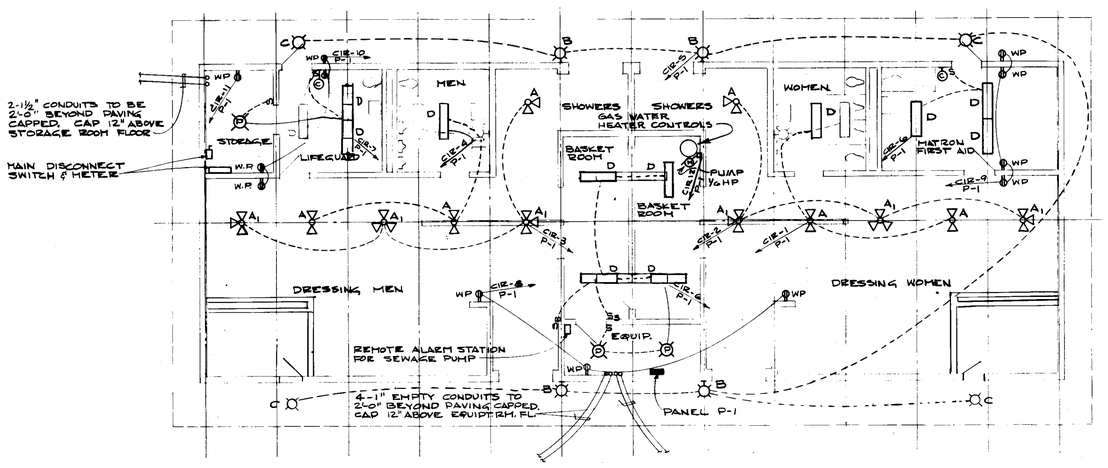

BATHHOUSE ELECTRIC PLAN

SCALE: 1/8"=1'-0"

REVISIONS

NO.	DATE	REMARKS

PROJECT TITLE

ASSOCIATED ARCHITECTS
FARMINGTON · CONNECTICUT · 06032

STRUCTURAL ENGINEER
BURTON & VAN HOUTEN
WEST HARTFORD CONNECTICUT

MECHANICAL ENGINEER
BURTON & VAN HOUTEN
WEST HARTFORD CONNECTICUT

LAND PLANNER
MAINE & TILLAPAUGH
WEST HARTFORD CONNECTICUT

CORRECT AS BUILT DEC. 20-72

STATE OF CONNECTICUT · BRUCE L. VAN HOUTEN · No. 6433 · REGISTERED PROFESSIONAL ENGINEER

SHEET TITLE
BATHHOUSE
ELECTRIC PLAN

PROJECT NO. 60470
DRAWN BY AY
CHECKED BY BSC
APPROVED BY BSC
DATE 11 SEPT 1970

SHEET NO.
E 1
SHEET 1 OF 2

BRUNING 11533