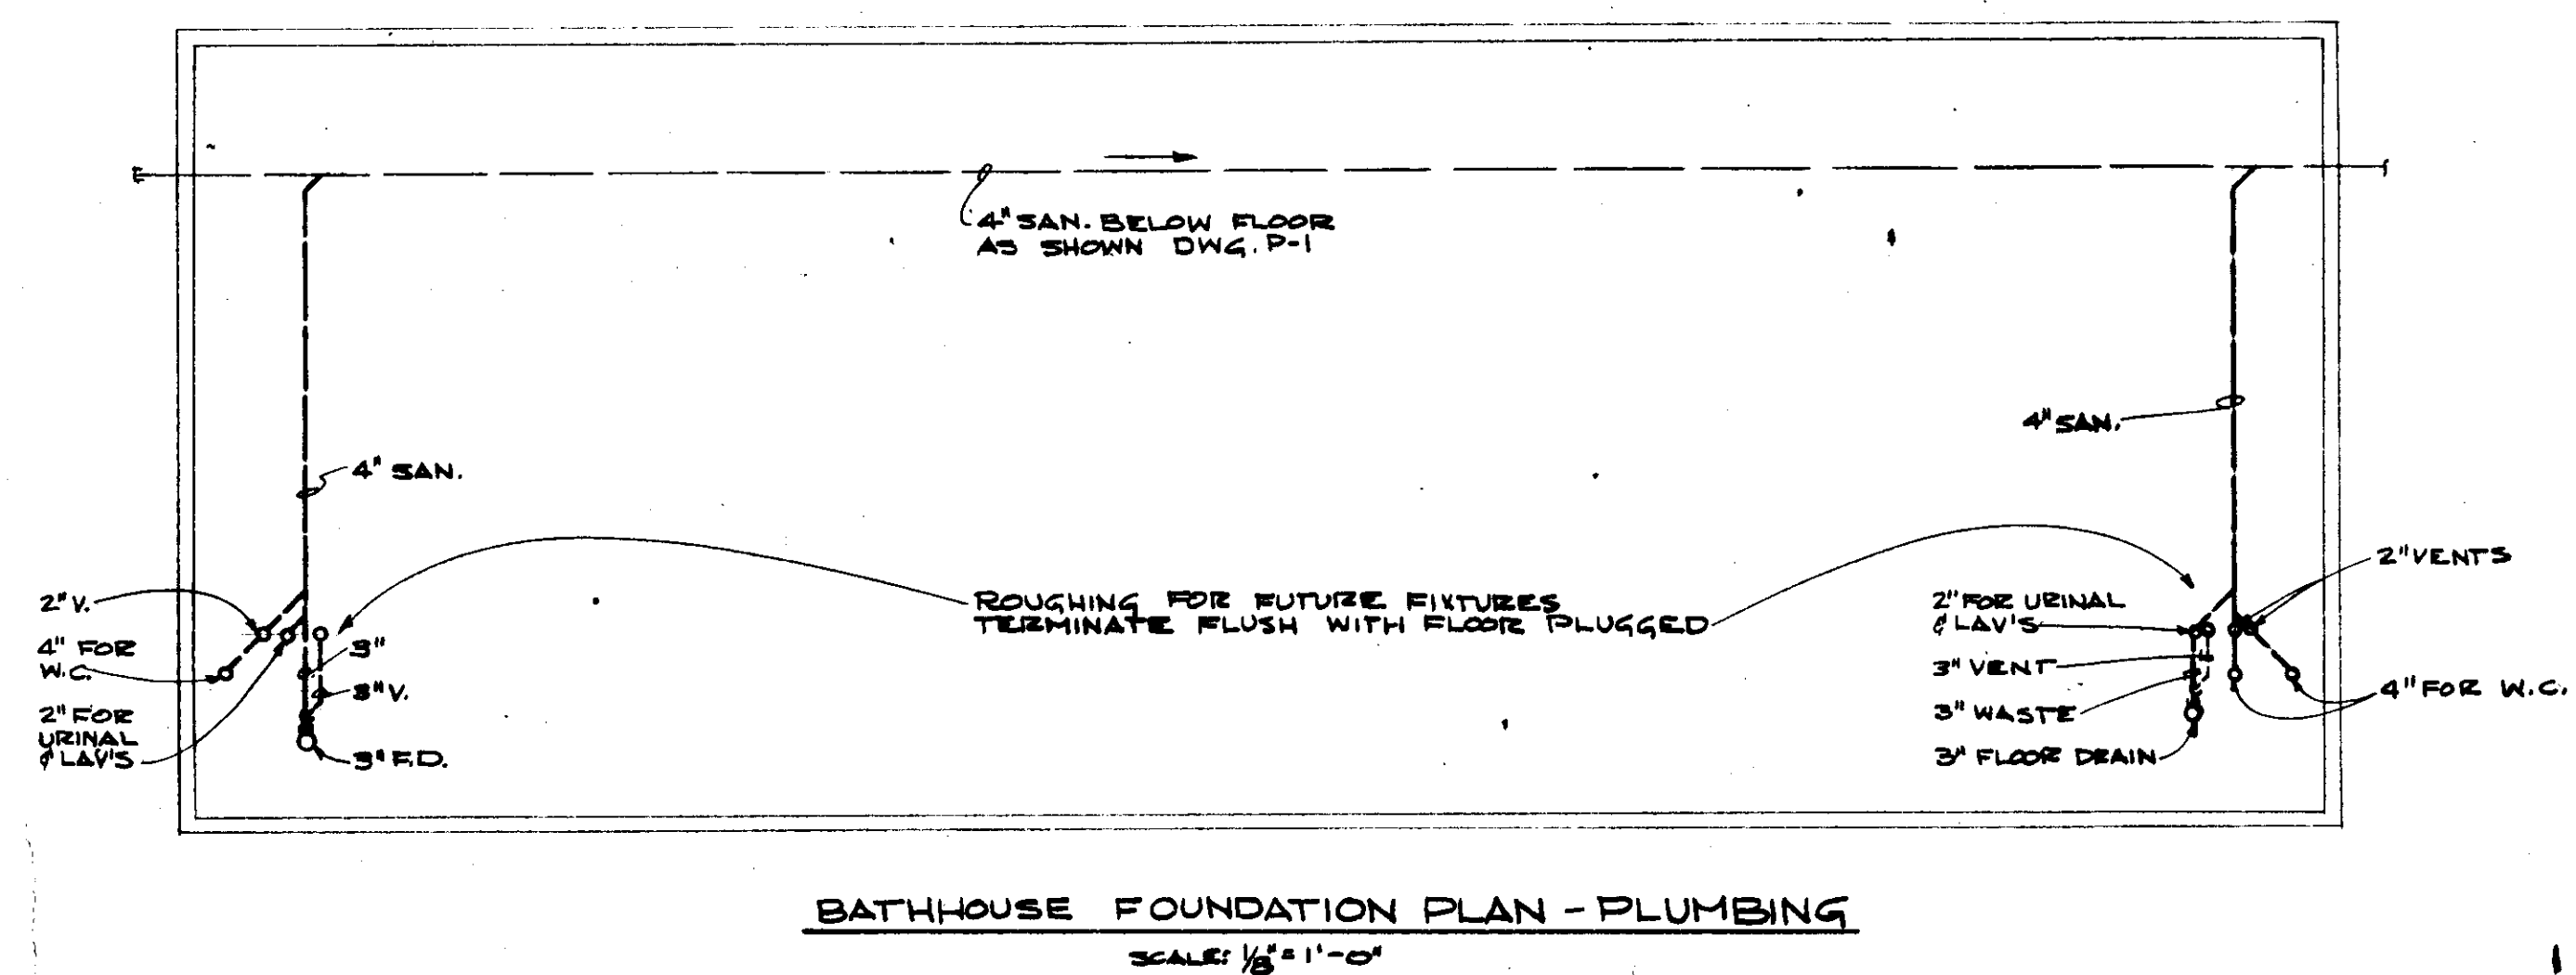
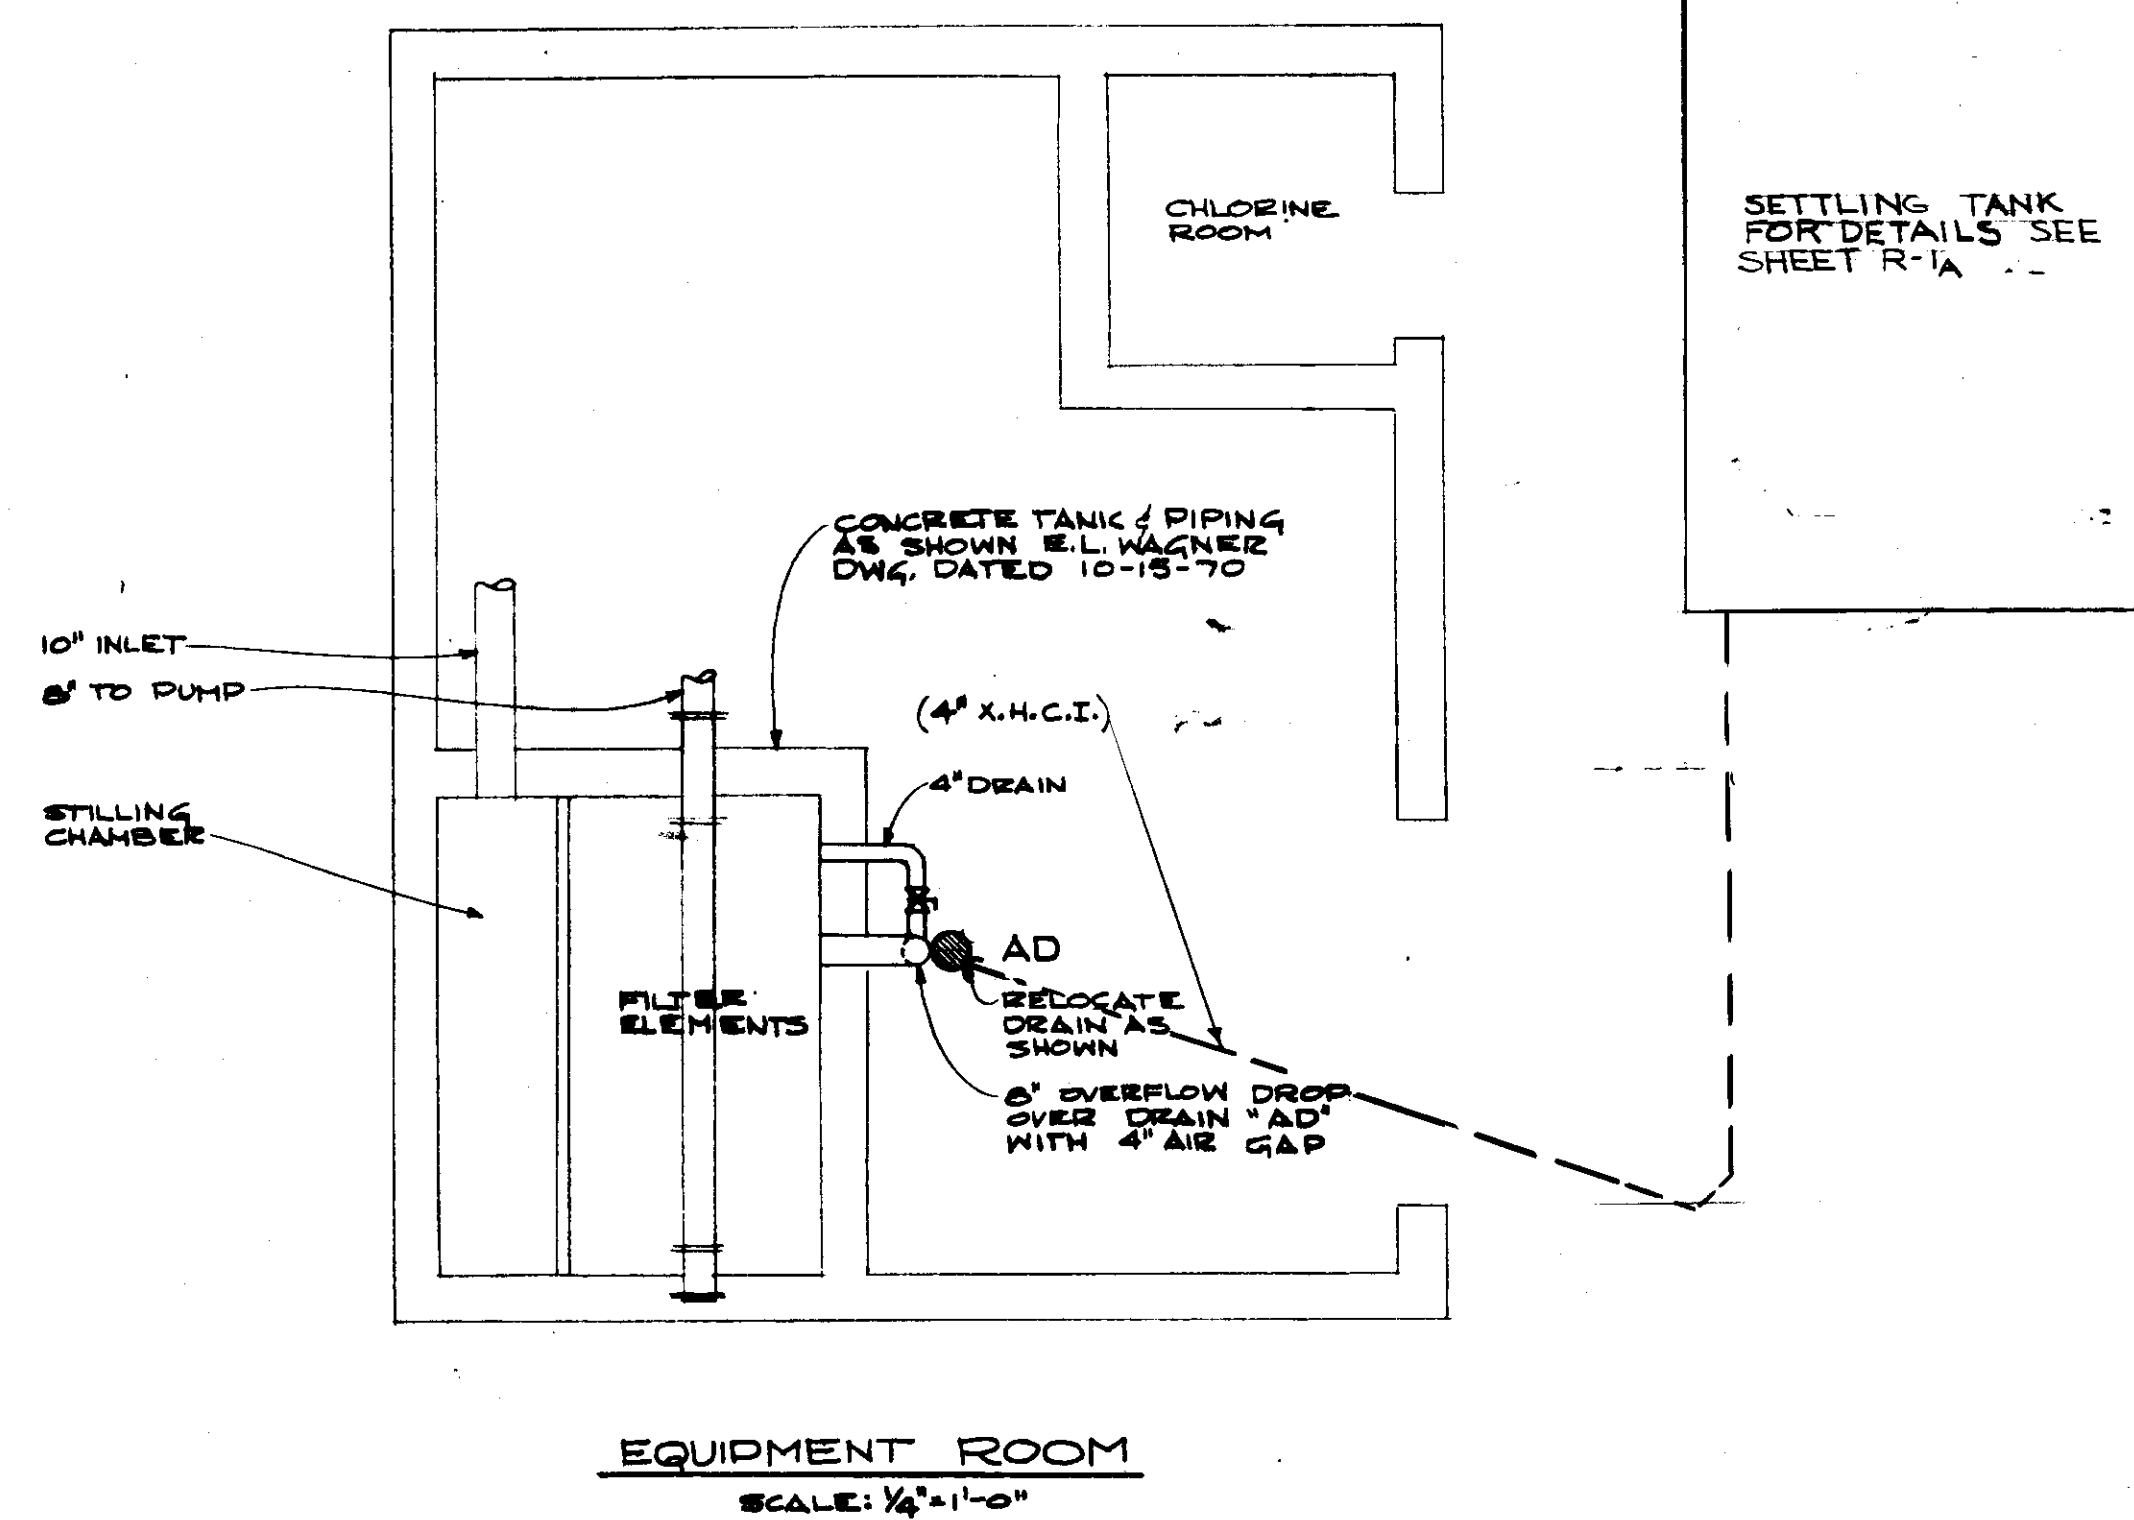
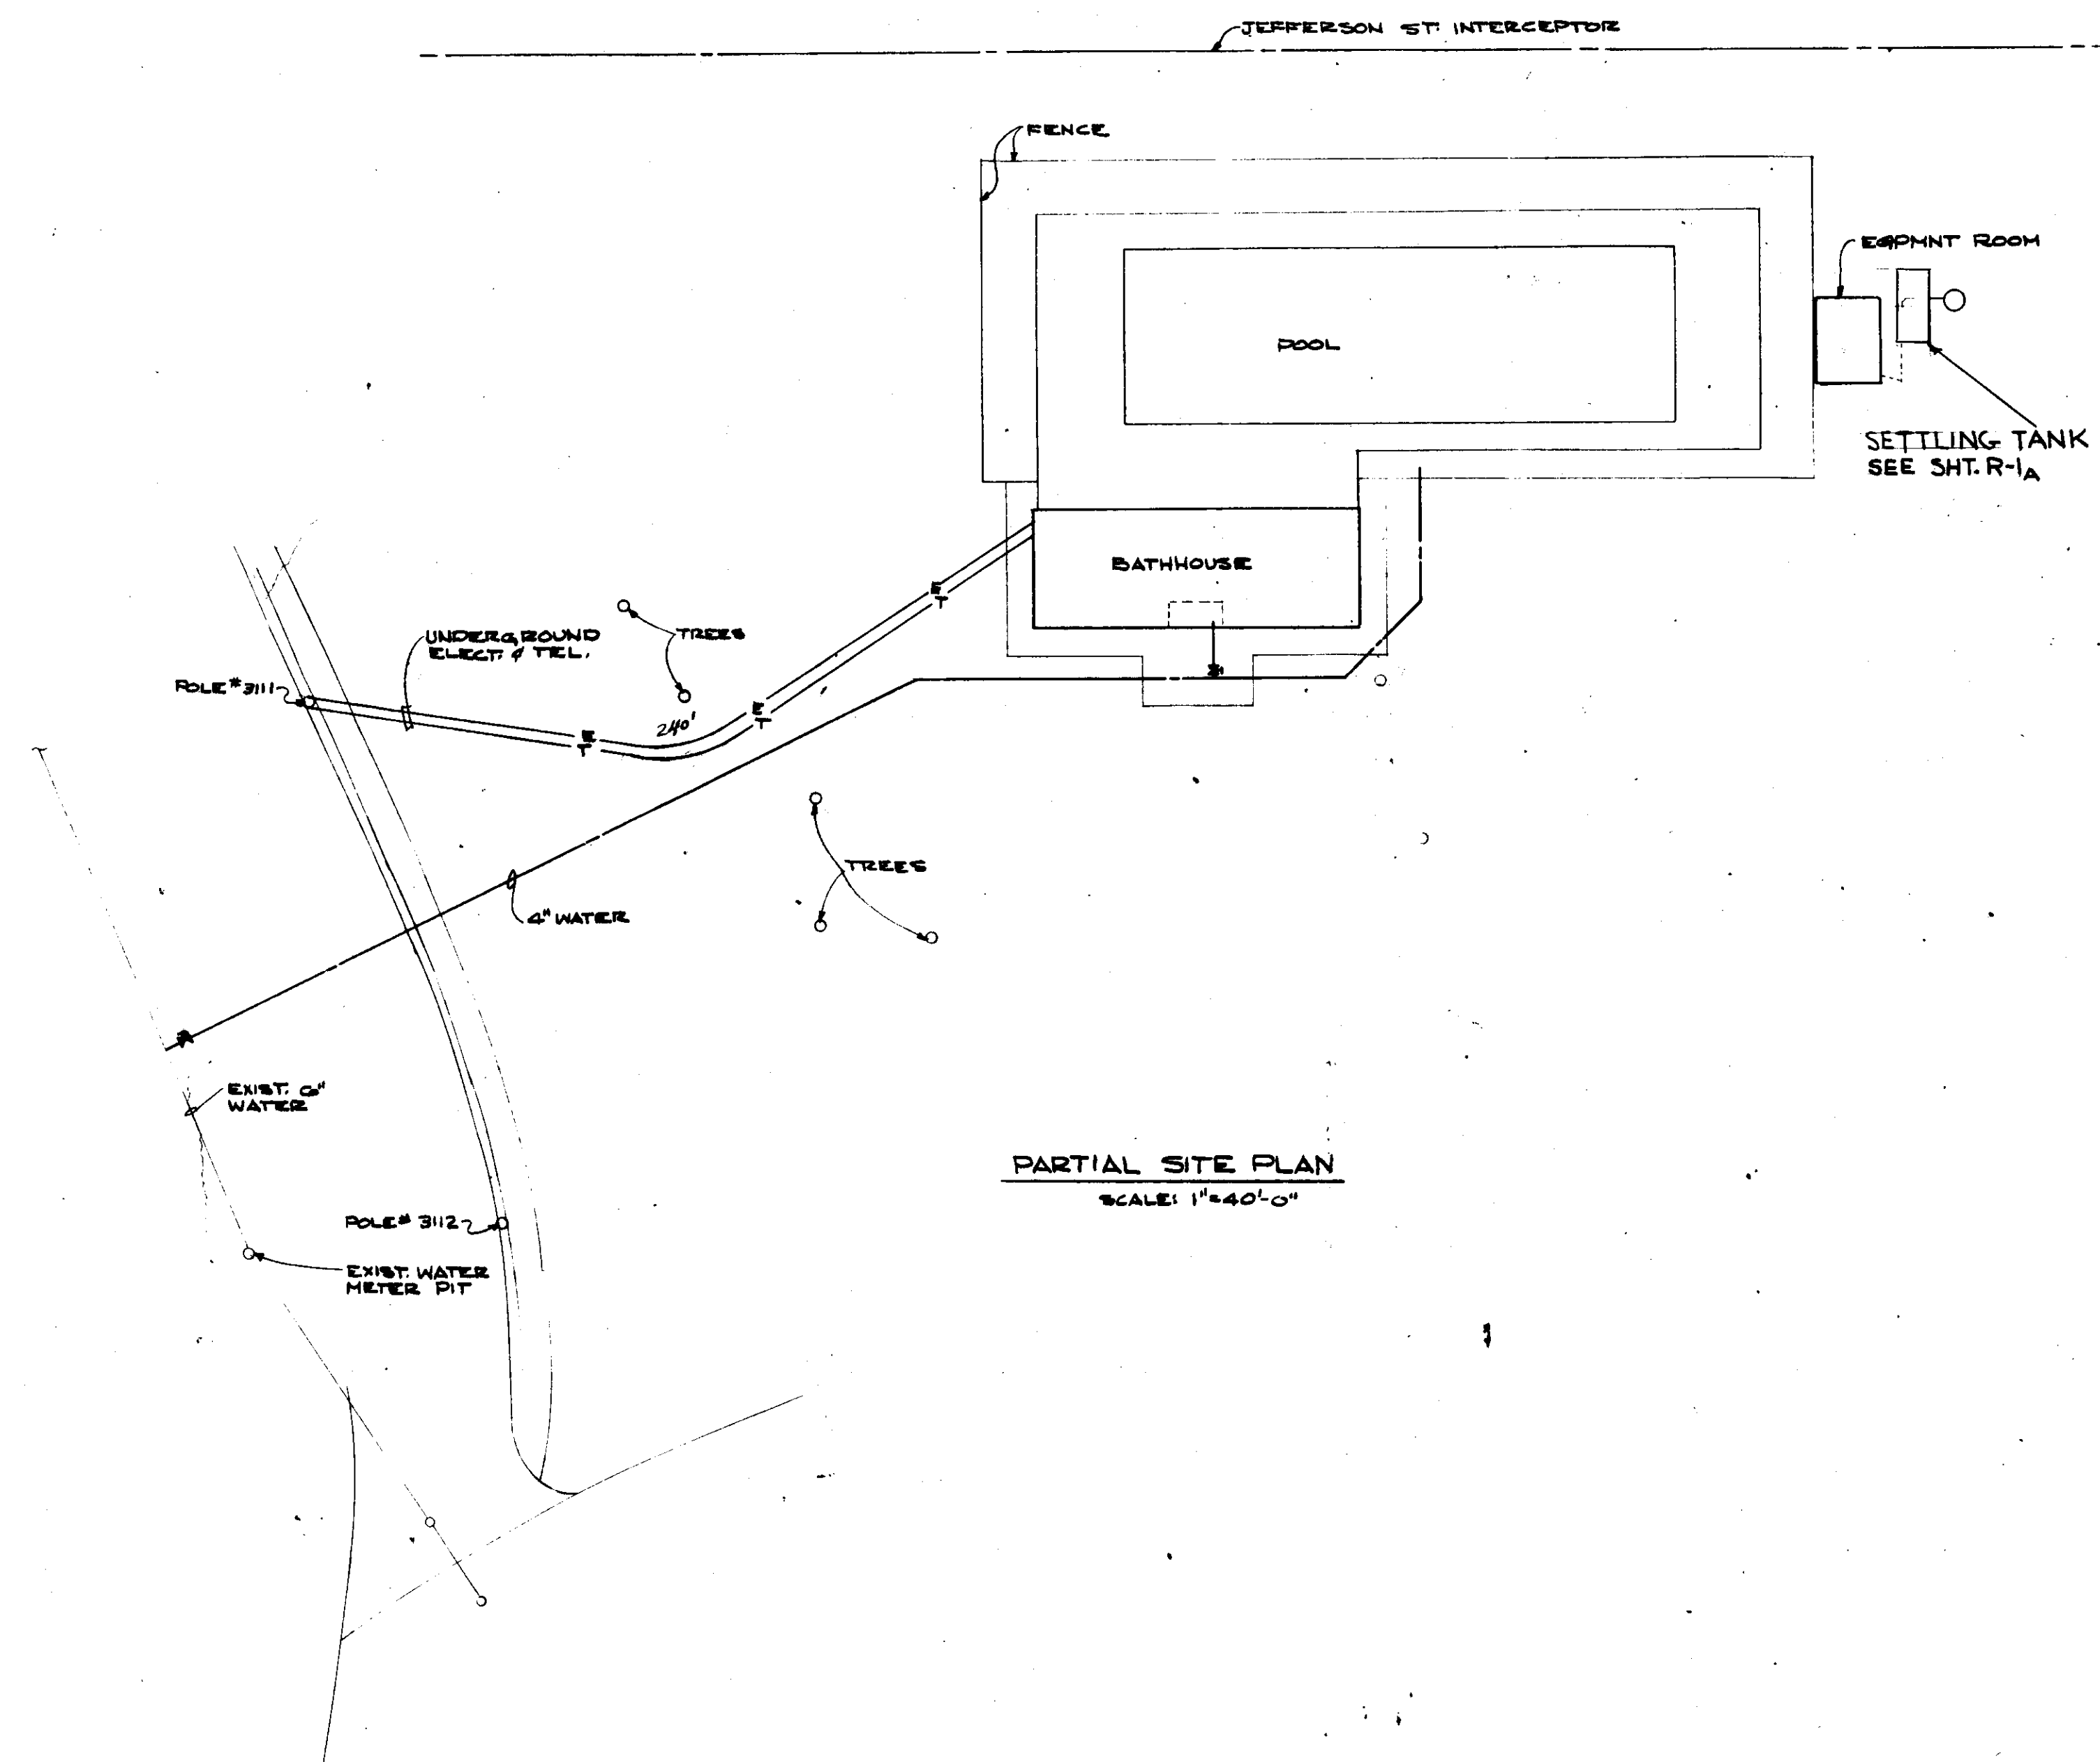


[illegible]