
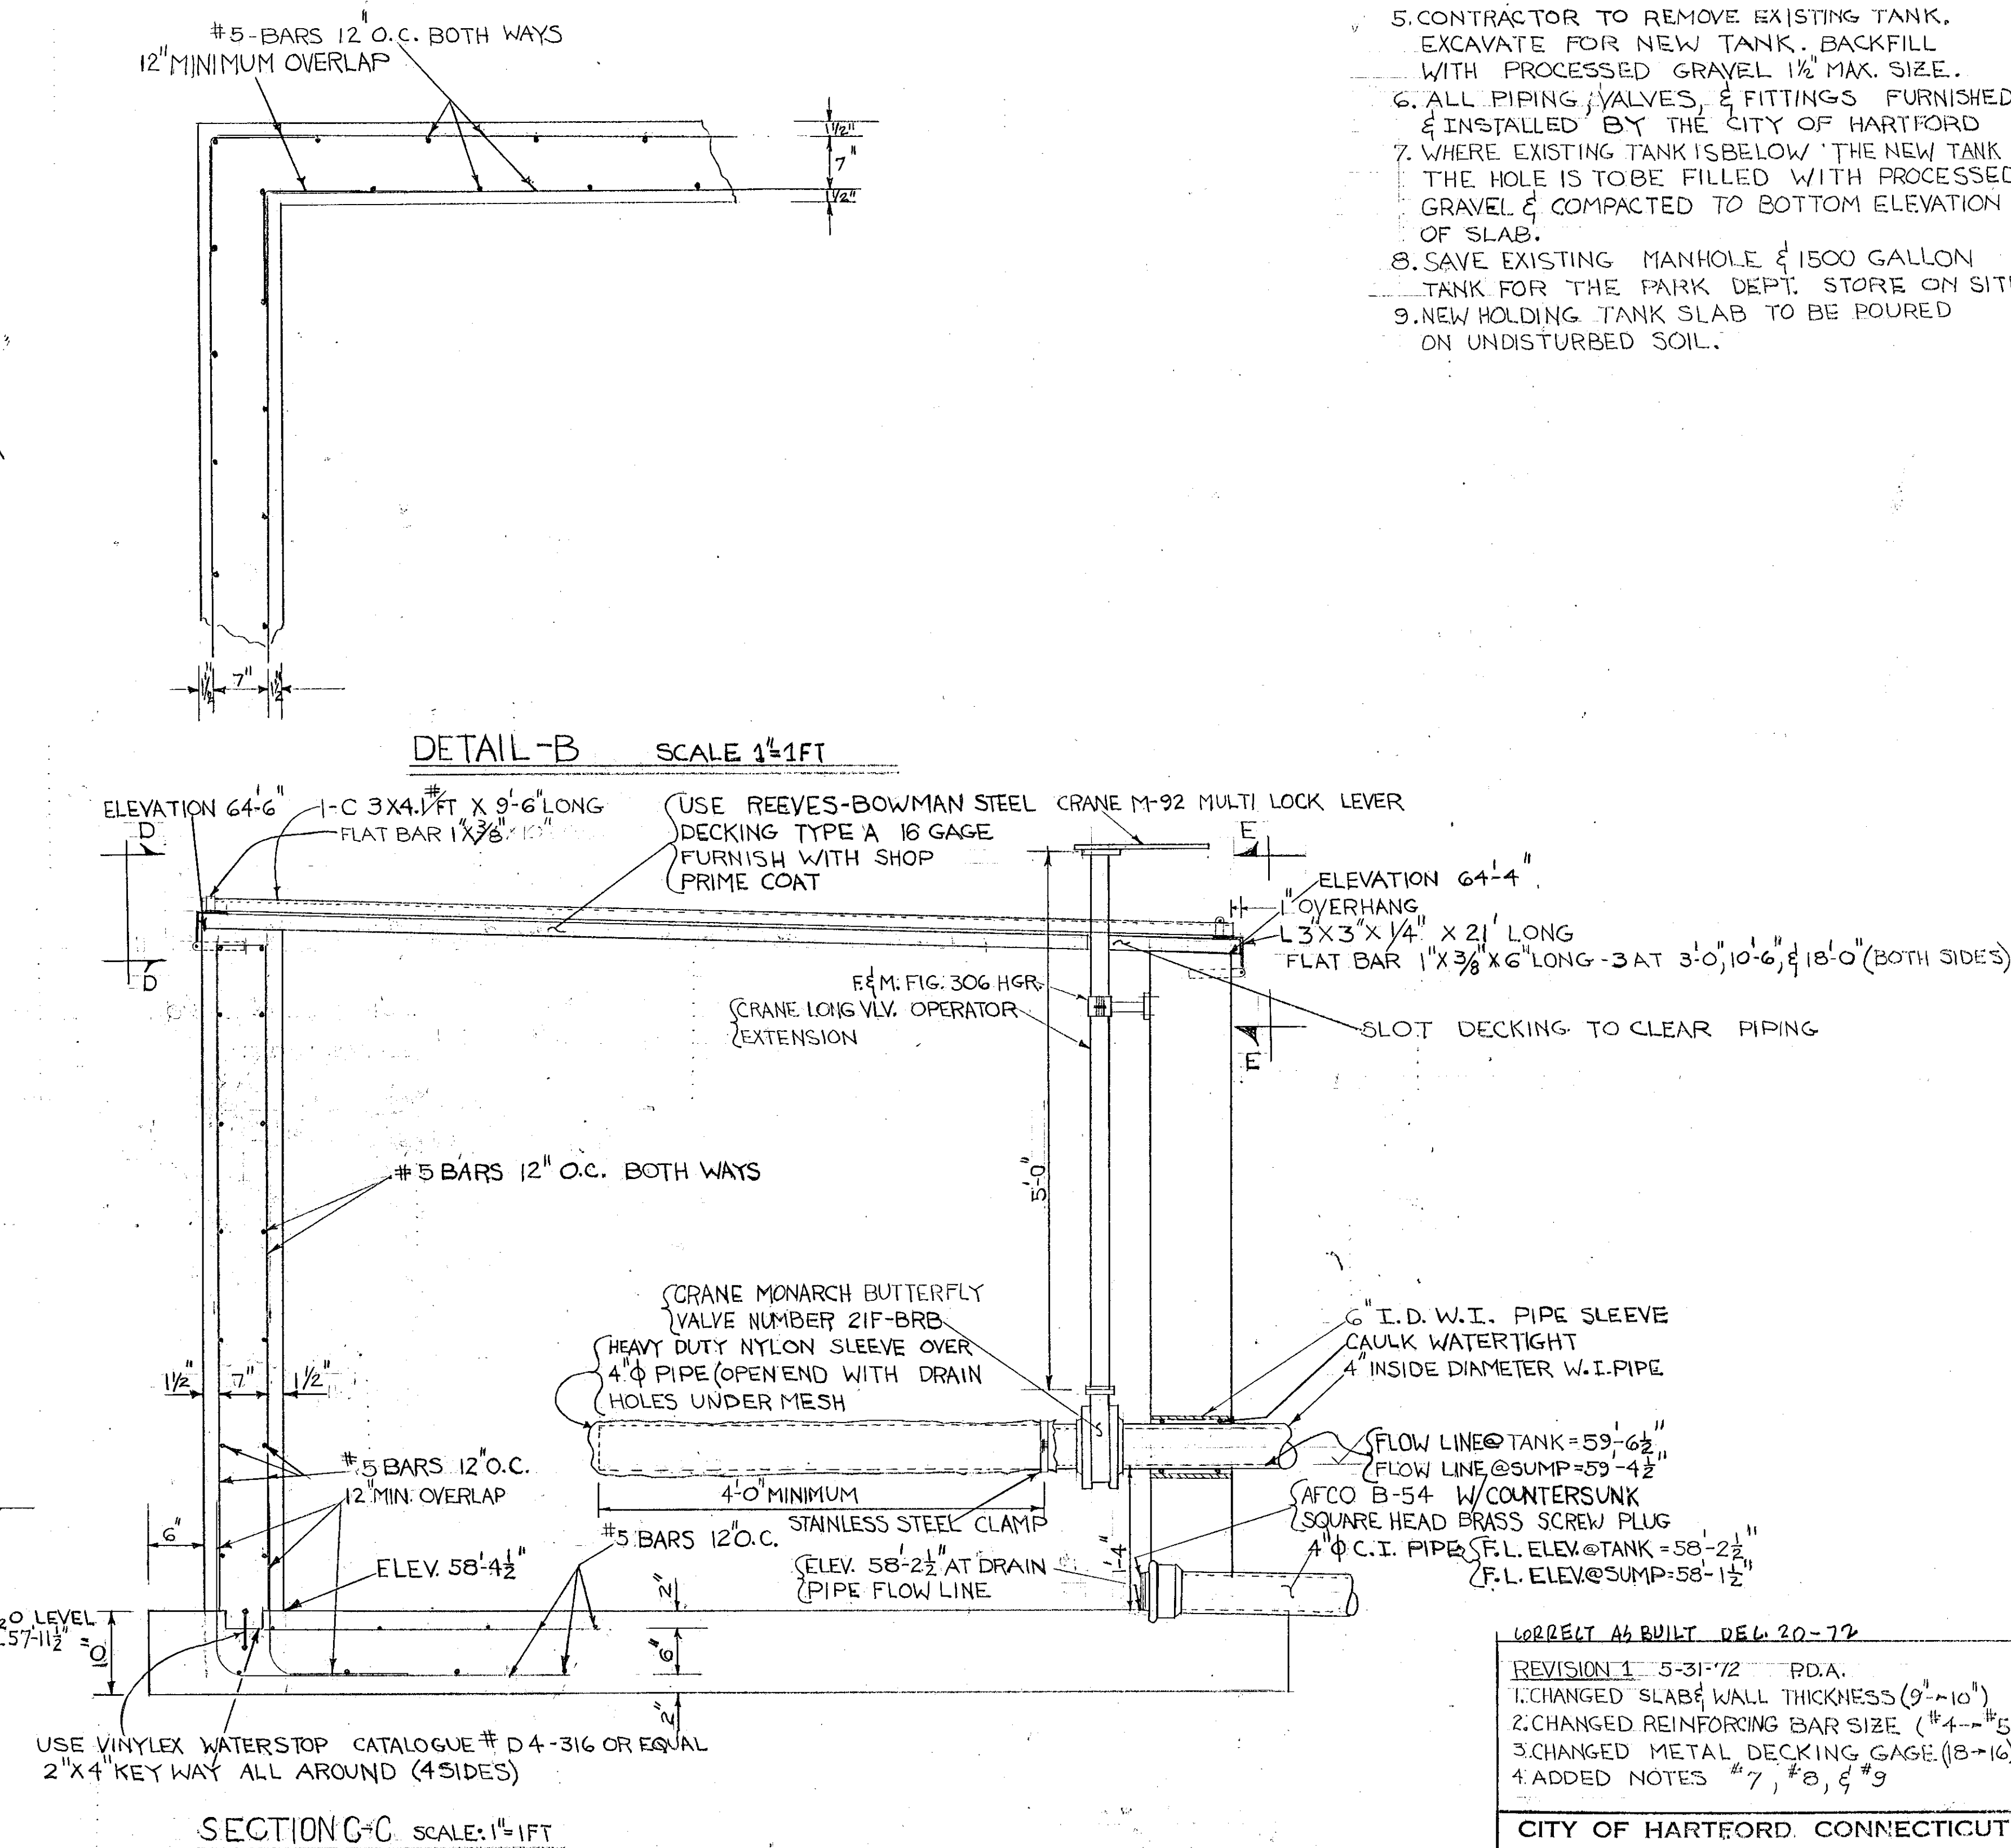
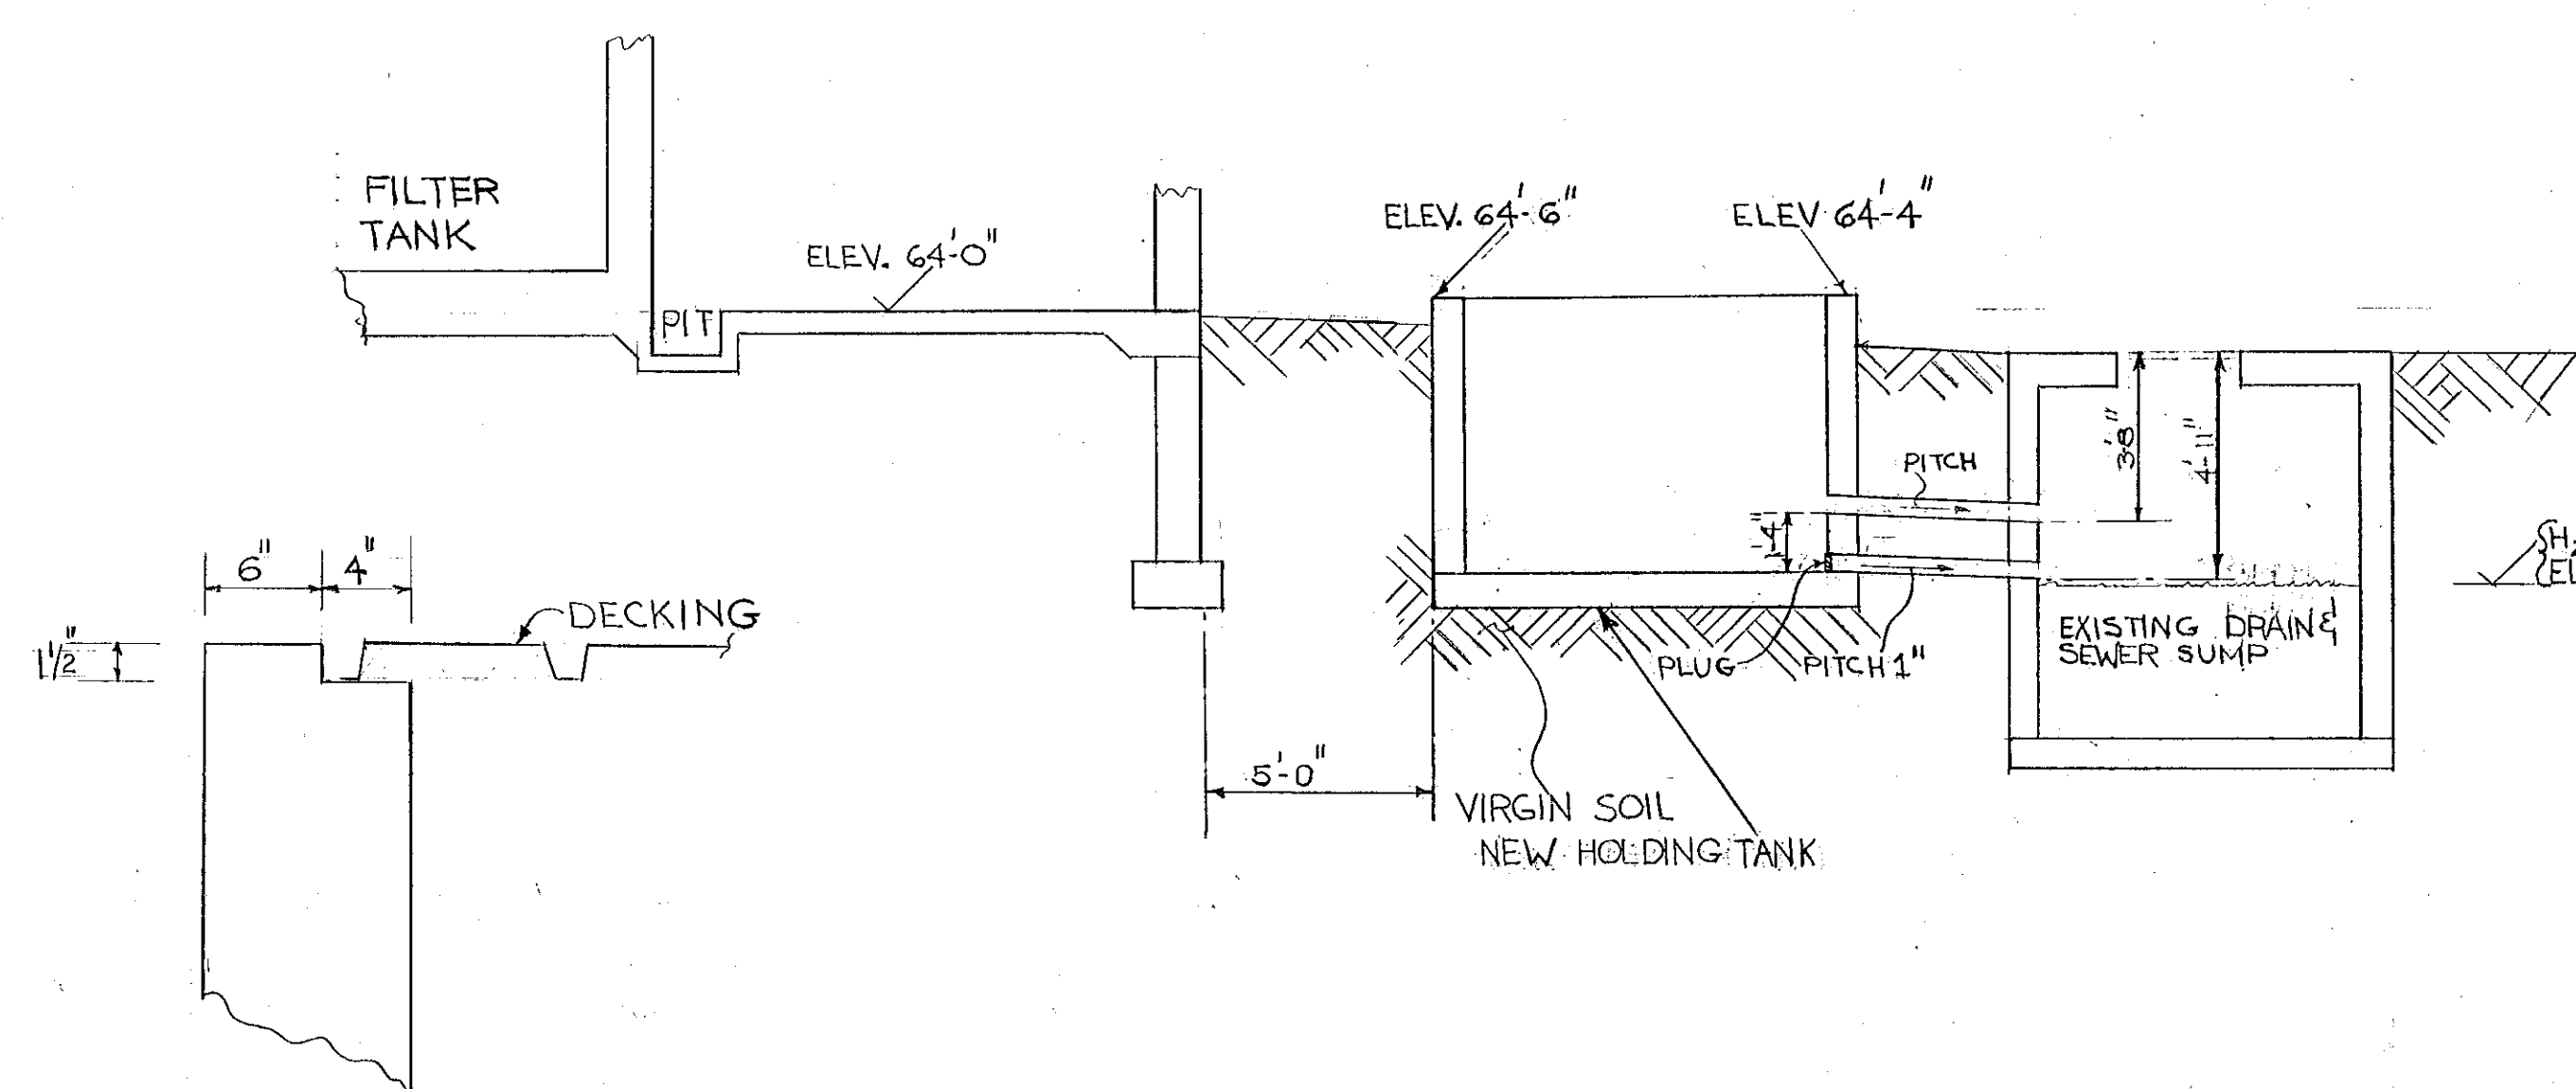


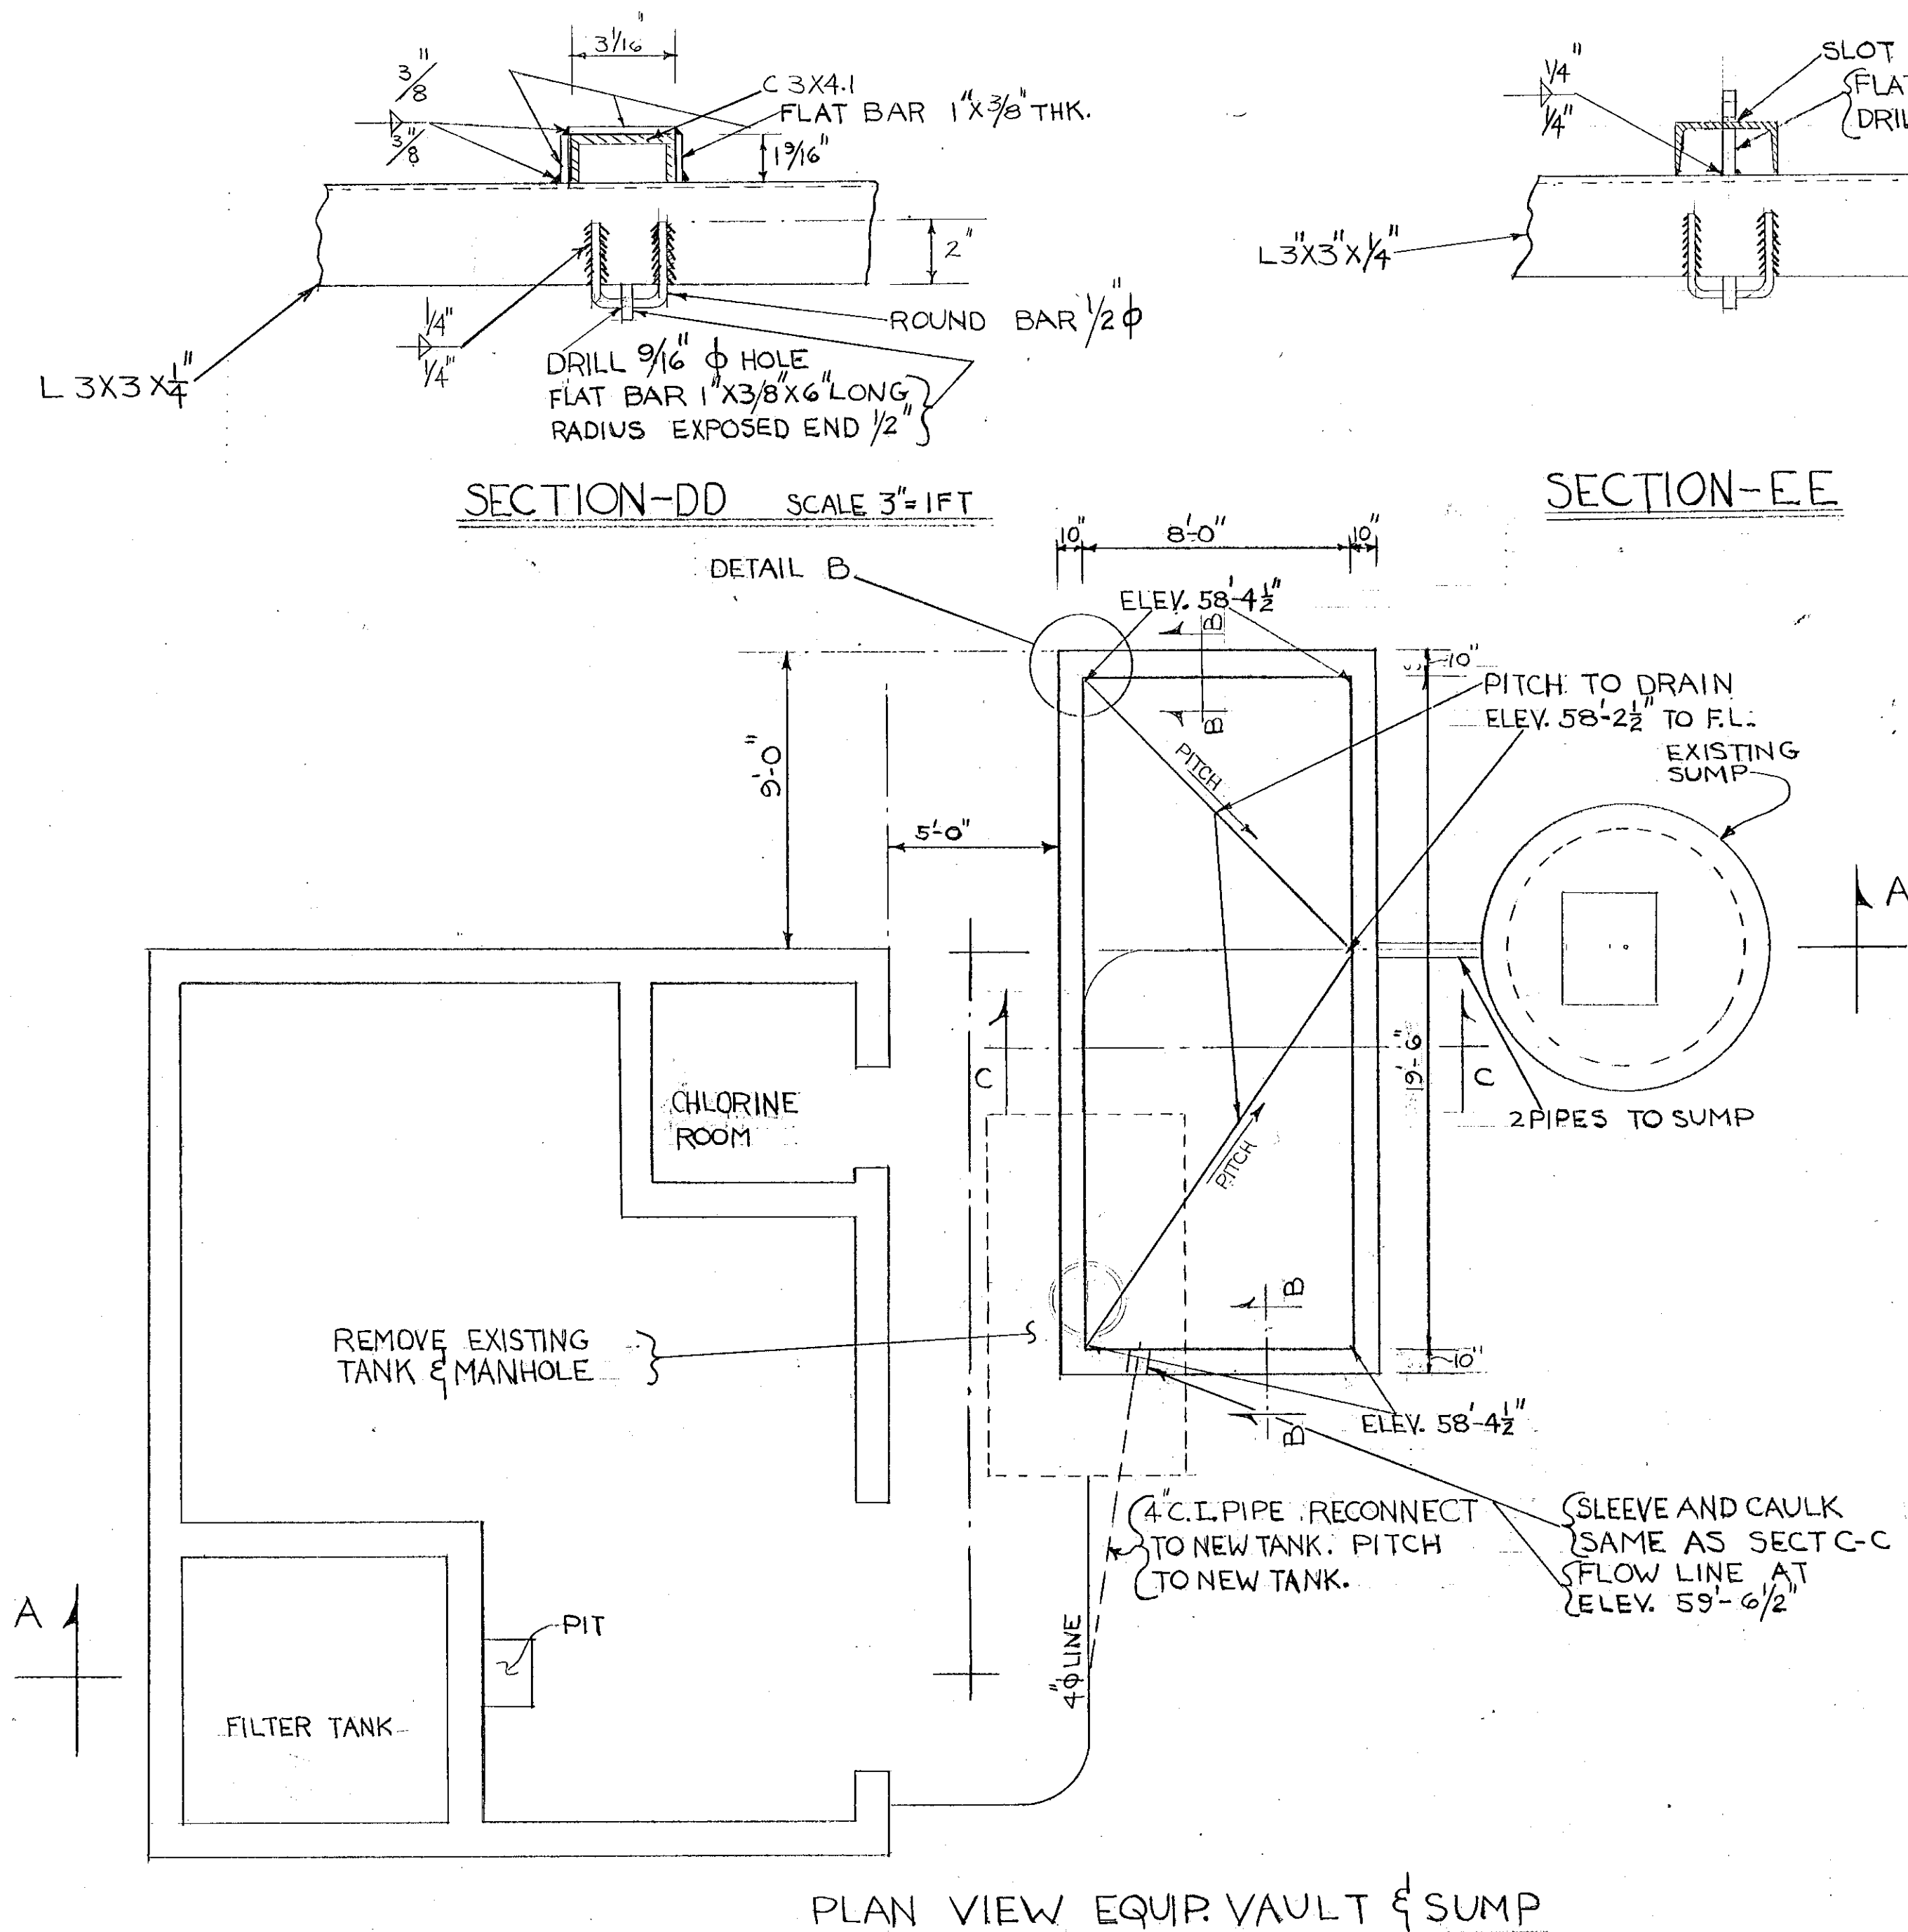

GENERAL NOTES

1. ALL CONCRETE TO BE CLASS A 3000 #/IN²
2. ALL REINFORCING STEEL TO BE ASTM-A305
3. ALL SHAPES TO BE ASTM A-36 STEEL
4. ALL WELDING IN ACCORDANCE WITH A.W.S. USE CLASS E-70 ELECTRODES.
5. CONTRACTOR TO REMOVE EXISTING TANK. EXCAVATE FOR NEW TANK. BACKFILL WITH PROCESSED GRAVEL 1 1/2" MAX. SIZE.
6. ALL PIPING, VALVES, & FITTINGS FURNISHED & INSTALLED BY THE CITY OF HARTFORD
7. WHERE EXISTING TANK IS BELOW THE NEW TANK THE HOLE IS TO BE FILLED WITH PROCESSED GRAVEL & COMPACTED TO BOTTOM ELEVATION OF SLAB.
8. SAVE EXISTING MANHOLE & 1500 GALLON TANK FOR THE PARK DEPT. STORE ON SITE.
9. NEW HOLDING TANK SLAB TO BE POURED ON UNDISTURBED SOIL.

REVISION 1 5-31-72 P.D.A.

1. CHANGED SLAB & WALL THICKNESS (9" - 10")
2. CHANGED REINFORCING BAR SIZE (#4 - #5)
3. CHANGED METAL DECKING GAGE (18 - 16)
4. ADDED NOTES #7, #8, & #9

CITY OF HARTFORD, CONNECTICUT
DEPARTMENT OF ENGINEERING

SETTLING TANK AT POPE PARK POOL

DWG. No. R1A

SUBMITTED	RECOMMENDED	APPROVED
DESIGN PDA	DRAWN PDA	DAYBOOK NO.
TRACED	CHECK	DATE 5/24/72

VERIFY EXISTING
CONDITIONS AND
DIMENSIONS AT
BUILDING