


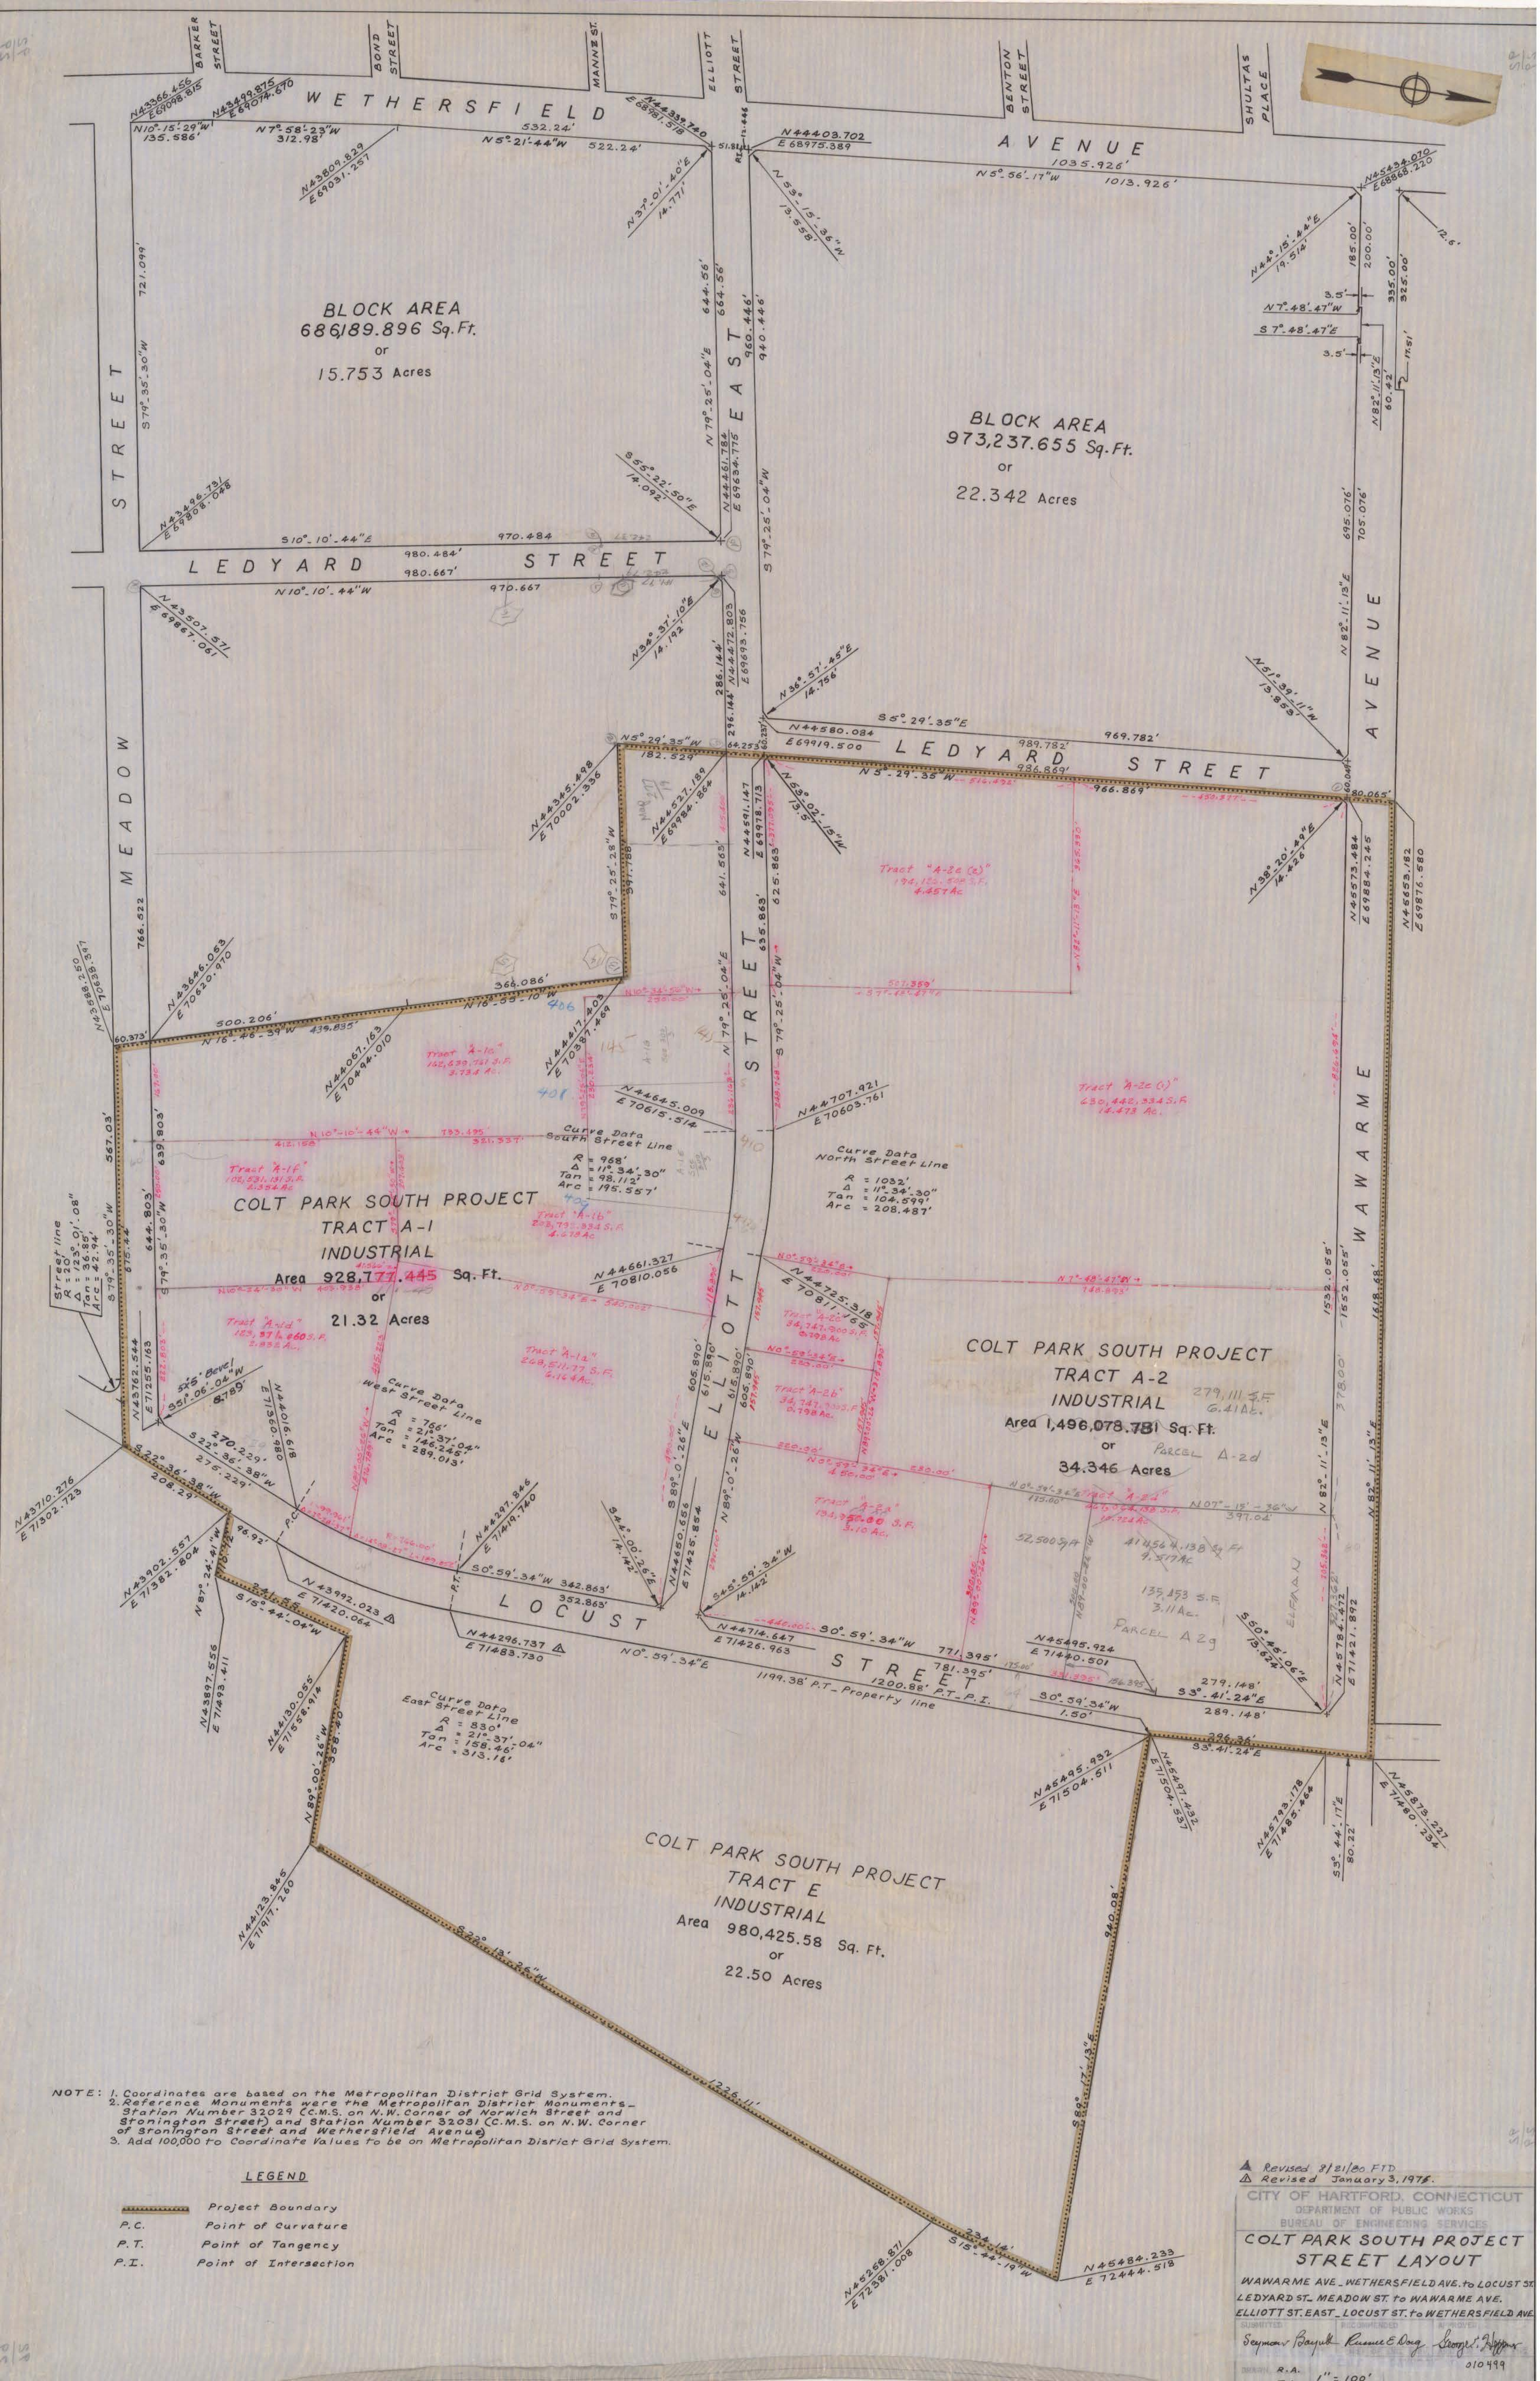

NOTE: 1. Coordinates are based on the Metropolitan District Grid System.
2. Reference Monuments were the Metropolitan District Monuments - Station Number 32029 C.M.S. on N.W. Corner of Norwich Street and Stonington Street and Station Number 32031 C.M.S. on N.W. Corner of Stonington Street and Wethersfield Avenue.
3. Add 100,000 to Coordinate Values to be on Metropolitan District Grid System.

LEGEND

Project Boundary
P.C. Point of Curvature
P.T. Point of Tangency
P.I. Point of Intersection

Revised 3/21/80 FTD
Revised January 3, 1978.

CITY OF HARTFORD, CONNECTICUT
DEPARTMENT OF PUBLIC WORKS
BUREAU OF ENGINEERING SERVICES
COLT PARK SOUTH PROJECT
STREET LAYOUT

WAWARME AVE. WETHERSFIELD AVE. TO LOCUST ST.
LEDYARD ST. MEADOW ST. TO WAWARME AVE.
ELLIOTT ST. EAST. LOCUST ST. TO WETHERSFIELD AVE.

Submitted: [Signature]
Reviewed: [Signature]
Approved: [Signature]
R.A. 1" = 100'
010499