


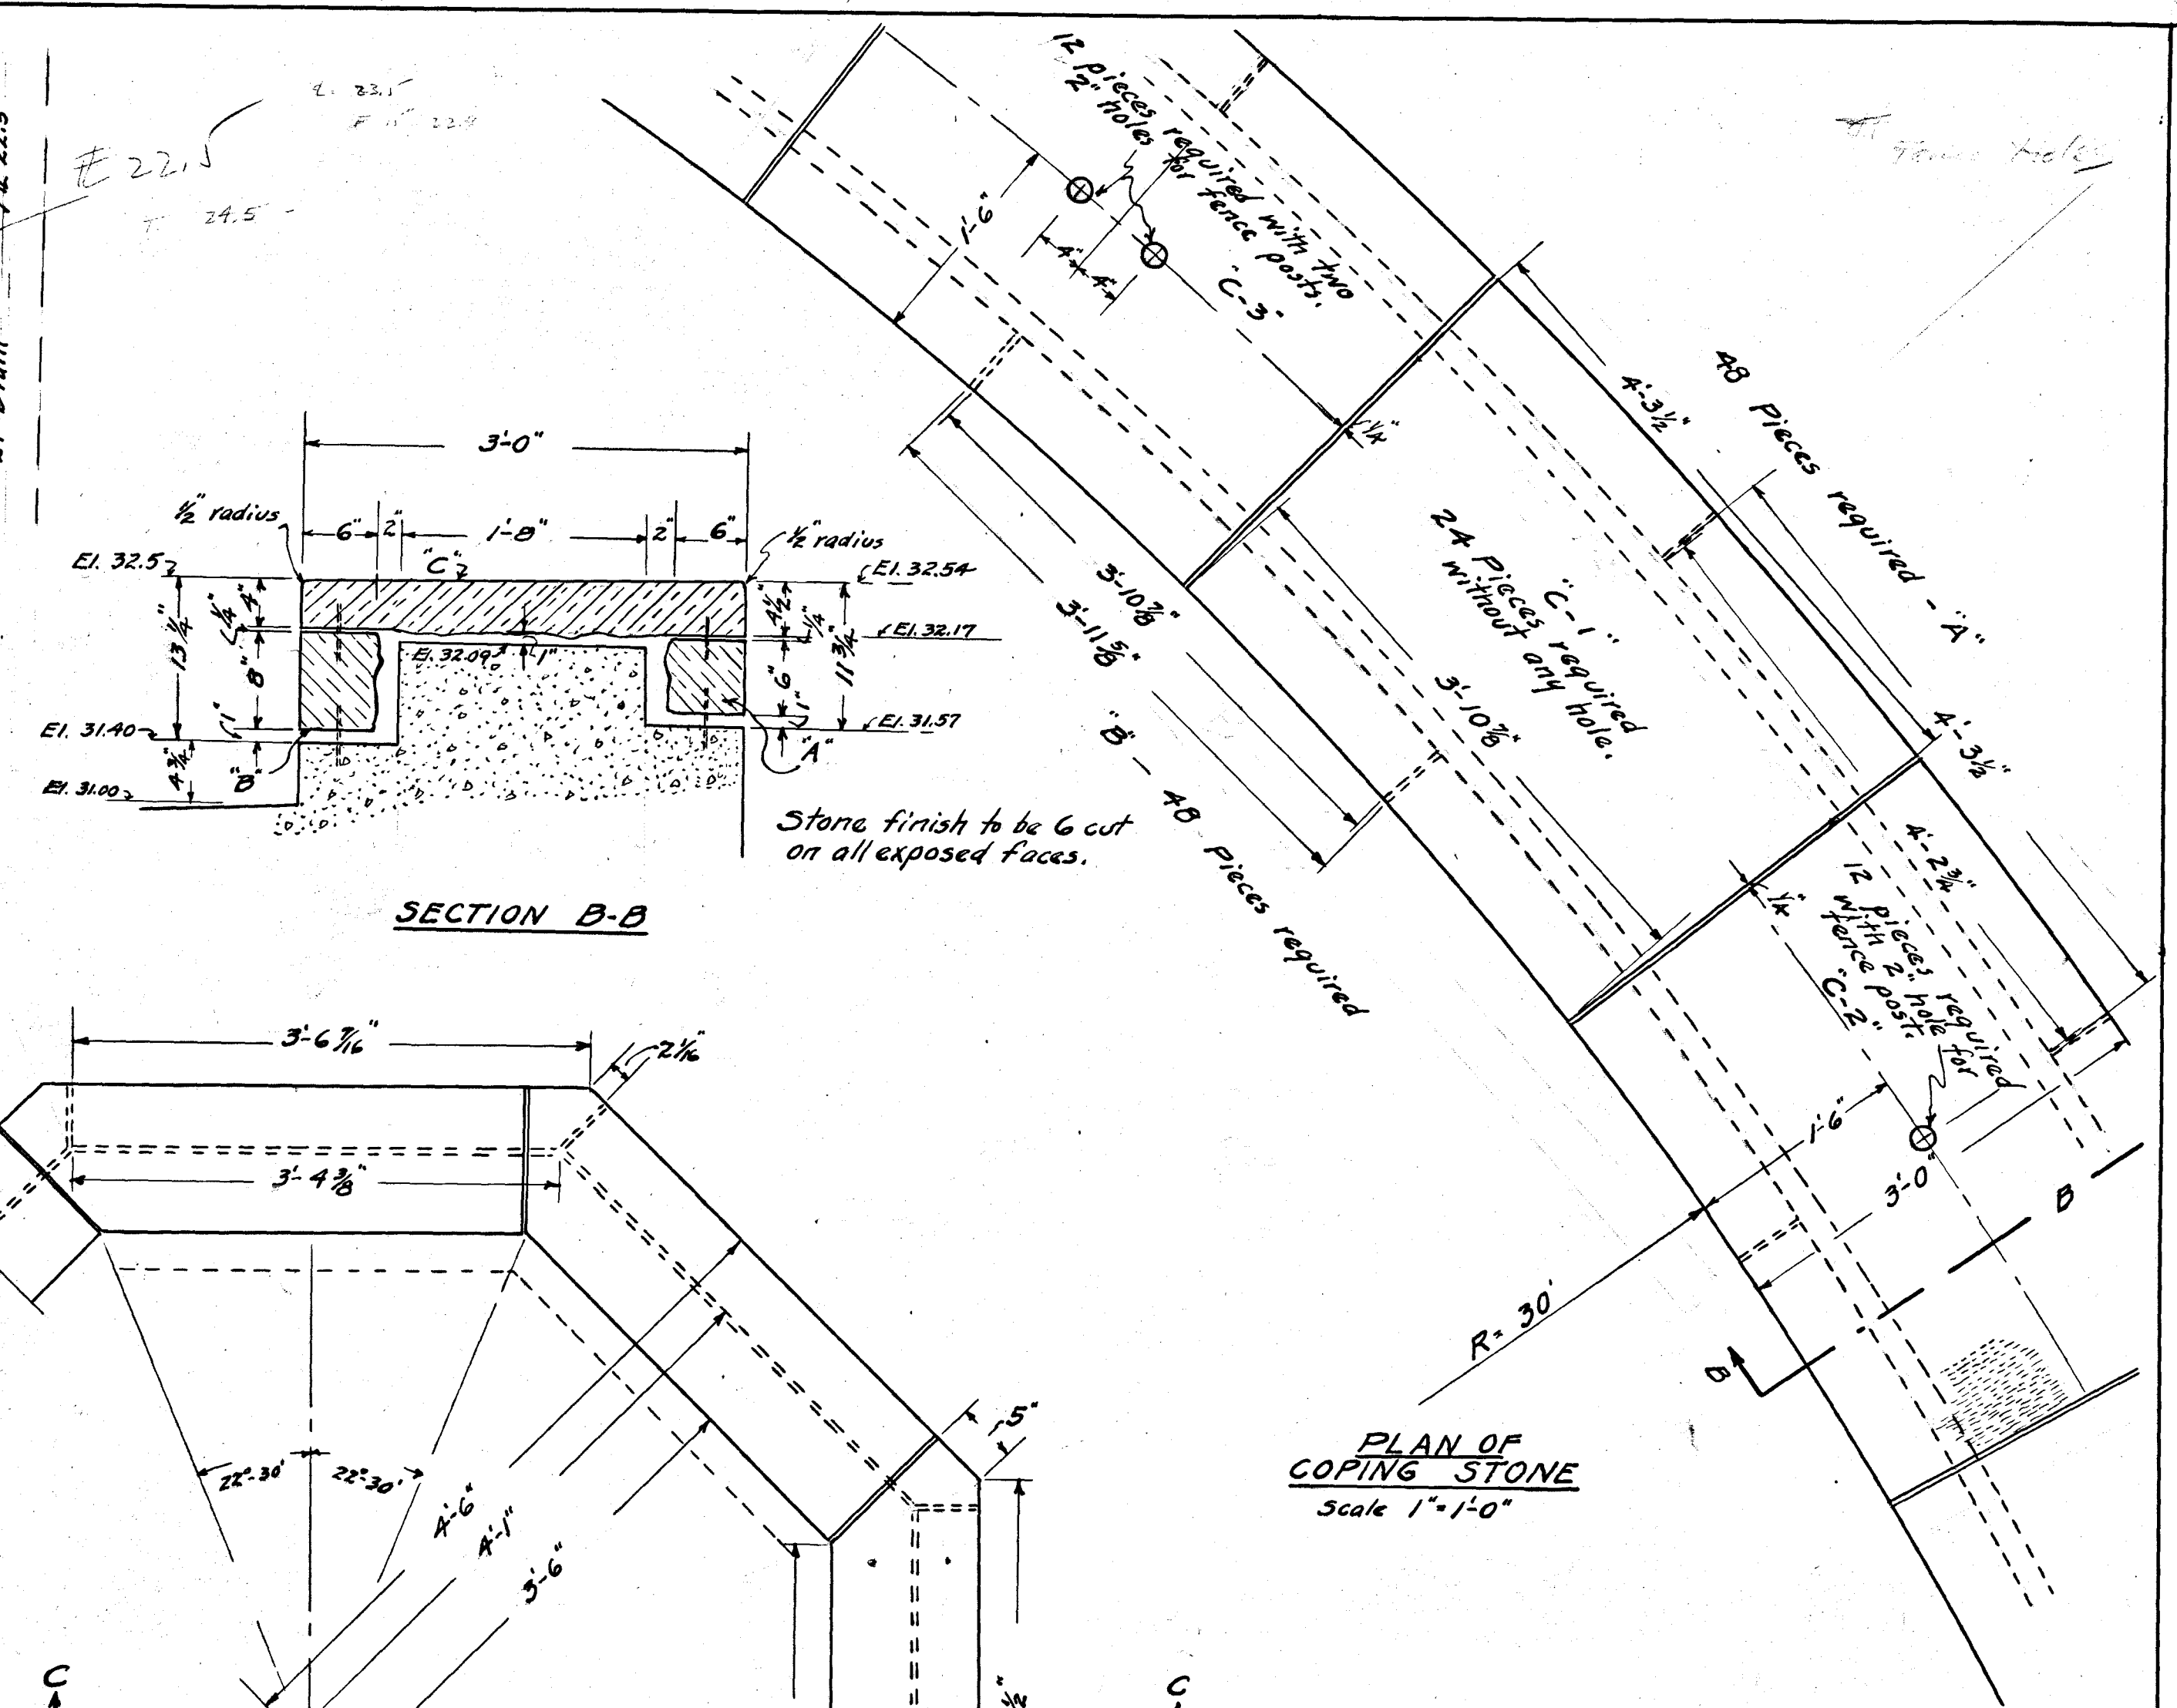
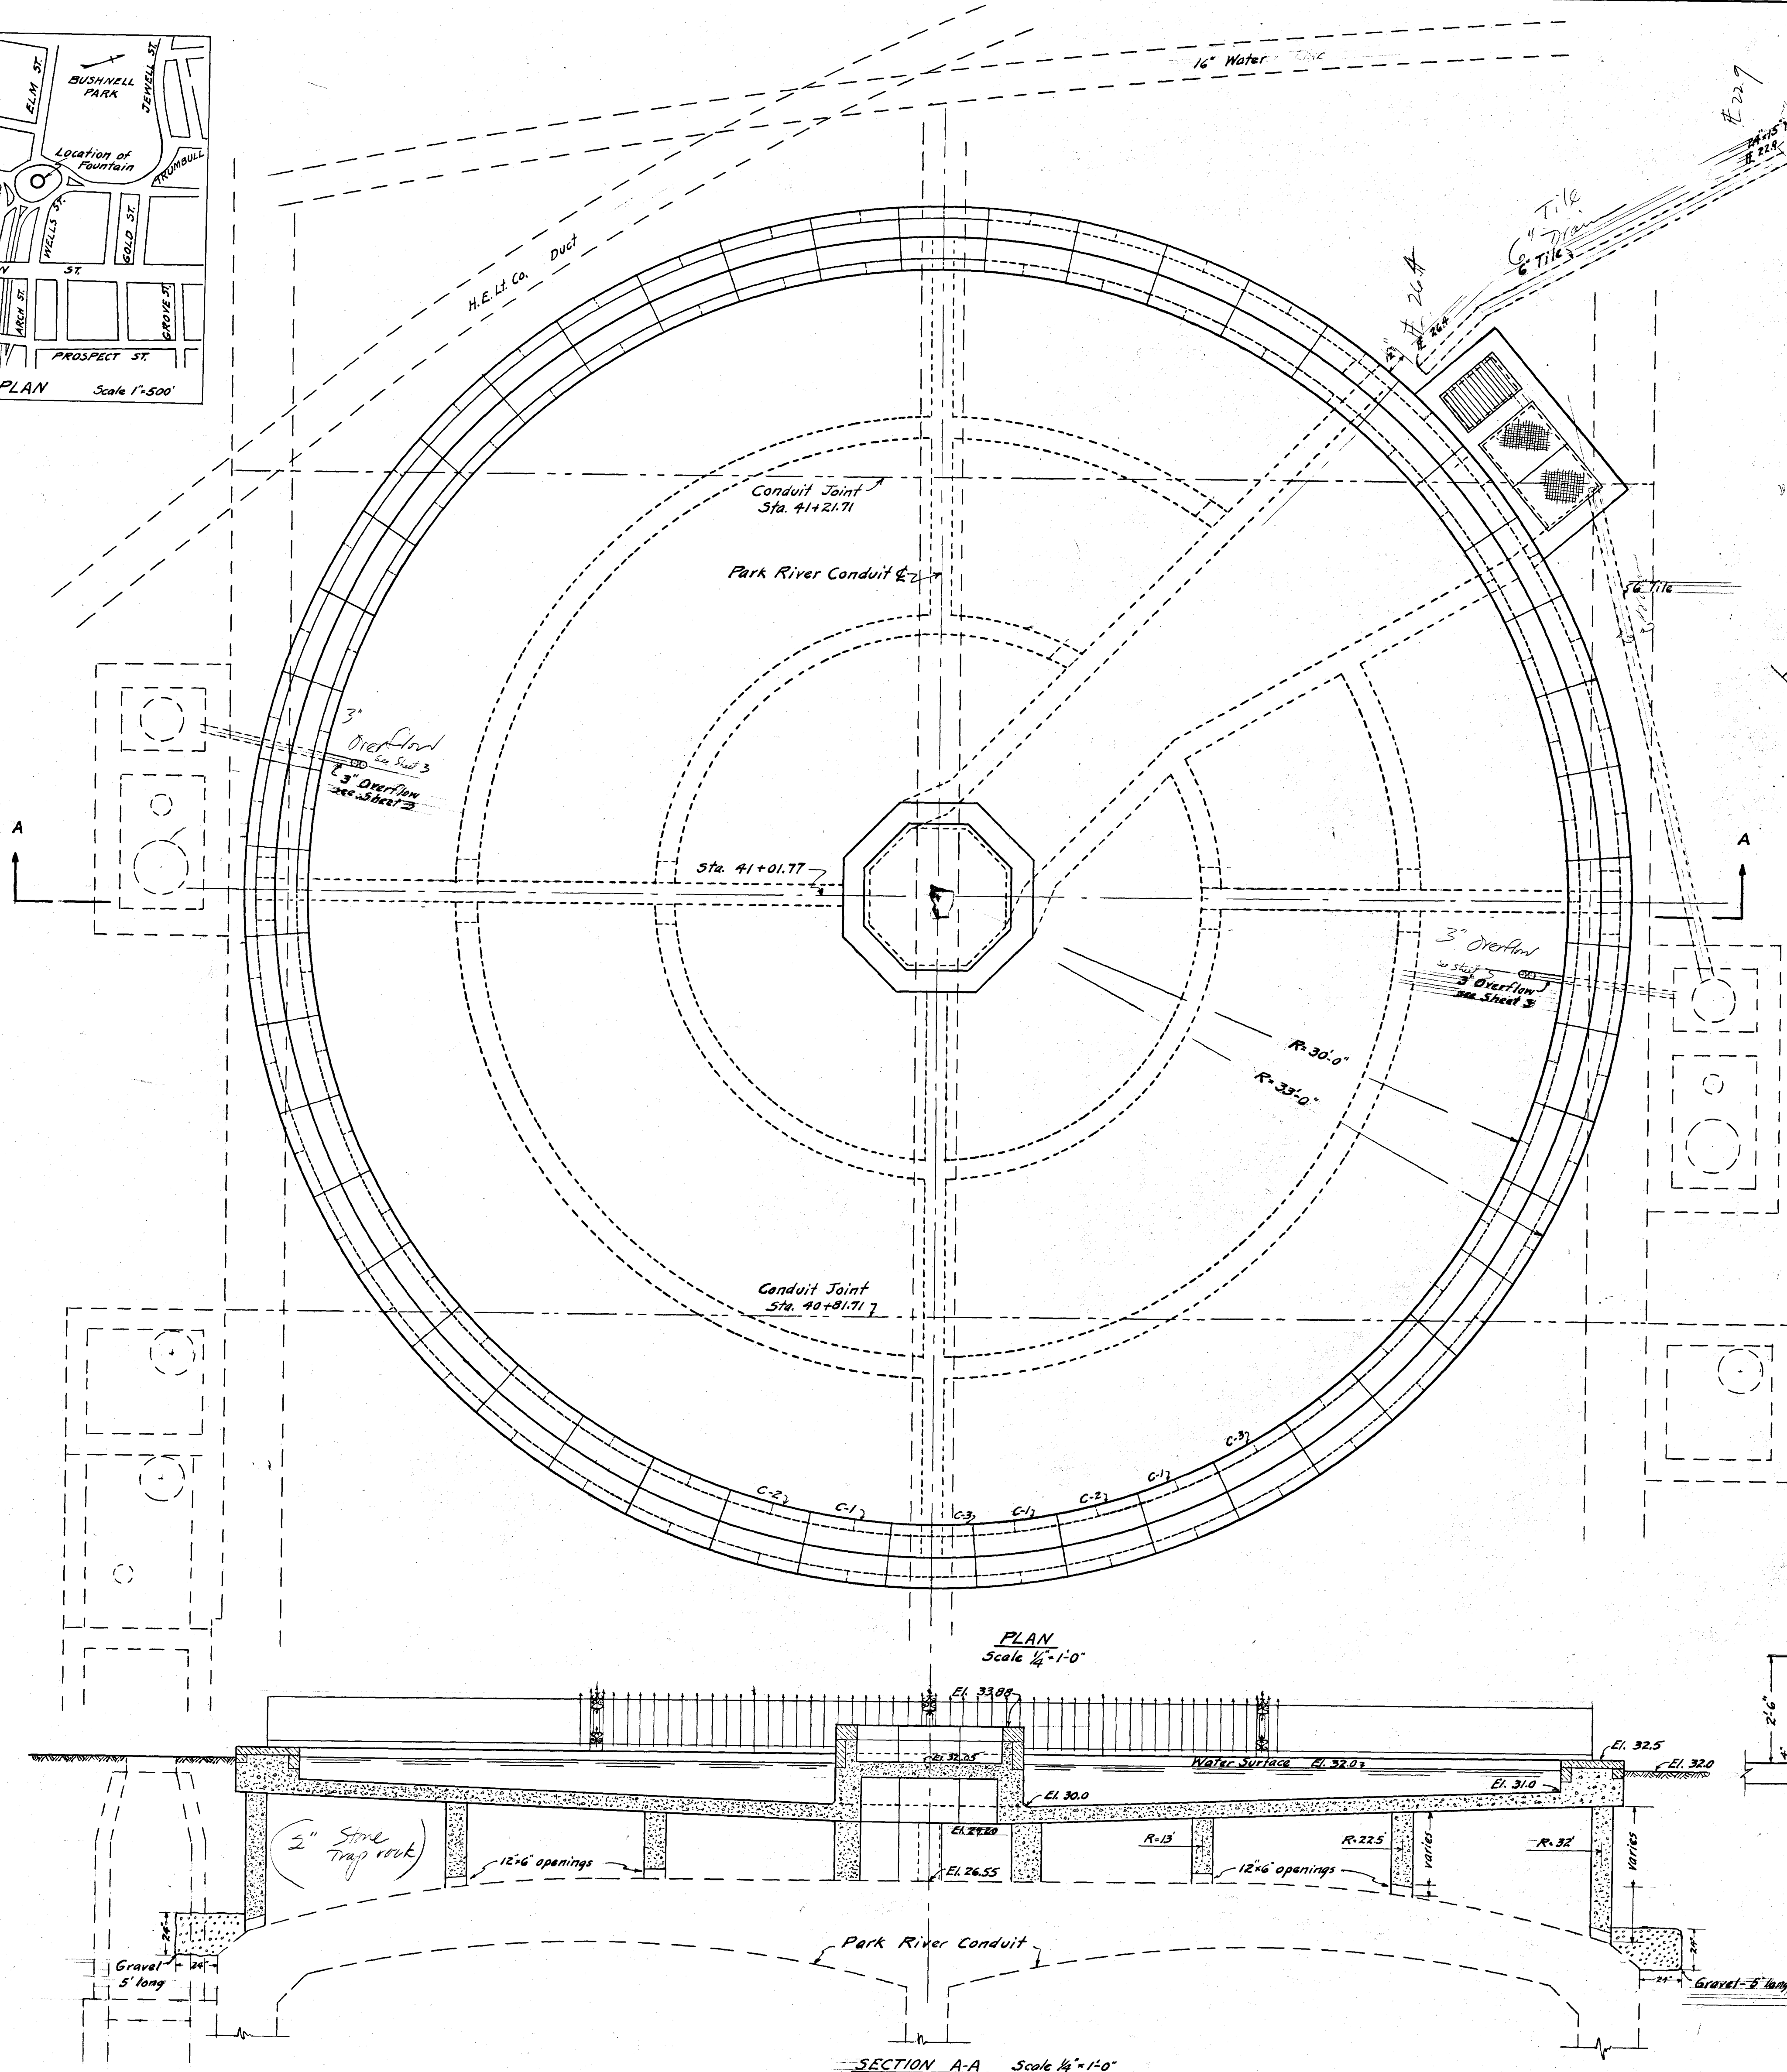


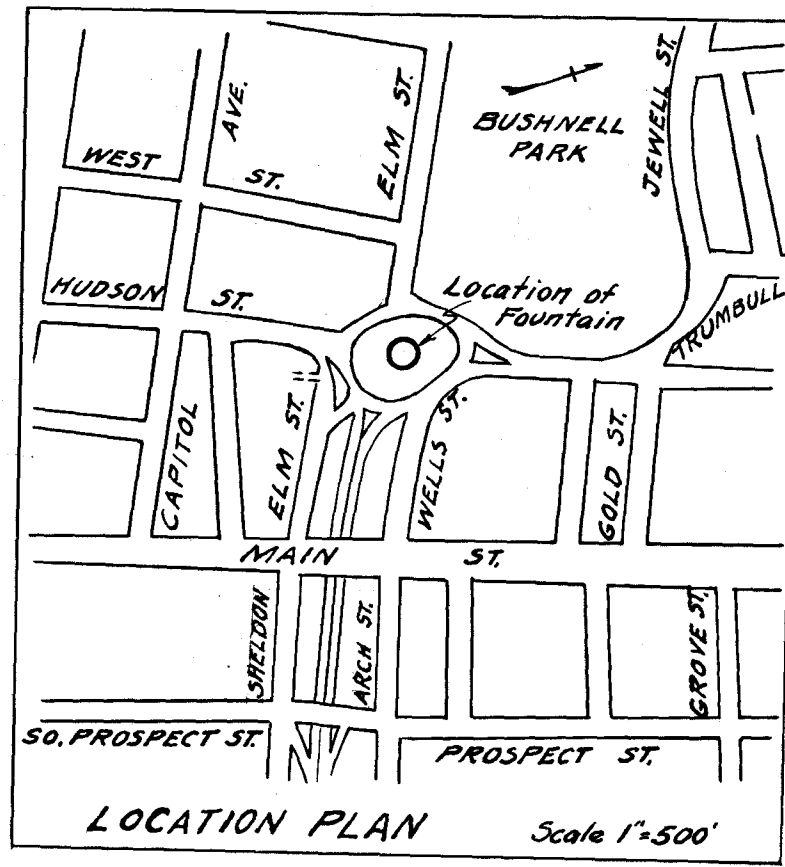

Notes:
All stone shown on this plan is to be pink granite. See specifications.
Contract No. is for furnishing of granite only. Setting of stone is part of Contract No.
For concrete and steel details see Sheet #2.
For electrical and piping details see Sheet #3.

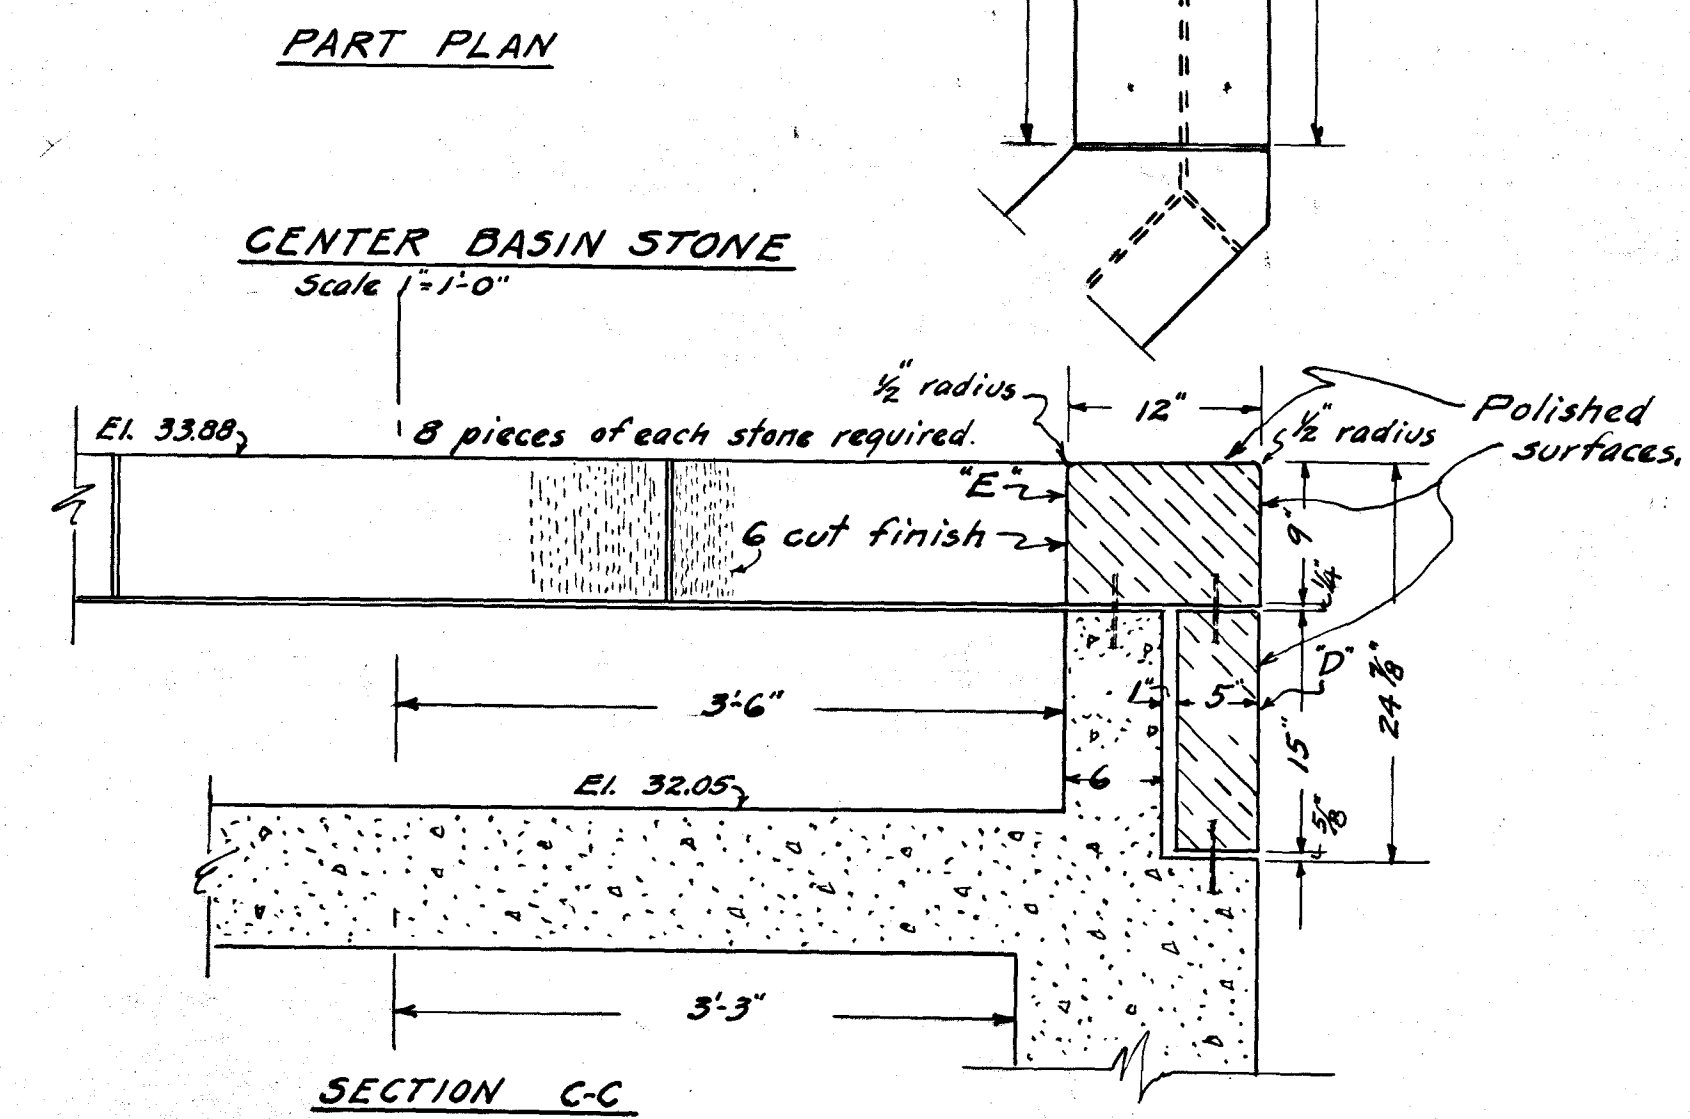

Shew Expansion in coping
(Please slip joint)

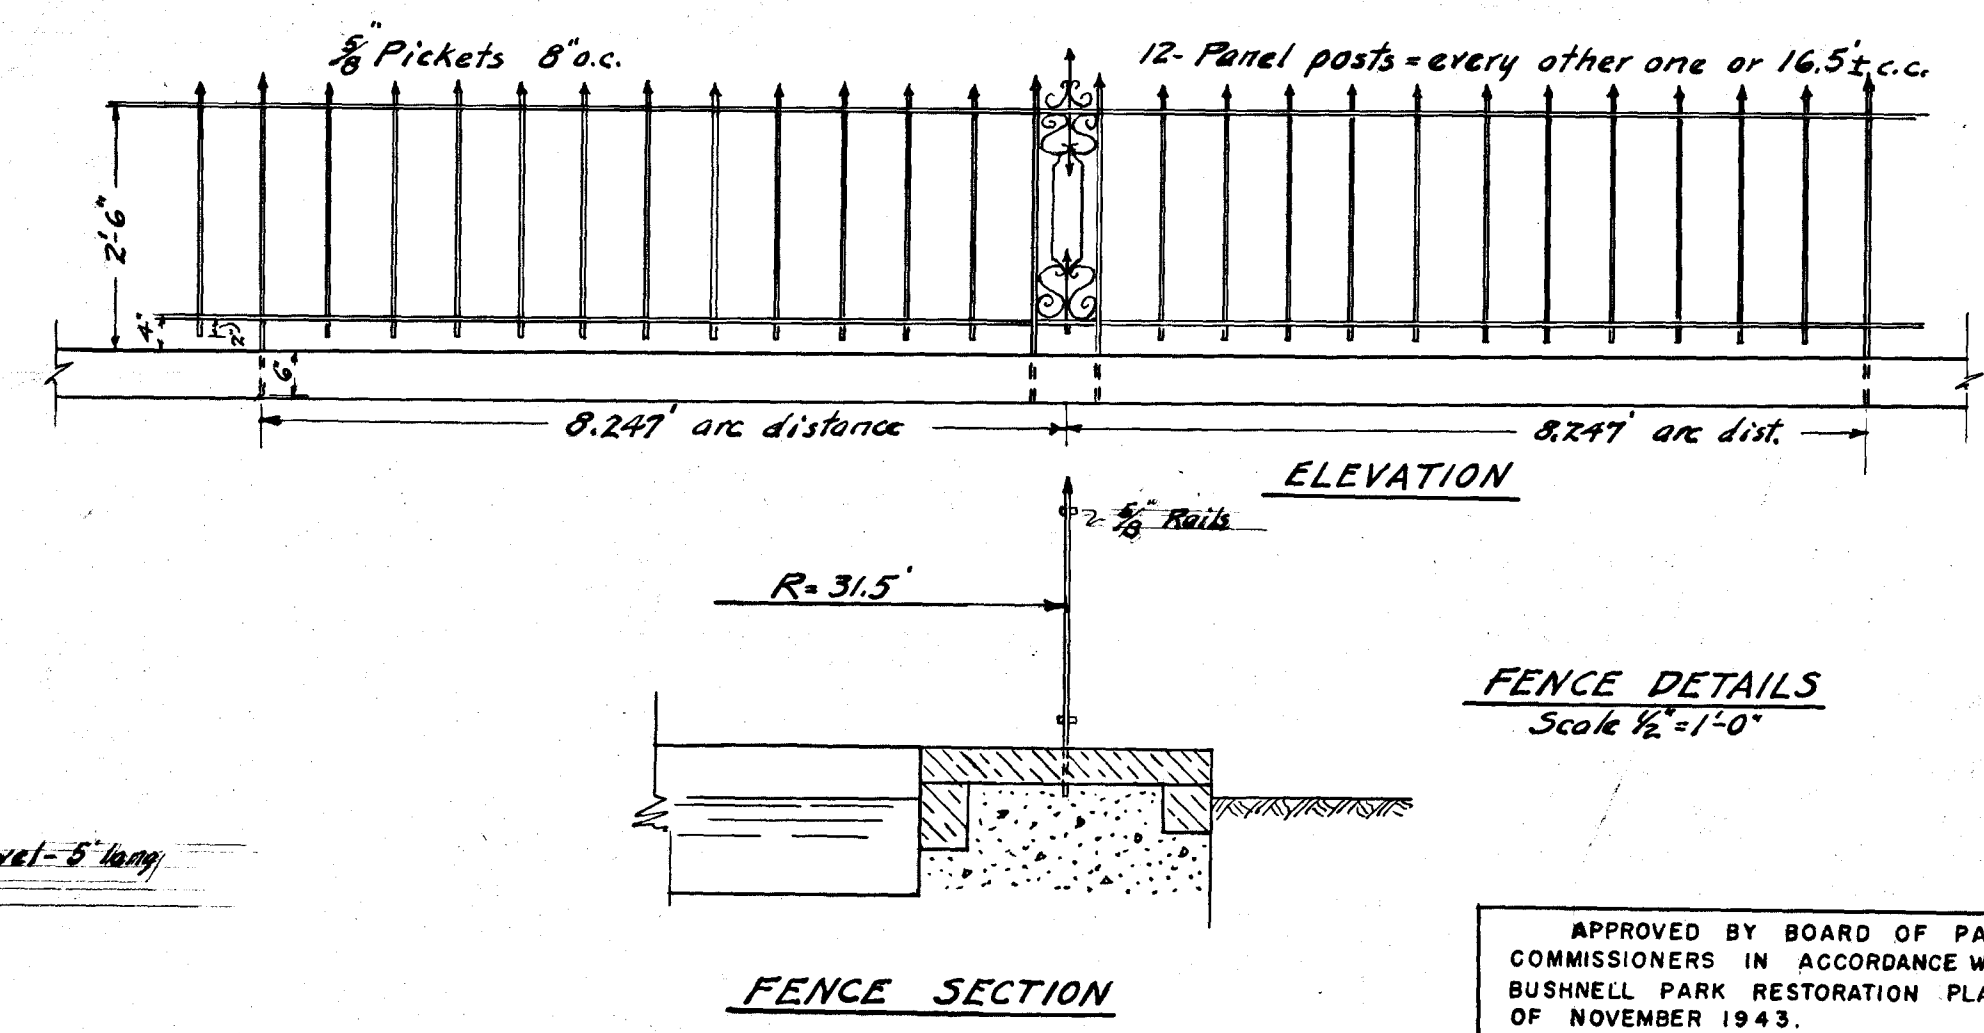

This plan is part of Contract No. as a single sheet, and part of Contract No. as one of 3 sheets.
Elevations refer to Hartford City Datum.

DEPT. OF ENGINEERING, HARTFORD, CONN.		
ROBERT J. ROSS, CITY ENGINEER & MANAGER, MET. DIST. BUREAU, PUBLIC WORKS		
FOR THE HARTFORD FLOOD COMMISSION		
CONTRACT DRAWING CONSTRUCTION OF		
FOUNTAIN		
AT HUDSON STREET CIRCLE		
GENERAL PLAN AND		
STONE DETAILS		
SCALES AS NOTED		
SUBMITTED	RECOMMENDED	APPROVED
DIVISION ENGINEER	ASST. CITY ENG.	CITY ENGINEER
DESIGN	DRAWN	CHECK
APPROVED BY BOARD OF PARK COMMISSIONERS IN ACCORDANCE WITH BUSHNELL PARK RESTORATION PLAN OF NOVEMBER 1943.		PRESIDENT-BOARD OF PARK COMMISSIONERS
DAYBOOK NO. 08745		MARCH 1946