
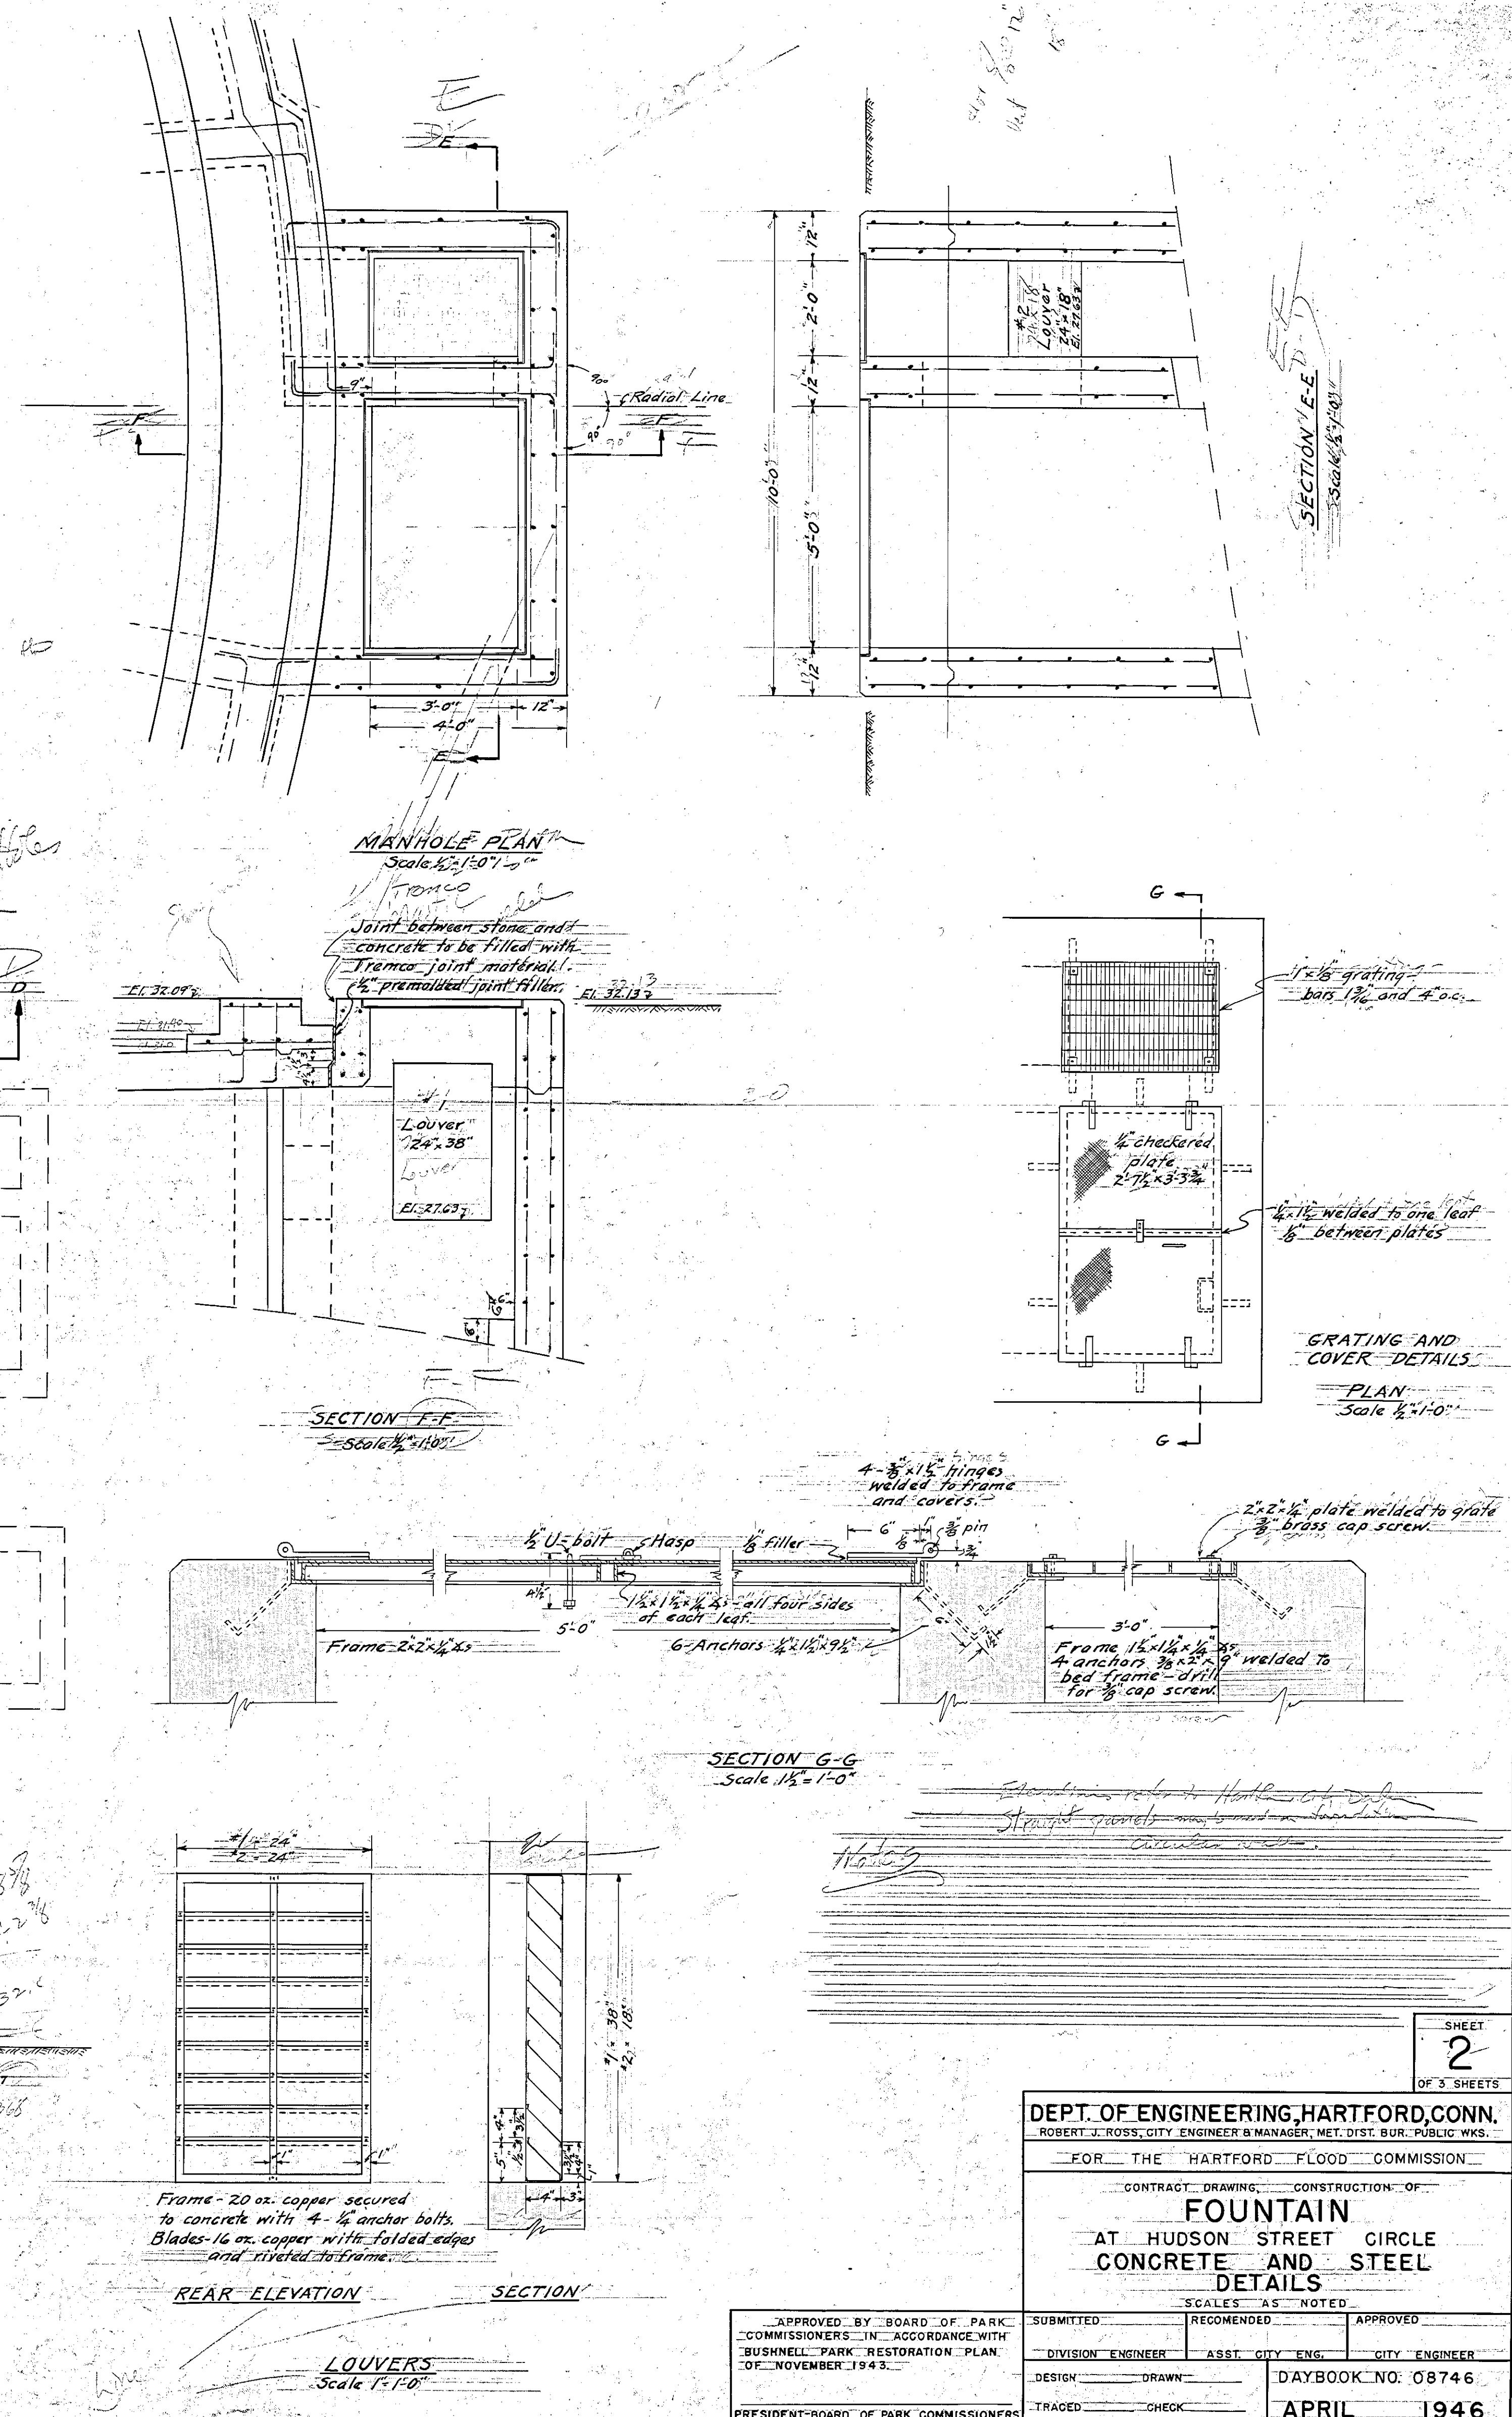


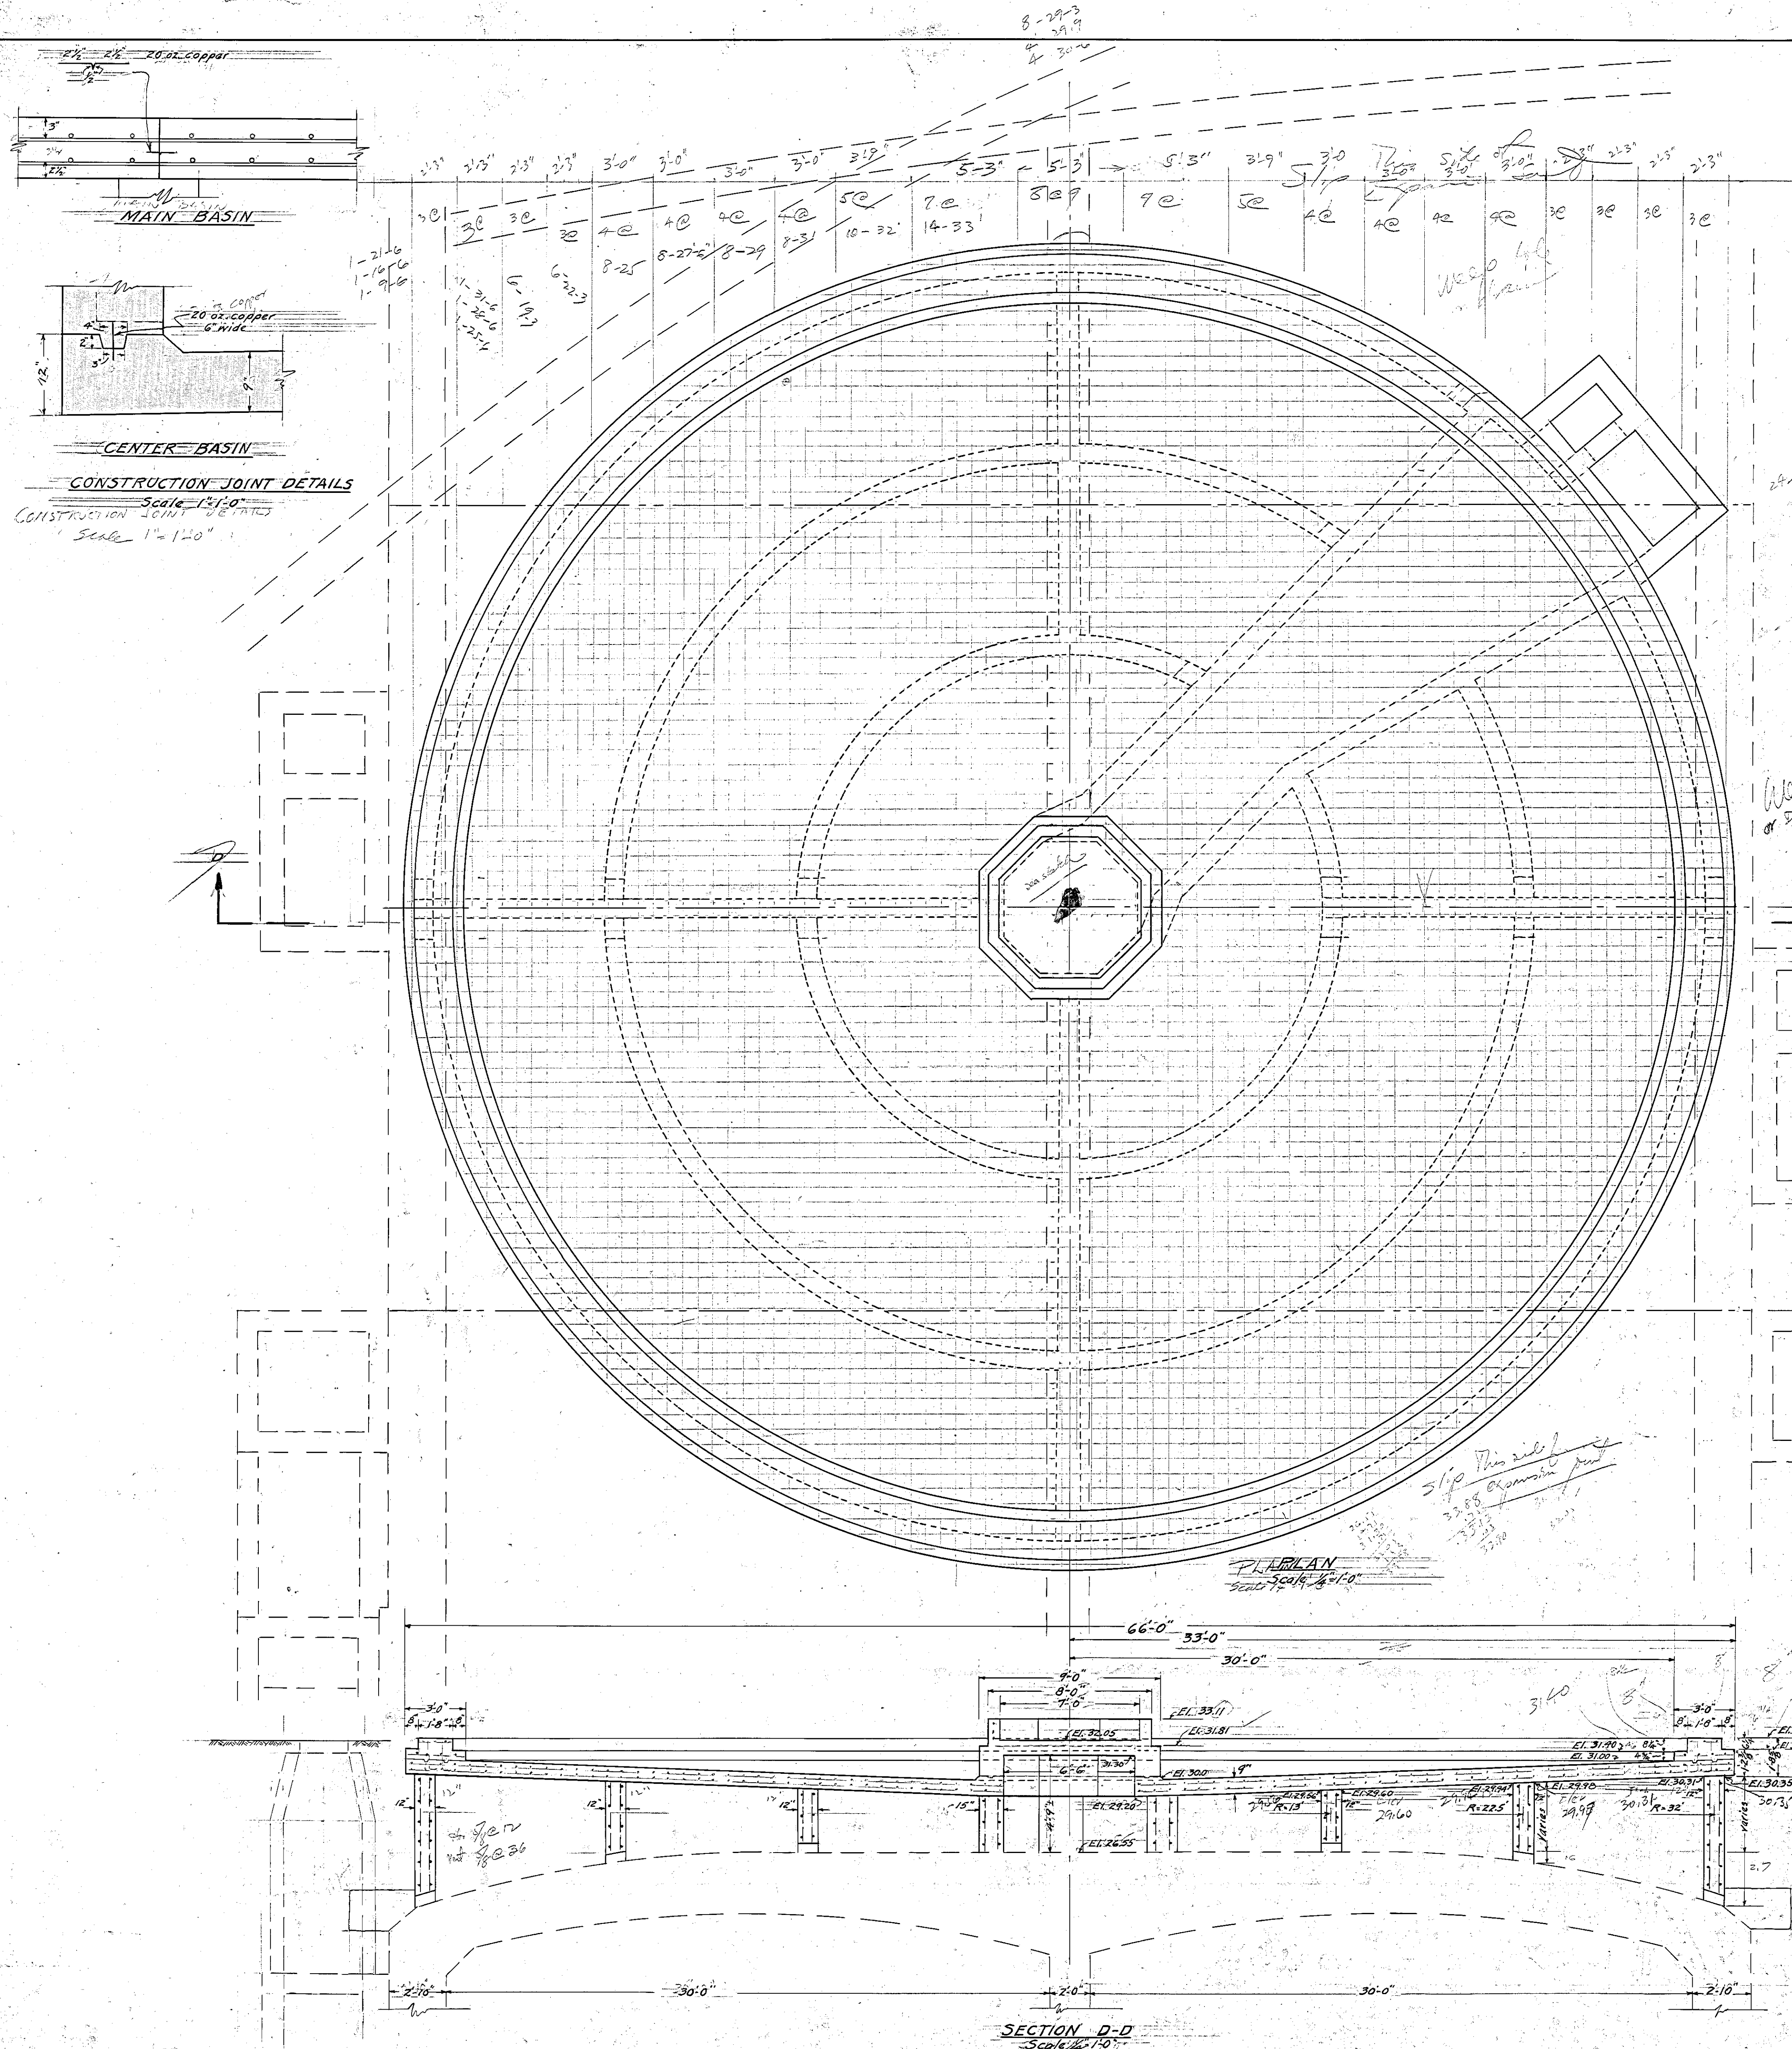

SHEET 2 OF 3 SHEETS		
DEPT. OF ENGINEERING, HARTFORD, CONN. ROBERT J. ROSS, CITY ENGINEER & MANAGER, MET. DIST. BUREAU, PUBLIC WORKS.		
FOR THE HARTFORD FLOOD COMMISSION		
CONTRACT DRAWING CONSTRUCTION OF		
FOUNTAIN		
AT HUDSON STREET CIRCLE		
CONCRETE AND STEEL		
DETAILS		
SCALES AS NOTED		
APPROVED BY BOARD OF PARK COMMISSIONERS IN ACCORDANCE WITH BUSHNELL PARK RESTORATION PLAN OF NOVEMBER 1943.	SUBMITTED DIVISION ENGINEER	RECOMMENDED ASST. CITY ENG.
PRESIDENT BOARD OF PARK COMMISSIONERS	DRAWN DAYBOOK NO. 08746	CITY ENGINEER
	TRACED CHECK	APRIL 1946