


TRAINING TOWER - FIRE DEPARTMENT

HARTFORD, CONN.

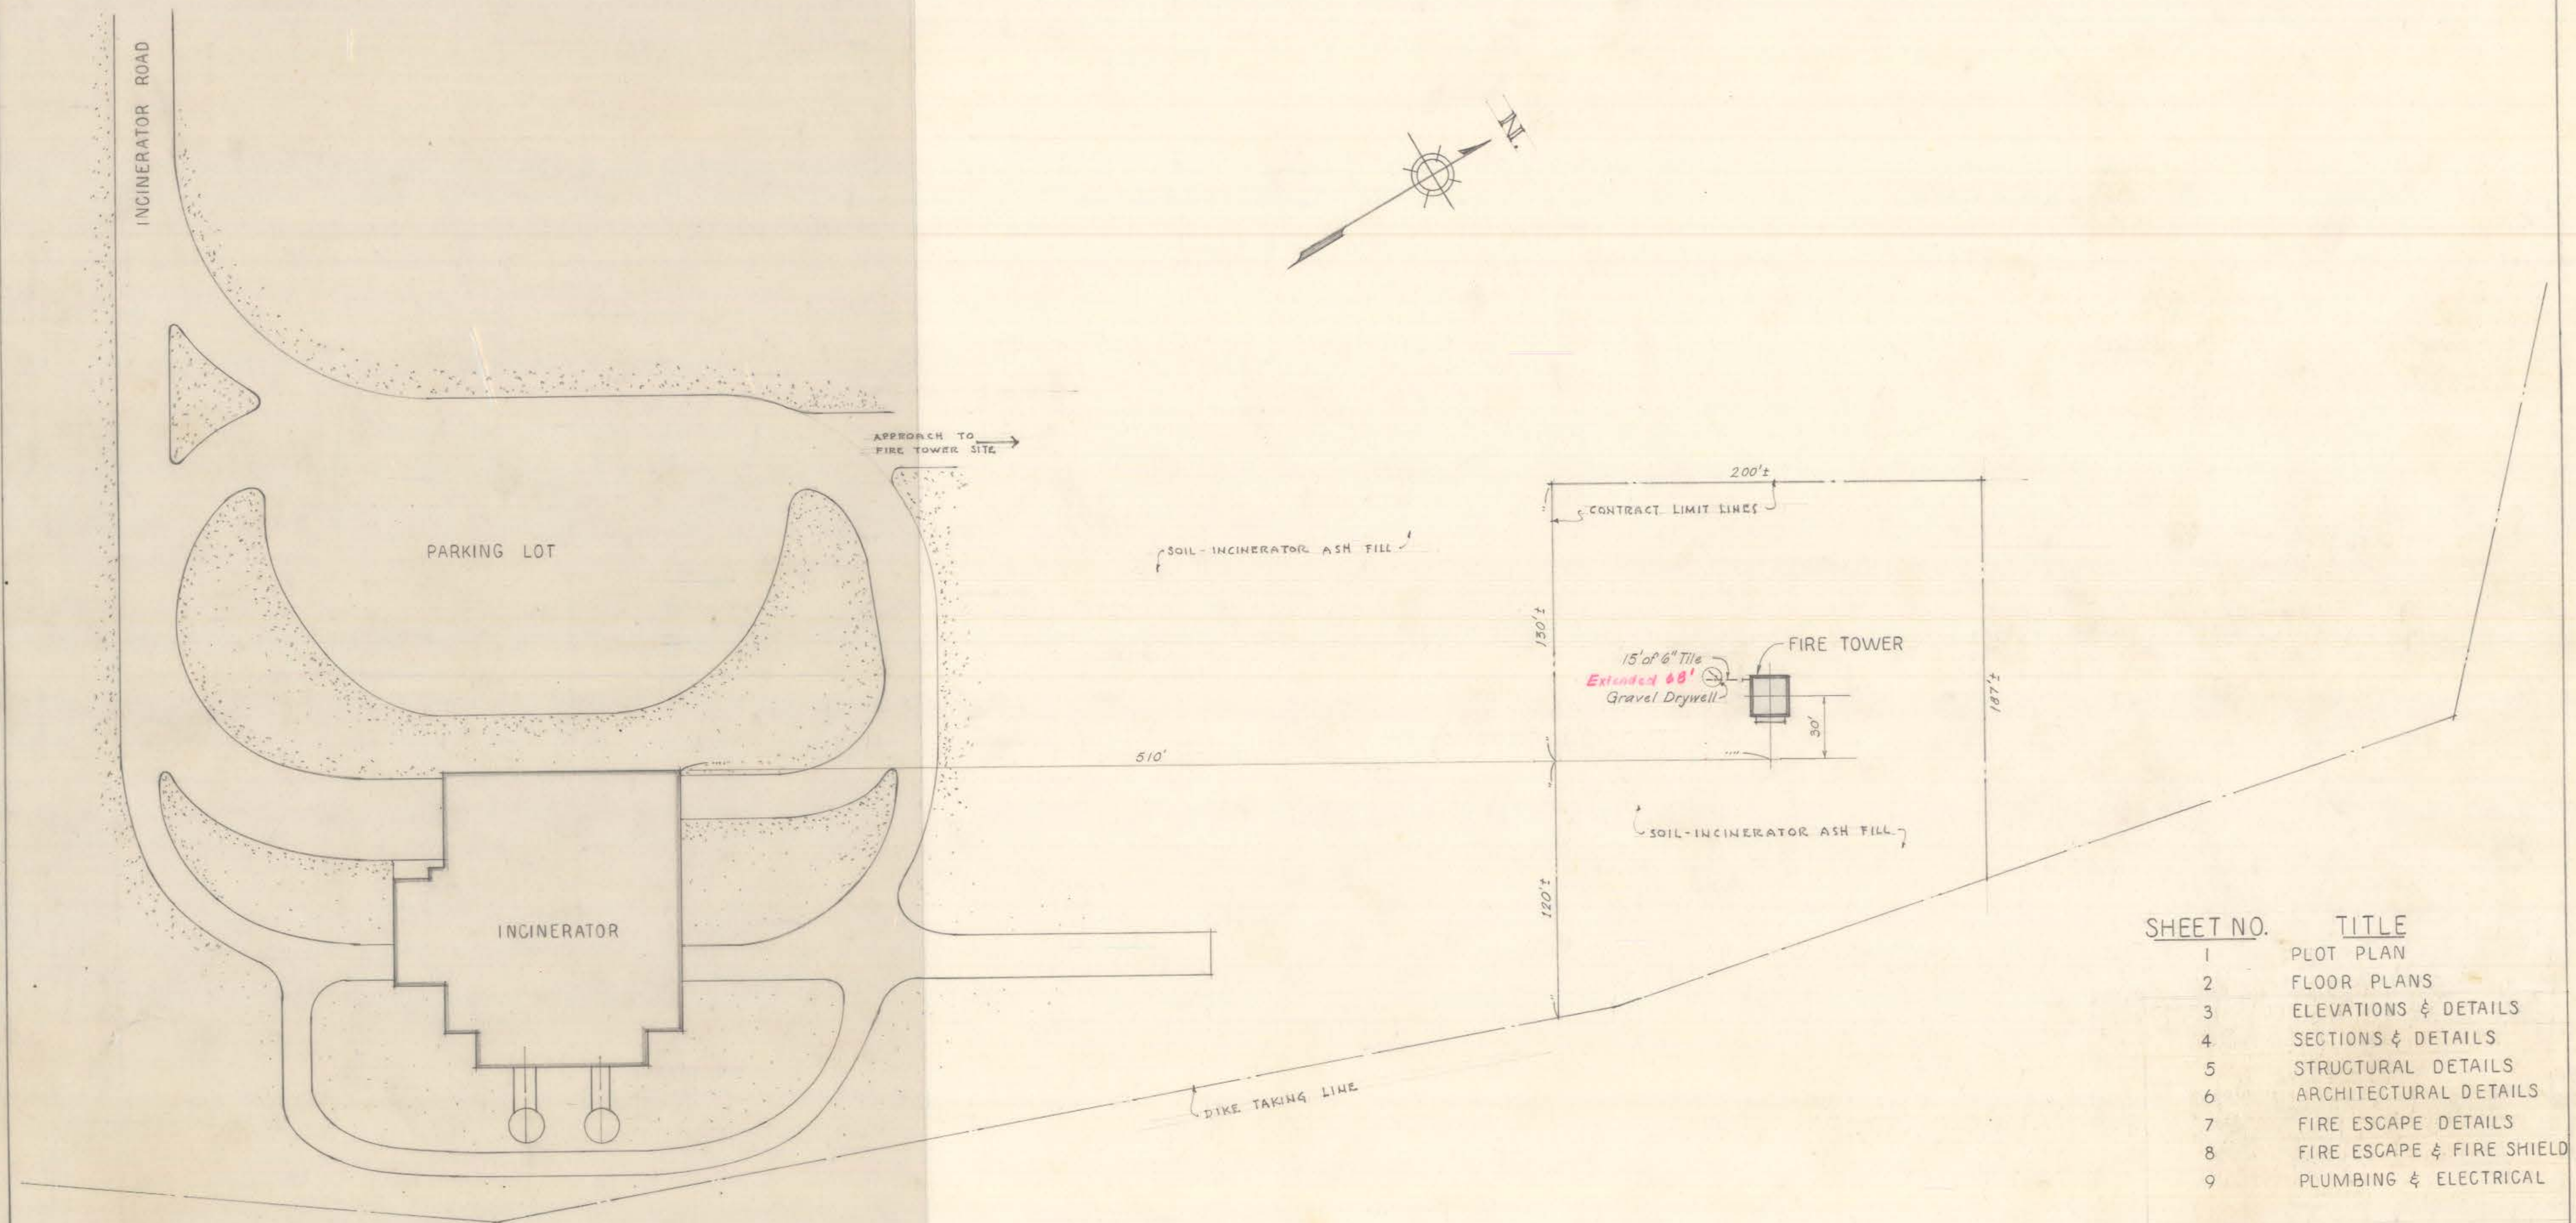

PLOT PLAN

SCALE : 1" = 40'

SHEET NO.	TITLE
1	PLOT PLAN
2	FLOOR PLANS
3	ELEVATIONS & DETAILS
4	SECTIONS & DETAILS
5	STRUCTURAL DETAILS
6	ARCHITECTURAL DETAILS
7	FIRE ESCAPE DETAILS
8	FIRE ESCAPE & FIRE SHIELD
9	PLUMBING & ELECTRICAL

CITY OF HARTFORD, CONNECTICUT DEPARTMENT OF ENGINEERING			
TRAINING TOWER FOR THE HARTFORD FIRE DEPARTMENT CITY OF HARTFORD, CONN.			
SUBMITTED <i>Russell E. Boag</i>	RECOMMENDED <i>David J. Bailey</i>	APPROVED <i>Robert H. Bannister</i>	
CITY ARCHITECT		CITY ENGINEER	
DESIGN RED	DRAWN RED	DAYBOOK NO. 09769 A	
TRACED	CHECK	DATE MAR. 27, 1963	

1