



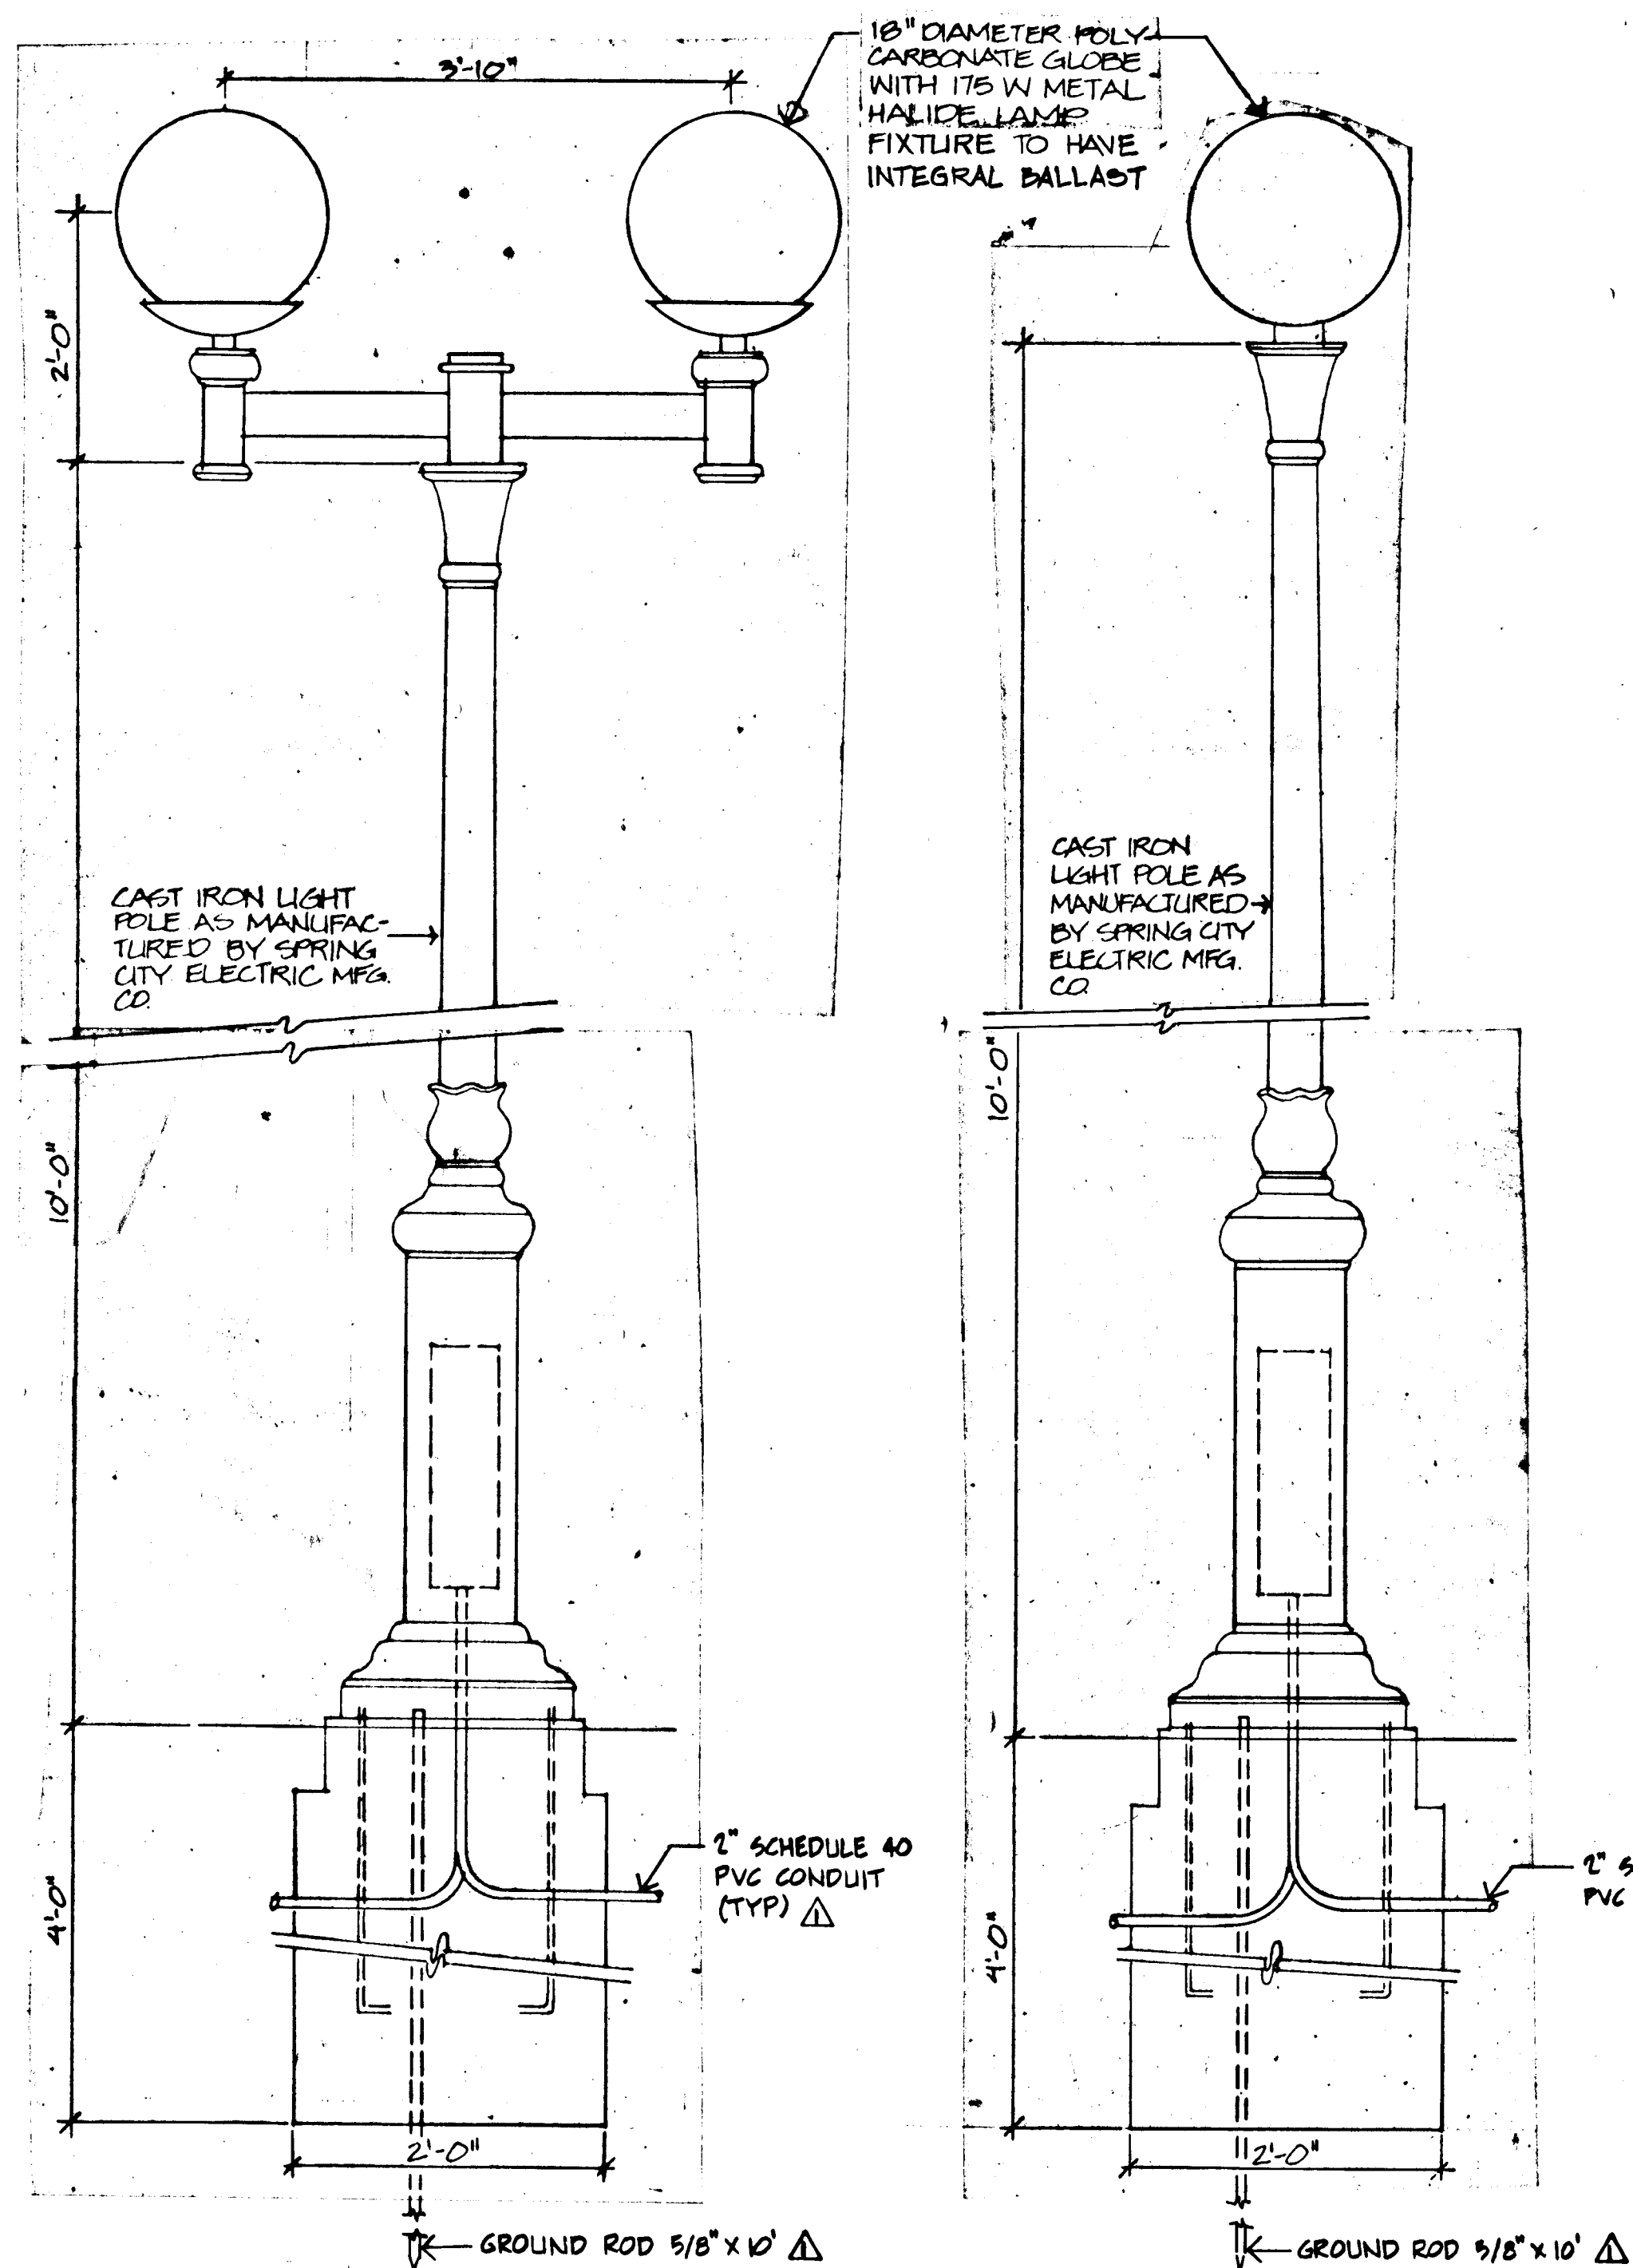


DOUBLE LIGHT FIXTURE


SINGLE LIGHT FIXTURE

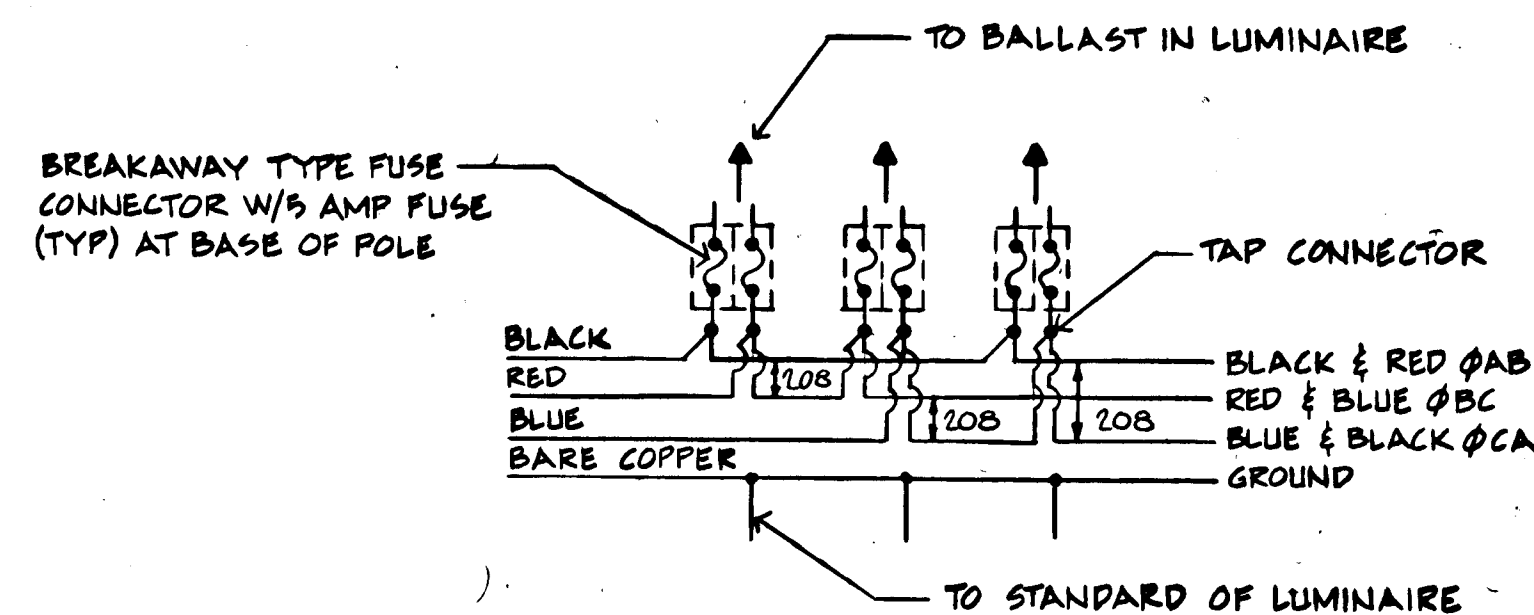


3 PHASE 3 WIRE SYSTEM FOR METAL HALIDE LAMP BALLAST

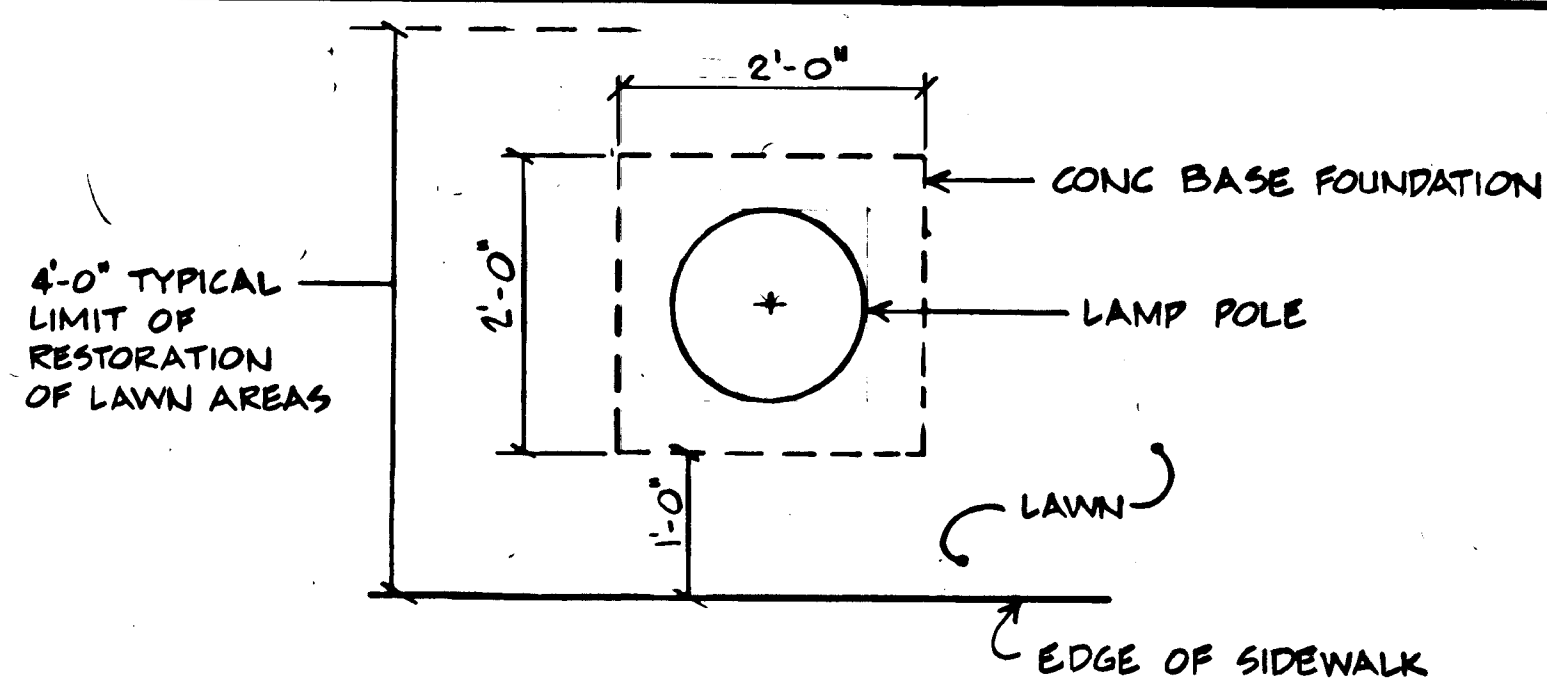

PLAN - LOCATION OF LAMP POST AT SIDEWALK EDGE

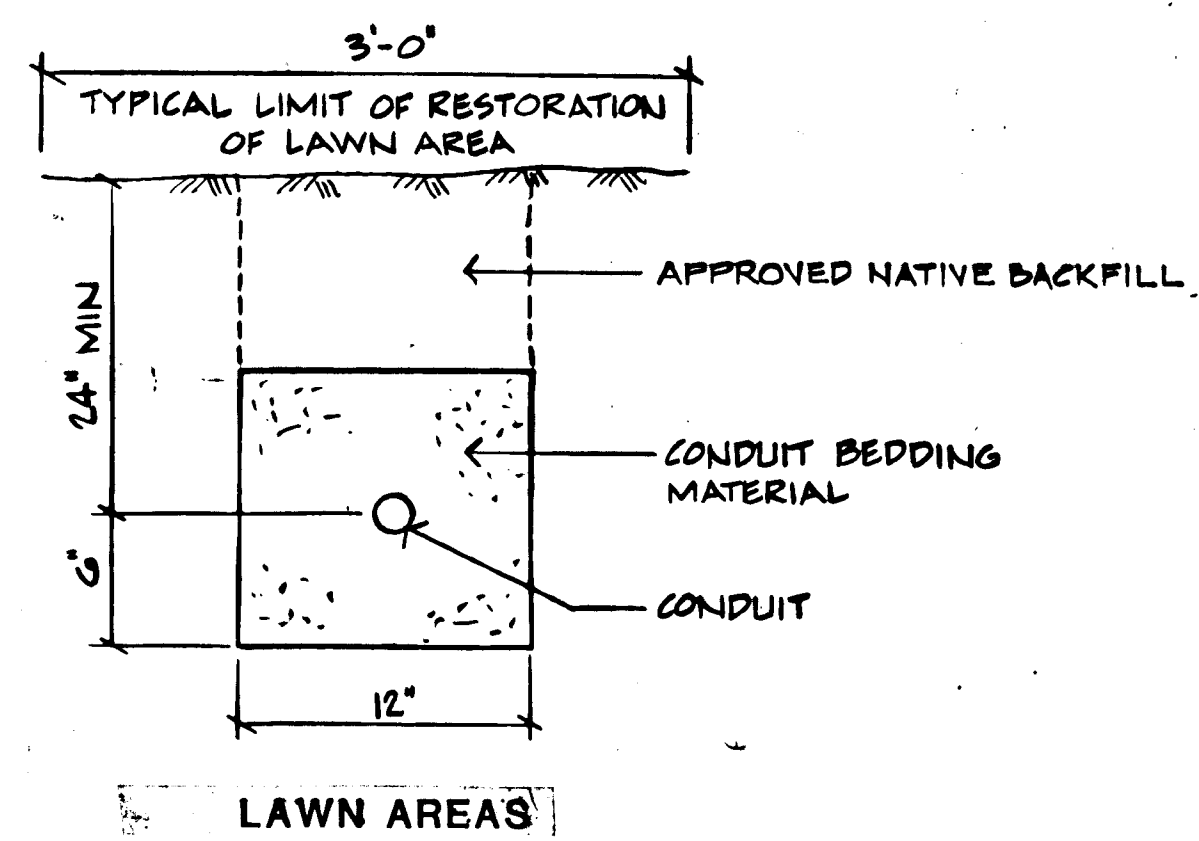

LAWN AREAS

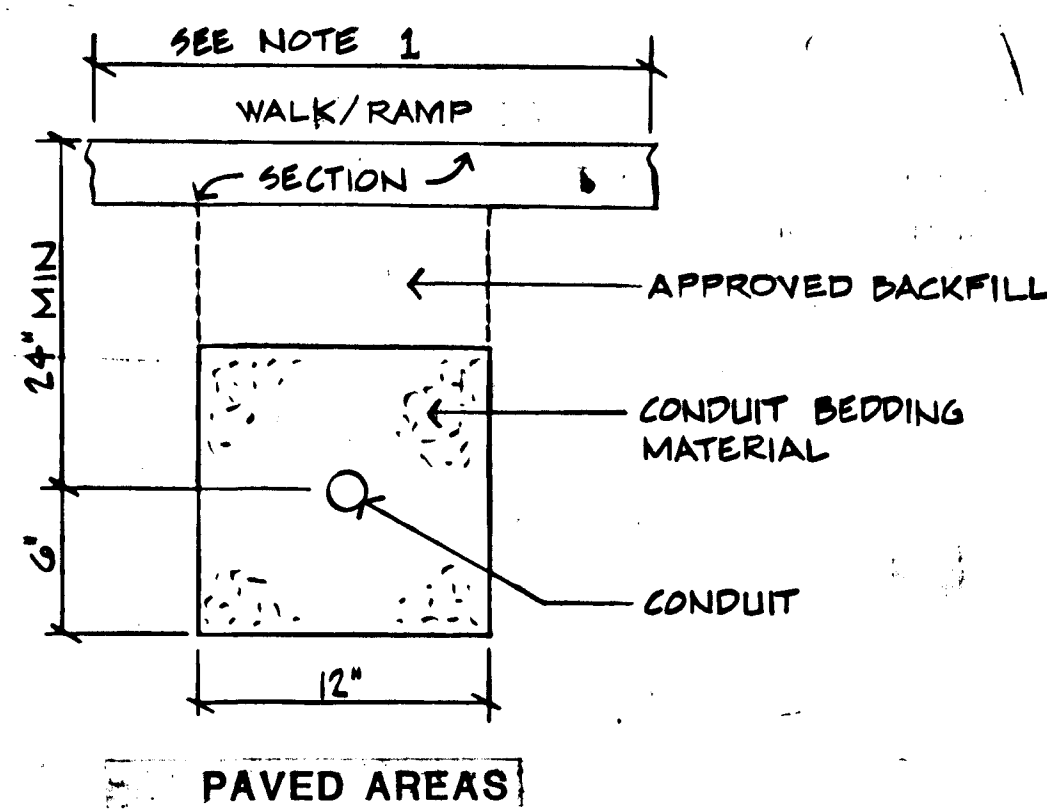


PAVED AREAS

TRENCHING DETAILS FOR CONDUIT


NOTE:

1. LIMIT FOR RESTORATION OF CONCRETE WALKS AND RAMPS TO BE ADJACENT EXPANSION JOINT OR DUMMY JOINT. LIMIT FOR RESTORATION OF BITUMINOUS CONCRETE WALKS AND RAMPS TO BE 3'-0".

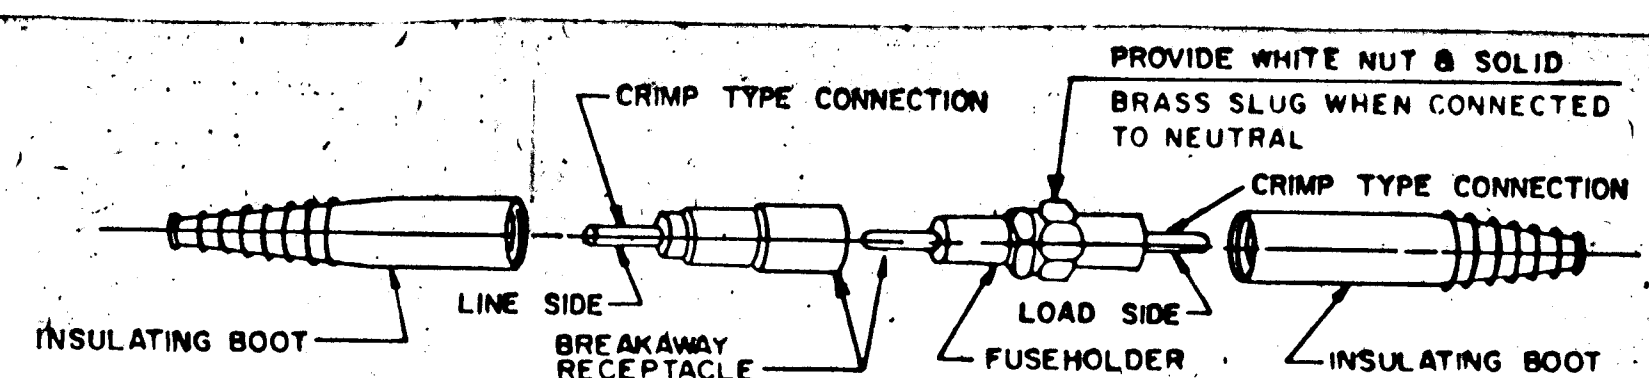


BREAKAWAY TYPE FUSE CONNECTOR TYPICAL


NOTE: THIS CONNECTOR IS REPRESENTATIVE ONLY - TWO POLE CONNECTORS WILL BE USED IN MOST INSTANCES.

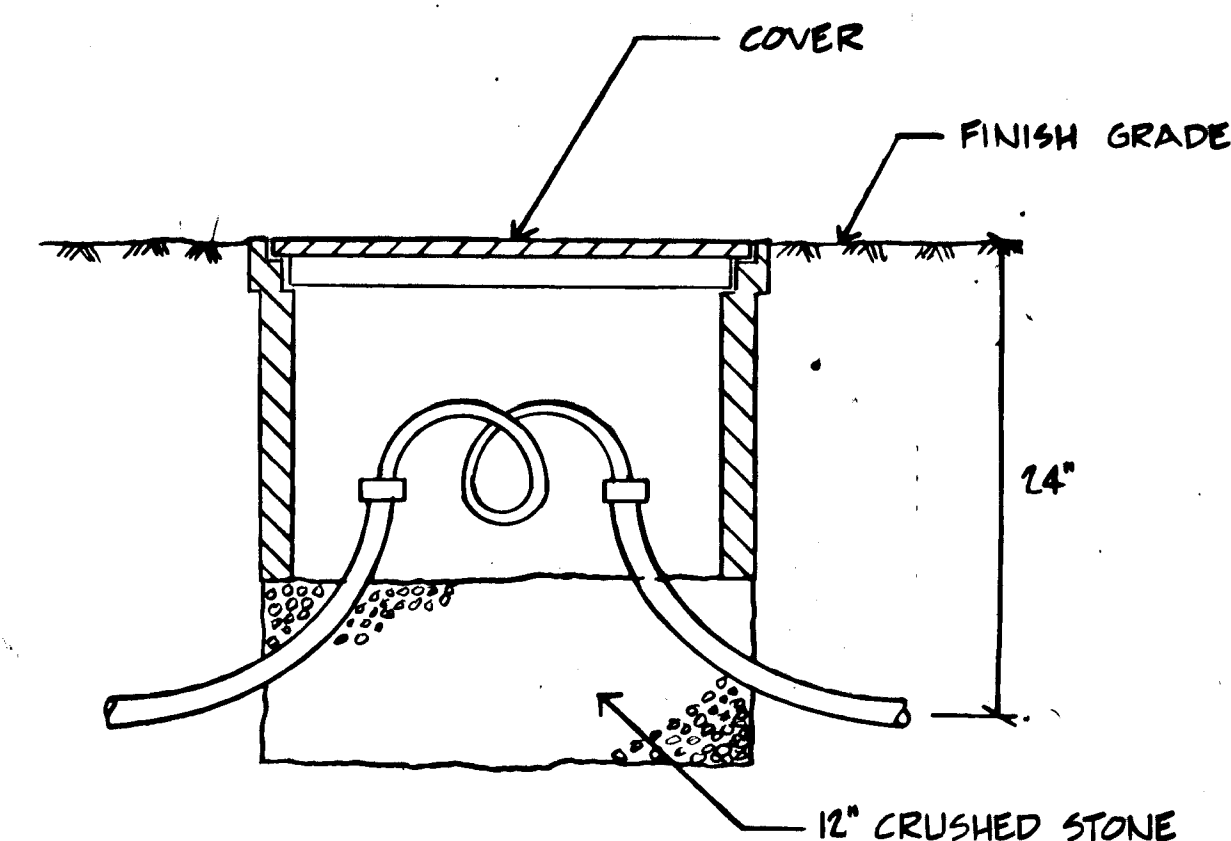

HAND HOLE - PULL BOX DETAIL

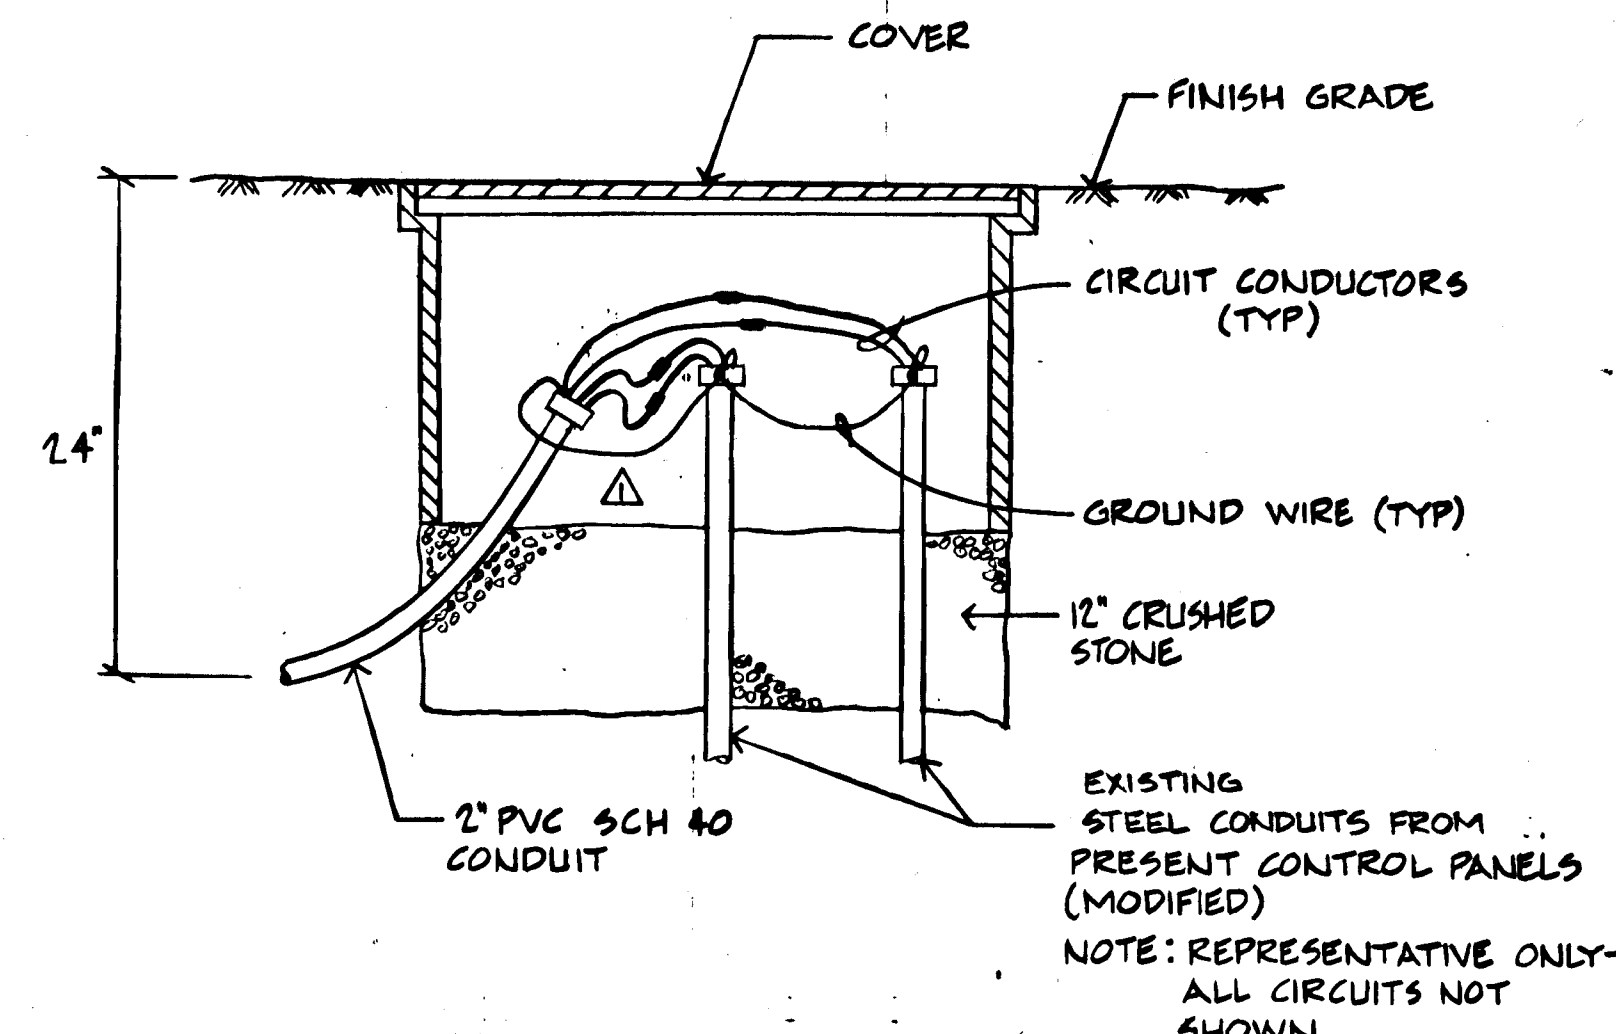

SPICE BOX DETAIL

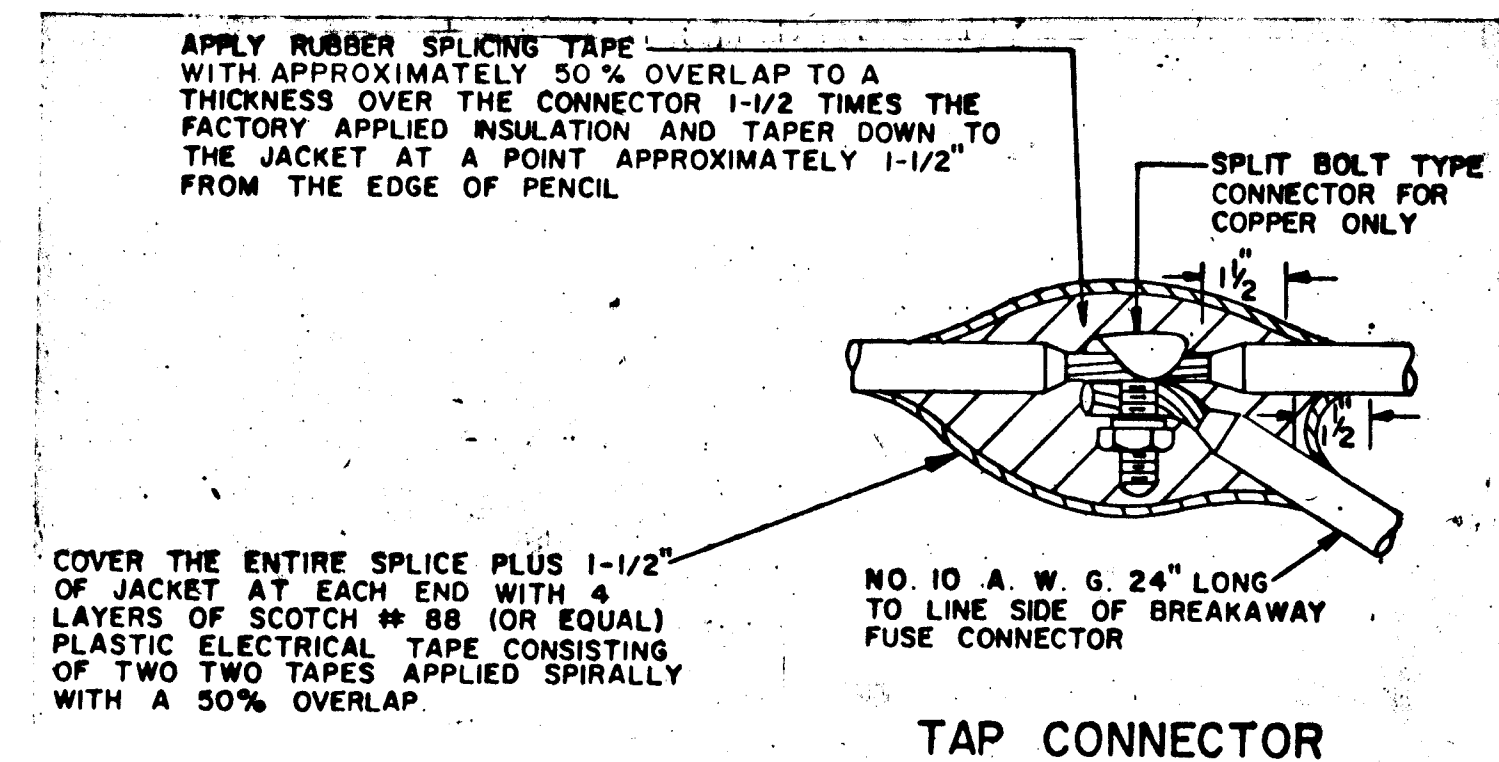

TAP CONNECTOR

SUBMITTED <i>[Signature]</i>	APPROVED <i>[Signature]</i>	APPROVED <i>[Signature]</i>
DRAWN <i>[Signature]</i>	CHECKED <i>[Signature]</i>	DATE 8/26/83
SCALE None	DAYBOOK NO. 010858	DRAWING NO. E-7

REV.	DATE	DESCRIPTION
1	11-30-83	CLIENTS REVISIONS

CITY OF HARTFORD DEPARTMENT OF PUBLIC WORKS FACILITY SERVICE BUREAU	cahn CONSULTING ENGINEERS AND PLANNERS 80 Alexander Drive, Wallingford, Ct. 06488
---	---

BUSHNELL PARK PATHWAY LIGHTING	MISCELLANEOUS DETAILS
-----------------------------------	-----------------------

Designed by J.E.D.	Drawn by R.E. MOSKI	Checked by [Signature]	Approved by [Signature]
Scale: Not To Scale	Date: AUG, 1983	Dwg. No. 7 of 8	Dwg. No. 7