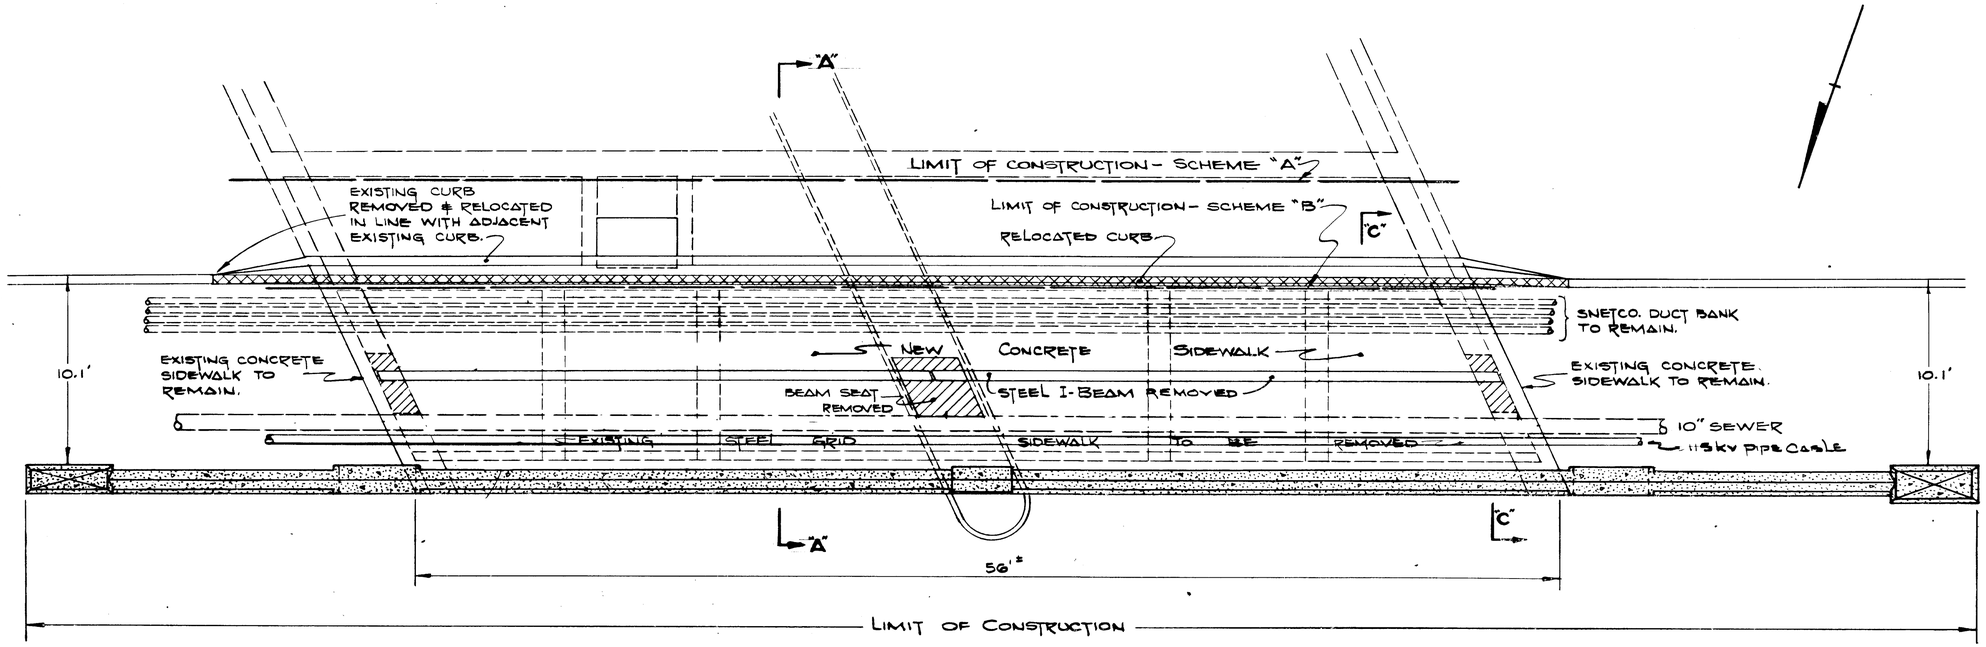

PLAN VIEW

SCALE 1/4" = 1'-0"

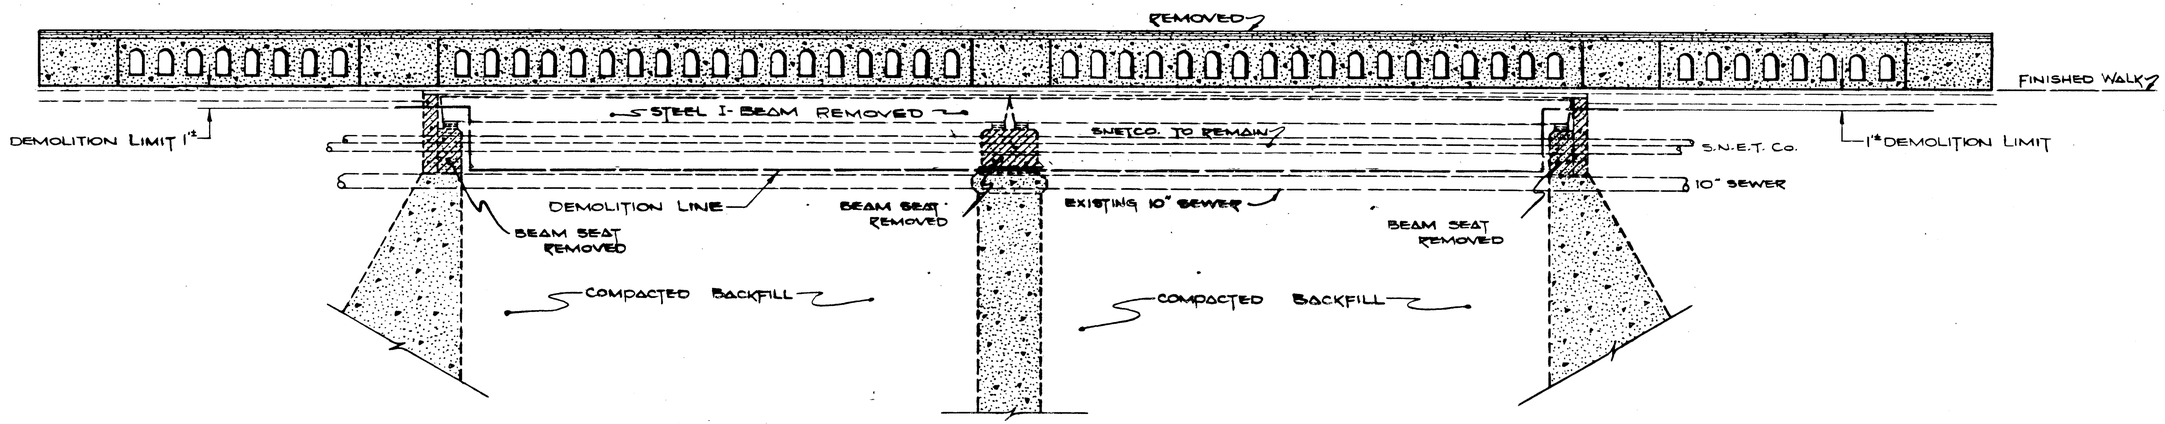

ELEVATION VIEW

SCALE 1/4" = 1'-0"

SHEET 1 OF 2

REVISIONS DURING CONSTRUCTION	P. A. NO.

MF	P. A. #	NO.	DATE	REVISIONS	BY	CHK	APP	APP
		1	7-19-88	As Built				

NORTHEAST UTILITIES SERVICE CO.

FOR CONNECTICUT LIGHT & POWER

TITLE
SOUTHWEST HARTFORD - NORTHWEST HARTFORD UNDERGROUND PIPE CABLE - 115KV TAP TO AETNA CAPITOL AVE. BRIDGE INSTALLATION

BY R. MINNICH	CHKD	APP T.M.H.	APP
DATE 8-19-87	DATE	DATE 7-19-88	DATE
SCALE AS NOTED	MICROFILM DATE	DWG. NO. 01194-10002	
P. A. #			

SERV. CK.	CONC. CK.	SERV. CK.	CONC. CK.	SERV. CK.	CONC. CK.	SERV. CK.	CONC. CK.
MECH. CK.	STRUC. CK.	MECH. CK.	STRUC. CK.	MECH. CK.	STRUC. CK.	MECH. CK.	STRUC. CK.
ELEC. CK.	HYDRL. CK.	ELEC. CK.	HYDRL. CK.	ELEC. CK.	HYDRL. CK.	ELEC. CK.	HYDRL. CK.

BRUNING 61745