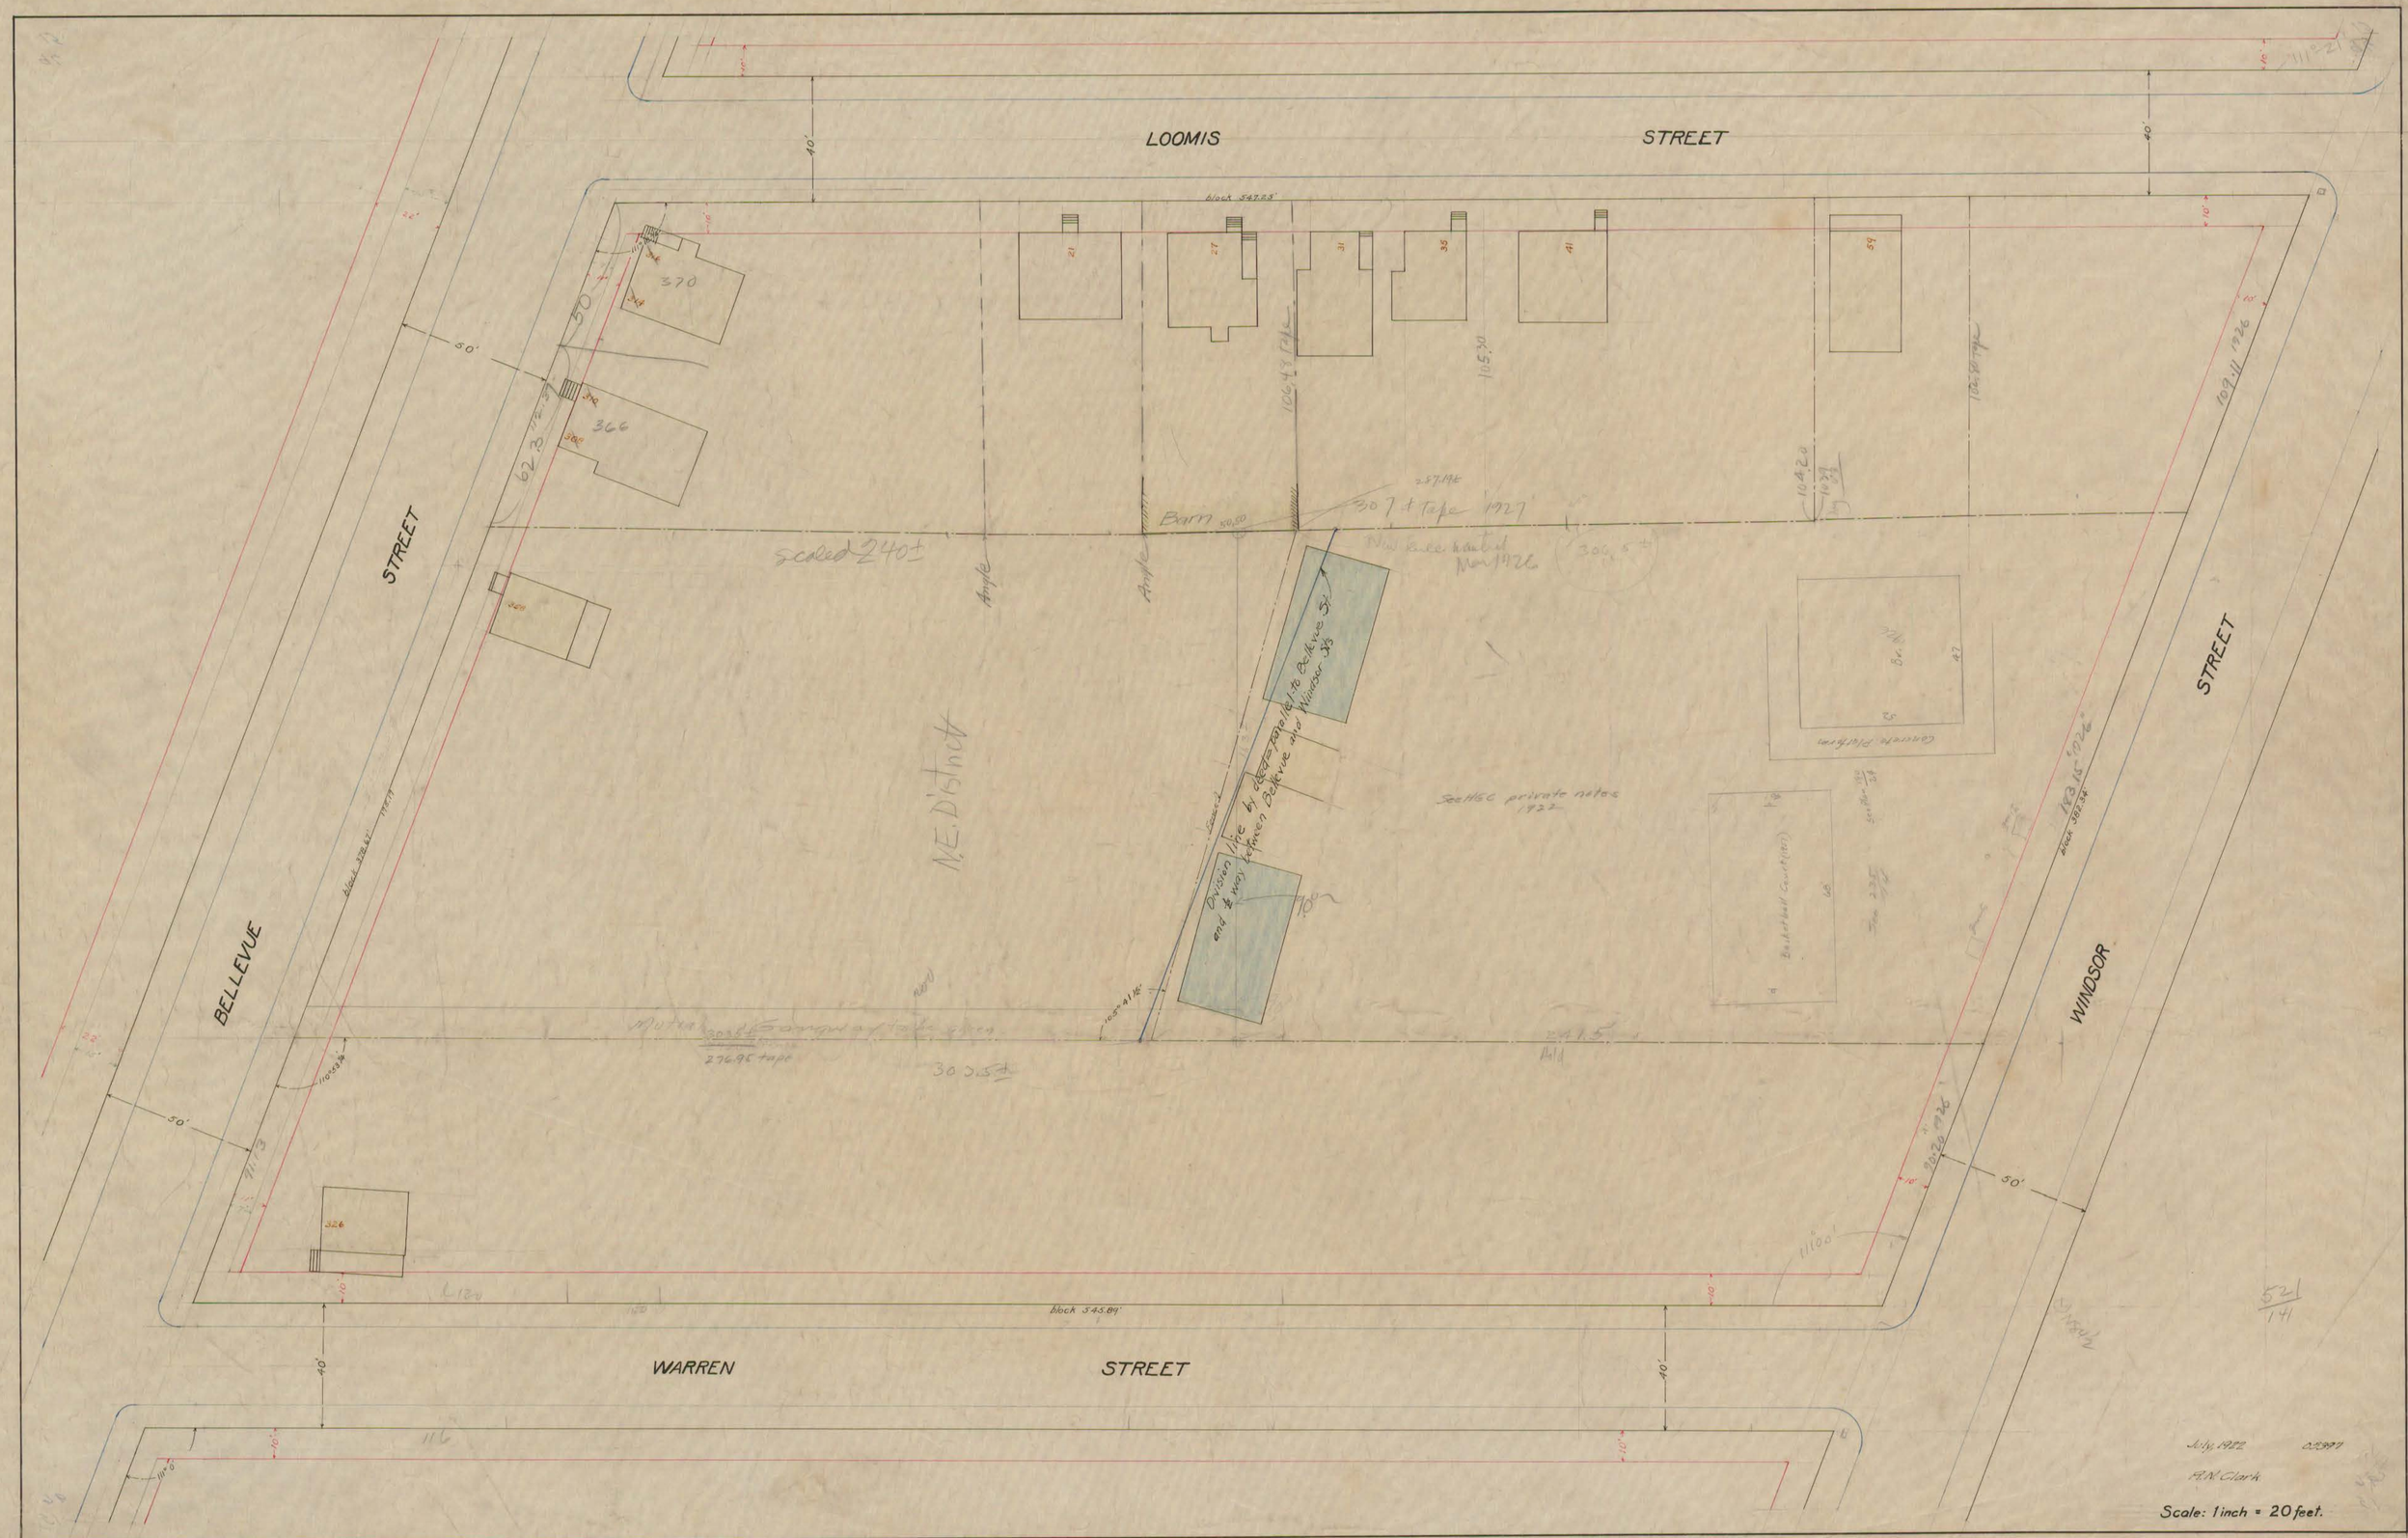
LOOMIS
STREET
WARREN
STREET
BELLEVUE
STREET
WINDSOR
STREET
Block 547.25'
block 345.84'
Block 376.42'
Block 382.34'
370
366
326
21
27
31
35
41
59
Barn
scaled 240±
N.E. District
Division line by deed parallel to Bellevue St and ½ way between Bellevue and Windsor St
Concrete Platform
Basketball Court (?)
307 ± tape 1927
Scale: 1 inch = 20 feet.