


BROAD STREET  
AT  
FARMINGTON AVE & ASYLUM ST  
SCALE 1"=20'

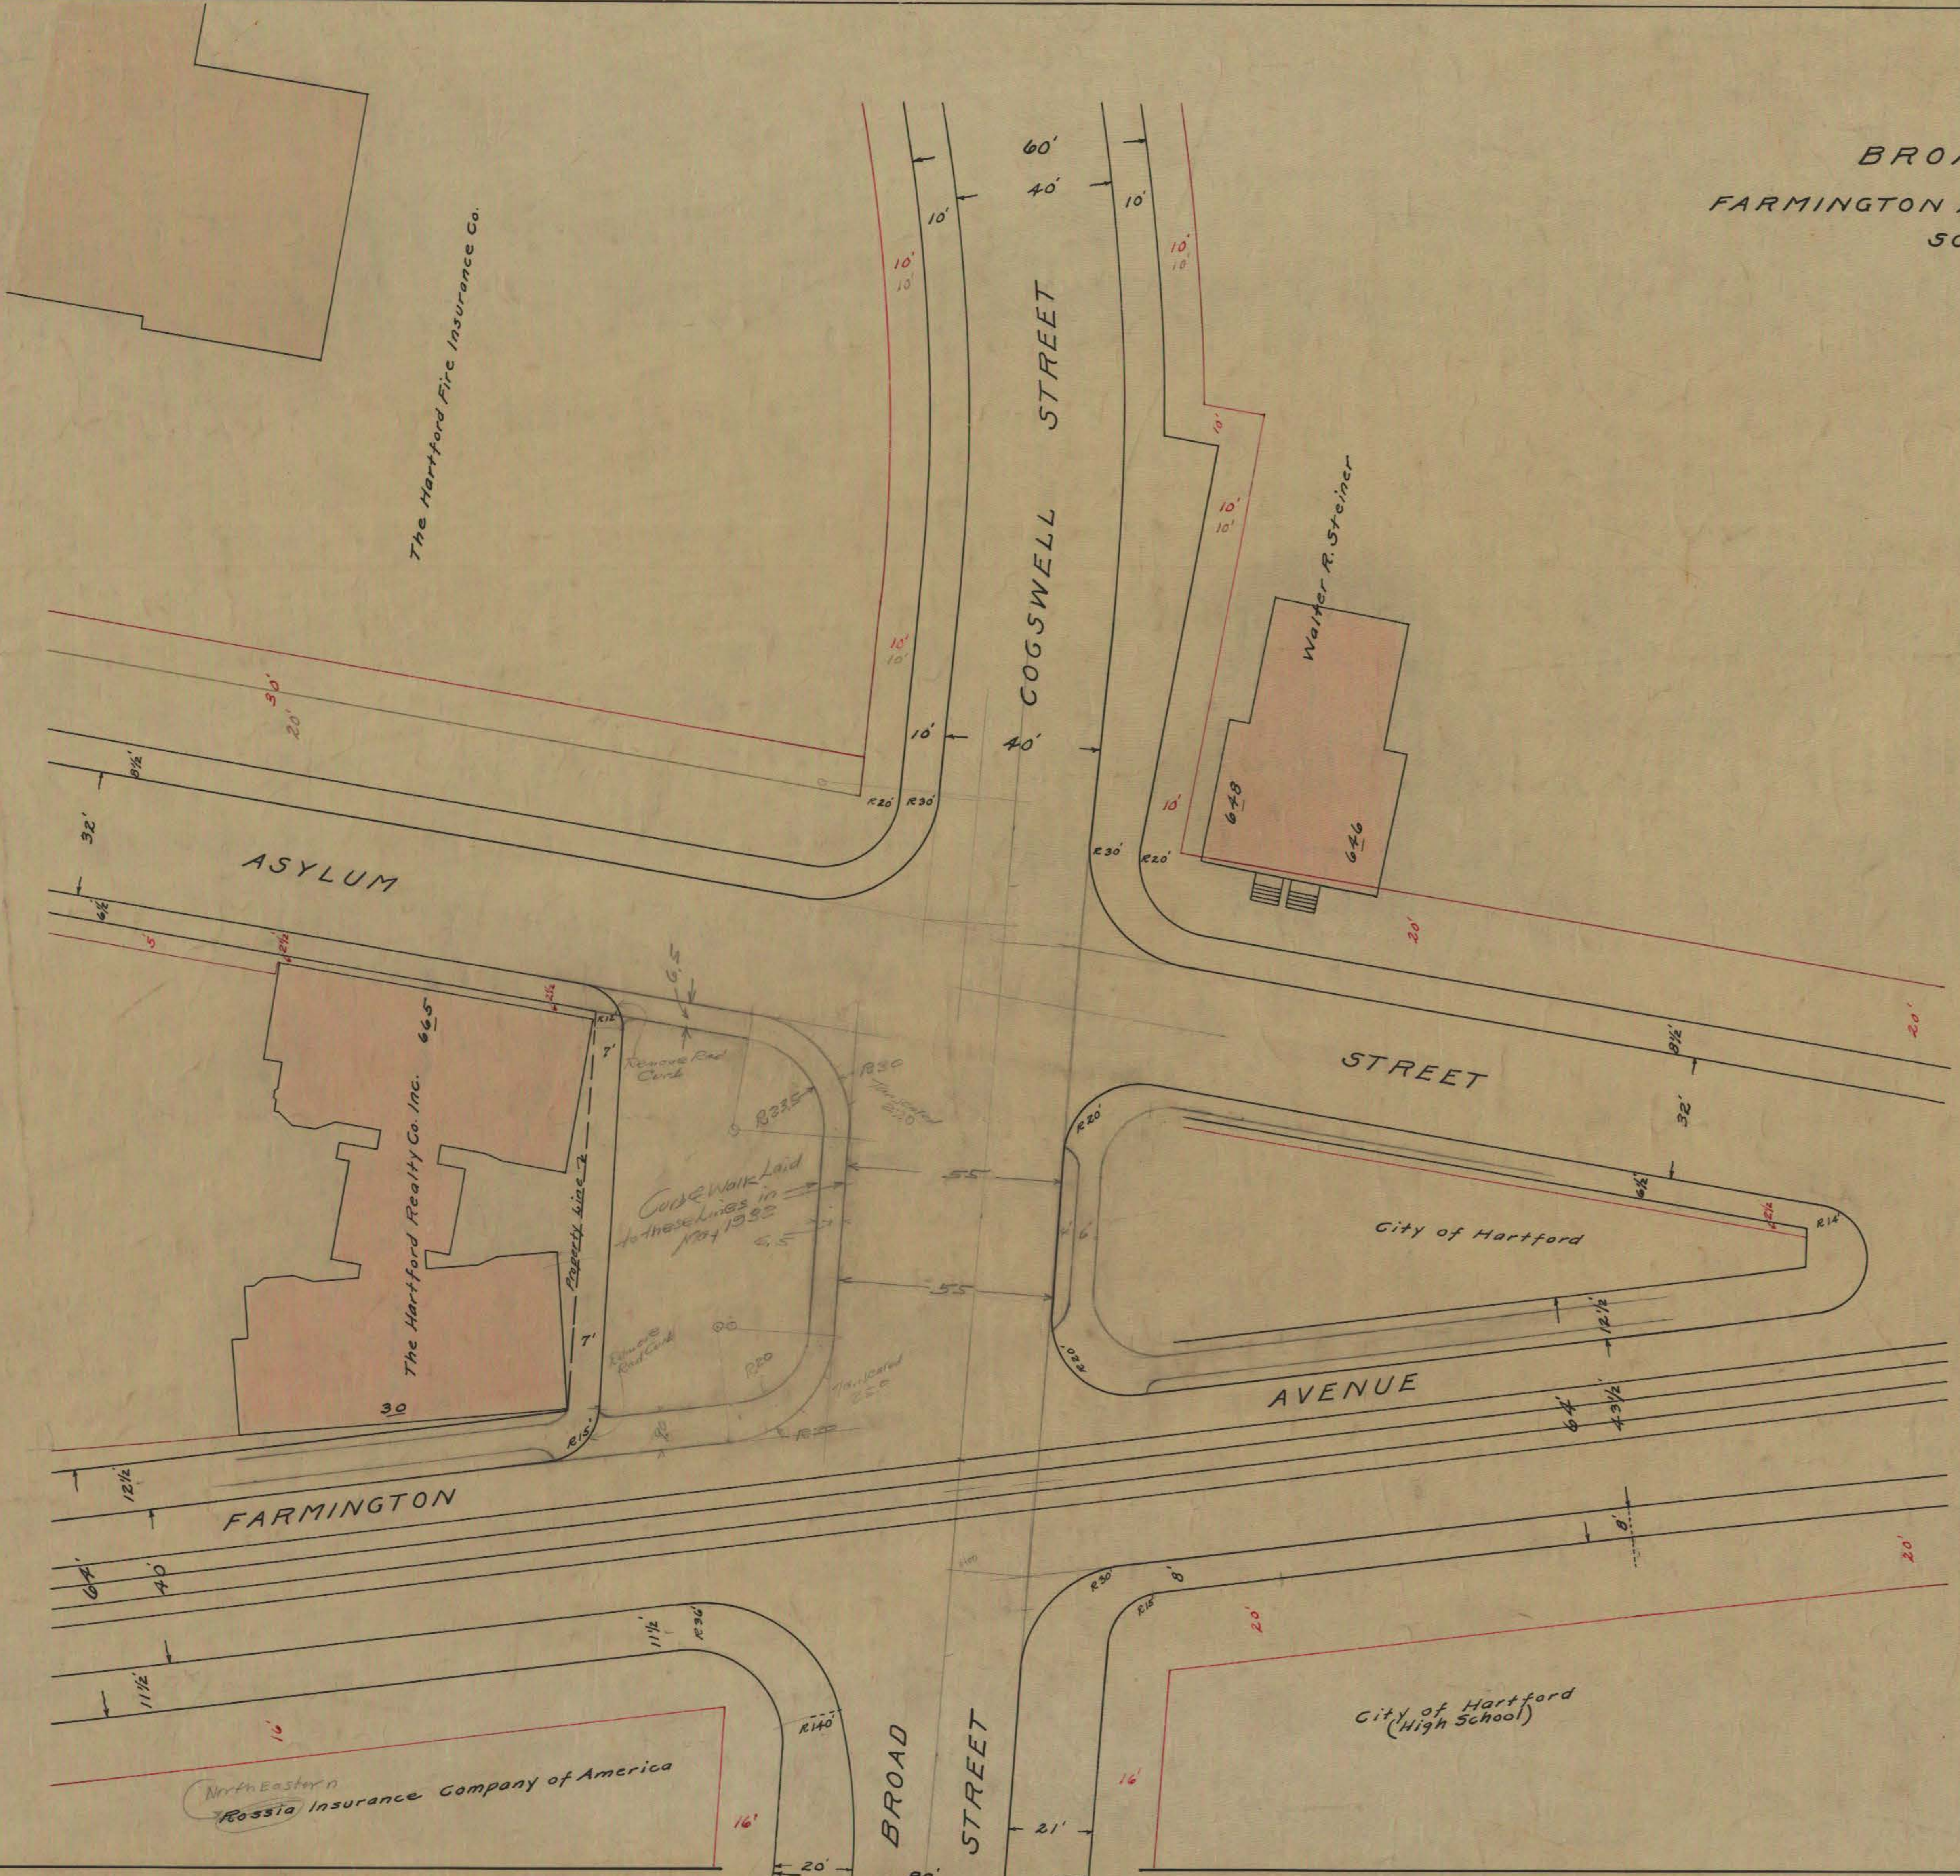

For Line of Traffic Buttons  
put into use in 1931 See Print #8

Lines & Figures in Pencil  
of Jan. 5, 1932

DEPARTMENT OF RECORDS  
CITY OF HARTFORD  
SUBJECT: Broad St at  
Farmington Ave & Asylum St.  
DATE: Feb. 1931  
SCALE: 1"=20'  
BY: W.H.B. H.I.S.  
TRACED FROM: 96  
DAYBOOK NO. 06897 16.