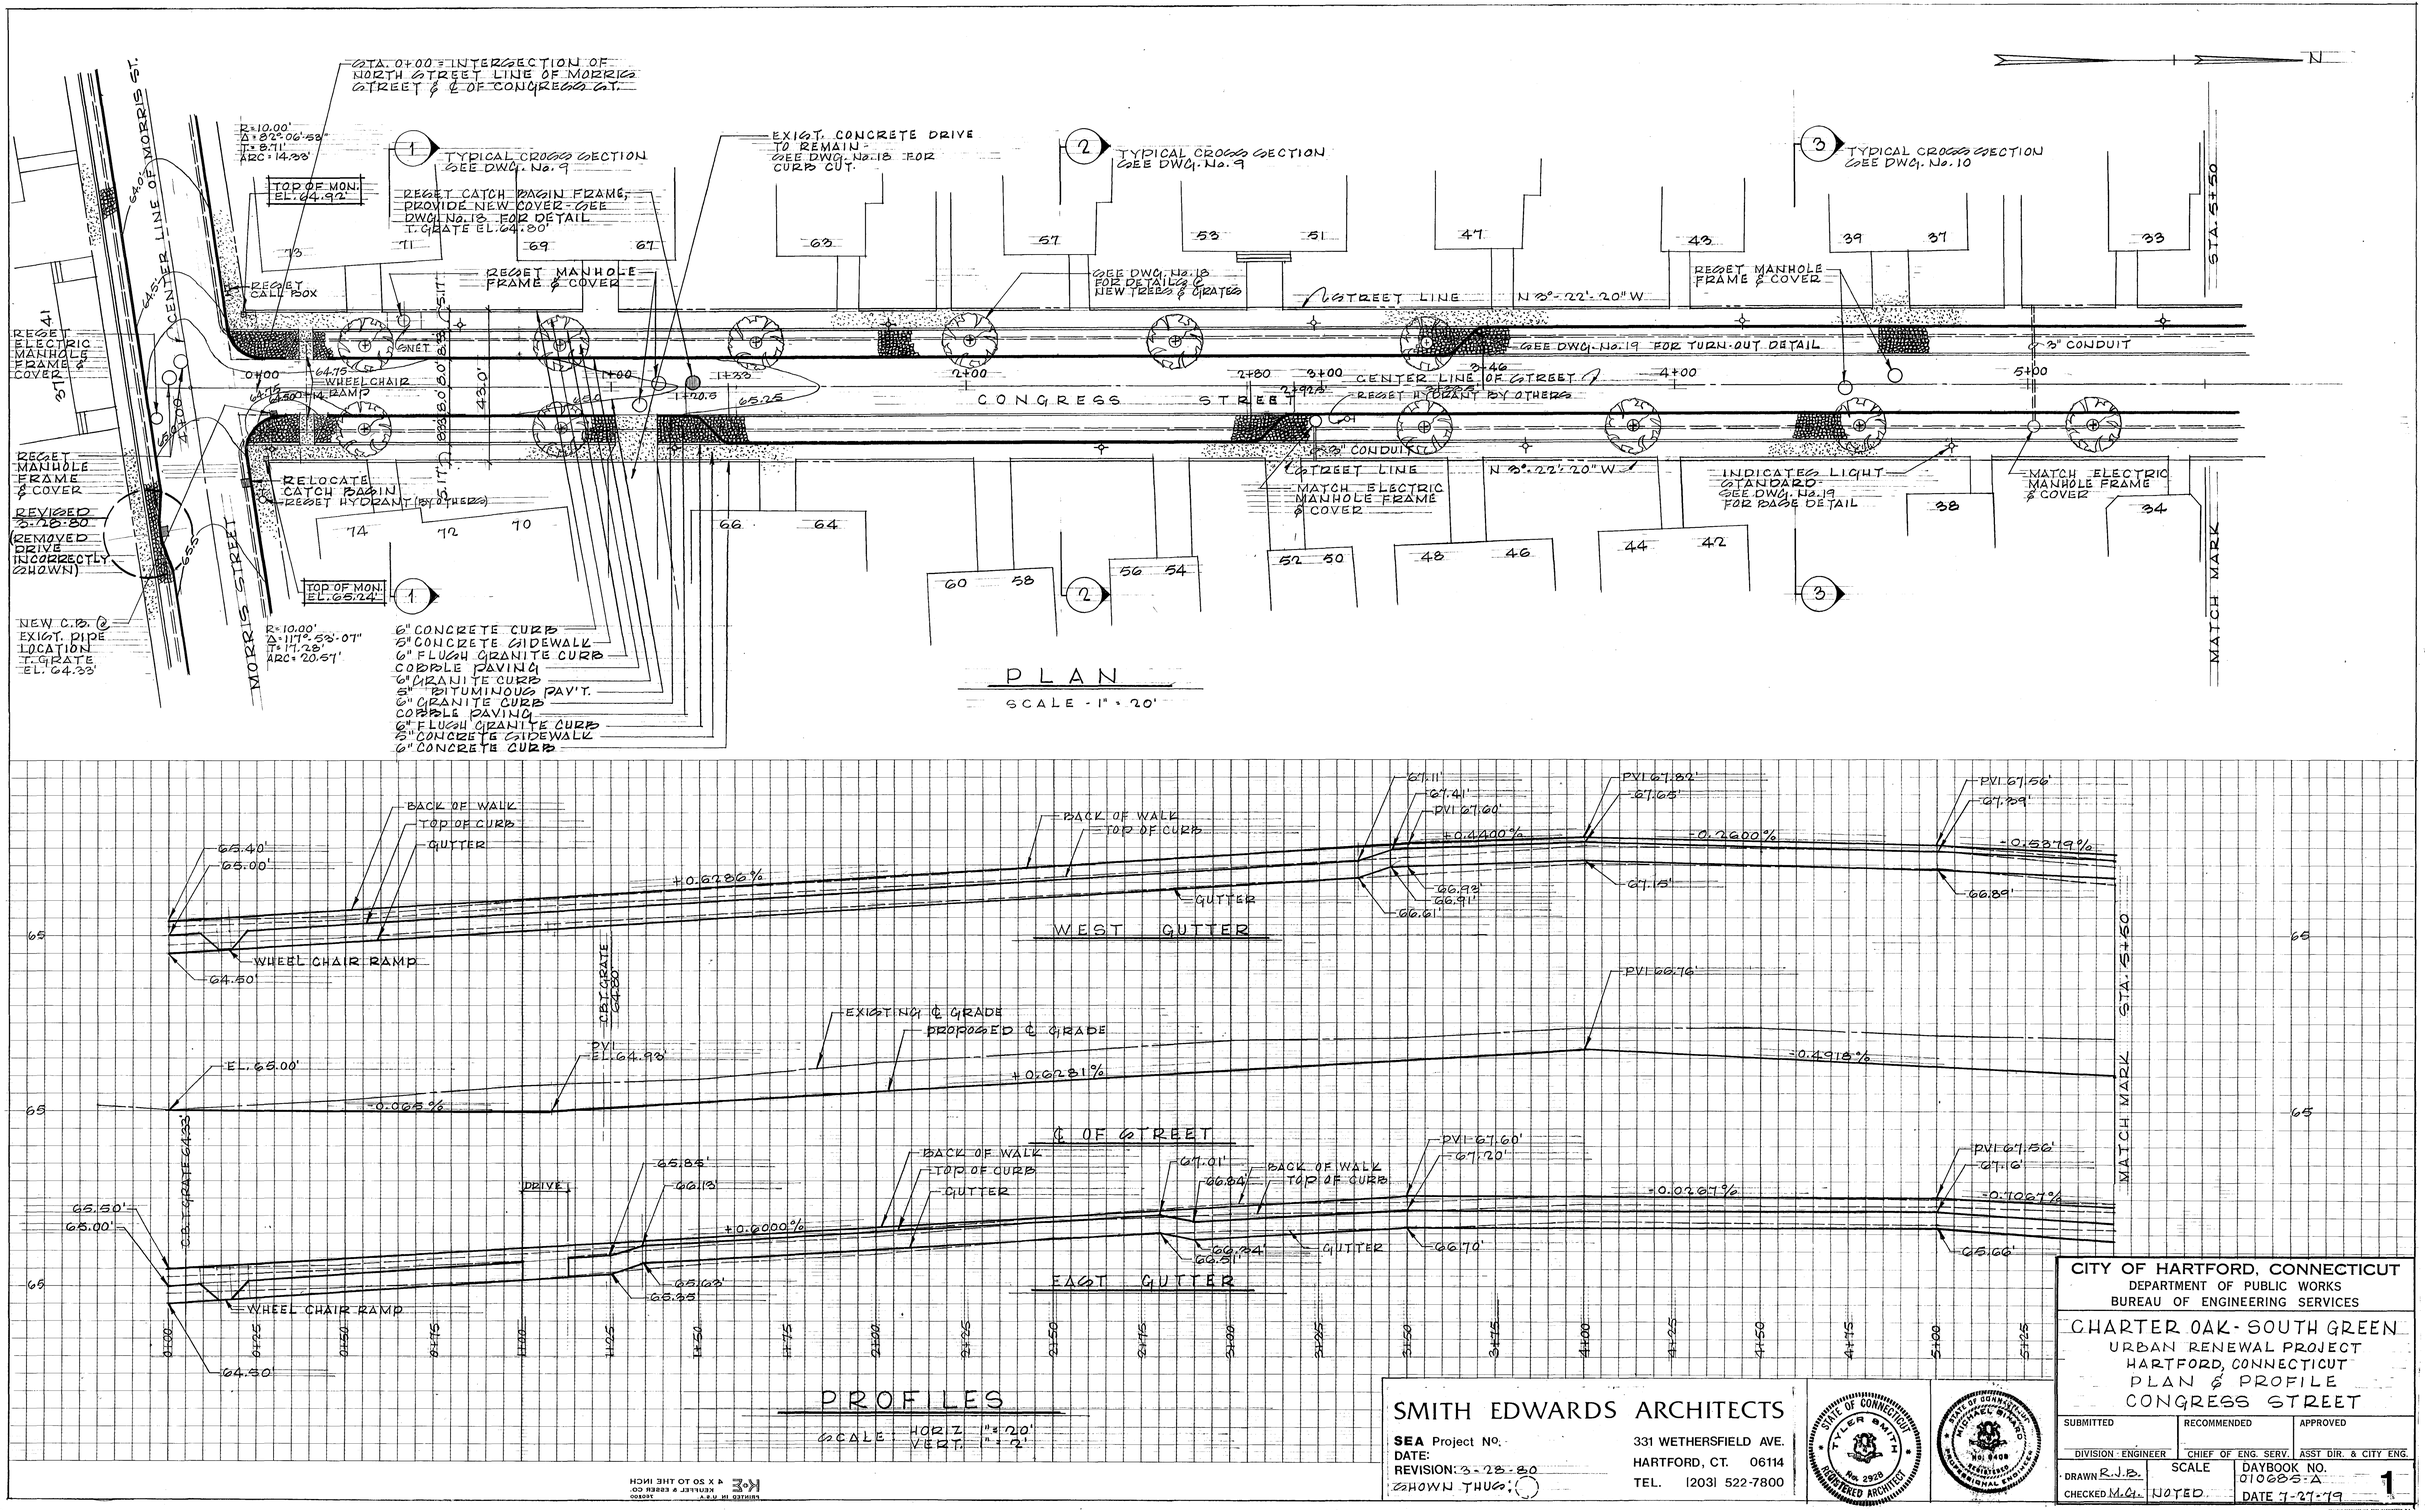

CITY OF HARTFORD, CONNECTICUT
DEPARTMENT OF PUBLIC WORKS
BUREAU OF ENGINEERING SERVICES

CHARTER OAK - SOUTH GREEN
URBAN RENEWAL PROJECT
HARTFORD, CONNECTICUT
PLAN & PROFILE
CONGRESS STREET

SUBMITTED	RECOMMENDED	APPROVED
DIVISION - ENGINEER	CHIEF OF ENG. SERV.	ASST DIR. & CITY ENG.

DRAWN R.J.B. | SCALE | DAYBOOK NO. 010685-A
CHECKED M.G. | NOTED | DATE 7-27-79 | 1

SMITH EDWARDS ARCHITECTS
SEA Project No.
DATE:
REVISION: 3-28-80
SHOWN THUS:
331 WETHERSFIELD AVE.
HARTFORD, CT. 06114
TEL. (203) 522-7800

STATE OF CONNECTICUT TYLER SMITH No. 2929 REGISTERED ARCHITECT

STATE OF CONNECTICUT MICHAEL GIANCO No. 9408 REGISTERED PROFESSIONAL ENGINEER

A85-38