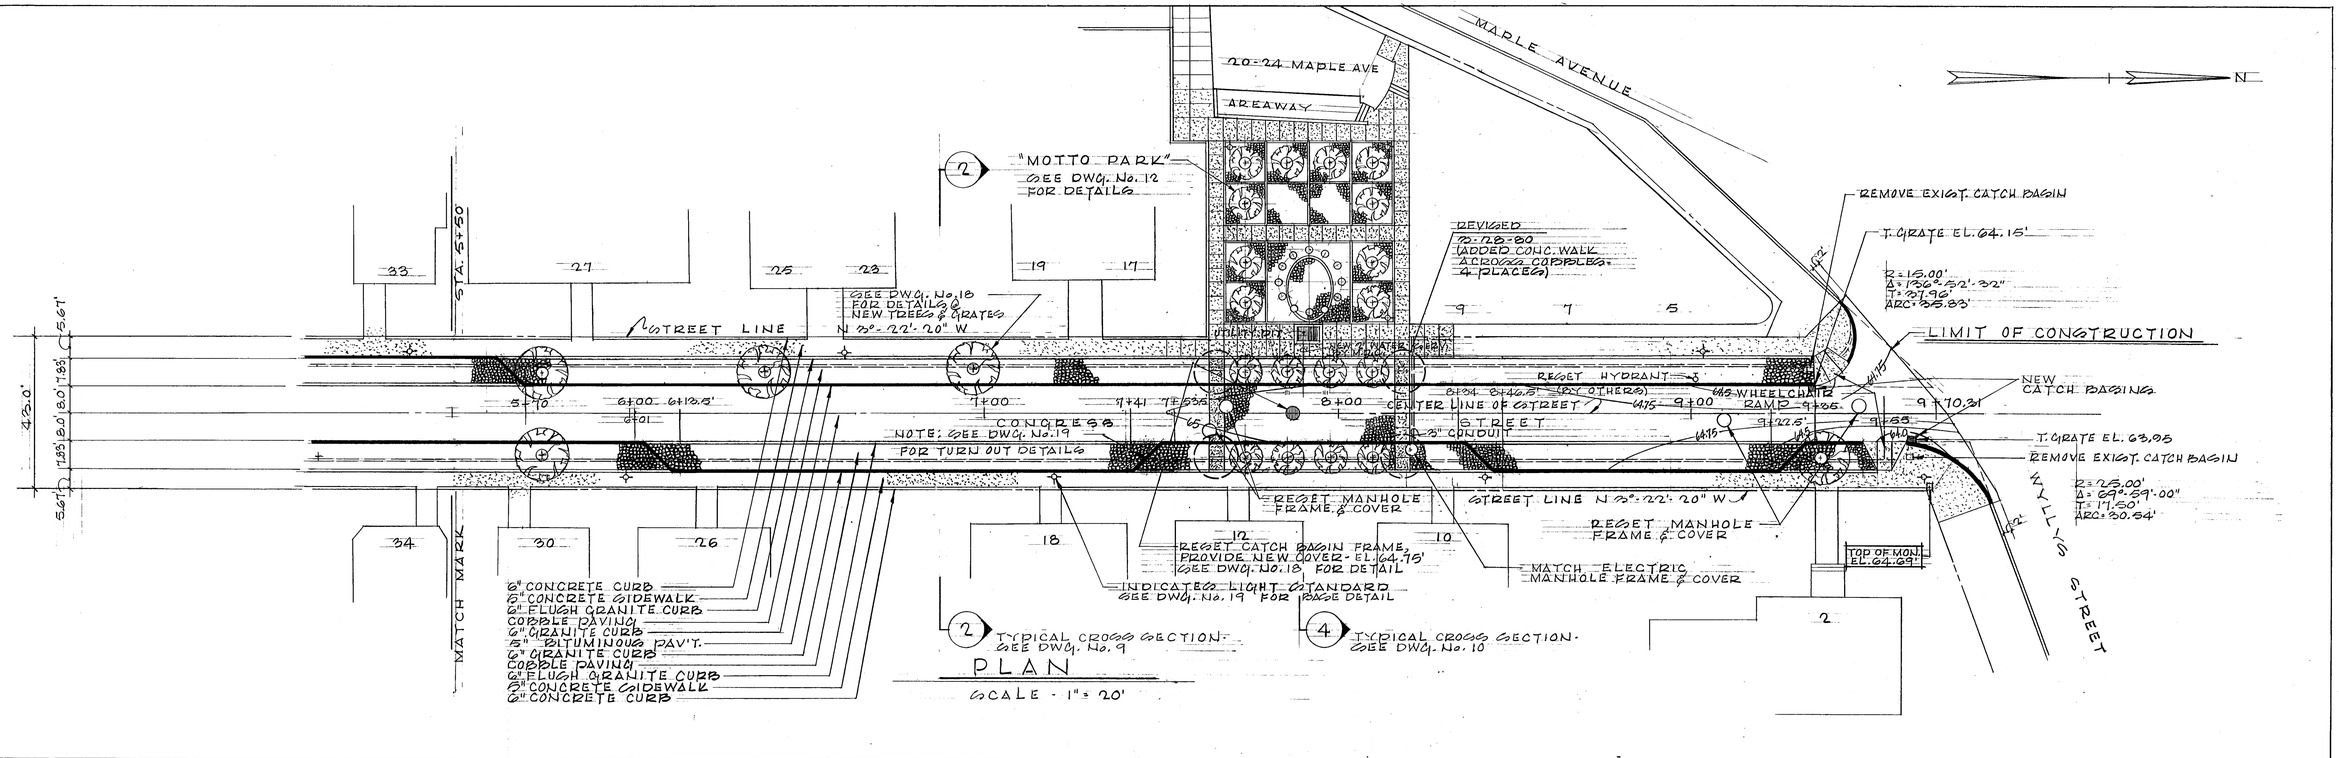

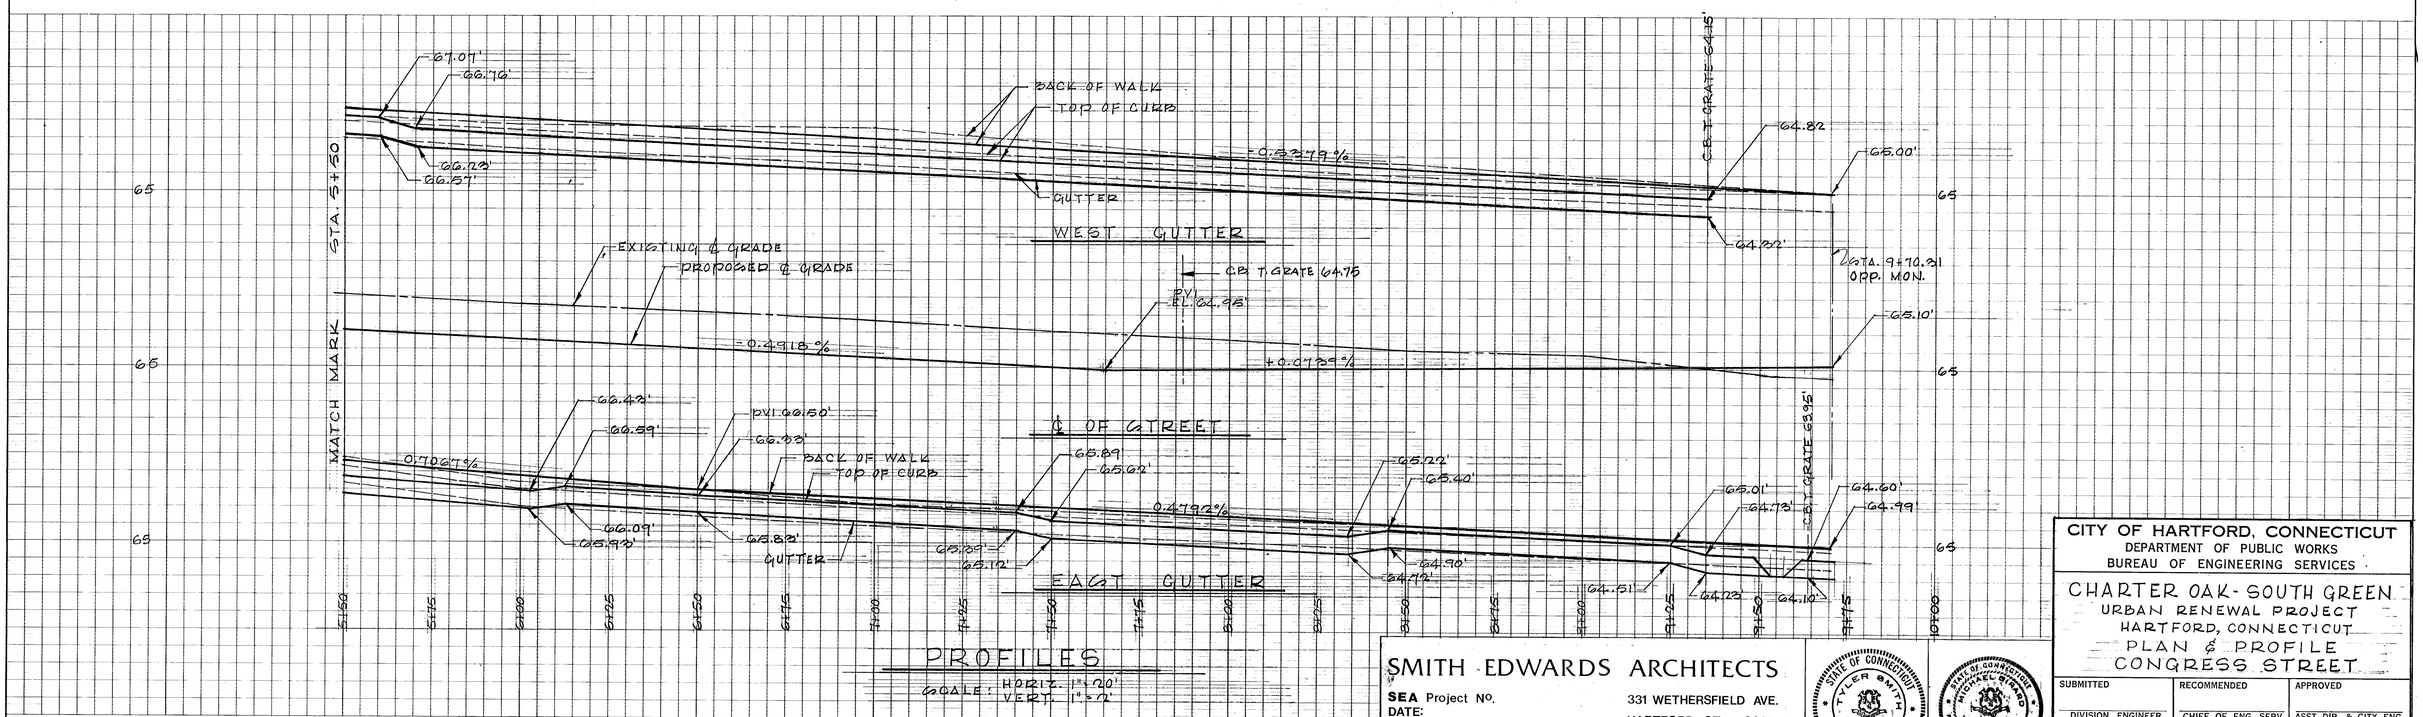

SMITH EDWARDS ARCHITECTS
331 WETHERSFIELD AVE.
HARTFORD, CT. 06114
TEL. (203) 522-7800

SEA Project No.
DATE:
REVISION: 3-28-80
SHOWN THUS: ◯

STATE OF CONNECTICUT — TYLER SMITH — No. 2929 — REGISTERED ARCHITECT

STATE OF CONNECTICUT — MICHAEL SIRAGO — No. 8408 — REGISTERED PROFESSIONAL ENGINEER

CITY OF HARTFORD, CONNECTICUT
DEPARTMENT OF PUBLIC WORKS
BUREAU OF ENGINEERING SERVICES

CHARTER OAK - SOUTH GREEN
URBAN RENEWAL PROJECT
HARTFORD, CONNECTICUT
PLAN & PROFILE
CONGRESS STREET

SUBMITTED	RECOMMENDED	APPROVED
DIVISION ENGINEER	CHIEF OF ENG. SERV.	ASST DIR. & CITY ENG.

DRAWN R.J.B.
CHECKED M.G.
SCALE NOTED
DAYBOOK NO. 010685-B
DATE 7-27-79
2