

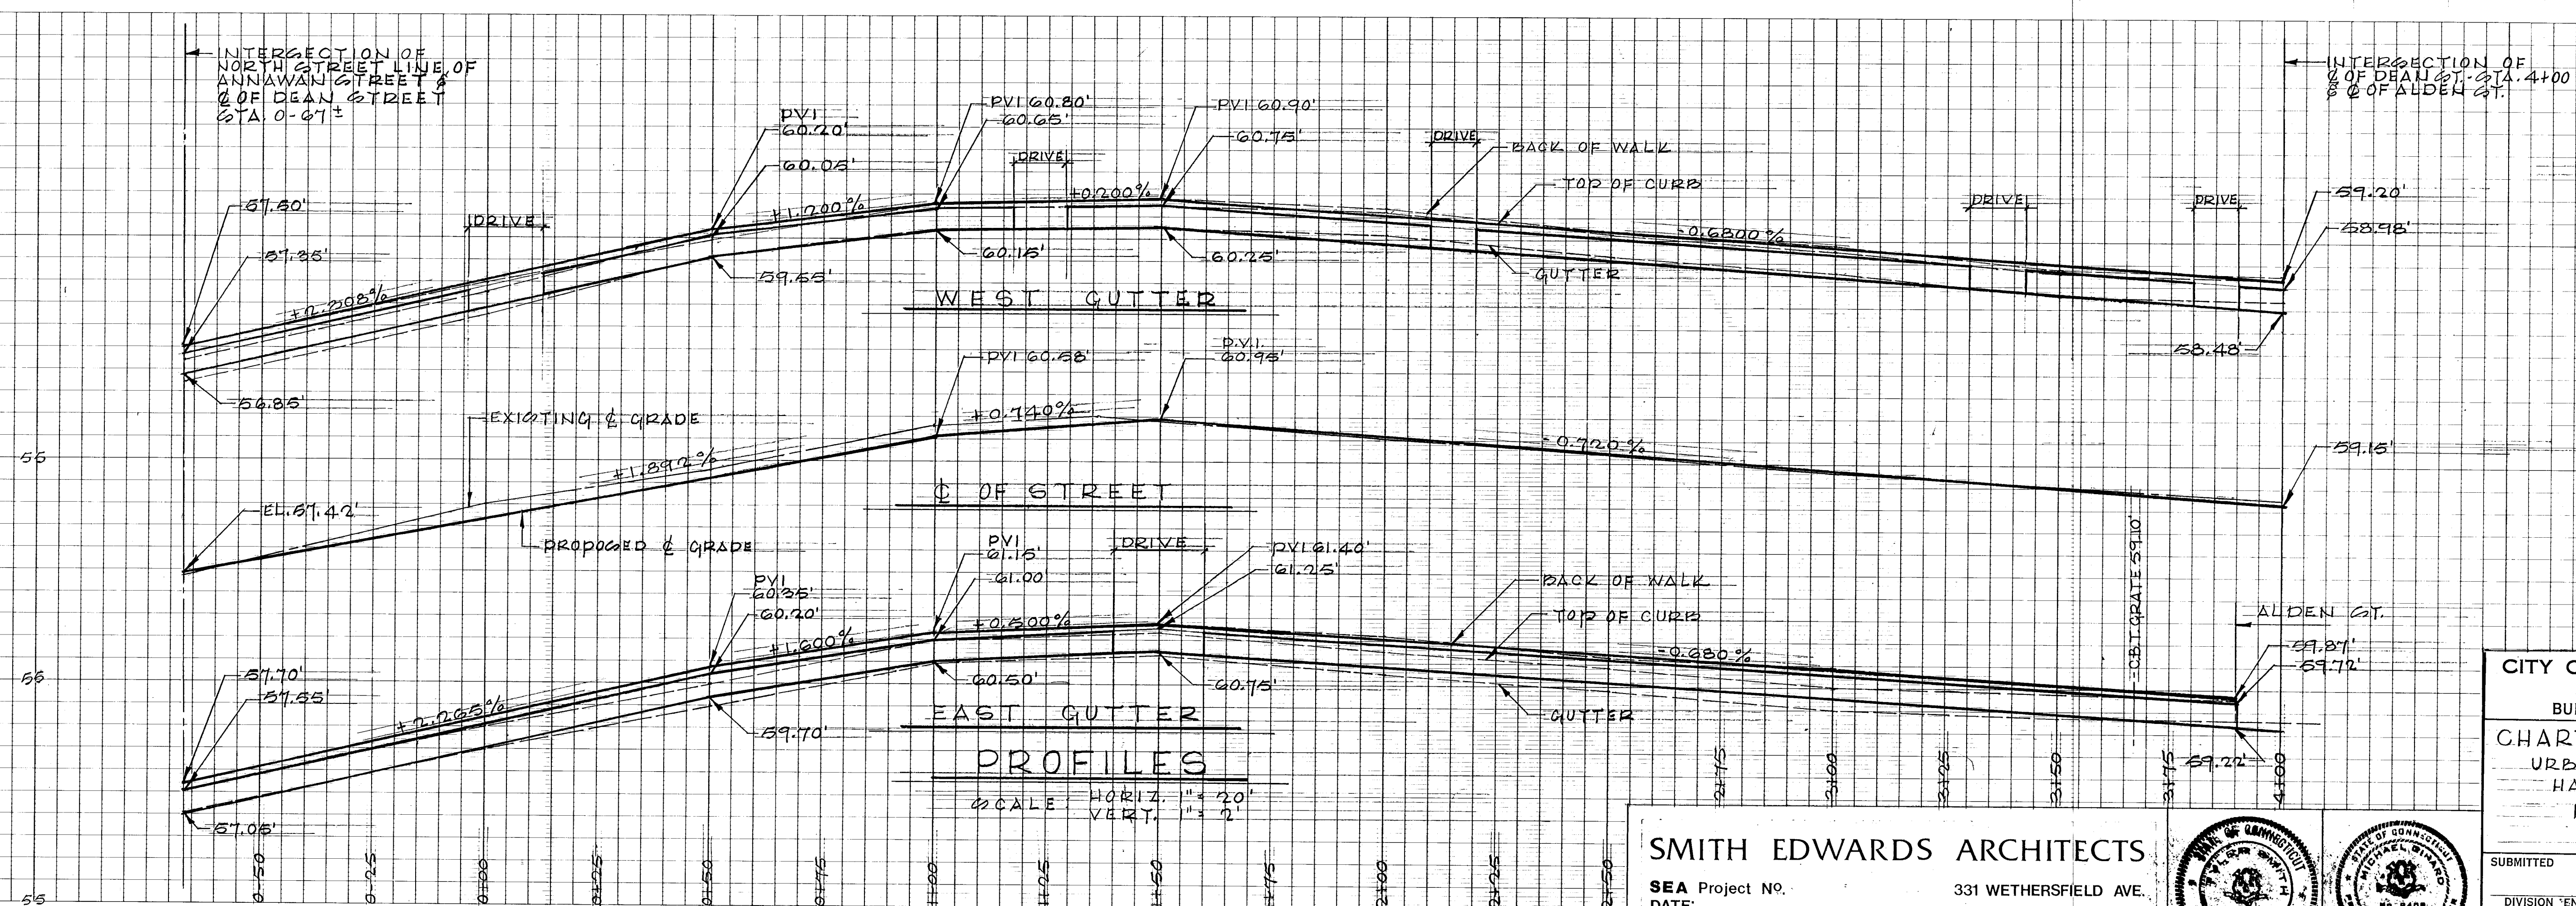
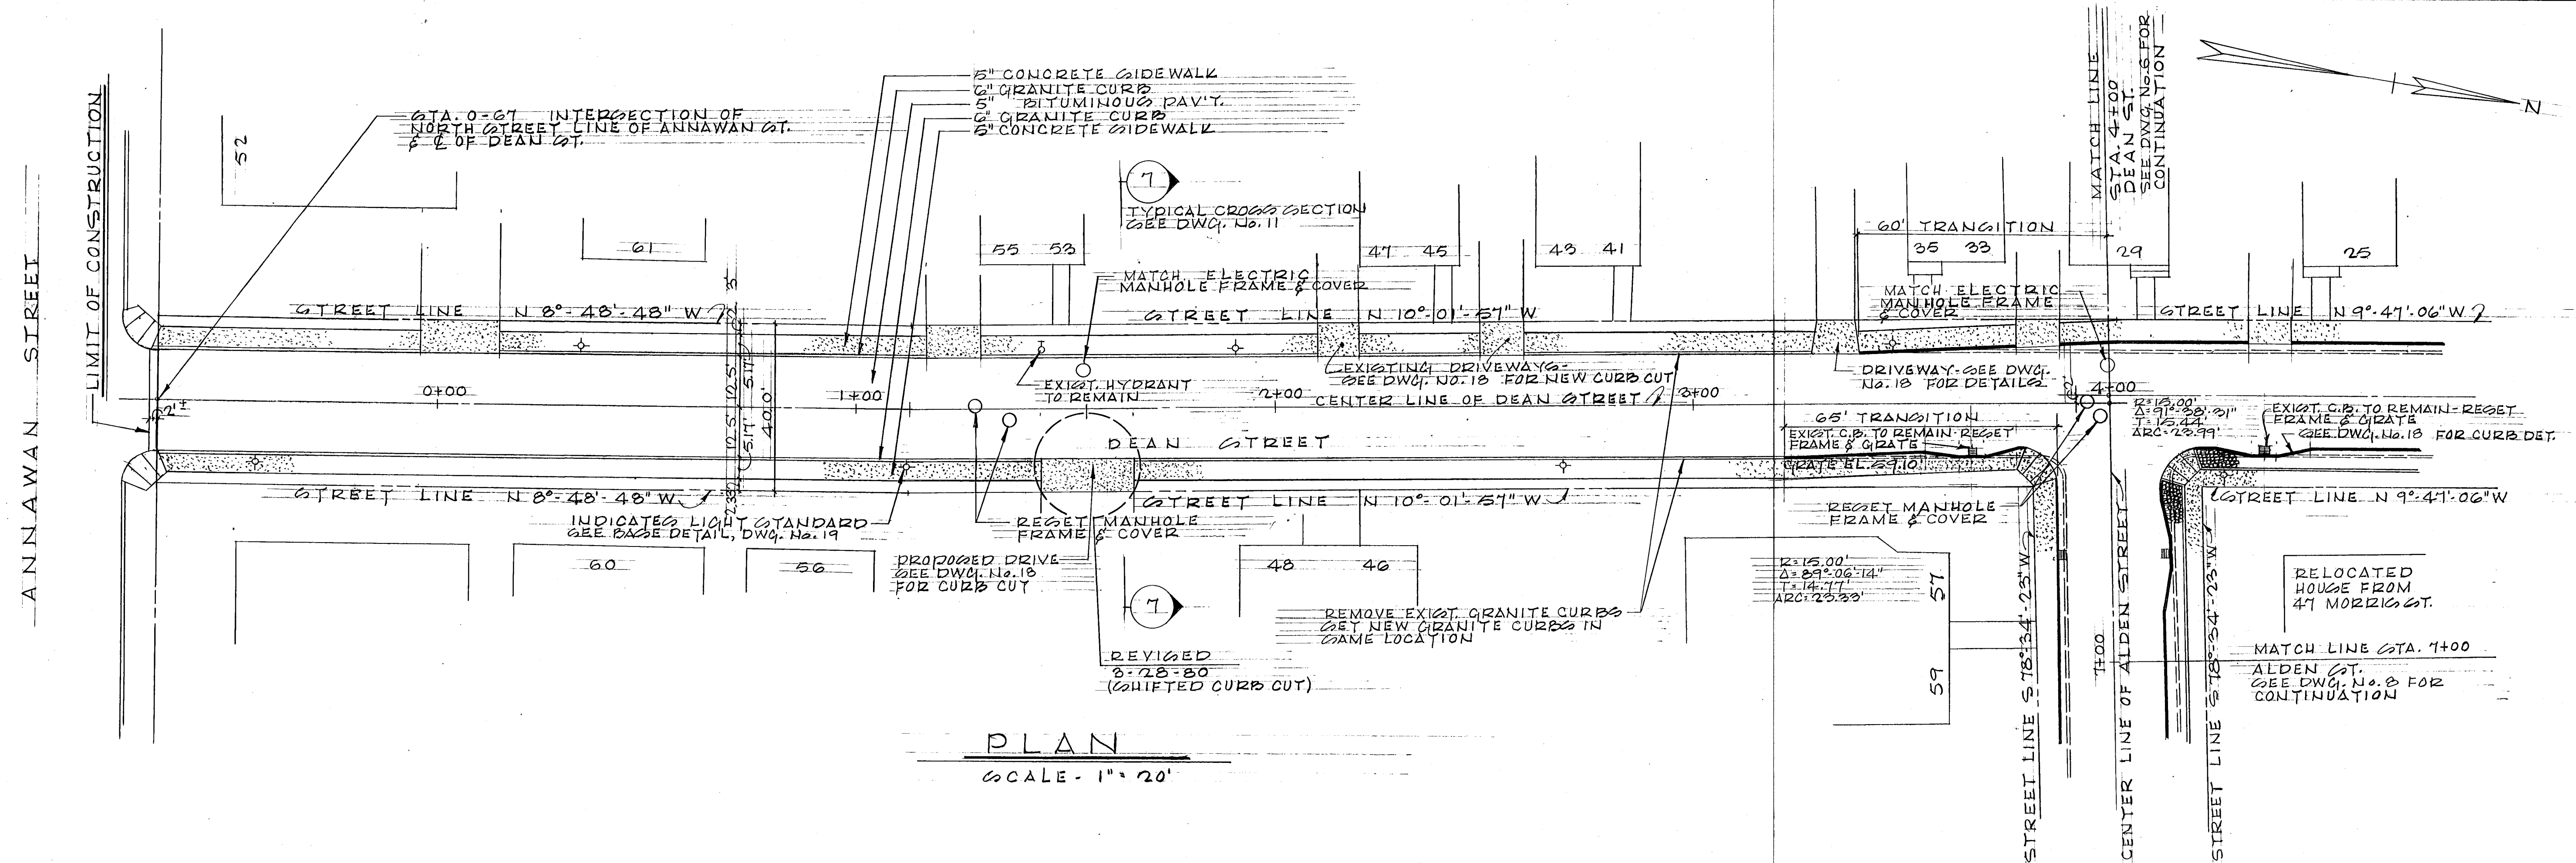


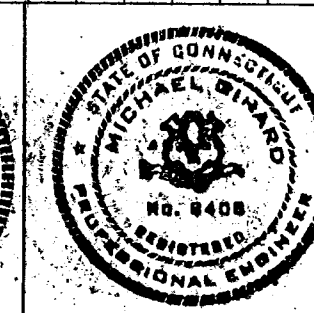

SMITH EDWARDS ARCHITECTS

SEA Project NO. _____
DATE: _____
REVISION: 3-28-80
SHOWN THUS: ()

331 WETHERSFIELD AVE.
HARTFORD, CT. 06114
TEL. (203) 522-7800

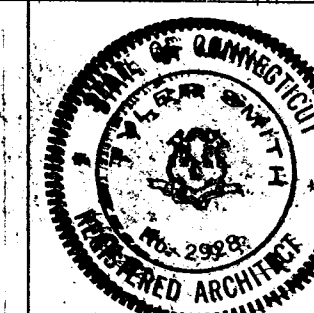

CITY OF HARTFORD, CONNECTICUT
DEPARTMENT OF PUBLIC WORKS
BUREAU OF ENGINEERING SERVICES

CHARTER OAK - SOUTH GREEN
URBAN RENEWAL PROJECT
HARTFORD, CONNECTICUT
PLAN & PROFILE
DEAN STREET

SUBMITTED		RECOMMENDED	APPROVED
DIVISION ENGINEER	CHIEF OF ENG. SERV.	ASST. DIR. & CITY ENG.	
DRAYN <u>R. J. B.</u>	SCALE	DAYBOOK NO.	
CHECKED <u>M. C.</u>	<u>NOTED</u>	010685-E	
		DATE 7-27-79	
		5	