

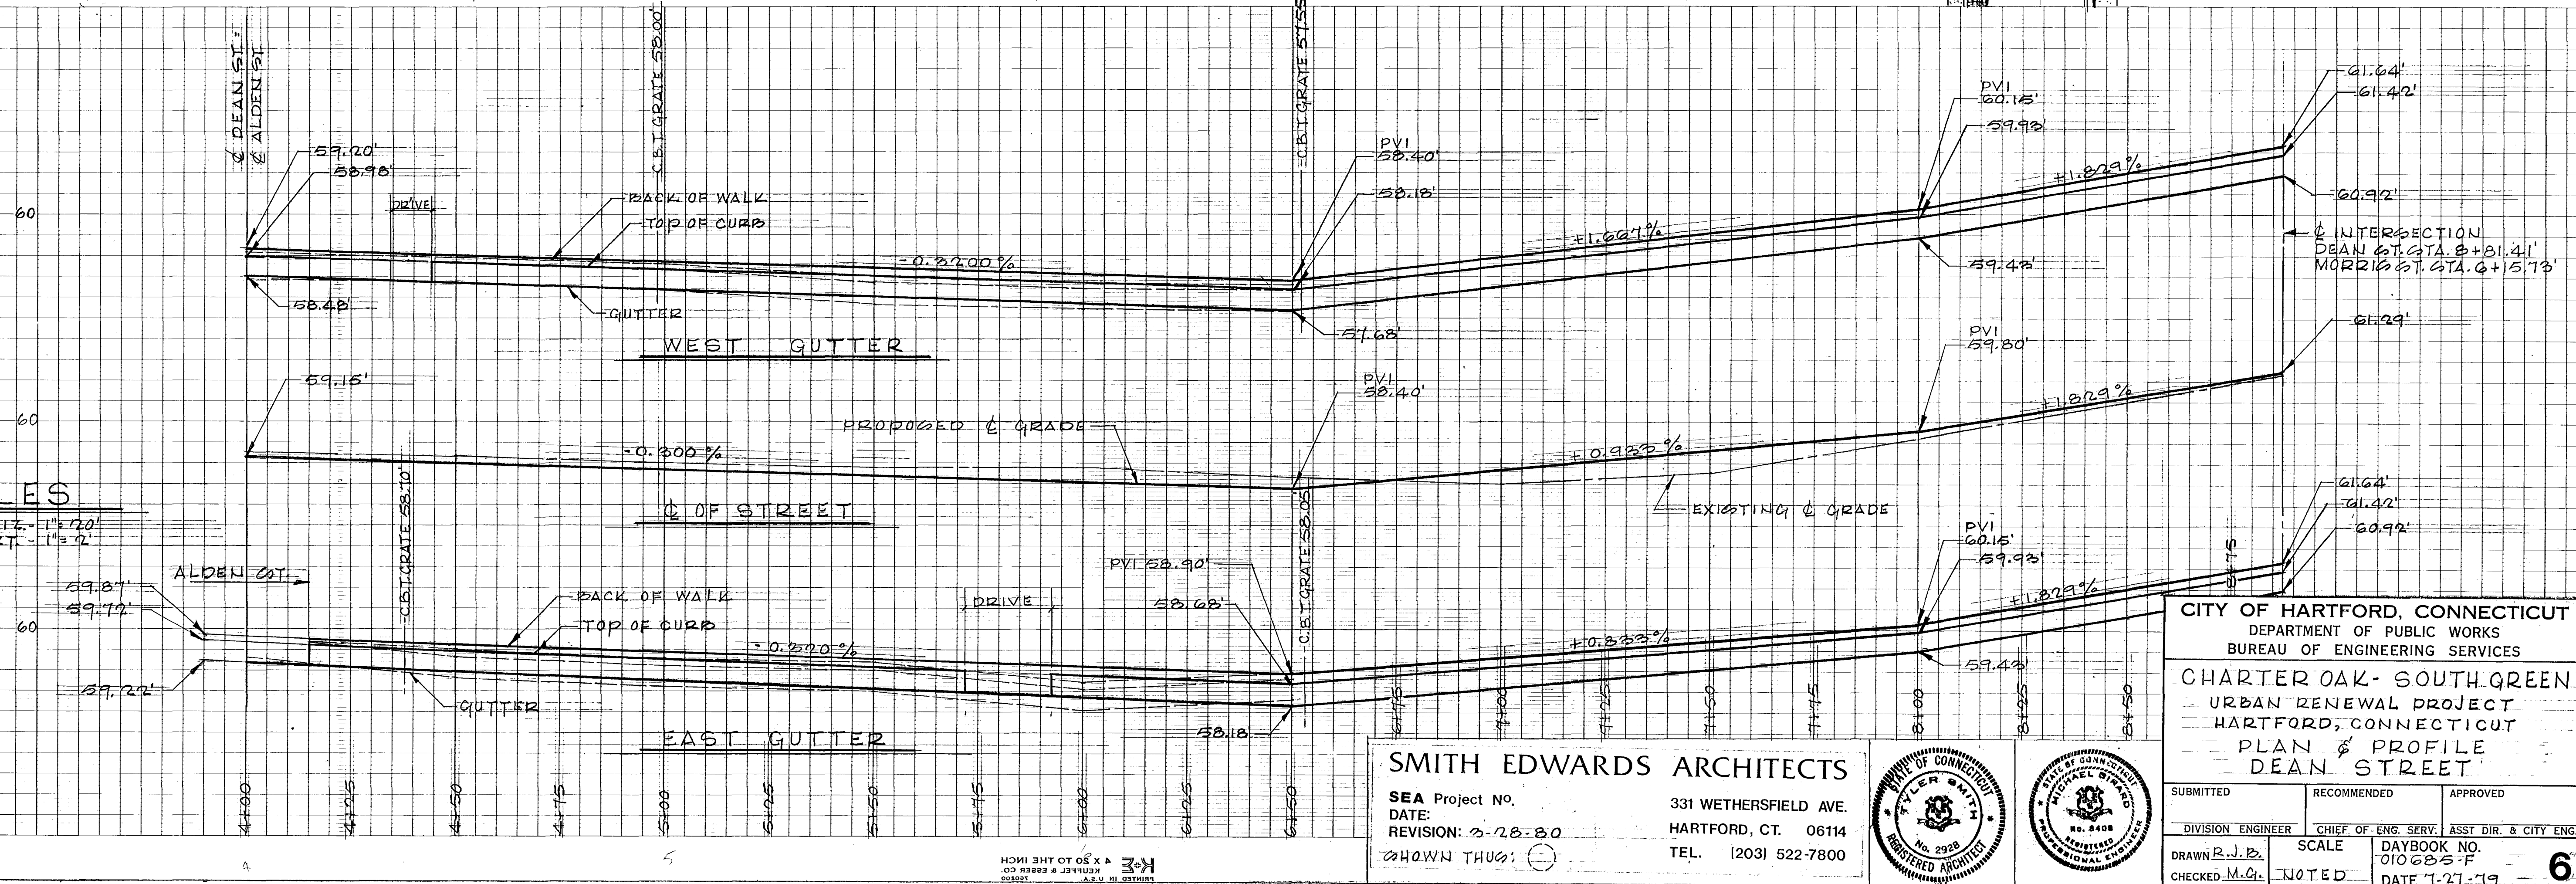
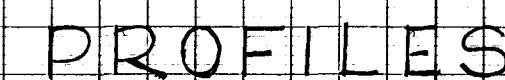


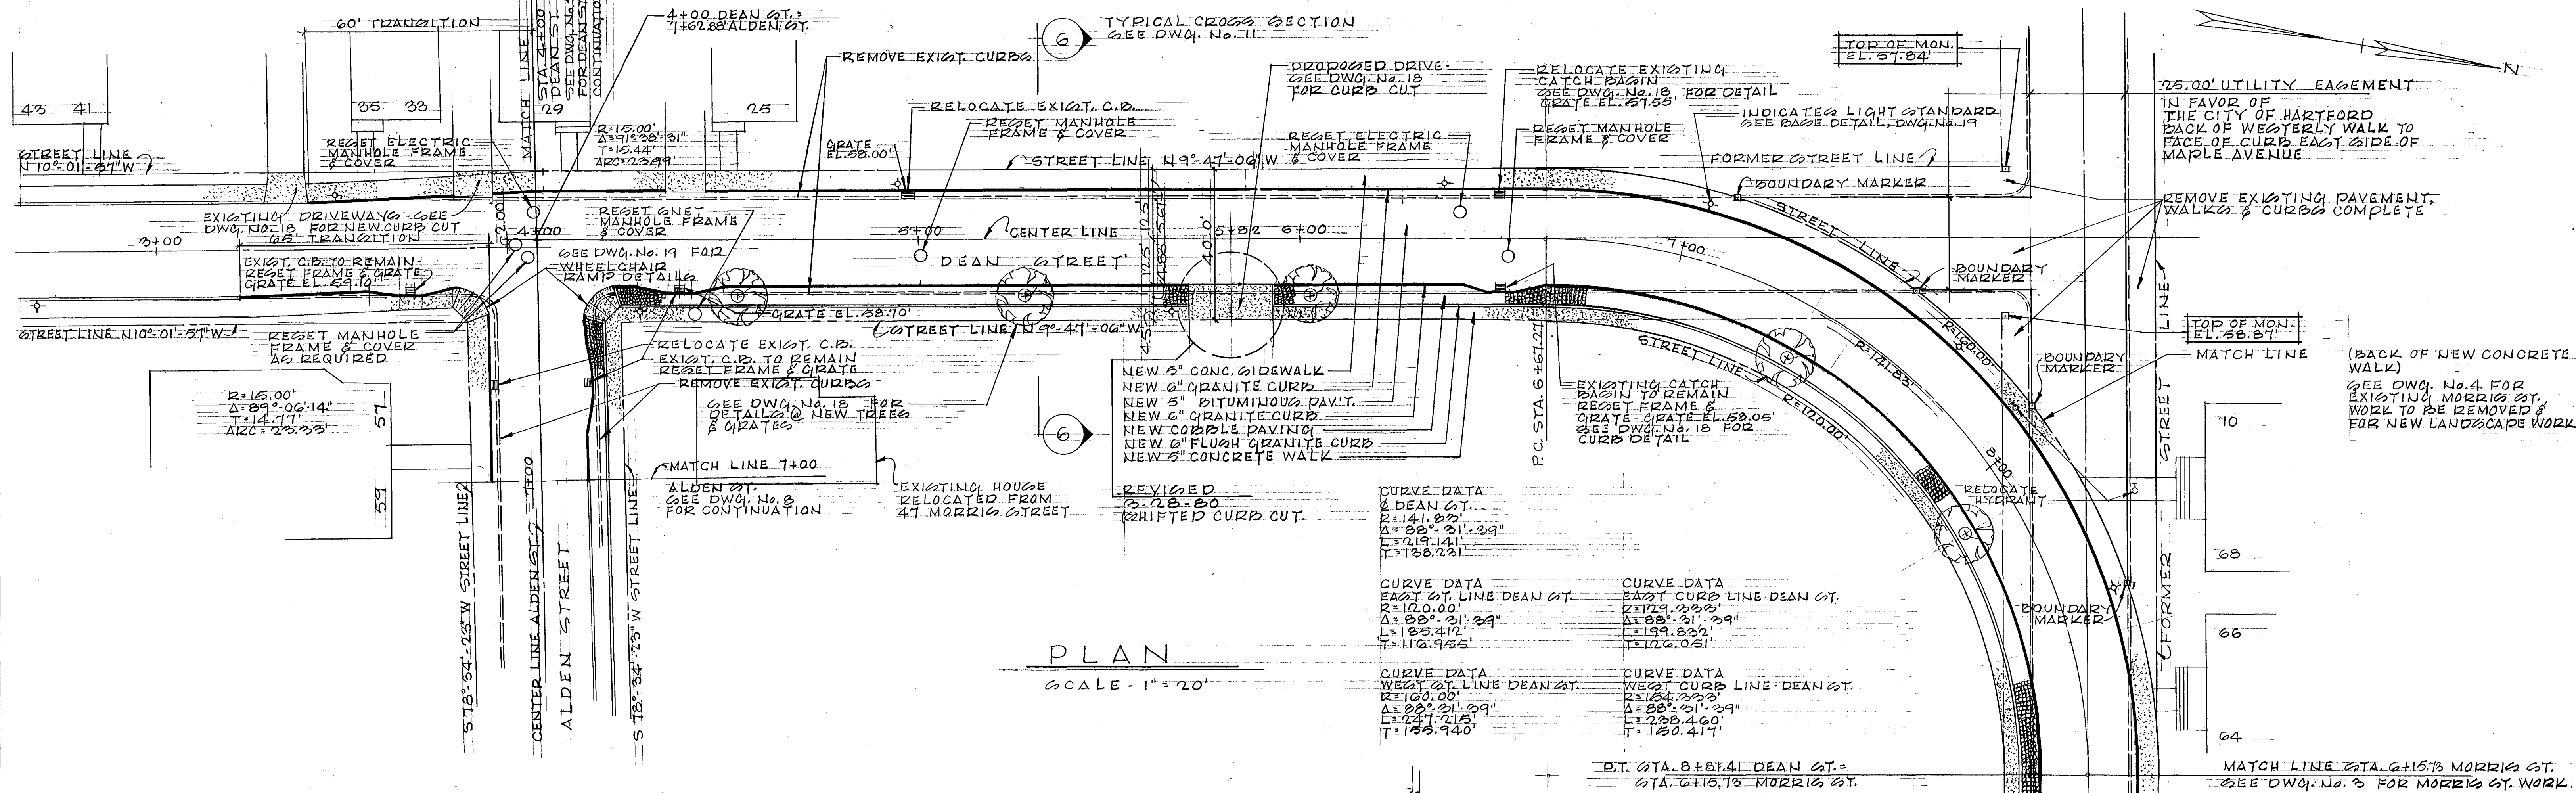

SEA Project No. 331 WETHERSFIELD AVE
DATE: HARTFORD, CT. 06114
REVISION: 3-28-80 TEL. [203] 522-7800
SHOWN THUS: ()

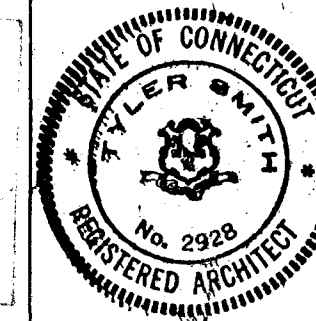

CITY OF HARTFORD, CONNECTICUT			
DEPARTMENT OF PUBLIC WORKS			
BUREAU OF ENGINEERING SERVICES			
CHARTER OAK- SOUTH GREEN URBAN RENEWAL PROJECT HARTFORD, CONNECTICUT PLAN & PROFILE DEAN STREET			
SUBMITTED	RECOMMENDED	APPROVED	
DIVISION ENGINEER	CHIEF OF ENG. SERV.	ASST. DIR. & CITY ENG.	
DRAWN R.J.D.	SCALE	DAYBOOK NO. 010 685-F	6
CHECKED M.G.	NOTED	DATE 7-27-79	