





RADIUS WALK CROSS-SECTION

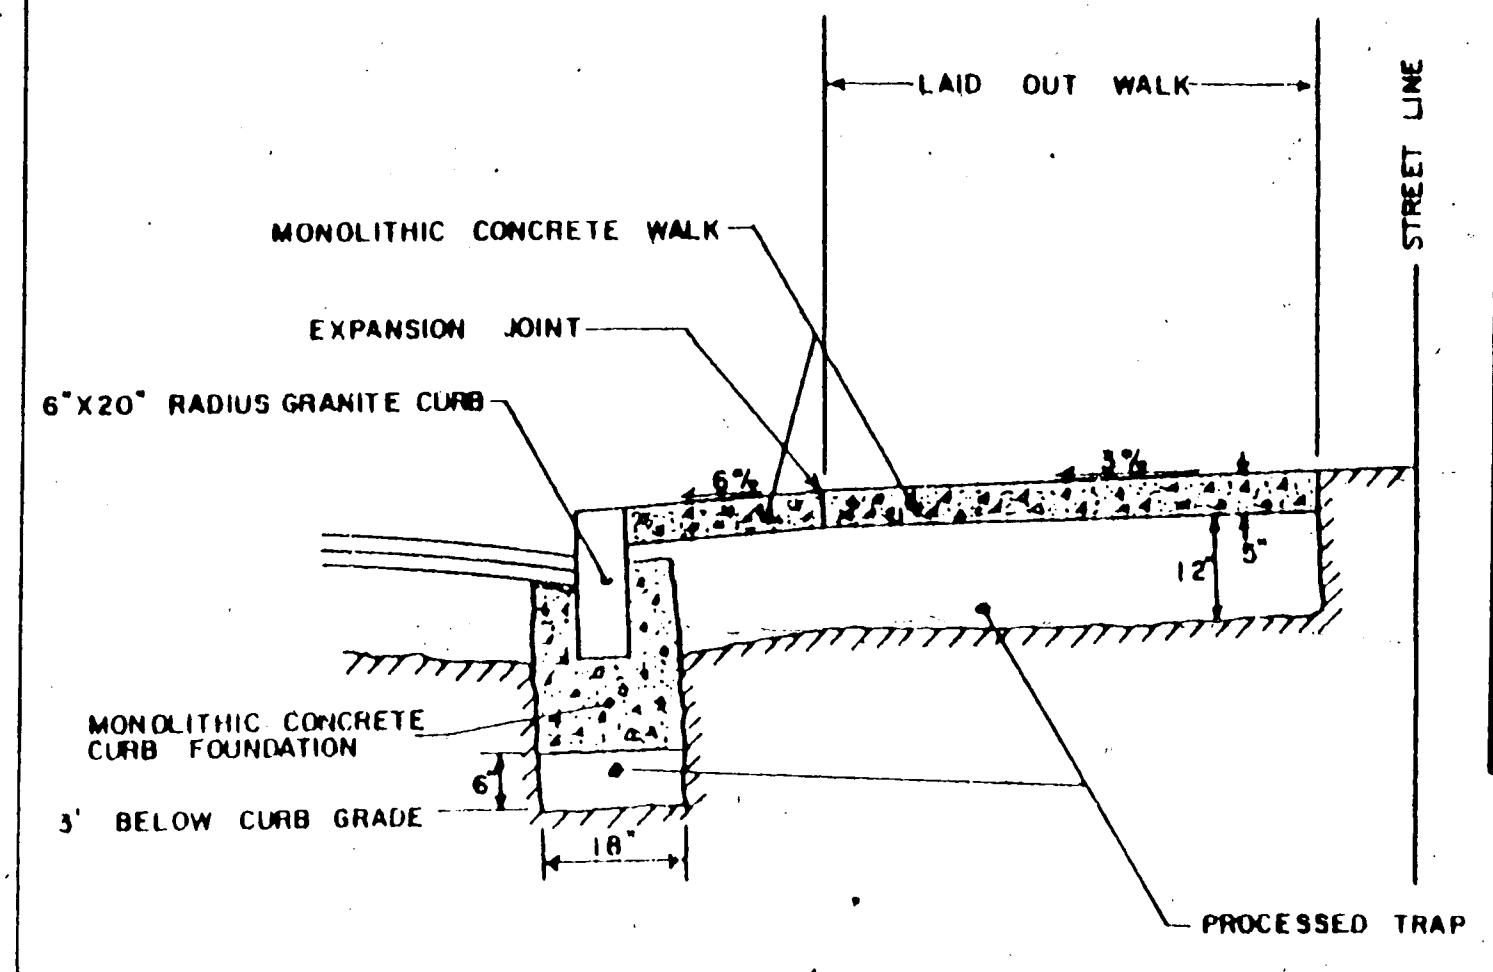


WALK CROSS-SECTION

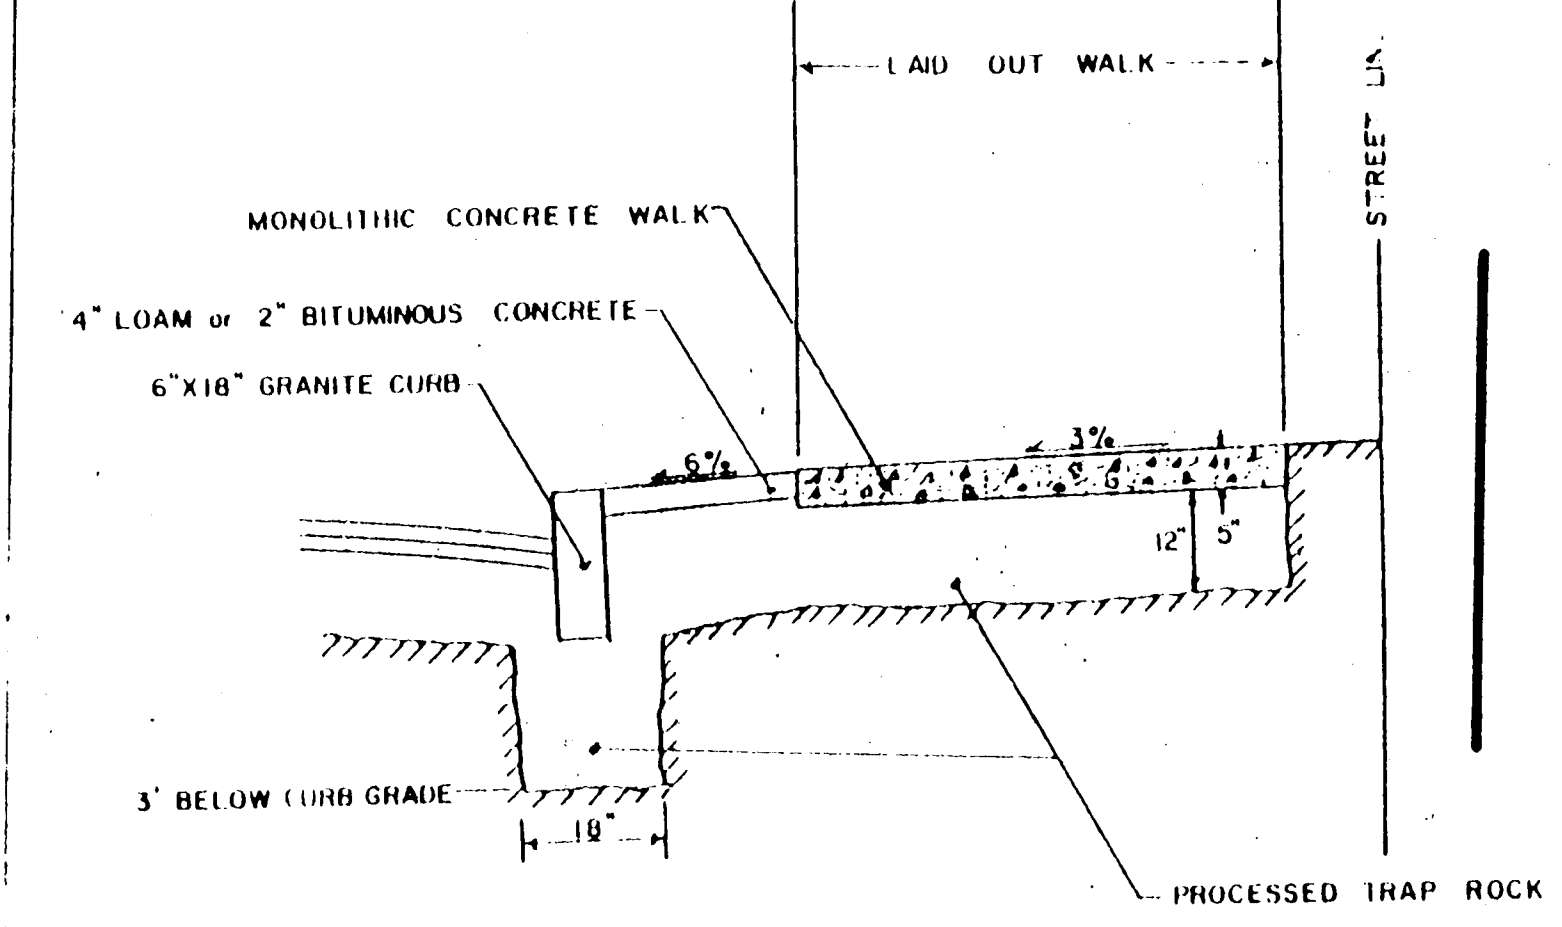


DRIVEWAY CROSS-SECTION

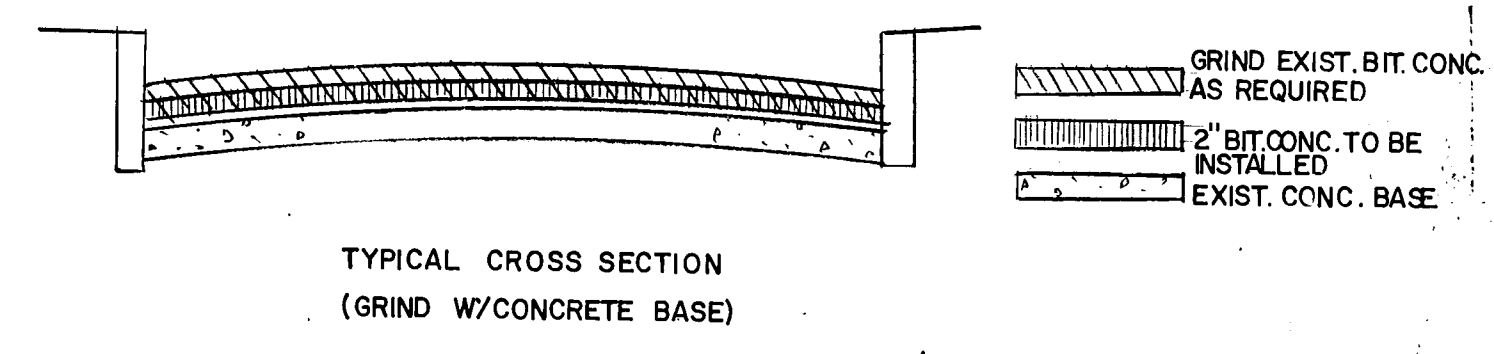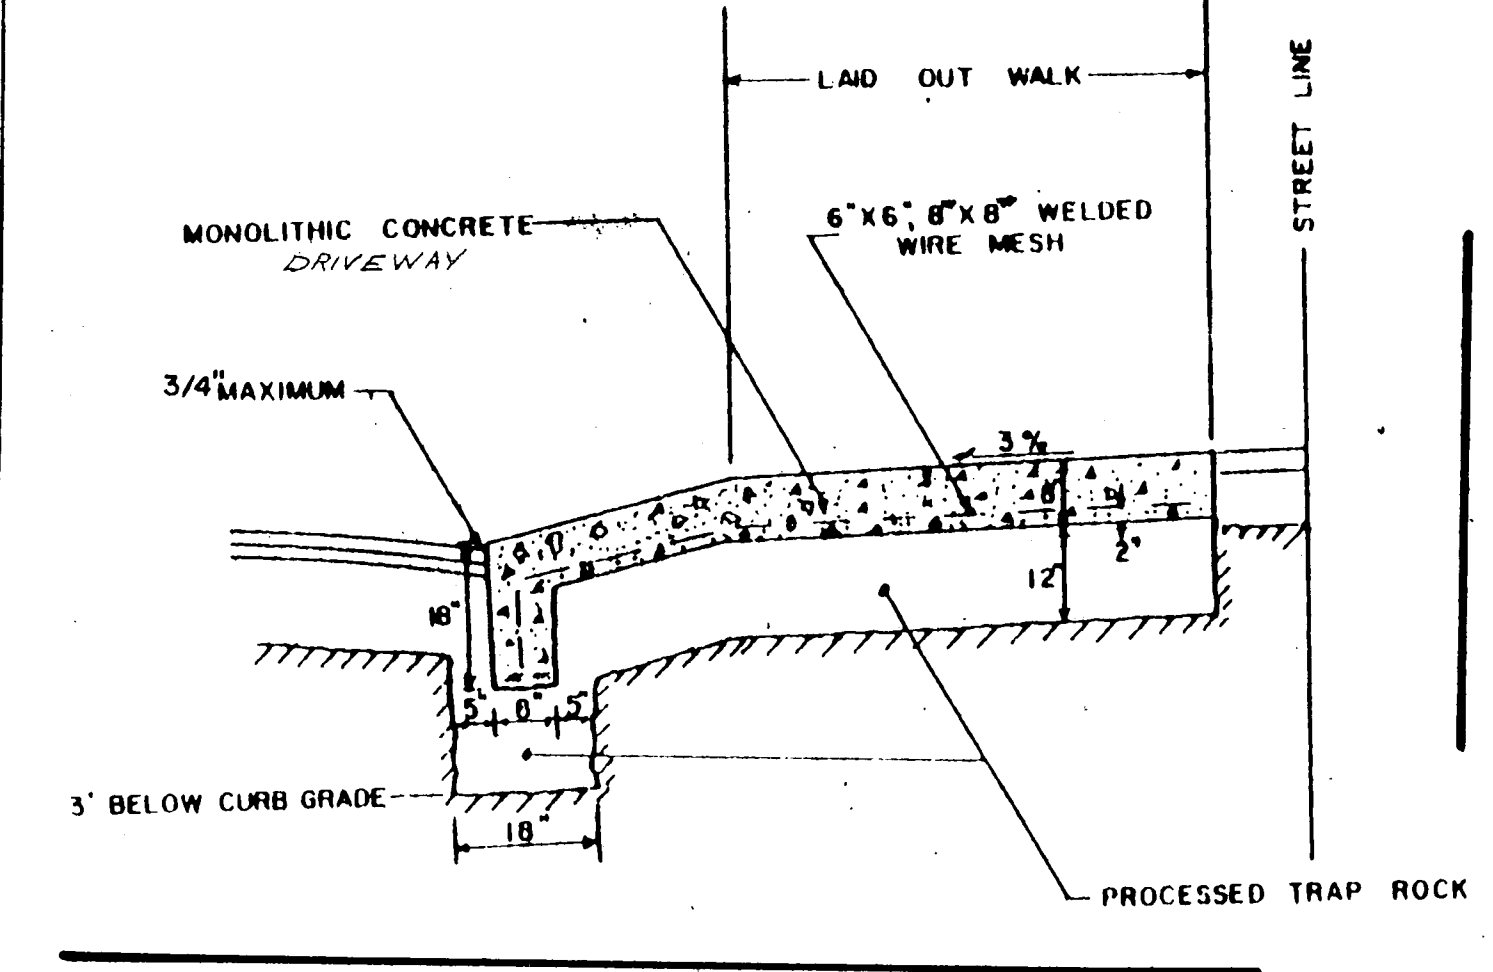


WHEELCHAIR RAMP - DETAILS

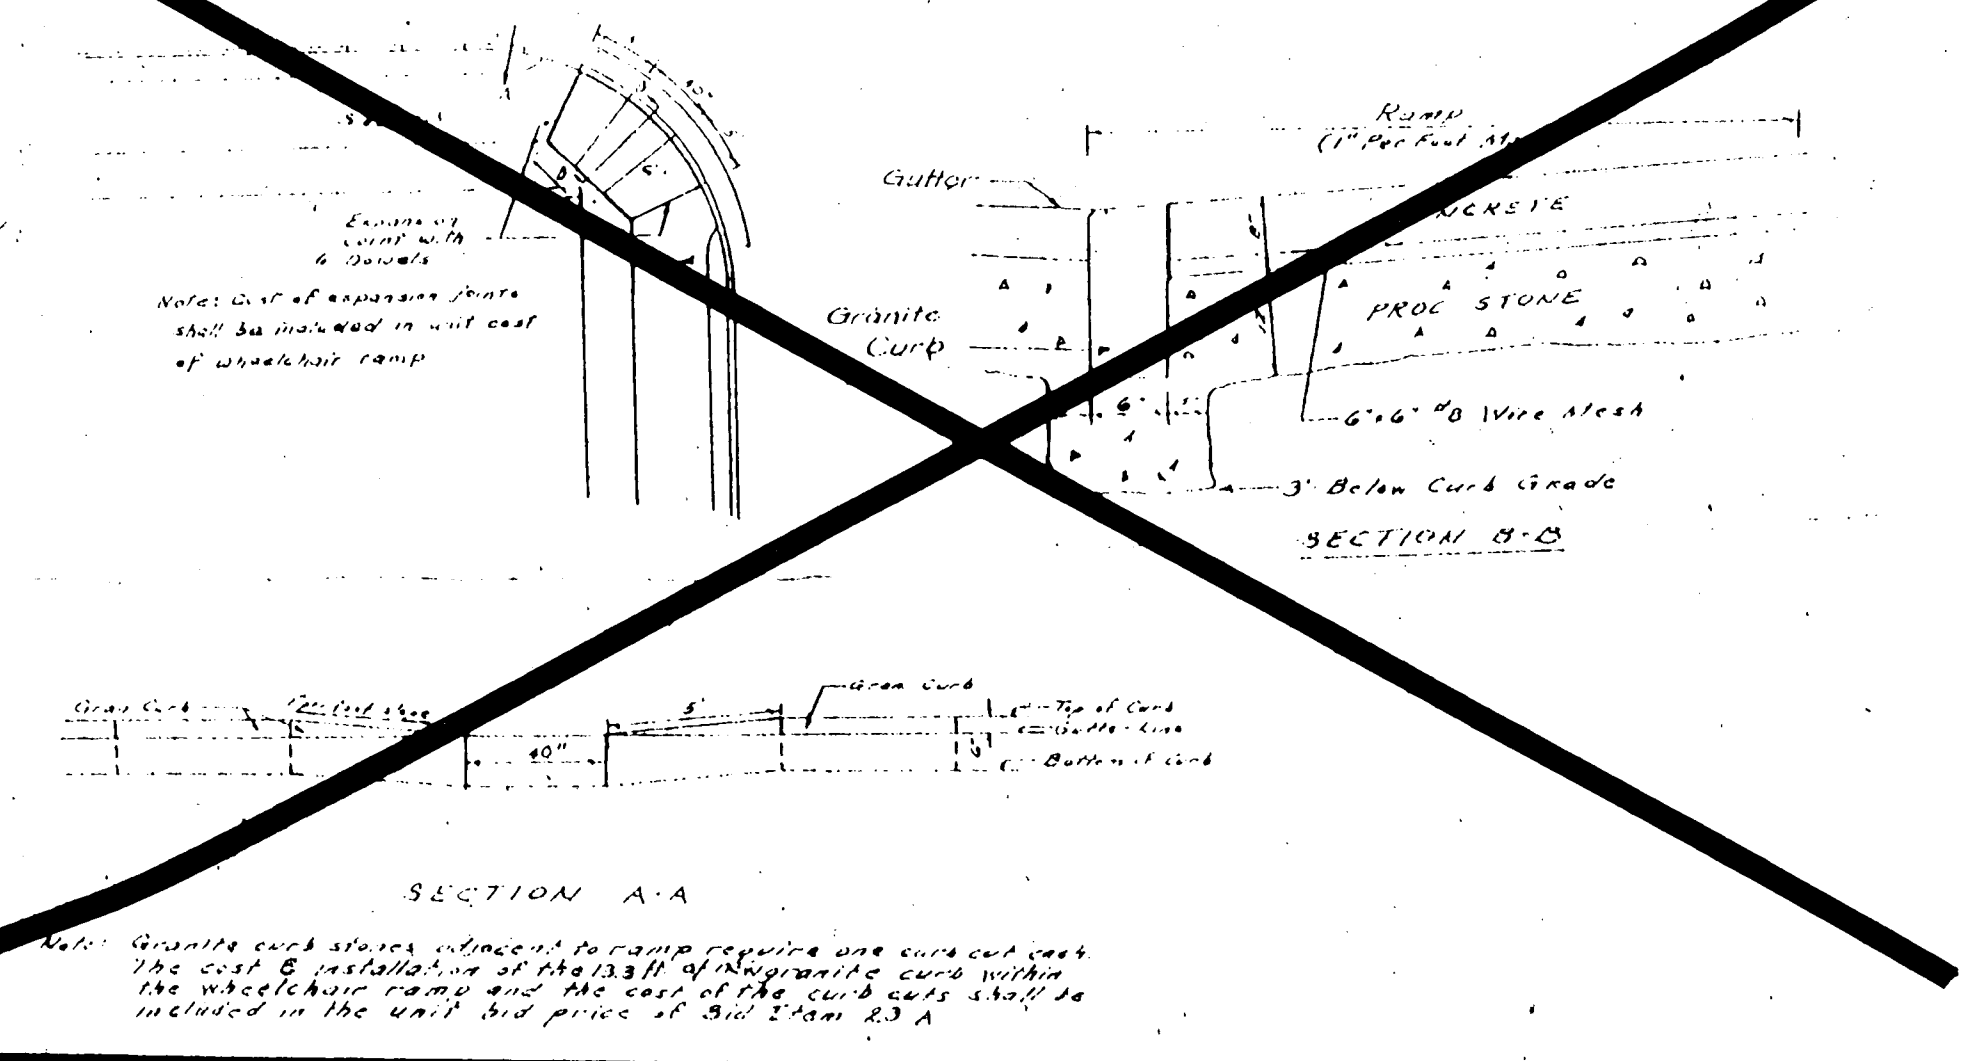

DRIVEWAY SCORING PATTERN

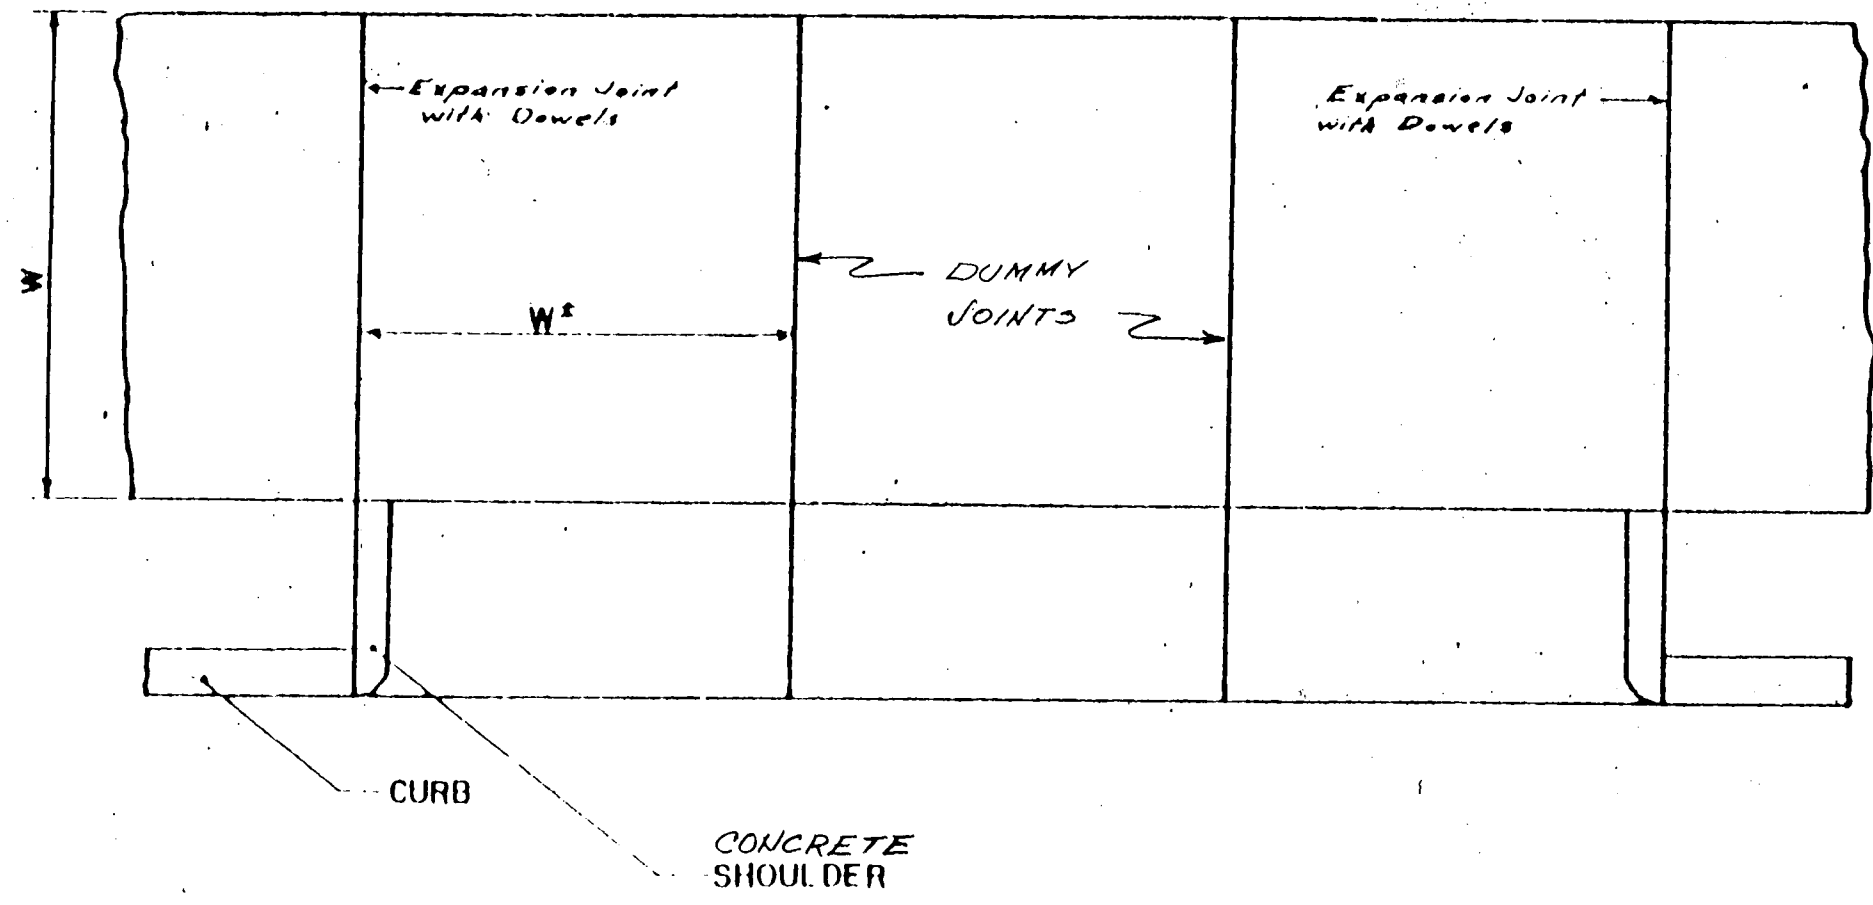


CROSS-SECTION IMPROVED ROADWAY (NOT TO SCALE)


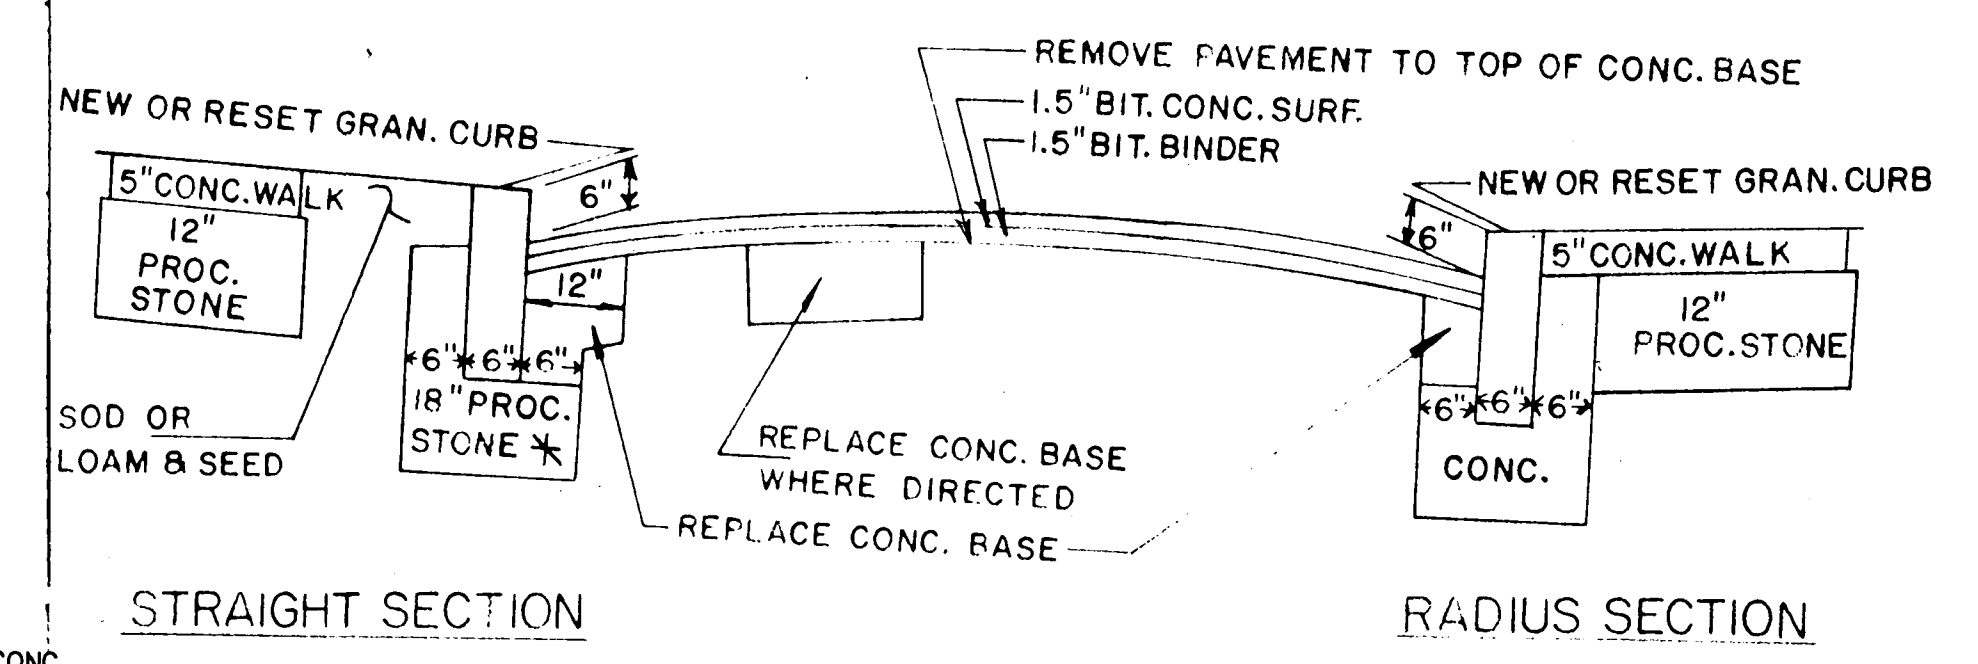


* ELIMINATE PROCESSED STONE BELOW CURB WHERE EXISTING FOUNDATION IS USED.

TYPE I STREET NAME SIGNS - TYPICAL MOUNTING DETAILS

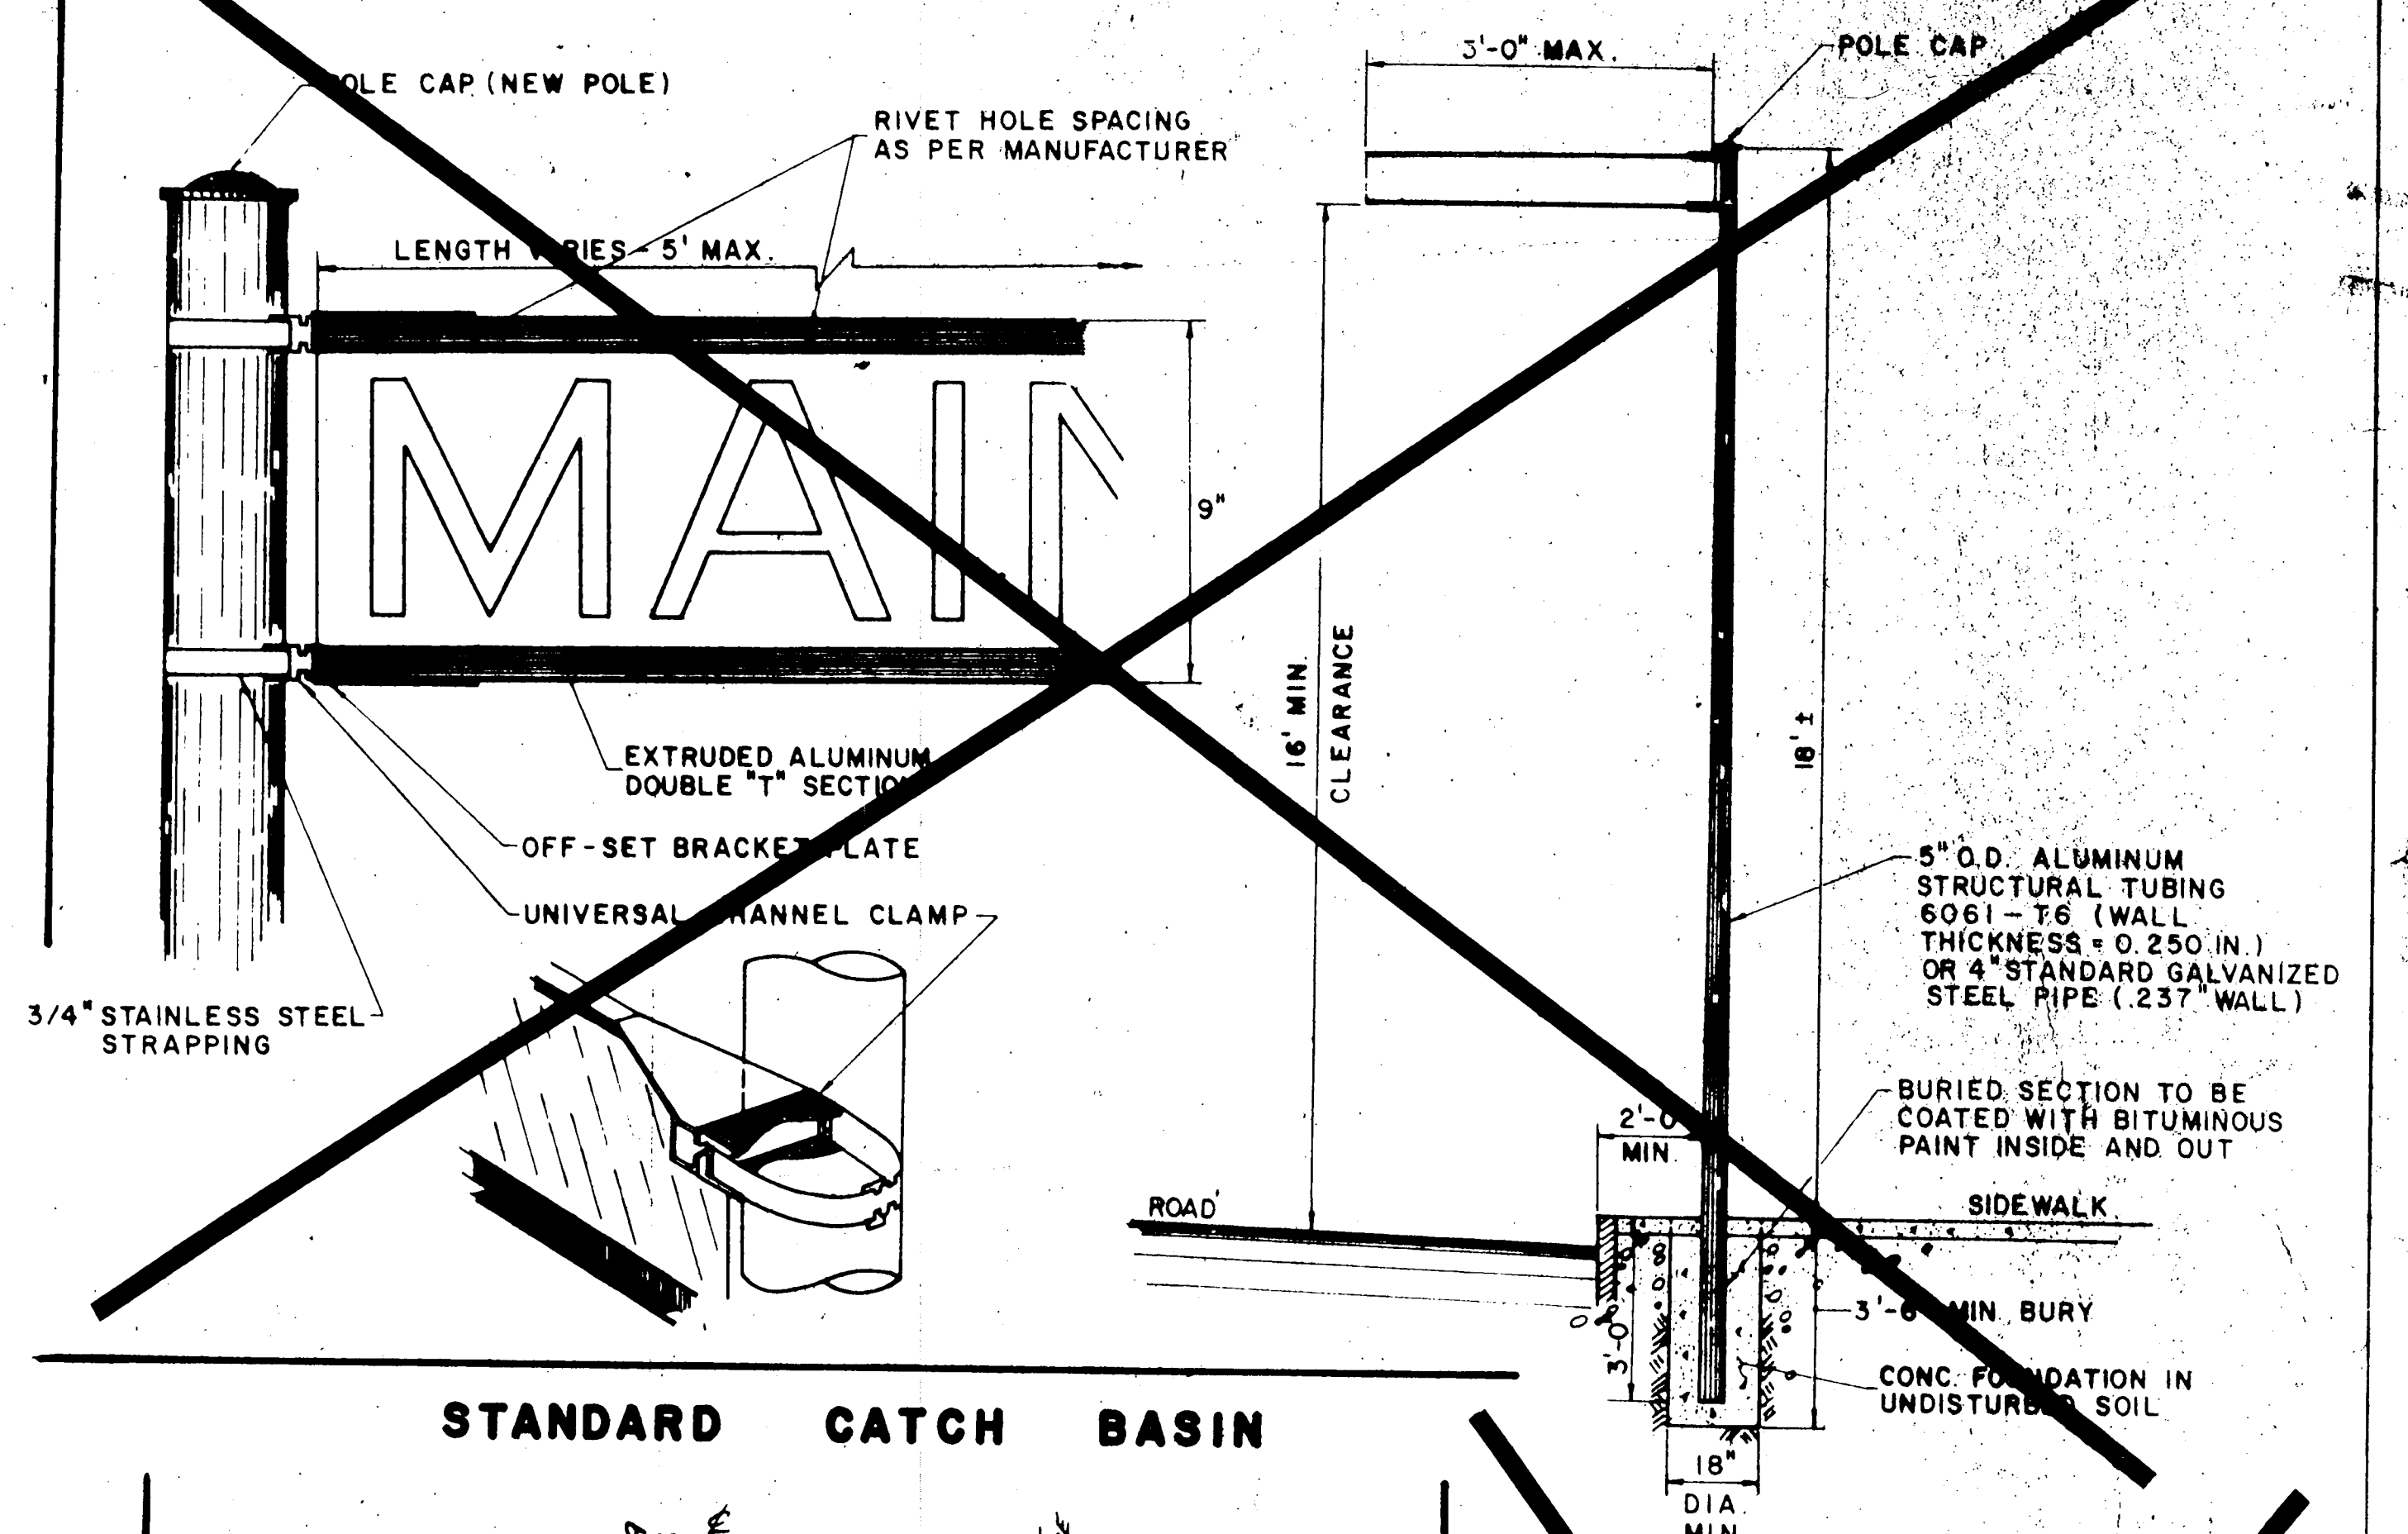

STANDARD CATCH BASIN

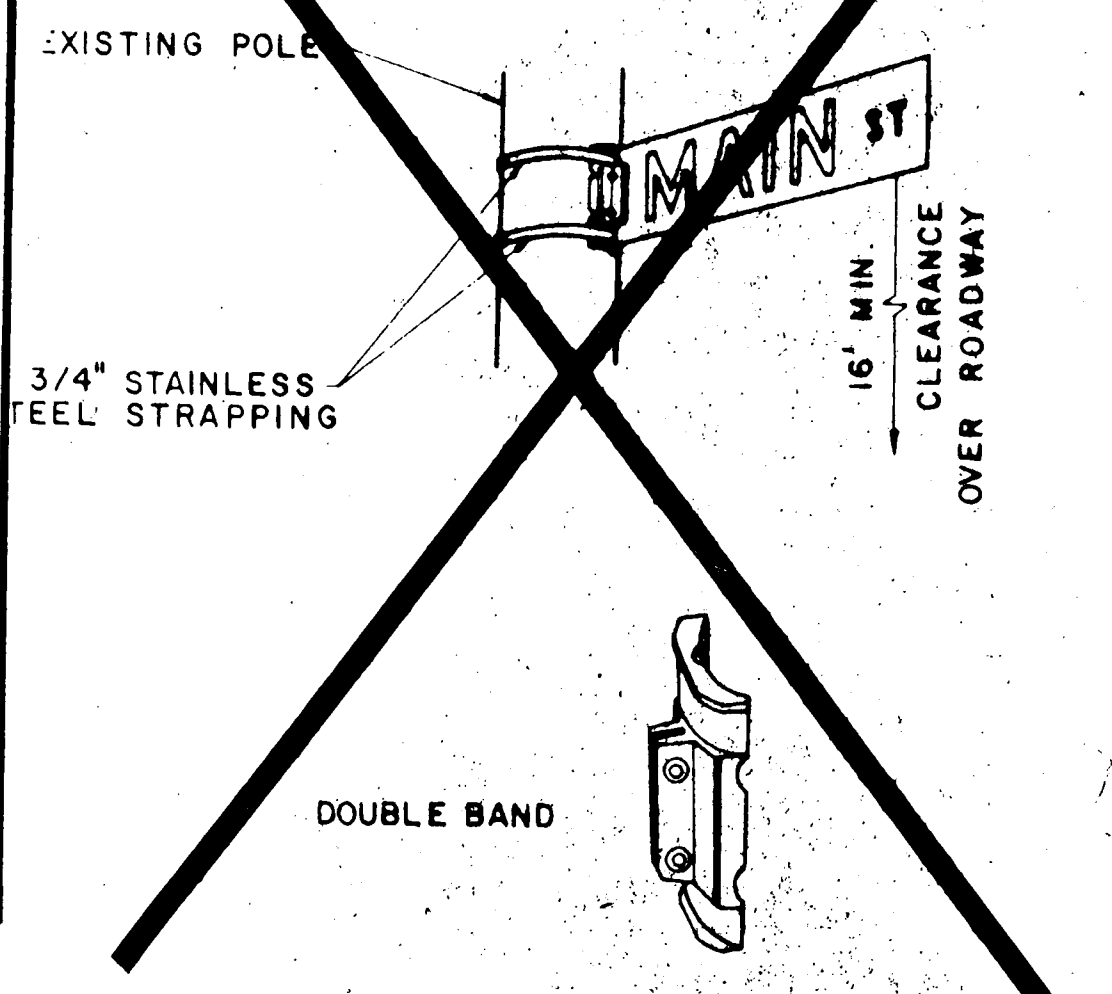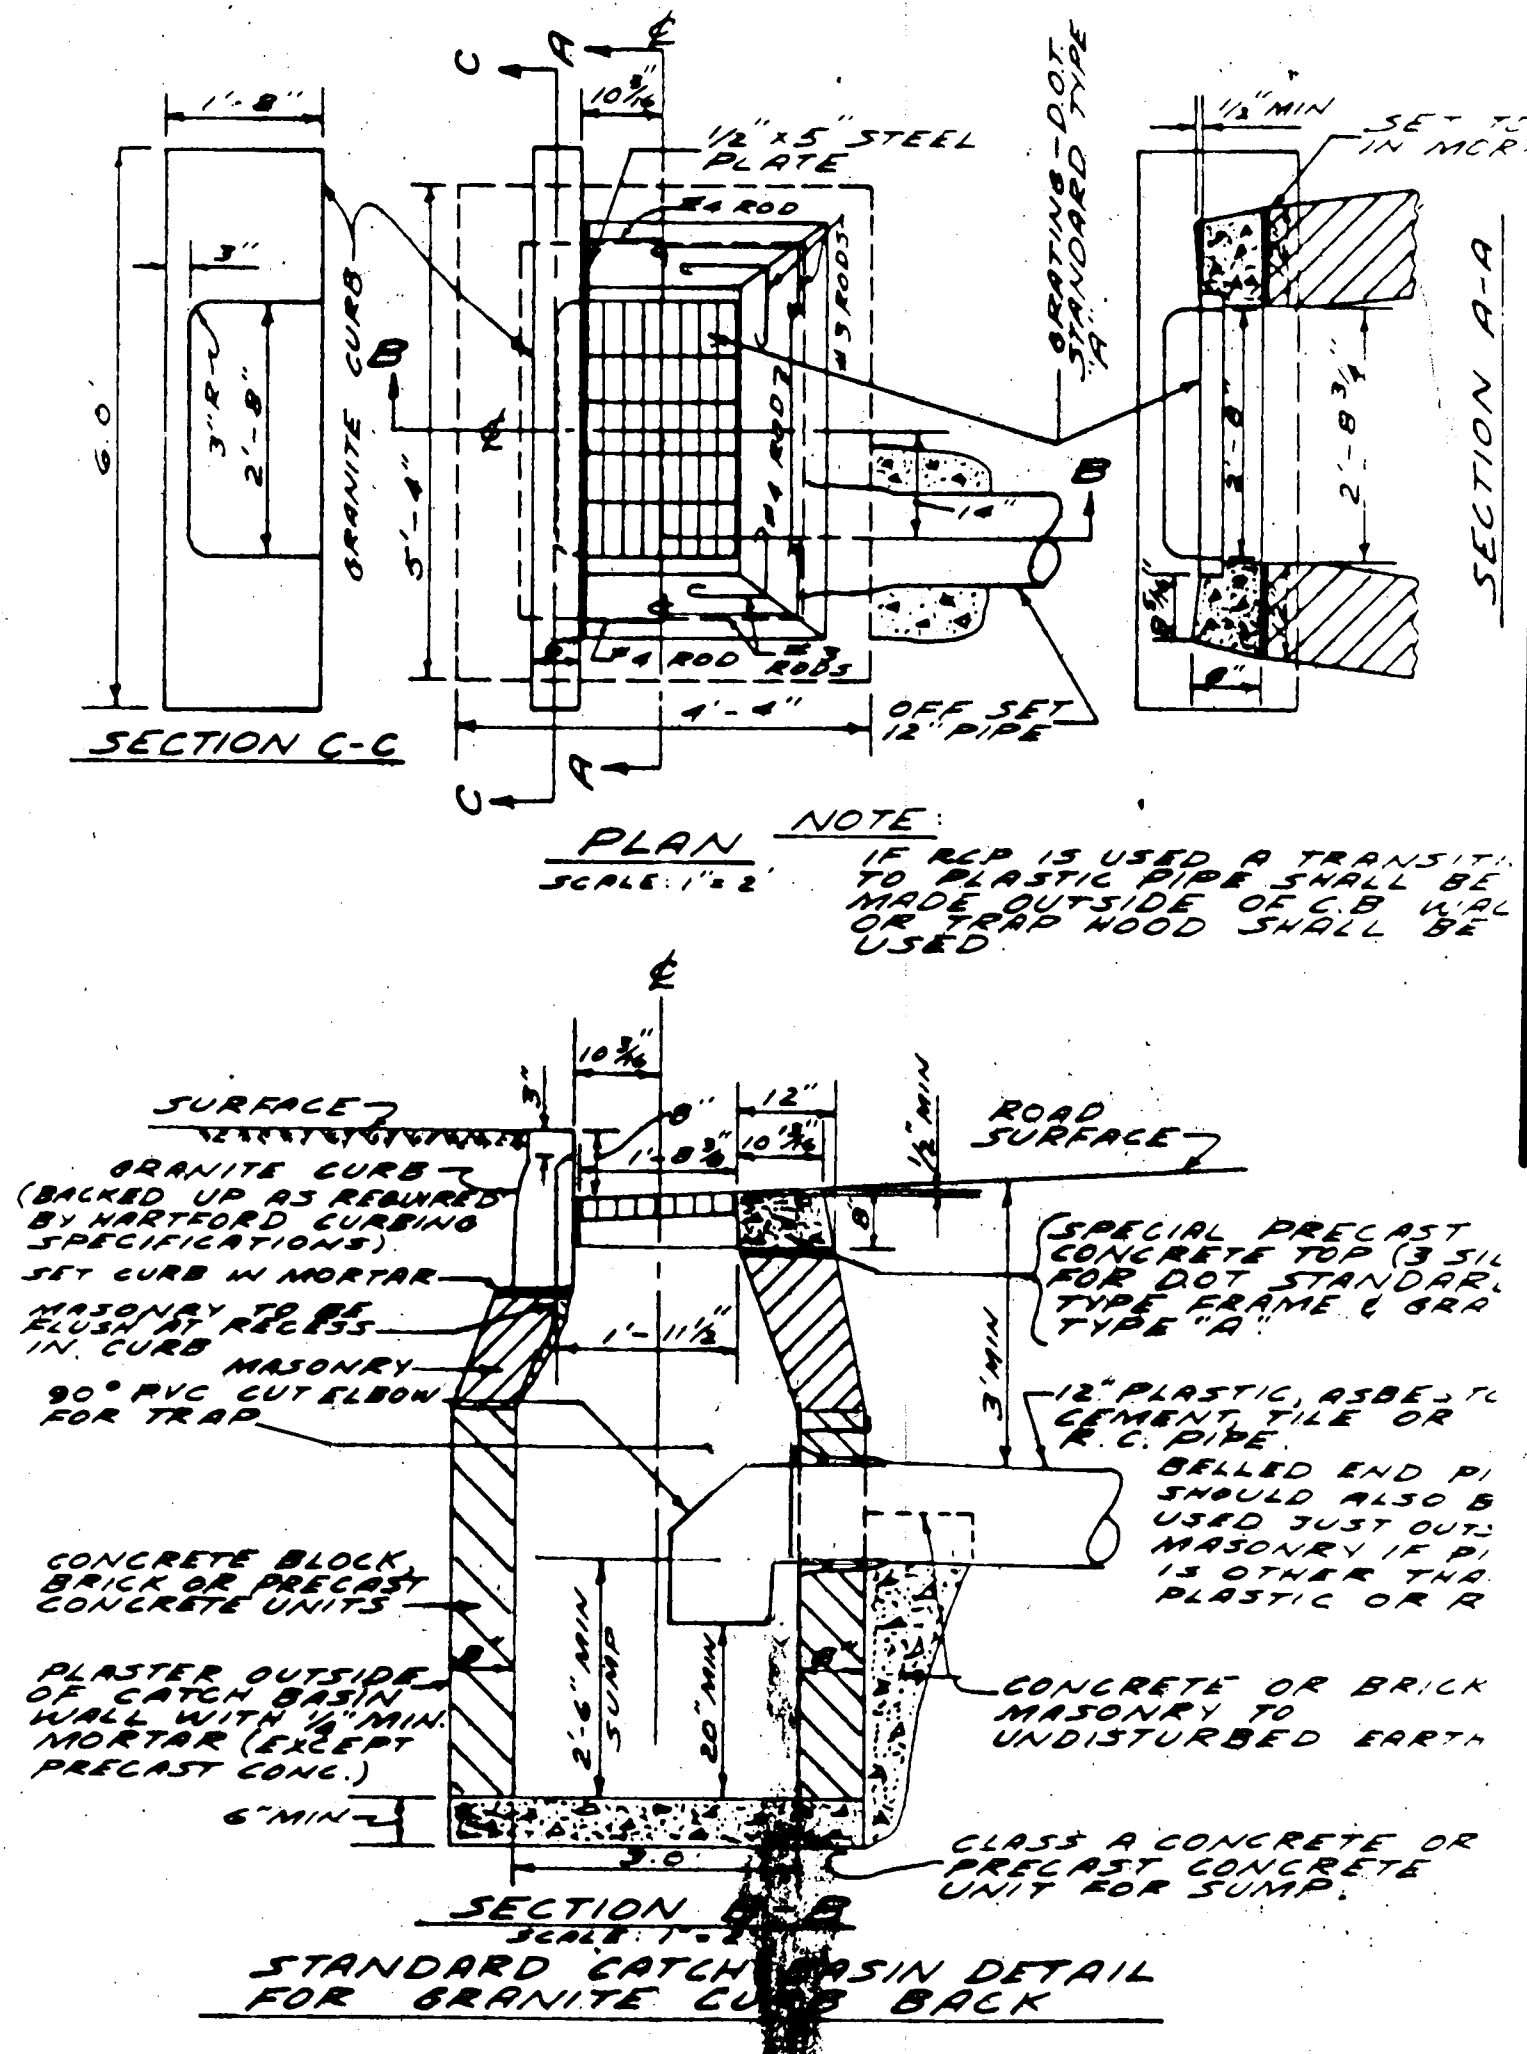

CAST ALUMINUM WING BRACKET

CITY OF HARTFORD, CONNECTICUT DEPARTMENT OF PUBLIC WORKS BUREAU OF ENGINEERING SERVICES			
CONSTRUCTION DETAILS			
SUBMITTED	RECOMMENDED	APPROVED	
ENGINEER	CHIEF OF ENG. SERV.	CITY ENG.	
DRAWN	SCALE	DAYBOOK NO.	
CHECKED	As Shown	DATE 11/17/82	