WAR DEPARTMENT

CORPS OF ENGINEERS, U.S. ARMY.

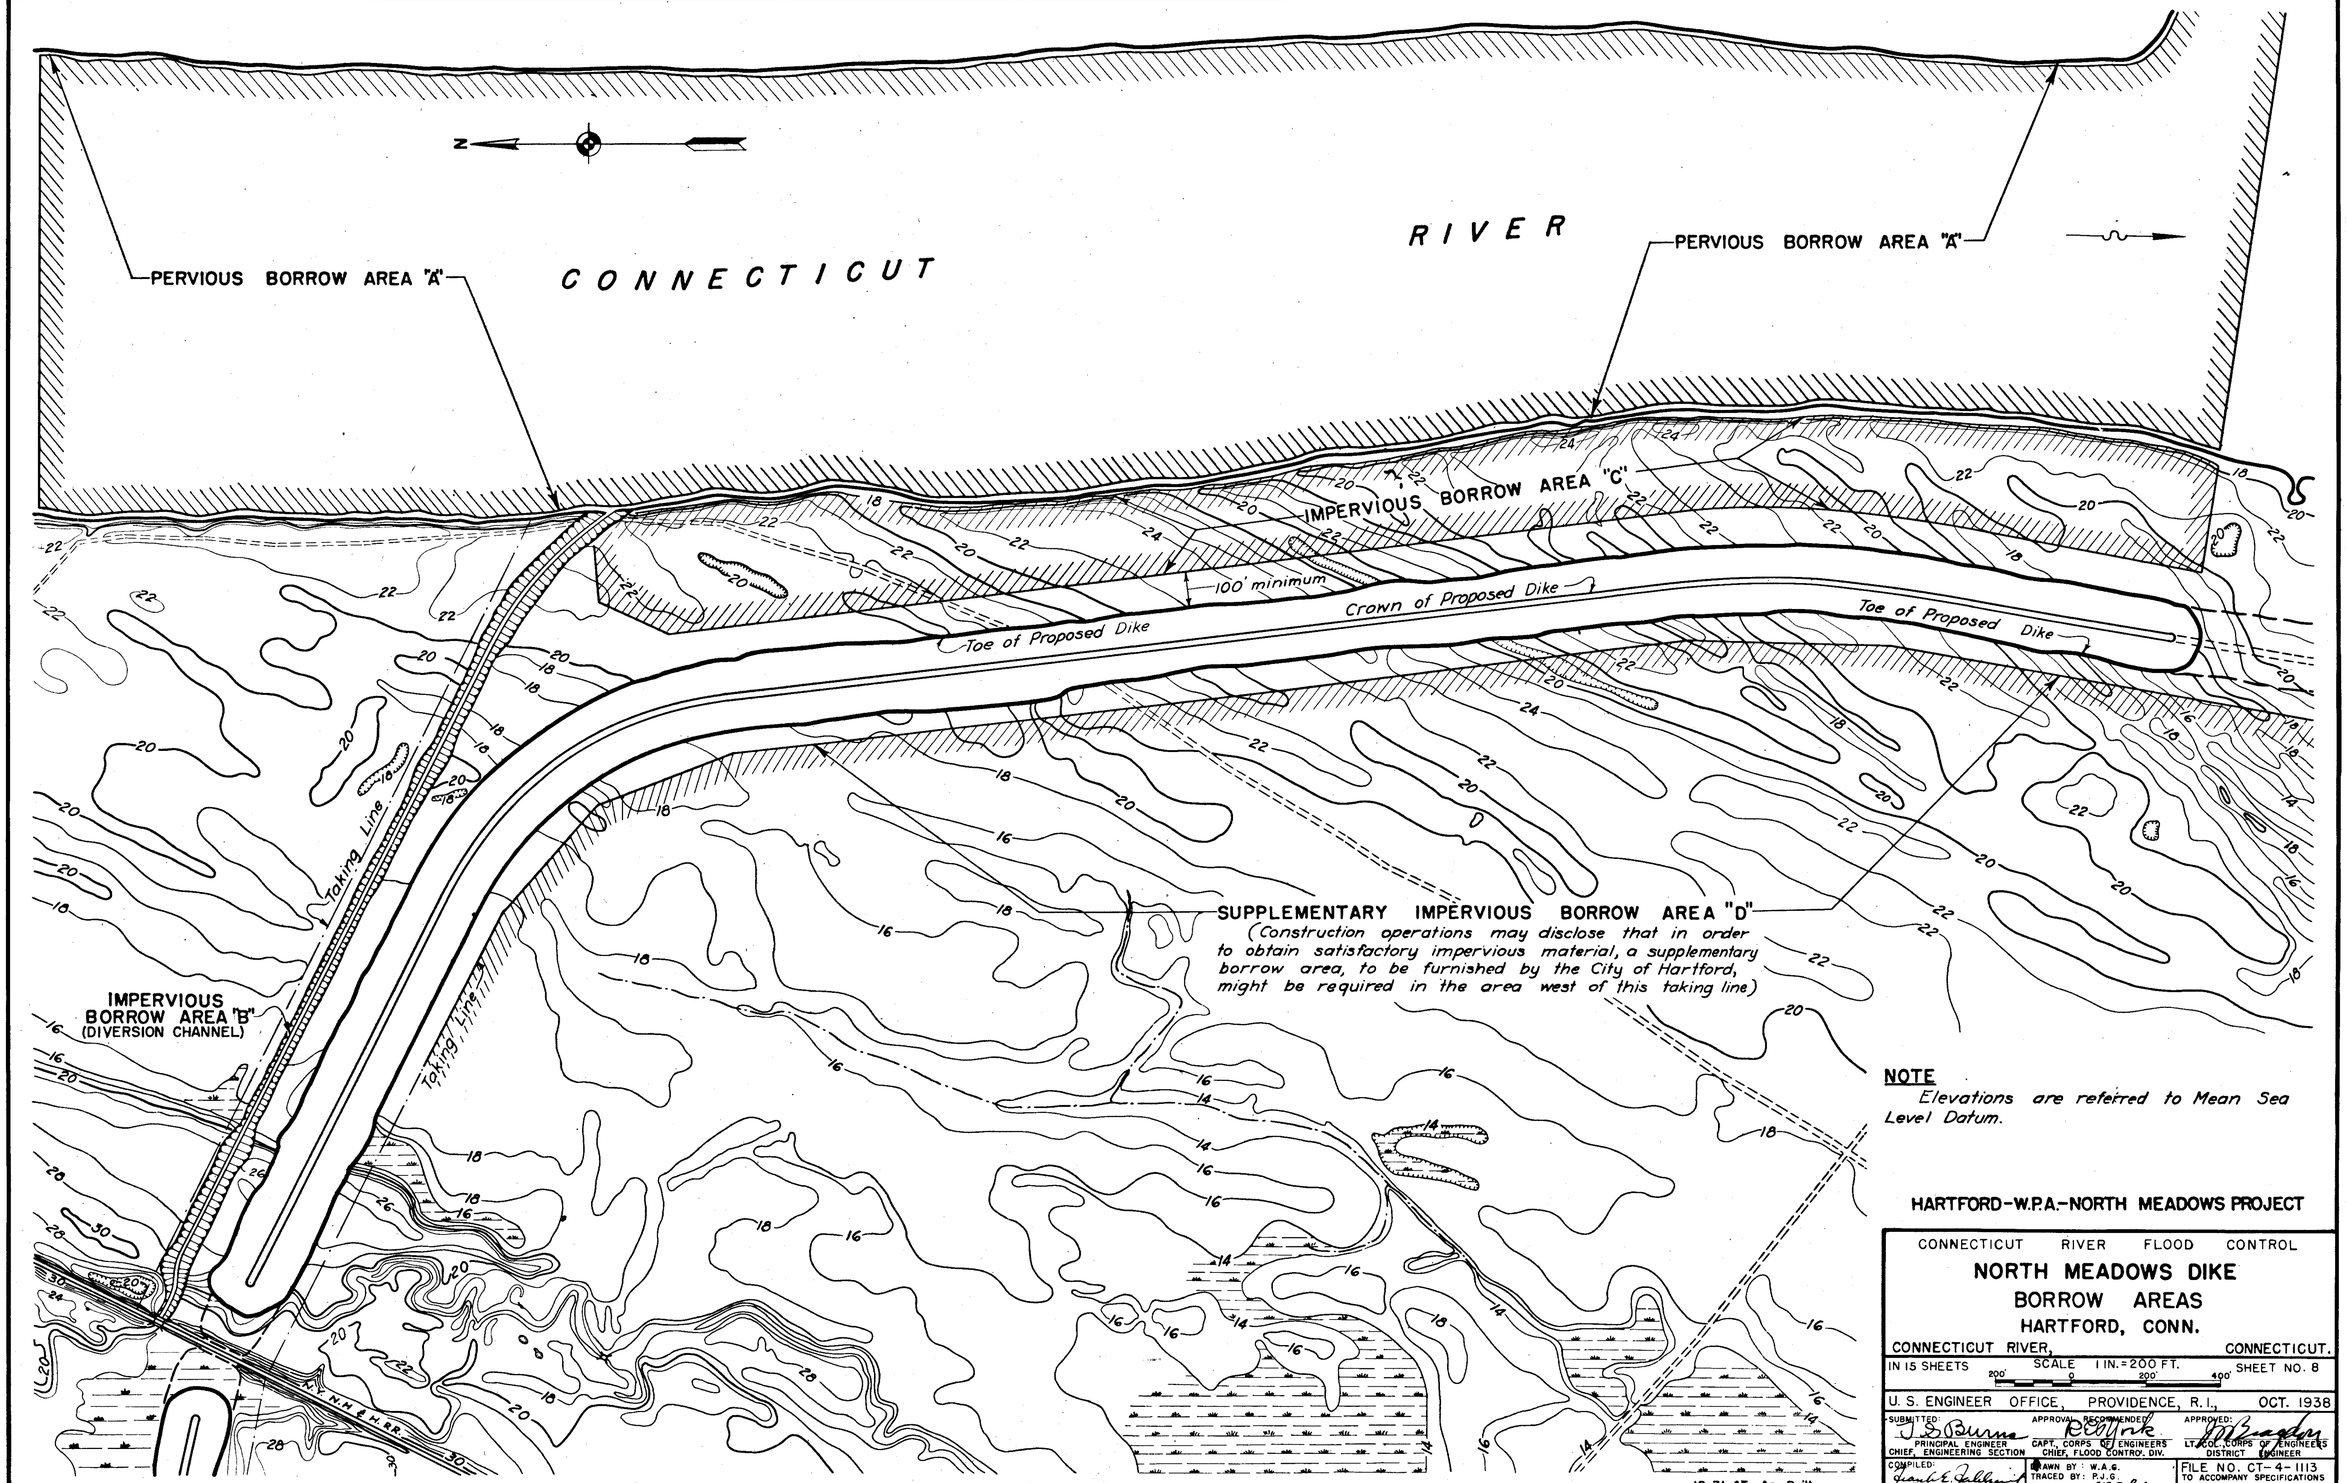

NOTE

Elevations are referred to Mean Sea Level Datum.

12-31-45 As Built

HARTFORD-W.P.A.-NORTH MEADOWS PROJECT

CONNECTICUT RIVER FLOOD CONTROL

NORTH MEADOWS DIKE
BORROW AREAS
HARTFORD, CONN.

CONNECTICUT RIVER, CONNECTICUT.

IN 15 SHEETS — SCALE 1 IN. = 200 FT. (200' 0 200' 400') — SHEET NO. 8

U. S. ENGINEER OFFICE, PROVIDENCE, R. I., OCT. 1938

SUBMITTED:	APPROVAL RECOMMENDED:	APPROVED:
J. S. Burns, PRINCIPAL ENGINEER, CHIEF, ENGINEERING SECTION	R. C. Tyrrell, CAPT., CORPS OF ENGINEERS, CHIEF, FLOOD CONTRO. DIV.	J. J. Bradley, LT. COL., CORPS OF ENGINEERS, DISTRICT ENGINEER

COMPILED: GEOLOGIST

DRAWN BY: W.A.G.
TRACED BY: P.J.G.
CHECKED BY: W.A.S.jr.

FILE NO. CT-4-1113
TO ACCOMPANY SPECIFICATIONS
DATED OCT. 1, 1938

Ht. 1