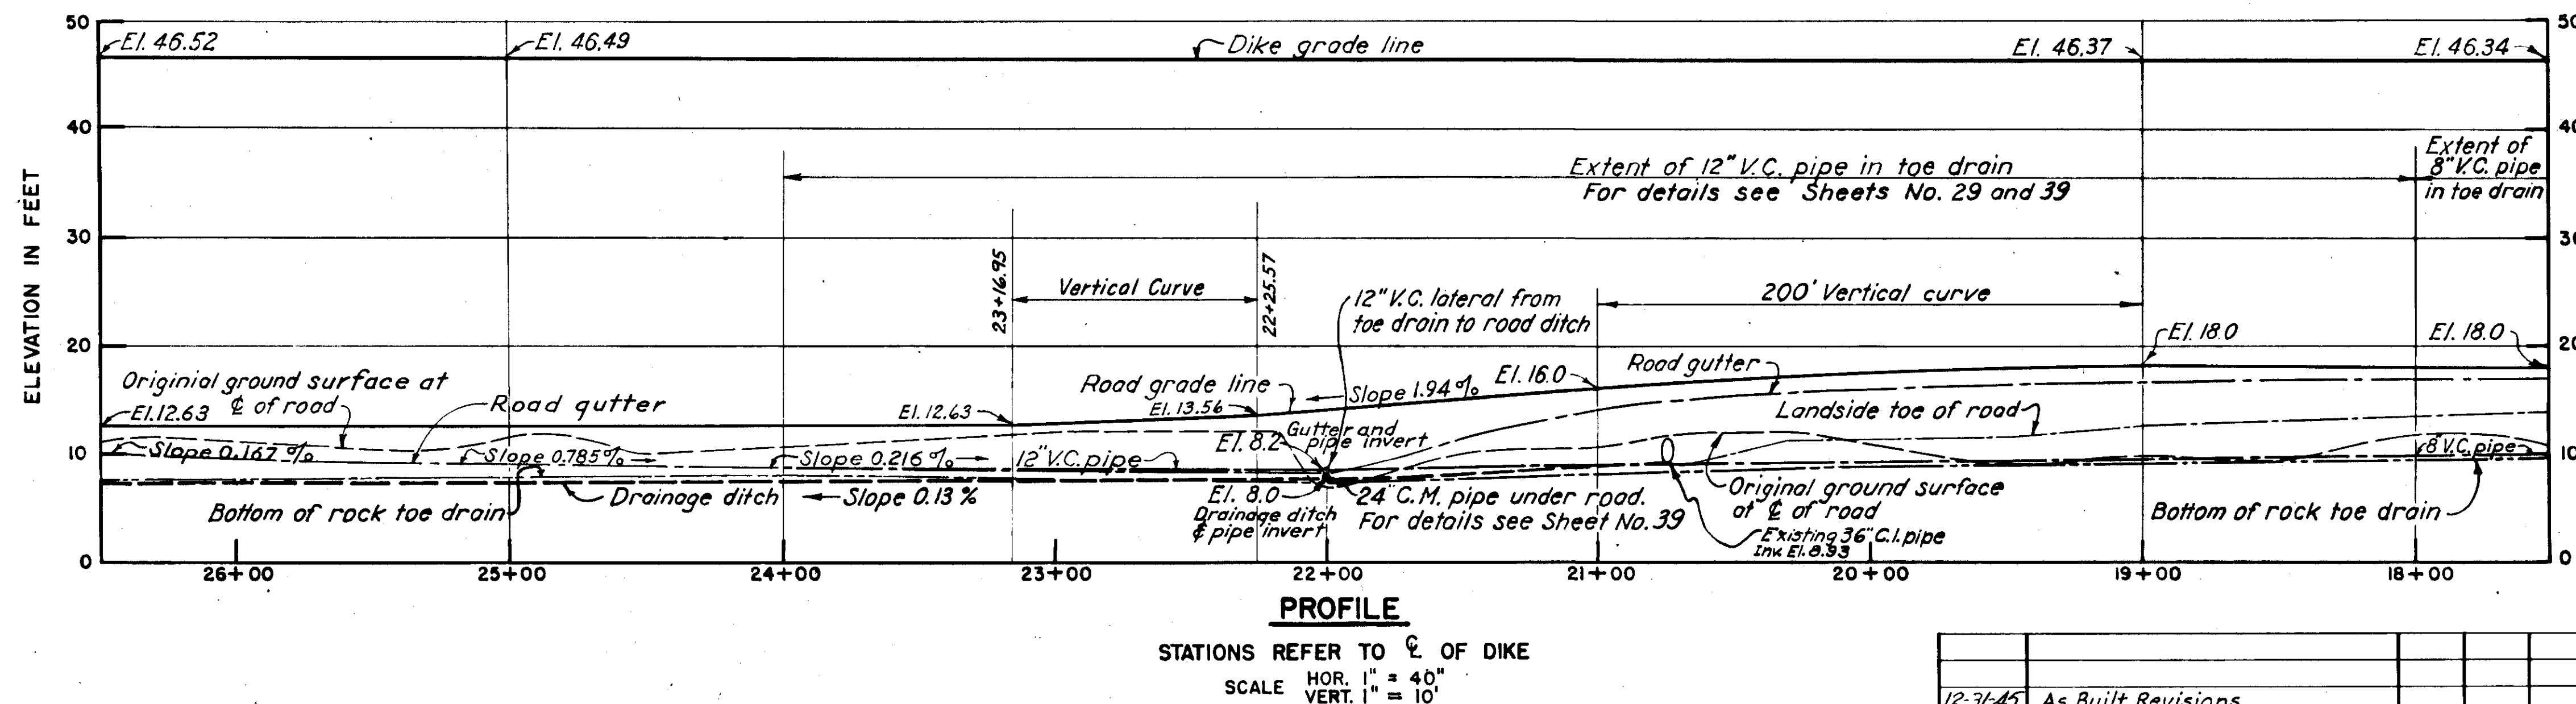
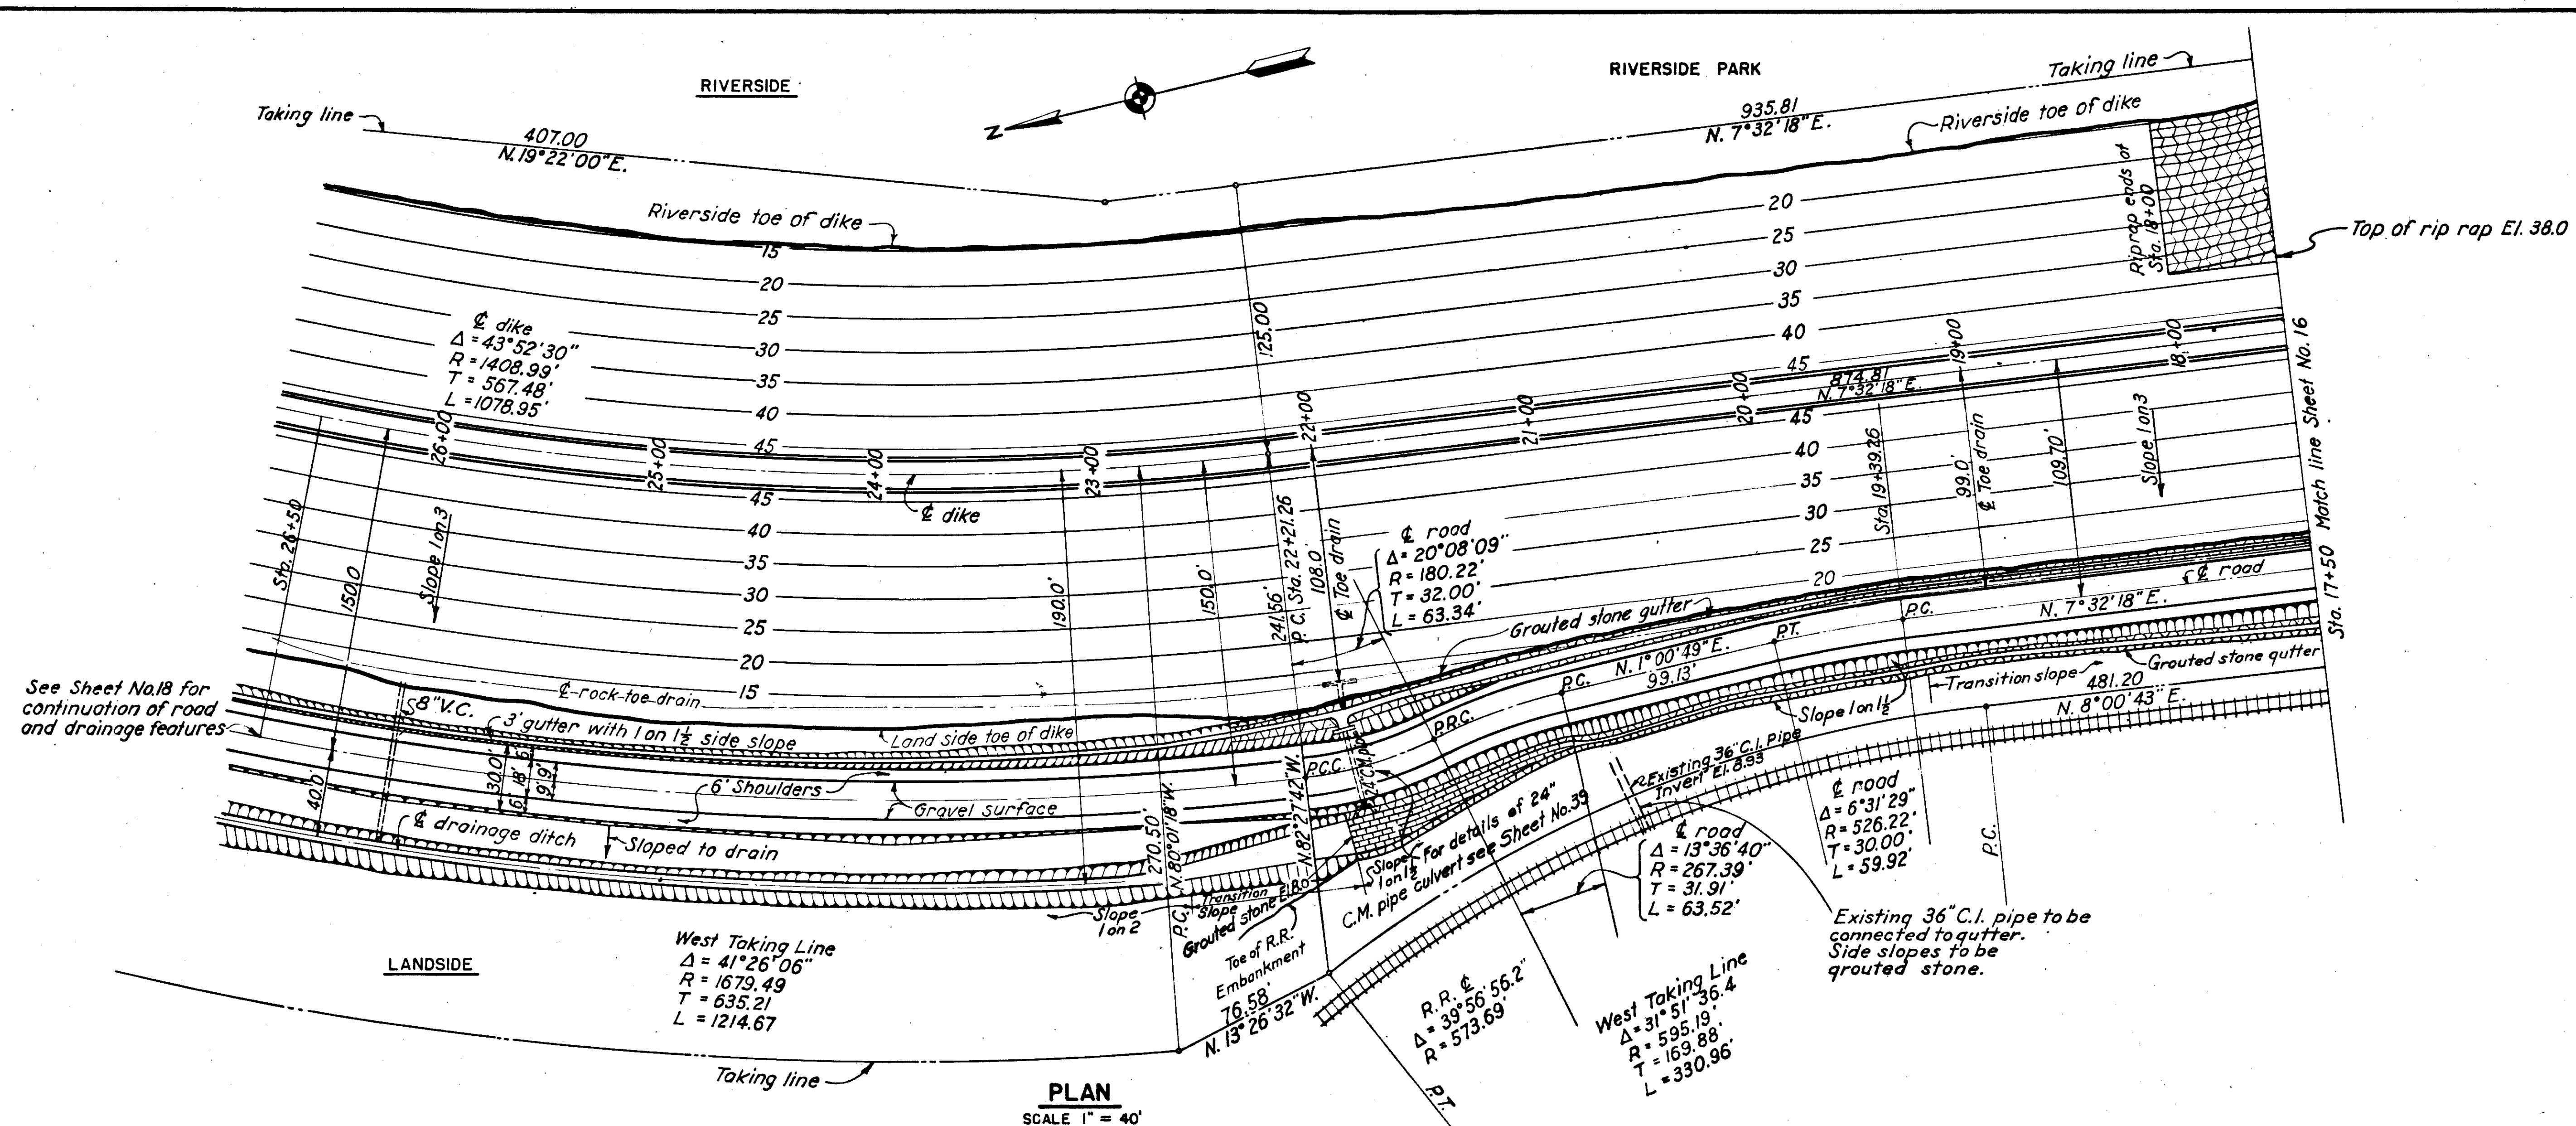


**NOTES**

For general notes applying to details shown on this sheet, see Sheet No. 15

CONNECTICUT RIVER FLOOD CONTROL

NORTH MEADOWS DIKE

FISCAL YEAR 1939 SECTION

DETAIL PLAN NO. 3

STA. 17+50 TO STA. 26+50

HARTFORD, CONN.

CONNECTICUT RIVER CONNECTICUT

IN 66 SHEETS SCALE 1 IN. = 40 FT. SHEET NO. 17

U. S. ENGINEER OFFICE, PROVIDENCE, R. I., APRIL 1939

SUBMITTED: APPROVAL RECOMMENDED: APPROVED:

DESIGNED: DRAWN: D. C. W. FILE NO. GT-4-1446

CHECKED: W. G. E.