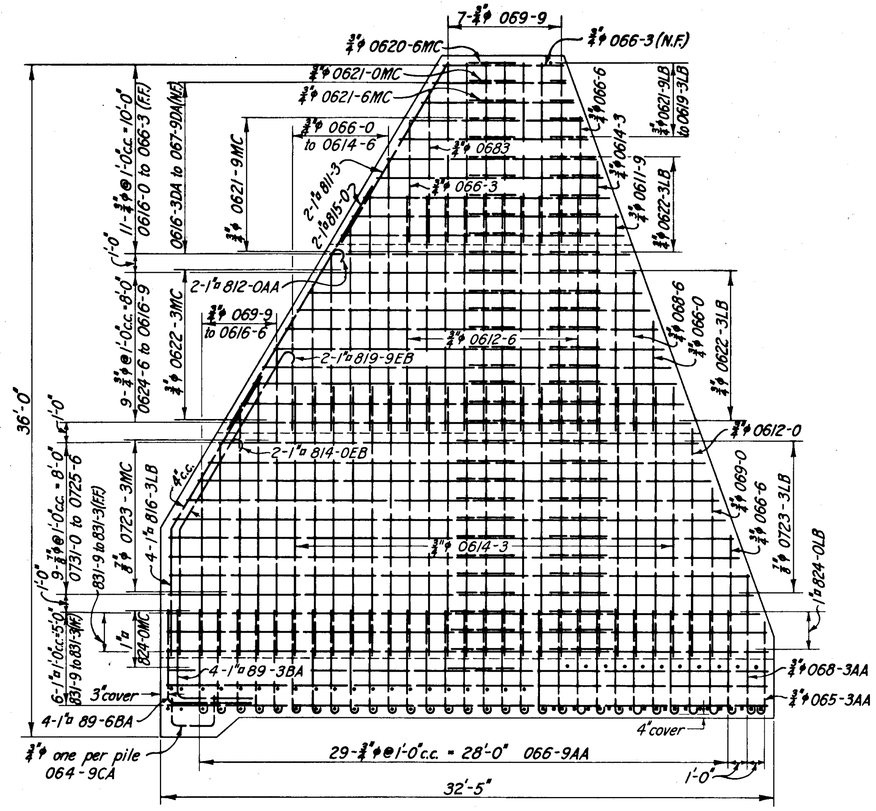

SECTION D/47

For details of steel reinforcement in base slab see Sheets No. 49 and 50.

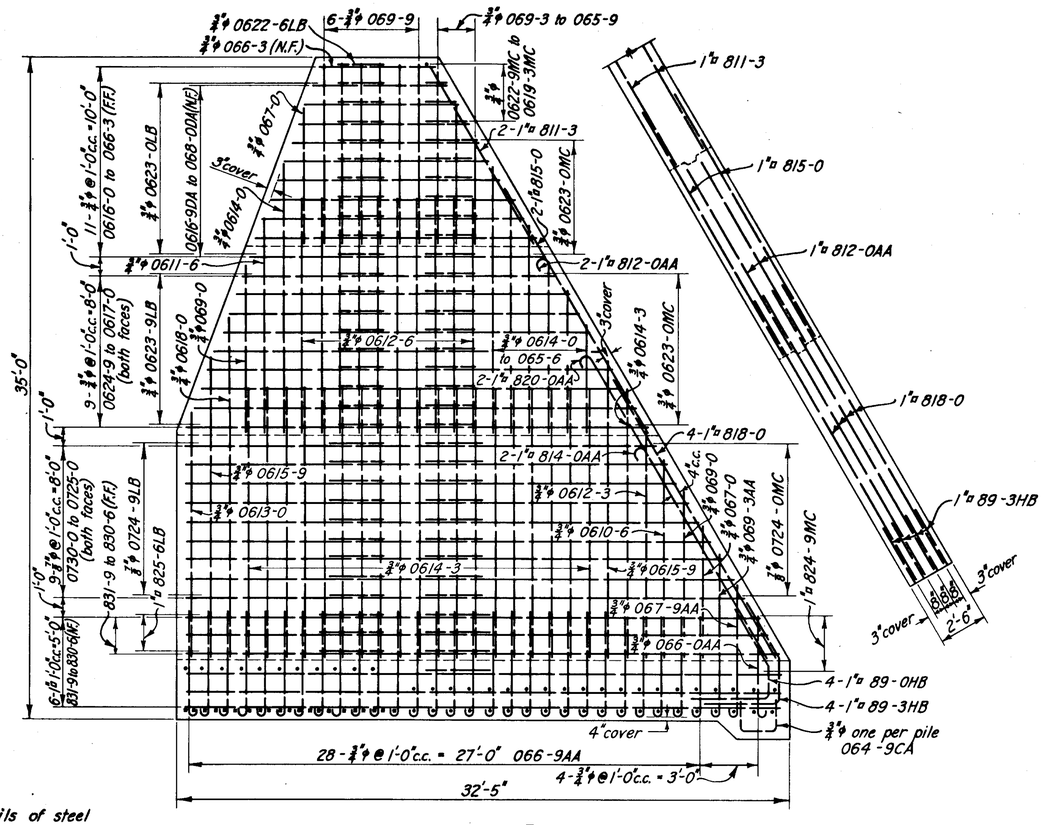

SECTION E/47

NOTES

For general notes applying to this sheet see Sheet No. 49.

All steel shown on this sheet is the same in both faces except as noted.

DATE	REVISION	REV.BY	CK.BY	AP.BY
12/31/45	As-Built			

THIS SHEET SUPERSEDES SHEET NO. 52, FILE NO. CT-4-1481

CONNECTICUT RIVER FLOOD CONTROL

NORTH MEADOWS DIKE

FISCAL YEAR 1939 SECTION

R.R. STOP-LOG STRUCTURE NO. 1

STEEL REINFORCEMENT NO. 4

HARTFORD, CONN.

CONNECTICUT RIVER — CONNECTICUT

IN 66 SHEETS — SCALE: 1/4 IN. = 1 FT. (5' 0 5' 10') — SHEET NO. 52

U. S. ENGINEER OFFICE, PROVIDENCE, R. I., MAY 1939

SUBMITTED: SENIOR ENGINEER, HEAD, DESIGN SECTION

APPROVAL RECOMMENDED: PRINCIPAL ENGINEER, CHIEF F. C. ENGINEERING DIV.

APPROVED: LT. COL., CORPS OF ENGINEERS, DISTRICT ENGINEER

DESIGNED: ASSOC. ENGINEER

DRAWN: H.E.W.
TRACED: L.F.D.
CHECKED:

FILE NO. CT-4-1701

PRINTED ON "Dri-Mount" TRACING CLOTH