


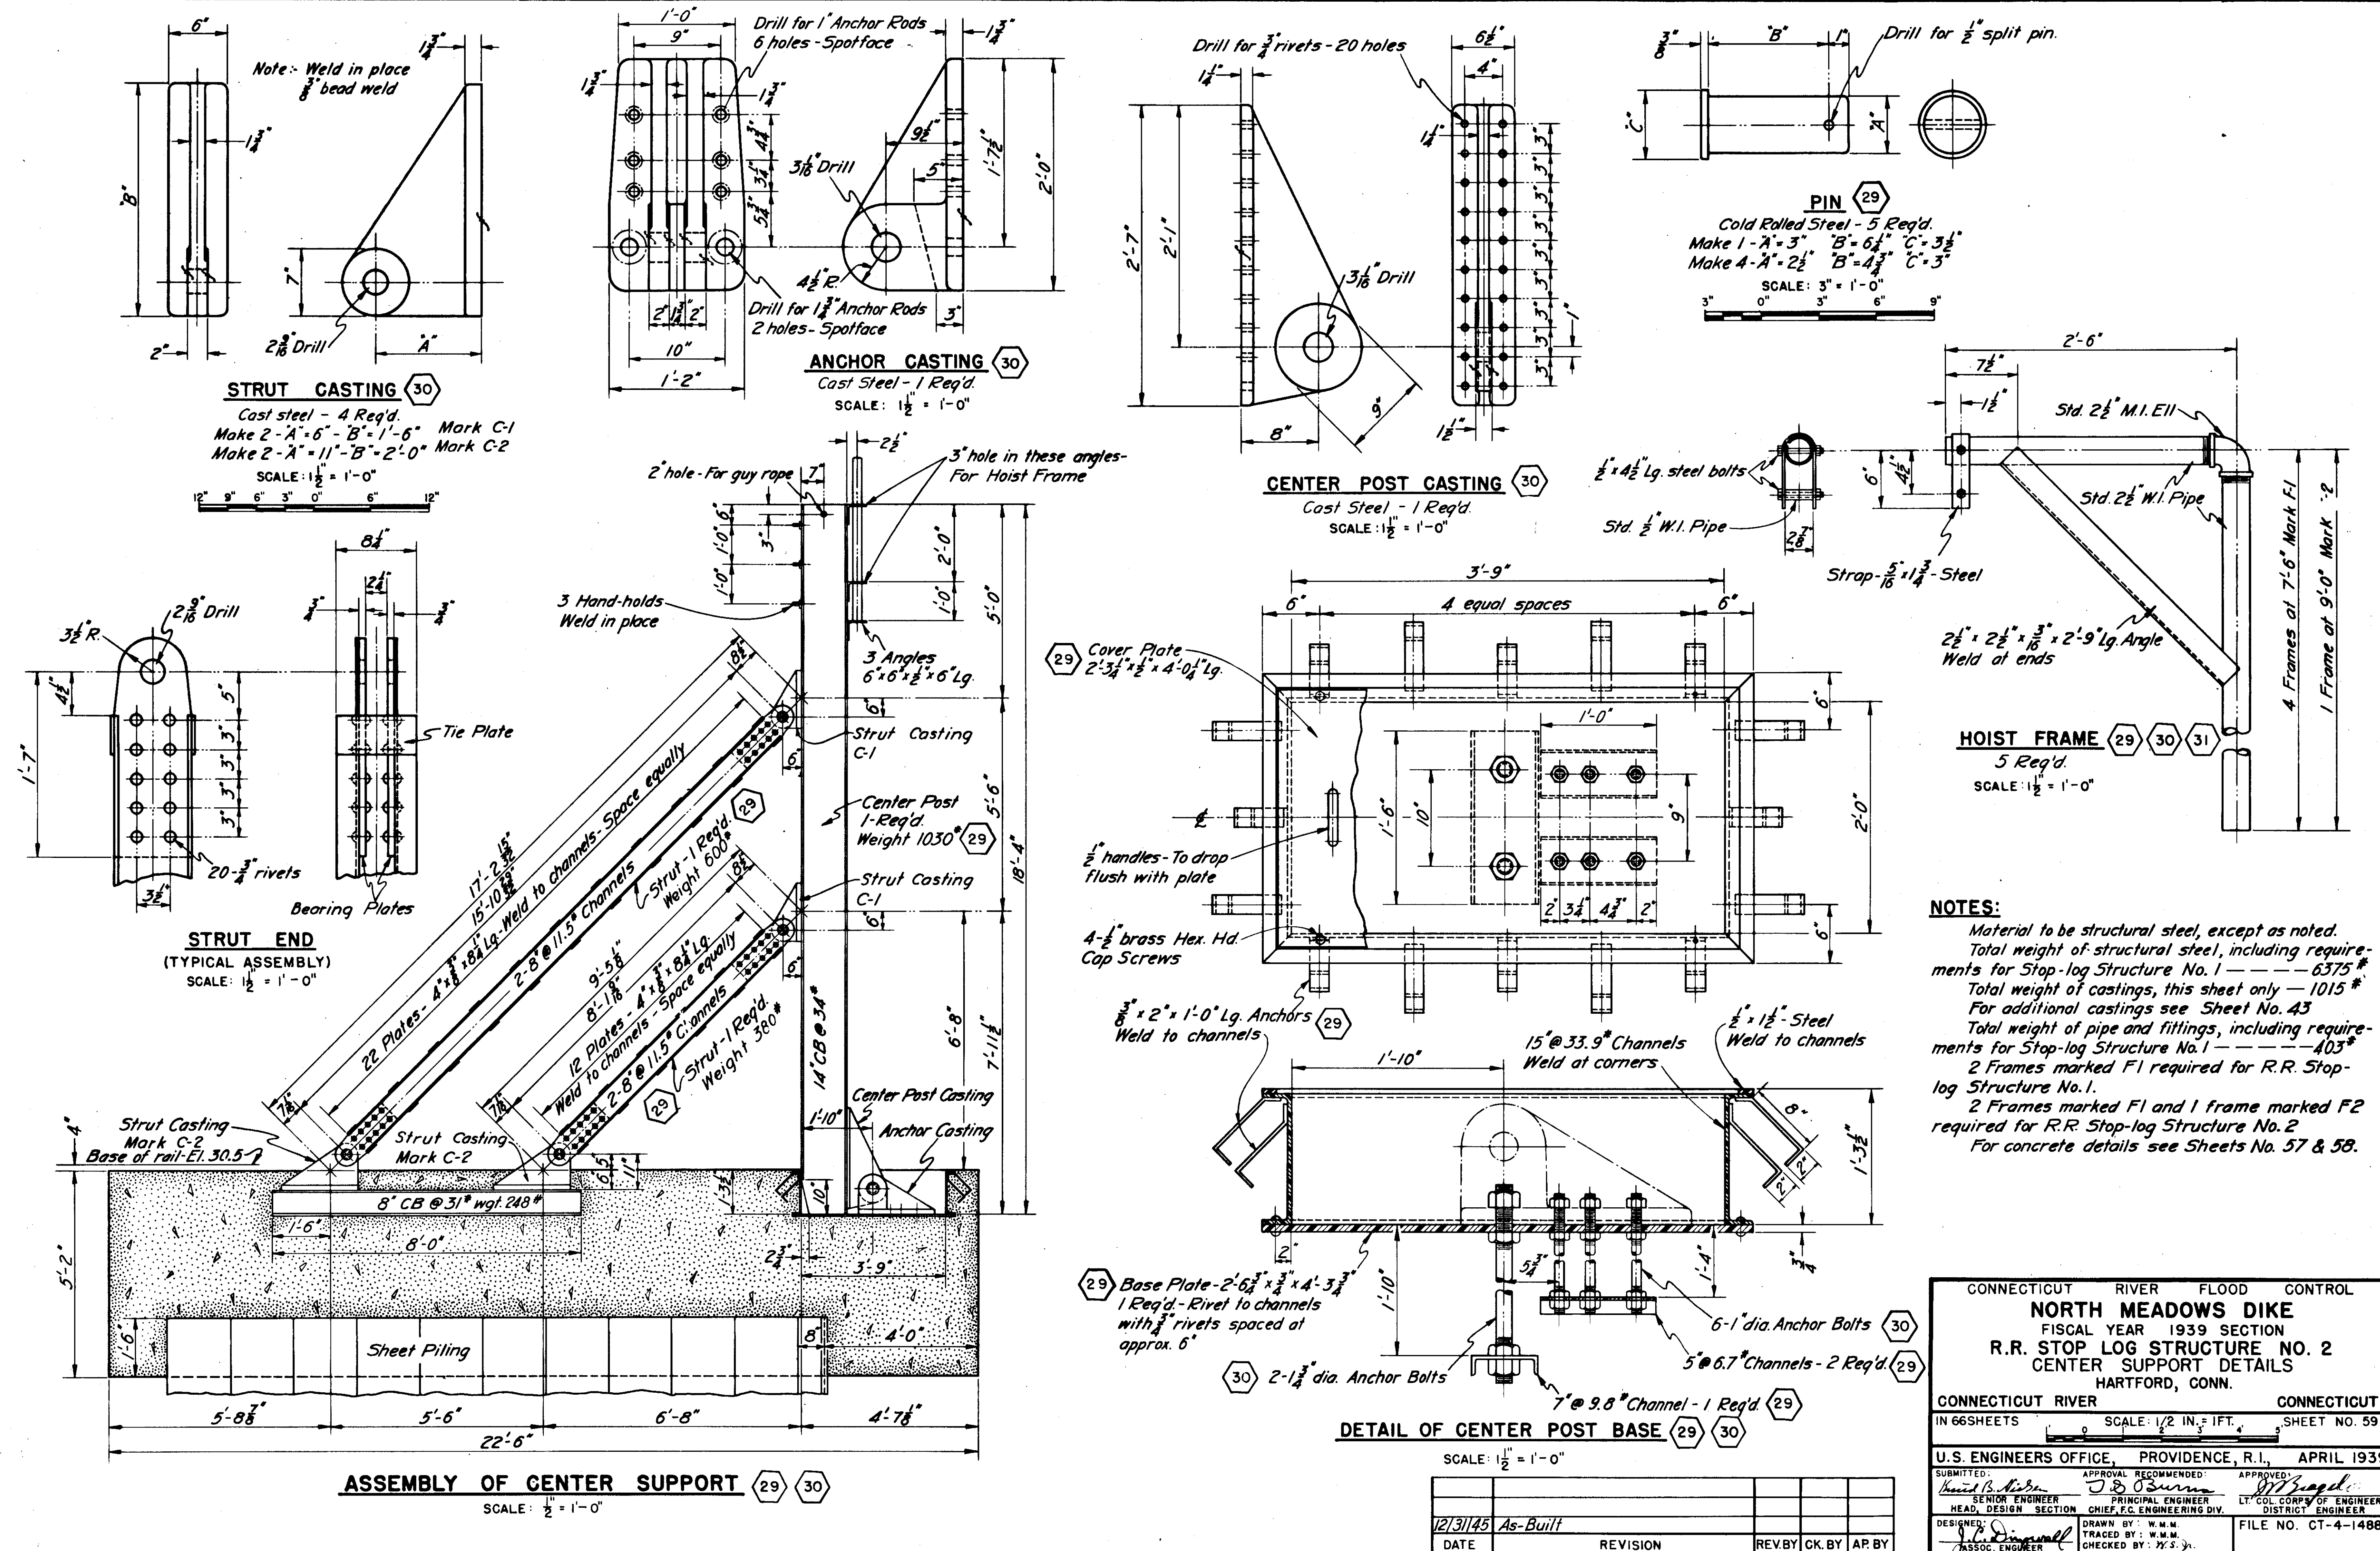

CONNECTICUT RIVER FLOOD CONTROL			
NORTH MEADOWS DIKE			
FISCAL YEAR 1939 SECTION			
R.R. STOP LOG STRUCTURE NO. 2			
CENTER SUPPORT DETAILS			
HARTFORD, CONN.			
CONNECTICUT RIVER		CONNECTICUT	
IN 66 SHEETS		SHEET NO. 59	
SCALE: 1/2" = 1'-0"			
U.S. ENGINEERS OFFICE, PROVIDENCE, R.I., APRIL 1939			
SUBMITTED:	APPROVAL RECOMMENDED:	APPROVED:	
SENIOR ENGINEER	PRINCIPAL ENGINEER	LT. COL. CORPS OF ENGINEERS	
HEAD, DESIGN SECTION	CHIEF, F.C. ENGINEERING DIV.	DISTRICT ENGINEER	
DESIGNED:	DRAWN BY:	FILE NO. CT-4-1488	
J. L. Dingwall	W. M. M.		
ASSOC. ENGINEER	CHECKED BY:		
	W. S. J.		