


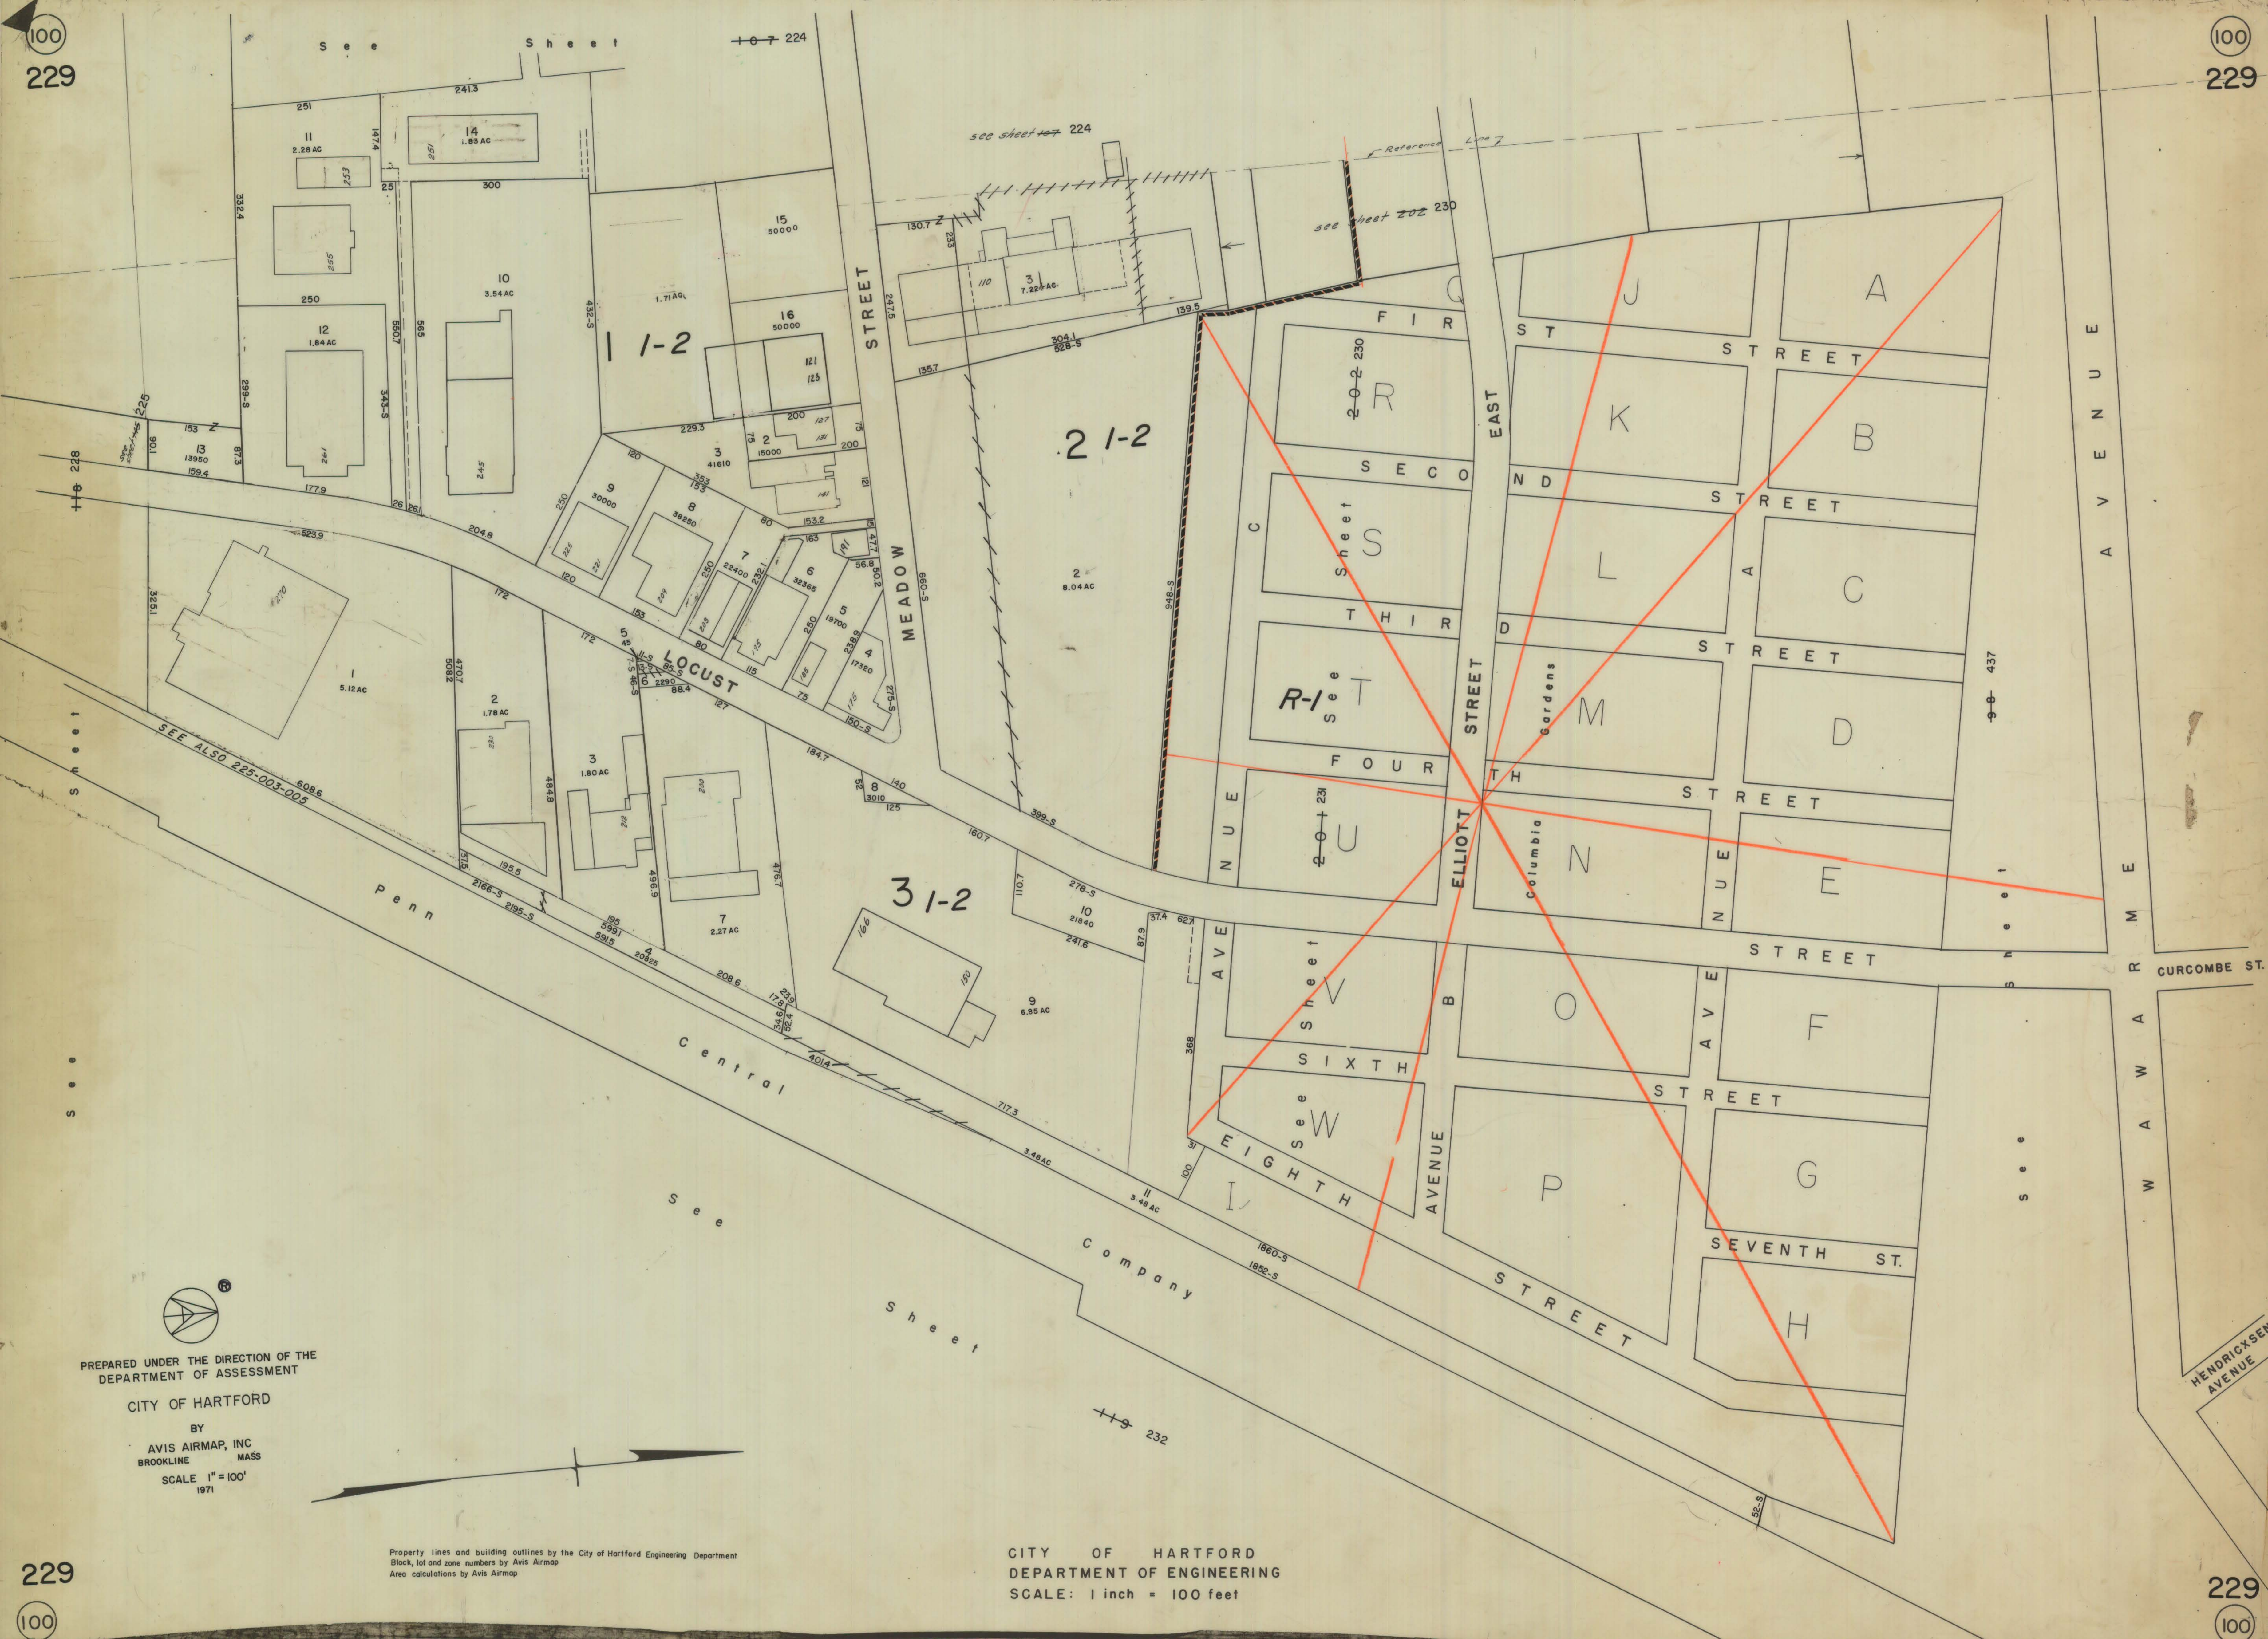

PREPARED UNDER THE DIRECTION OF THE
DEPARTMENT OF ASSESSMENT
CITY OF HARTFORD
BY
AVIS AIRMAP, INC
BROOKLINE MASS
SCALE 1" = 100'
1971

Property lines and building outlines by the City of Hartford Engineering Department
Block, lot and zone numbers by Avis Airmap
Area calculations by Avis Airmap

CITY OF HARTFORD
DEPARTMENT OF ENGINEERING
SCALE: 1 inch = 100 feet