

W E T H E R S F I E L D

Sheet

46 221

See

Sheet

44 222

A V E N U E

Sheet

See

Sheet

44 222

Sheet

See





Sheet

225-424

See

Sheet

44 222

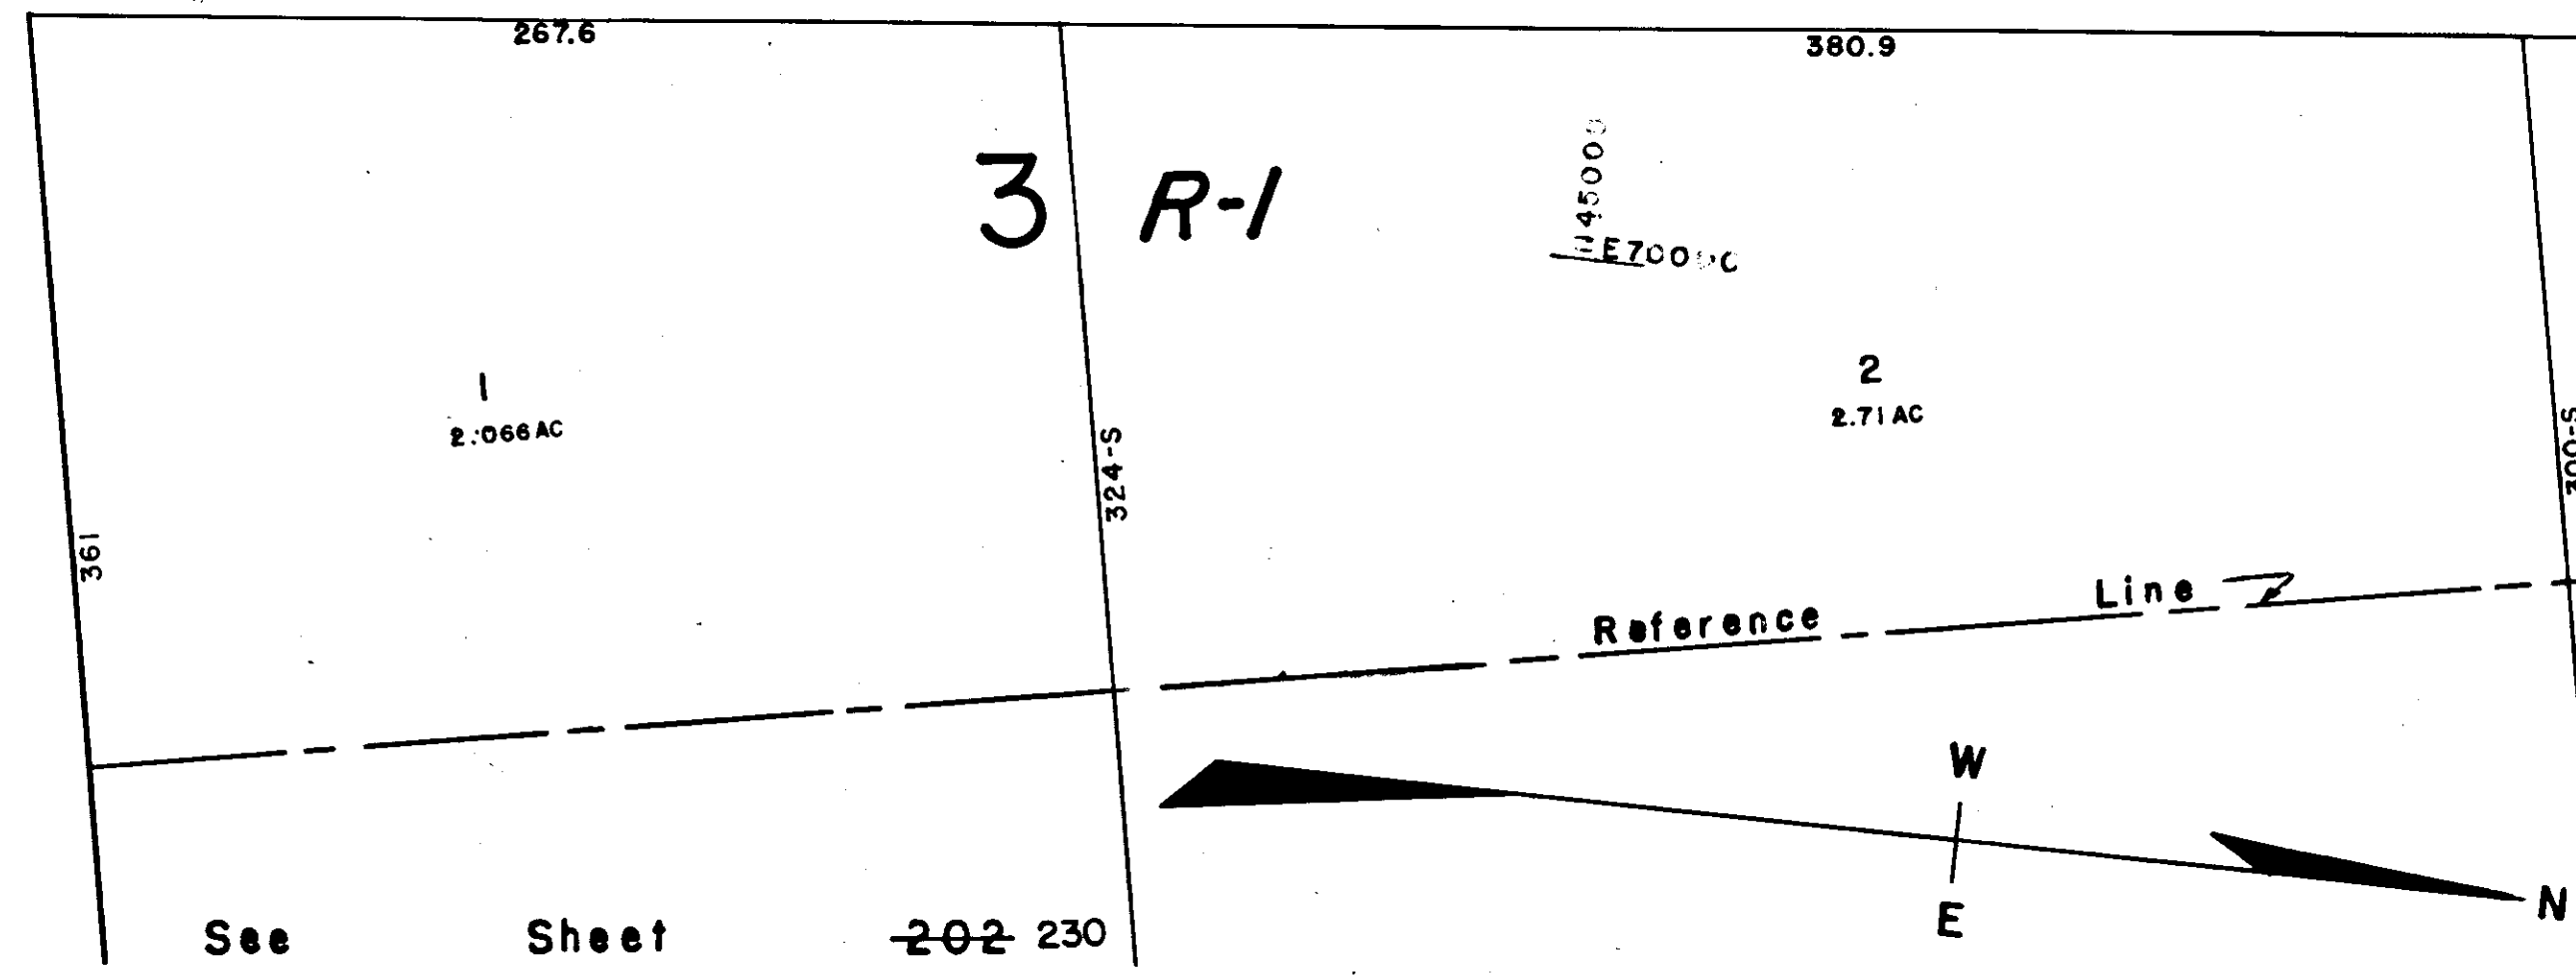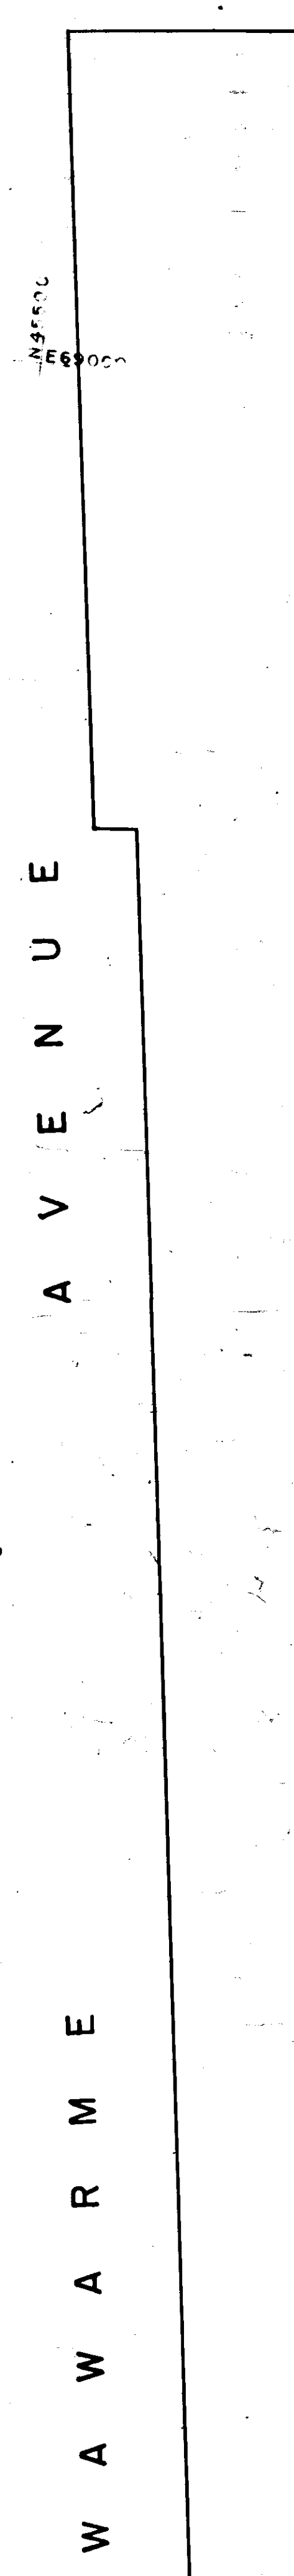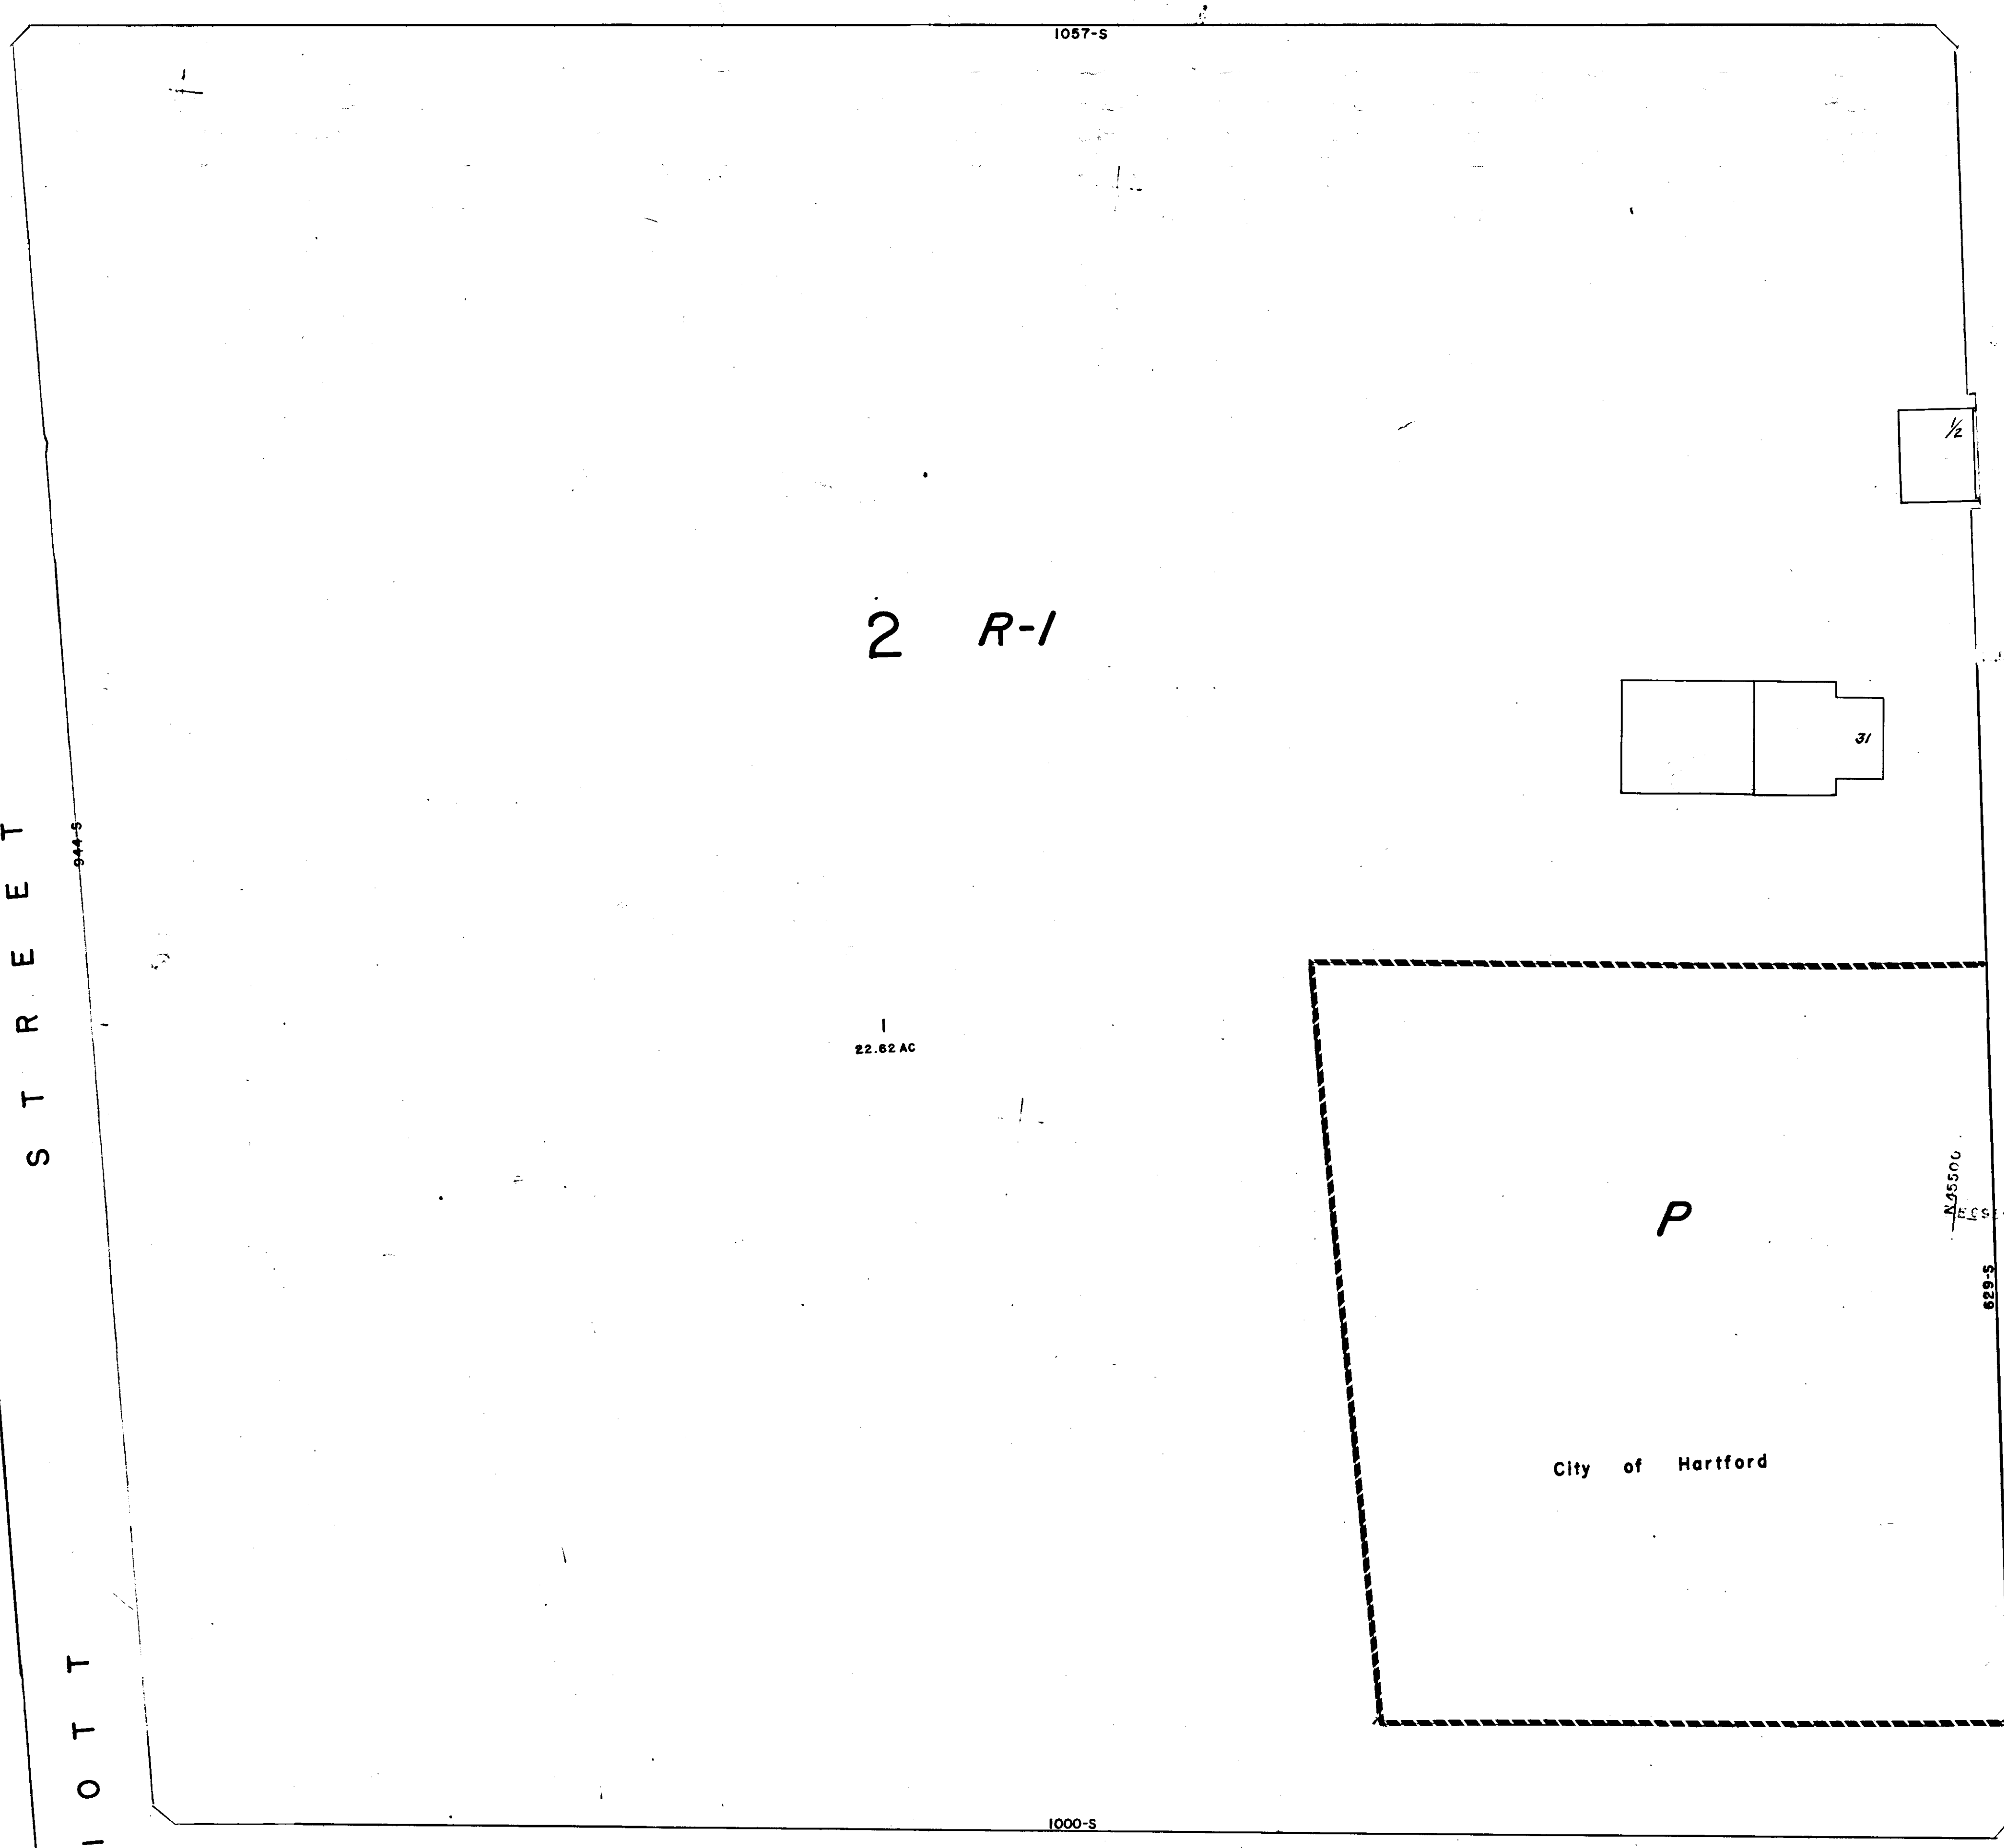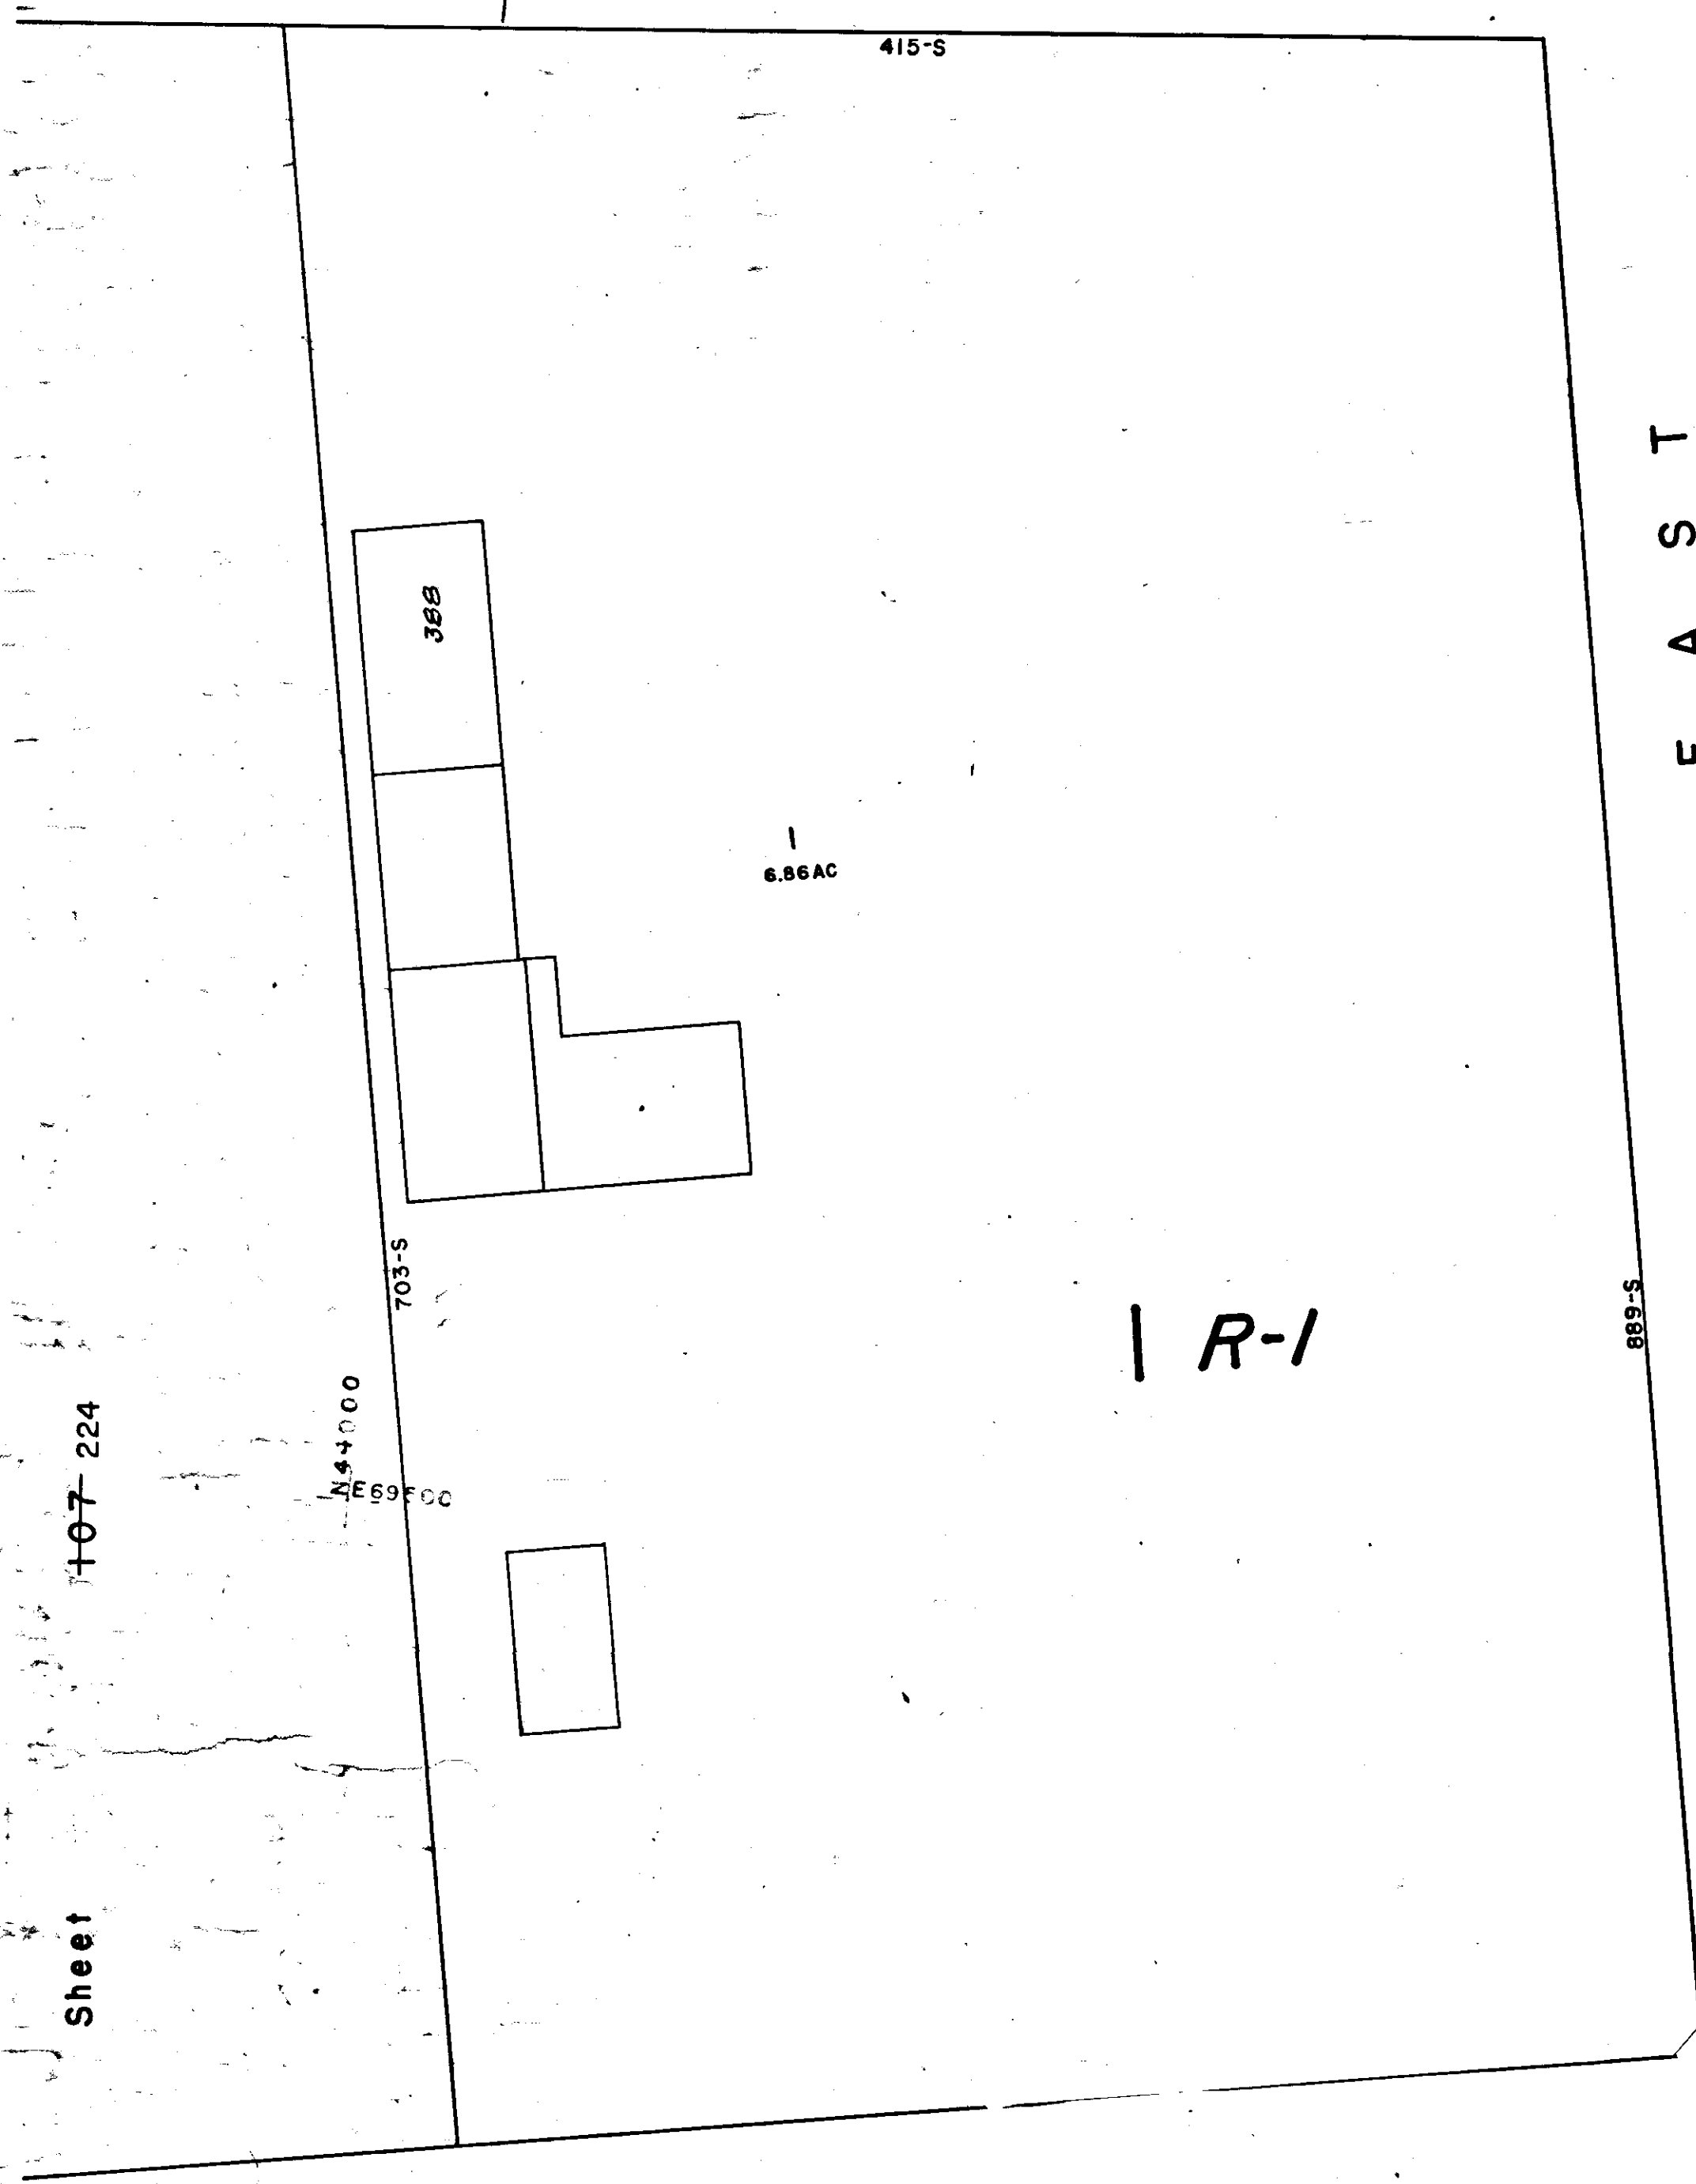

PREPARED UNDER THE DIRECTION OF THE
DEPARTMENT OF ASSESSMENT
CITY OF HARTFORD
BY
AVIS AIRMAP, INC. MASS
BROOKLINE
SCALE 1" = 50'
1971

CITY OF HARTFORD
DEPT. OF ENGINEERING

Property lines and building outlines by the City of Hartford Engineering Department
Block, lot and zone numbers by Avis Airmap
Area calculations by Avis Airmap