


PLAN

SCALE: 1" = 100'

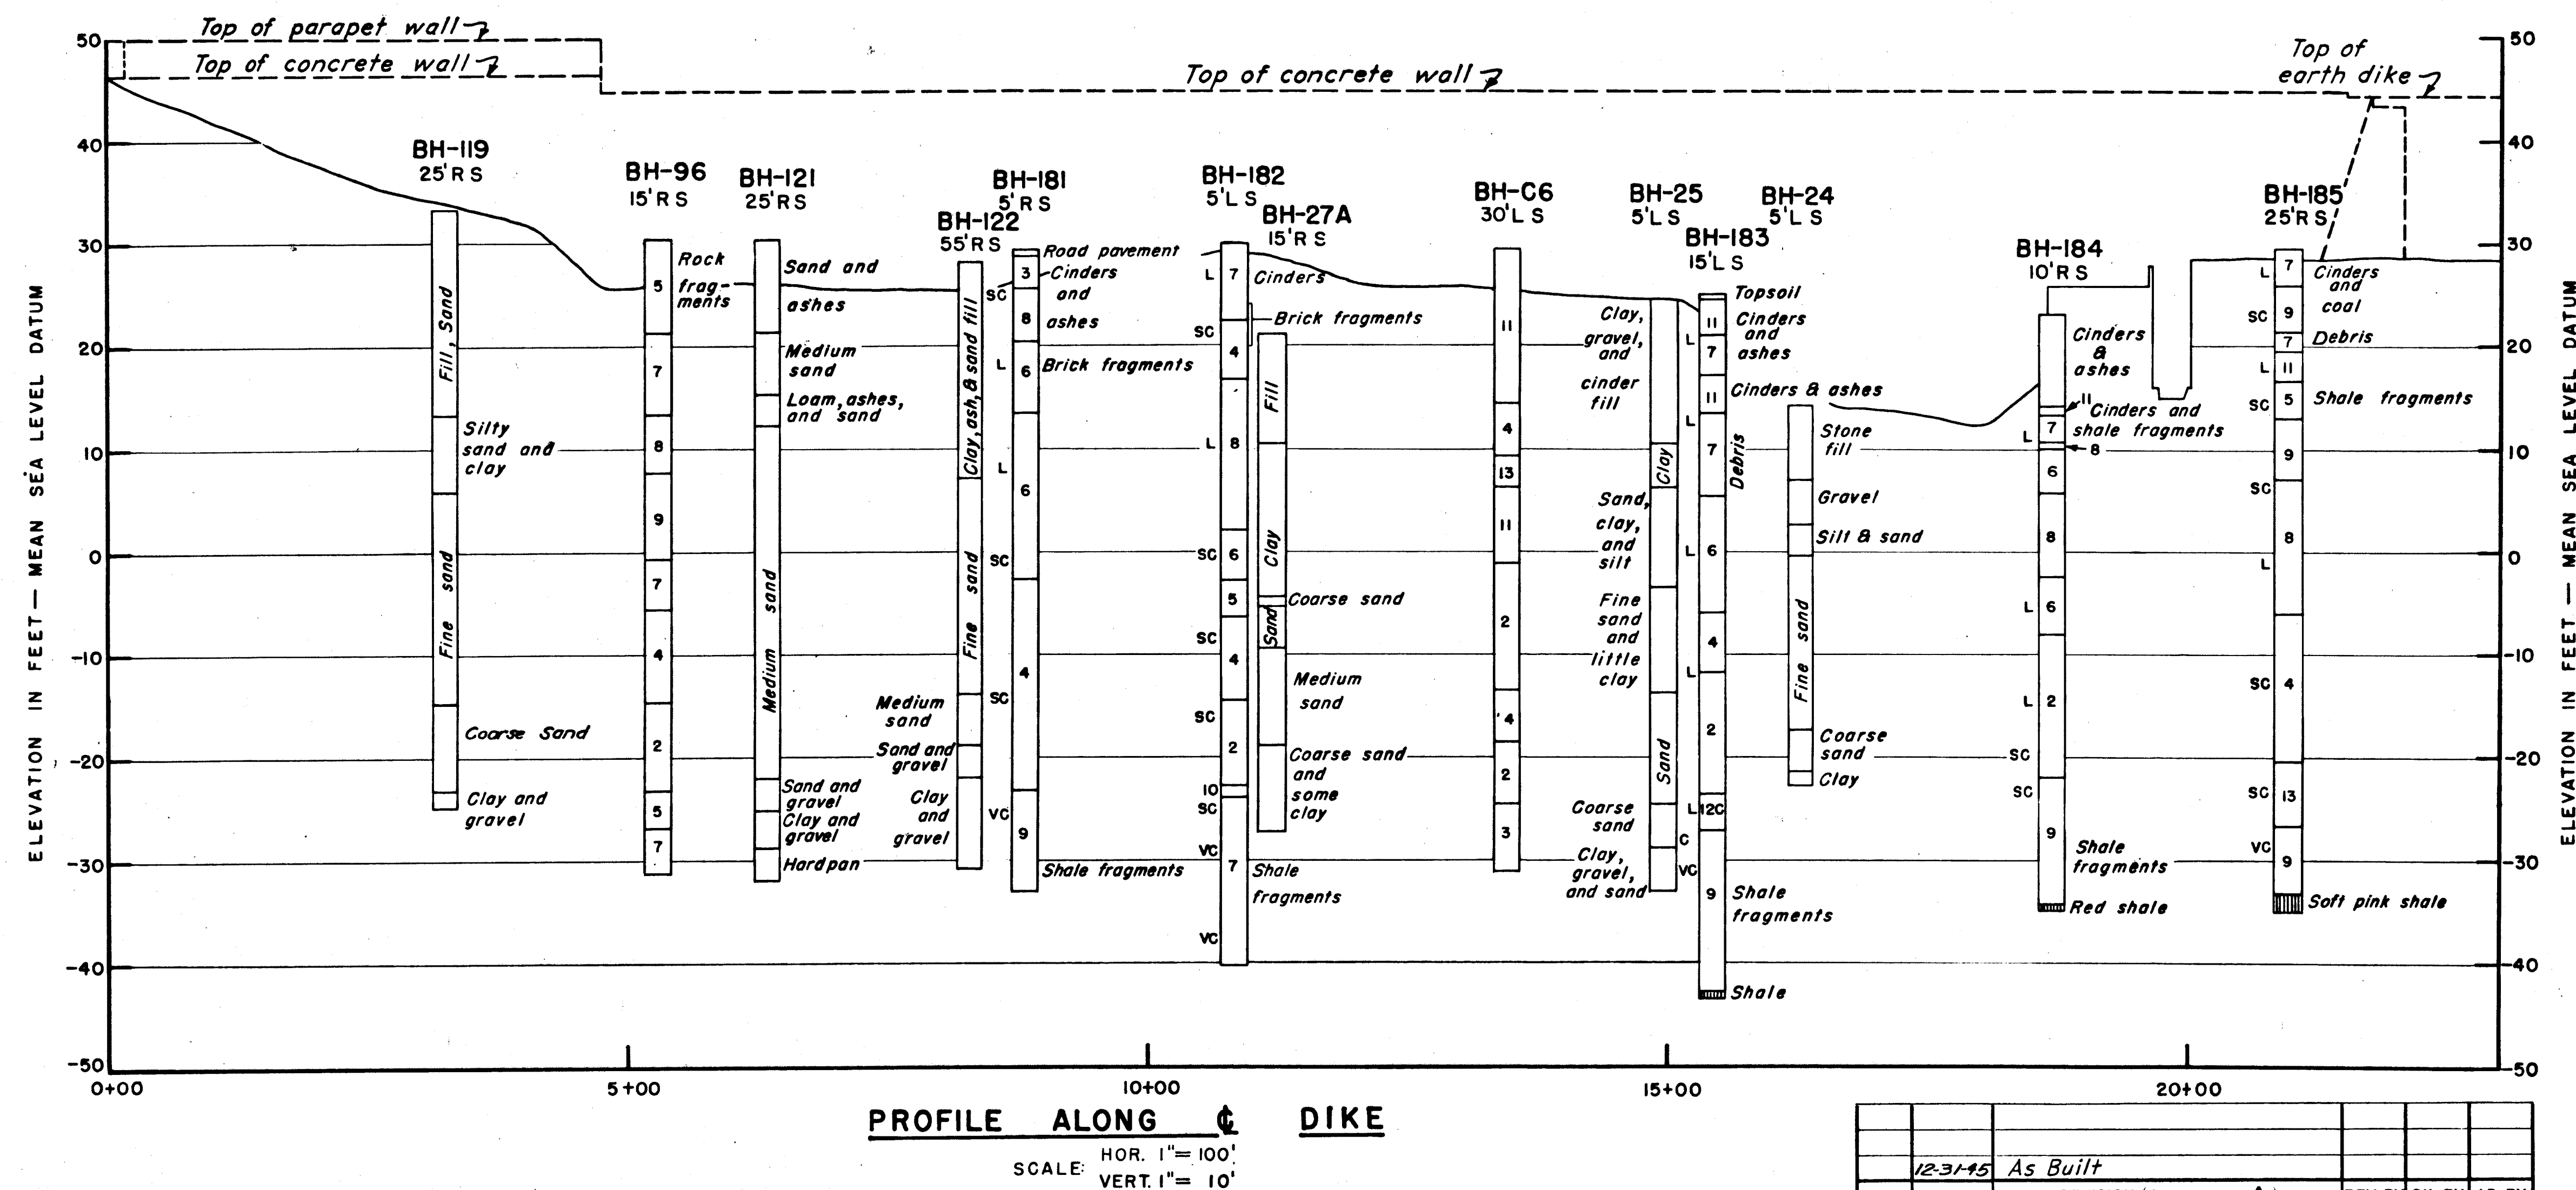

PROFILE ALONG DIKE

SCALE: HOR. 1" = 100'
VERT. 1" = 10'

NOTE

For general notes, legend, and description of soil classes see Sheet No. 7.

CONNECTICUT RIVER FLOOD CONTROL			
HARTFORD DIKE			
RIVERFRONT, MORGAN ST. TO STA. 96+73			
SUBSURFACE EXPLORATIONS NO. 1			
CONNECTICUT RIVER		CONNECTICUT	
IN 135 SHEETS		SCALE: 1 IN = 100 FT.	
U.S. ENGINEER OFFICE, PROVIDENCE, R.I.		MAY 1940	
SUBMITTED:	APPROVAL RECOMMENDED:	APPROVED:	
Frank J. Galloway	W. B. Burns	W. B. Burns	
SENIOR GEOLOGIST	PRINCIPAL ENGINEER	DISTRICT ENGINEER	
HEAD, GEOLOGY SECTION	CHIEF, F.C. ENGINEERING DIV.	DISTRICT ENGINEER	
COMPILED:	DRAWN:	FISCAL YEAR 1940	
W. B. Burns	R. L. & J. M. C.	FILE NO. CT-2-1274	
ASST. ENGINEER	CHECKED:		

H1587b

5

File 11-14-3