


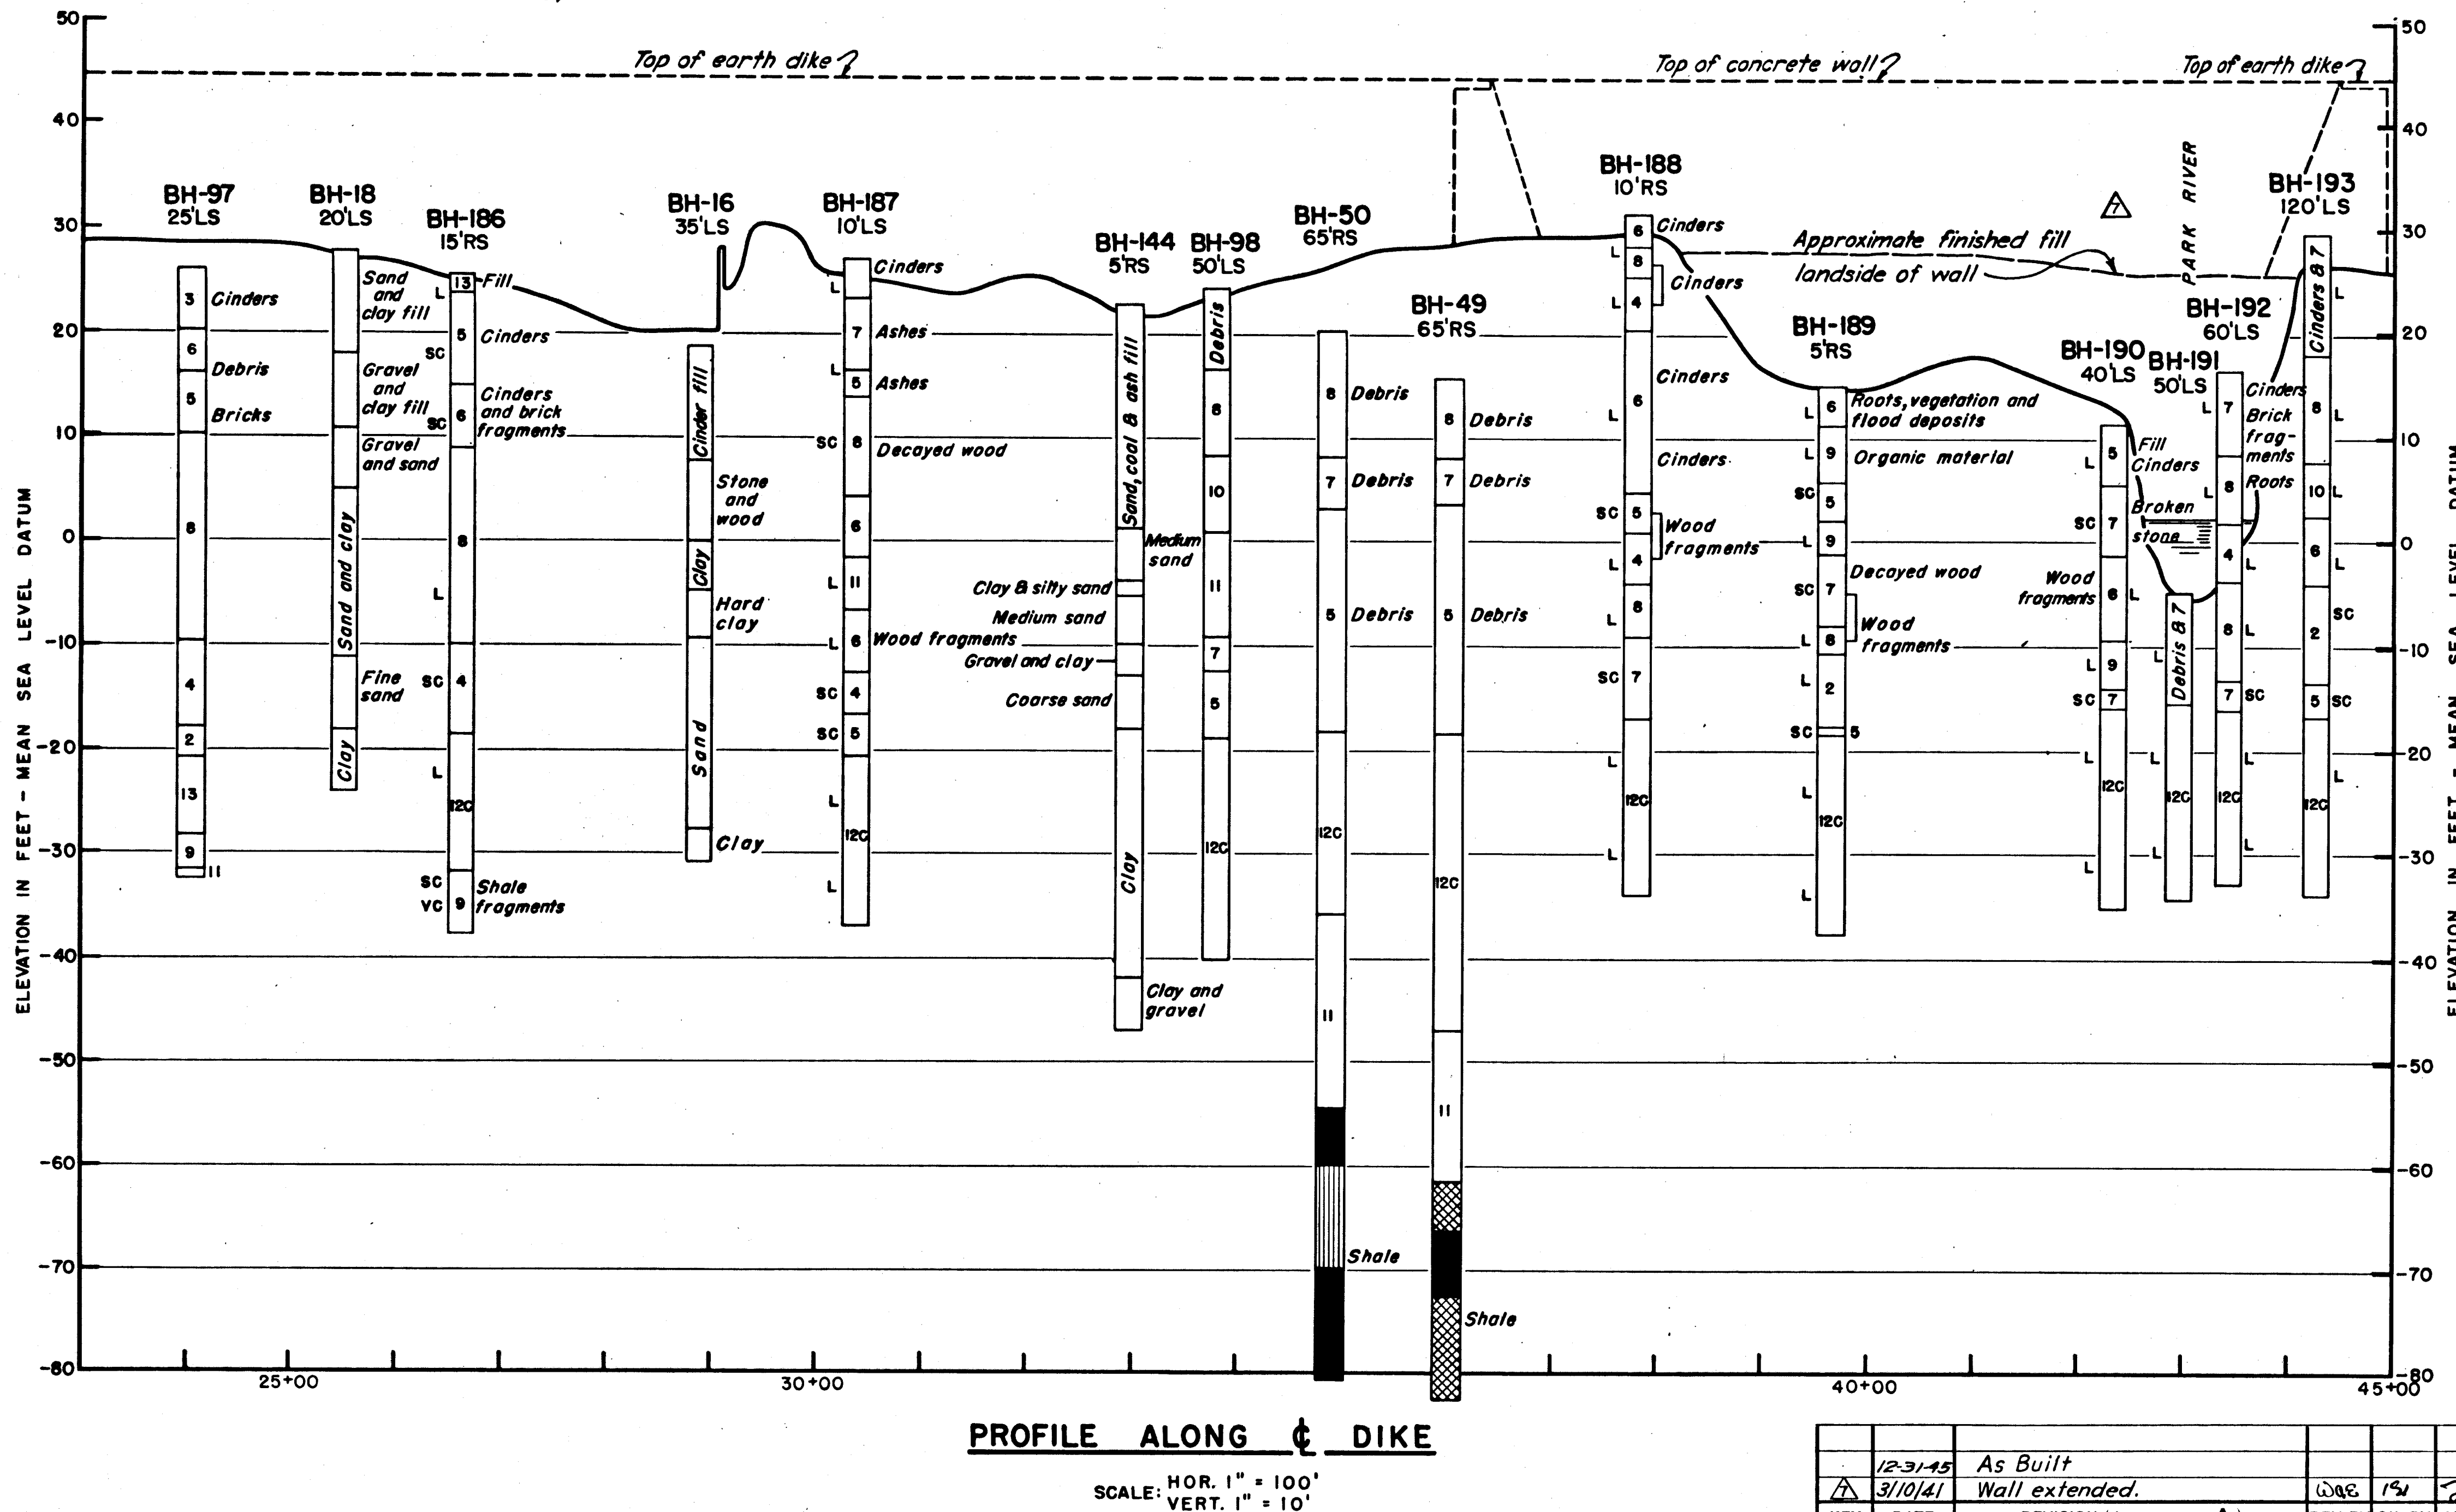

For general notes, legend and description of soil classes, see Sheet No. 7.

CONNECTICUT RIVER FLOOD CONTROL HARTFORD DIKE RIVERFRONT, MORGAN ST. TO STA. 96+73 SUBSURFACE EXPLORATIONS NO.2		
CONNECTICUT RIVER		CONNECTICUT
IN 135 SHEETS	SCALE: 1 IN. = 100 FT. 	SHEET NO. 6
U. S. ENGINEER OFFICE, PROVIDENCE, R.I., MAY 1940		
SUBMITTED: <i>Frank J. Talbot</i> SENIOR GEOLOGIST HEAD, GEOLOGY SECTION	APPROVED FOR: <i>W. B. Burns</i> PRINCIPAL ENGINEER CHIEF, F.C. ENGINEERING DIV.	
COMPILED: <i>Mrs. C. A. G. Baker</i> ASST. ENGINEER	DRAWN: R. R. L. TRACED: P. V. S. CHECKED: <i>W. B. Burns</i>	
		FISCAL YEAR 1940 FILE NO. CT-2-1275