


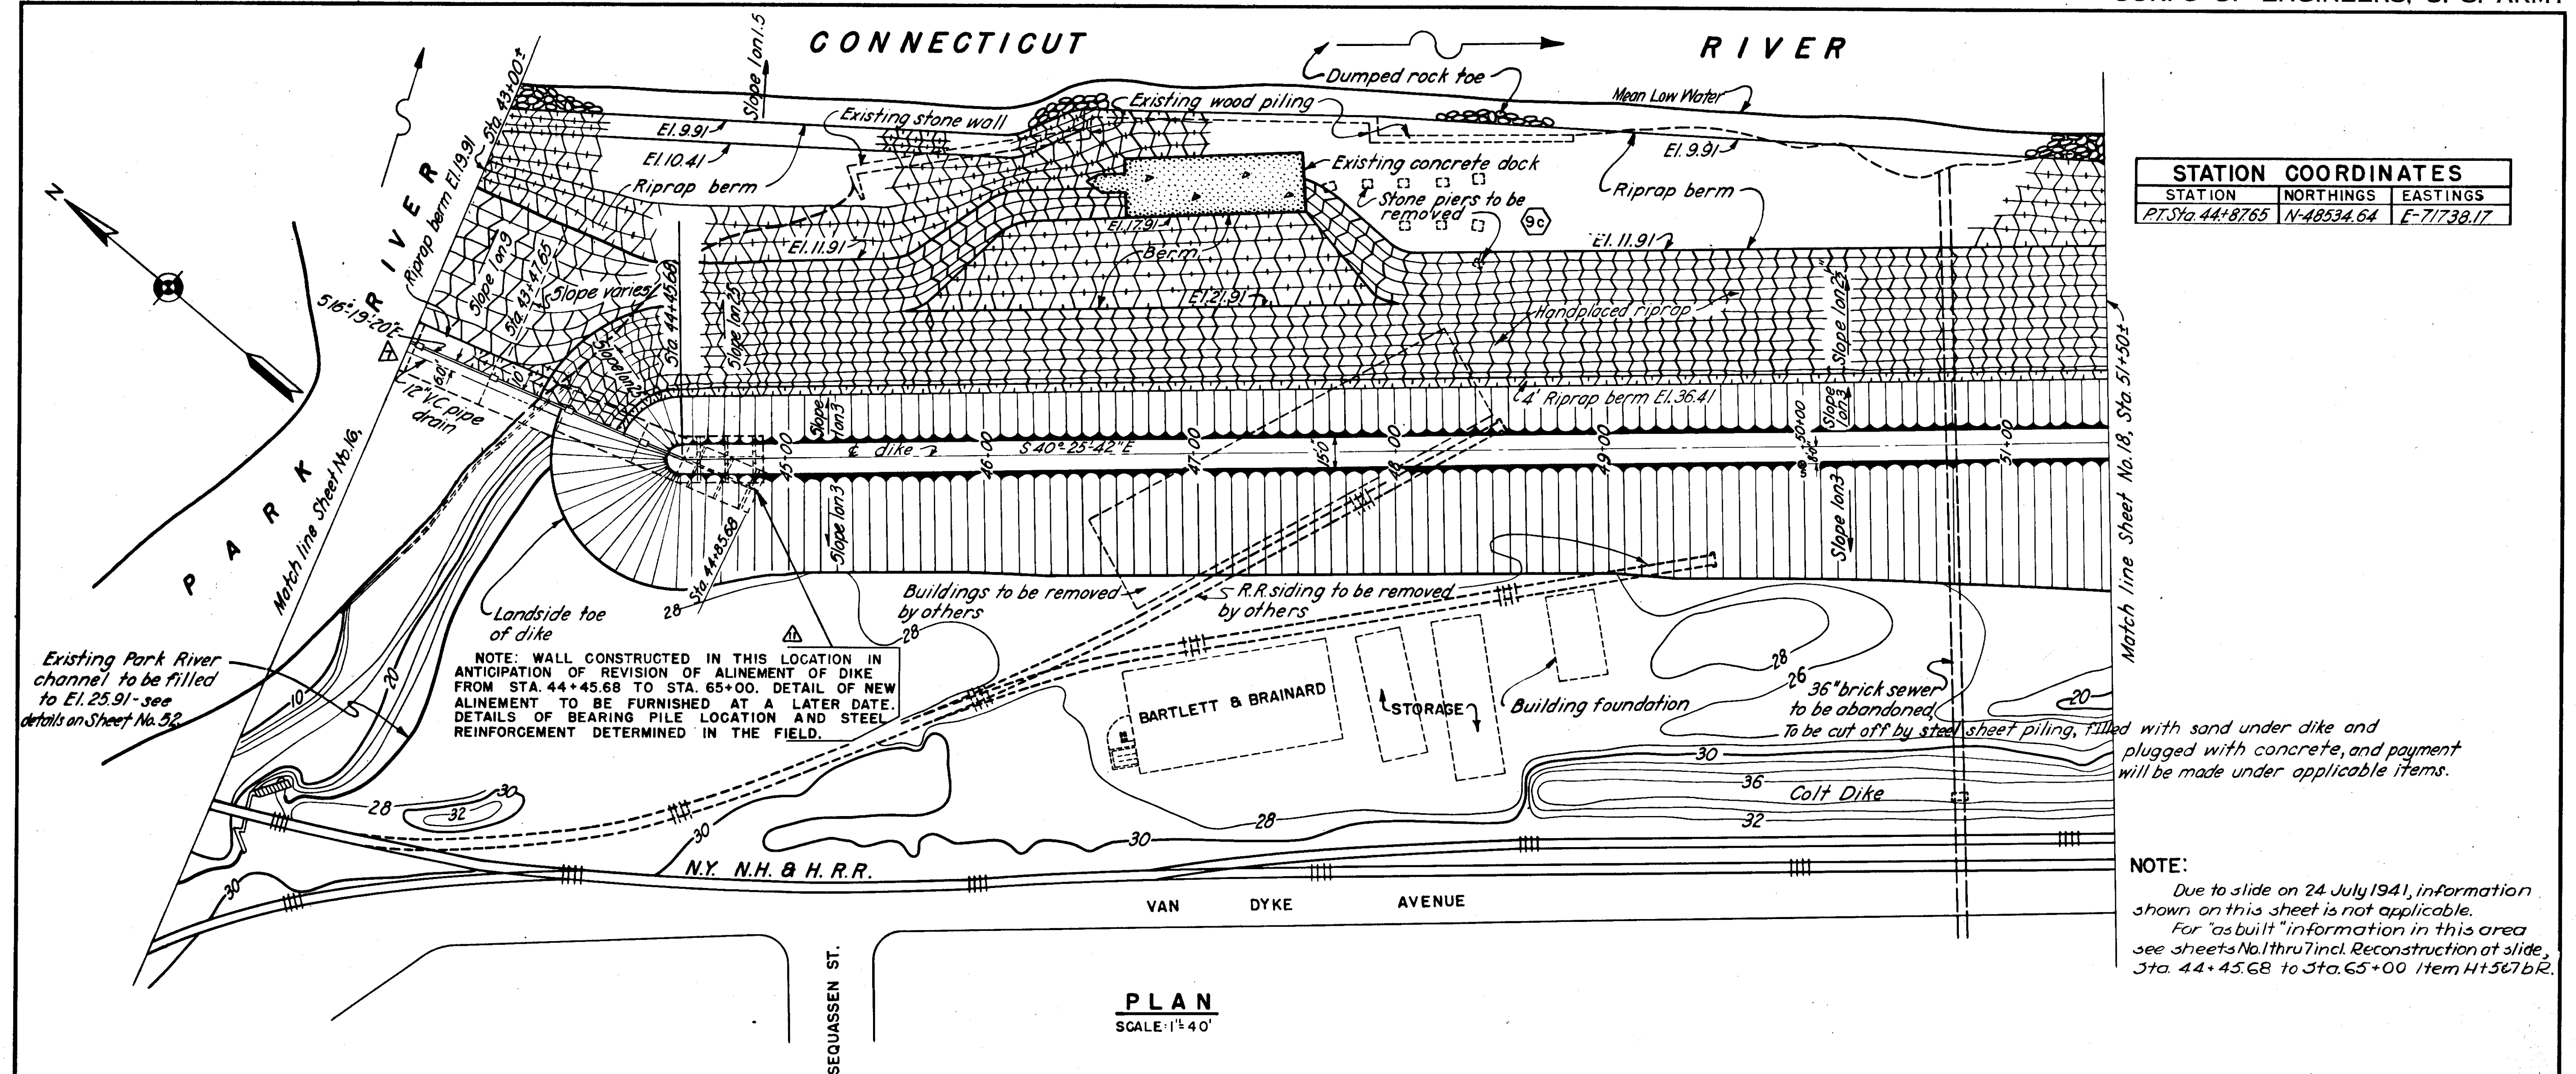


STATION COORDINATES		
STATION	NORTHINGS	EASTINGS
PT. Sta. 44+8765	N-48534.64	E-71738.17

NOTES

For general notes, see Sheet No. 12.
For details of Park River foundation treatment, see Sheets No. 52.
Locations of settlement gages marked Δ , for detail see Sheets No. 52 & 53.

CONNECTICUT RIVER FLOOD CONTROL			
HARTFORD DIKE			
RIVERFRONT, MORGAN ST. TO STA. 96+73			
PLAN AND PROFILE NO. 6			
CONNECTICUT RIVER		CONNECTICUT	
IN 135 SHEETS		SHEET NO. 17	
SCALE: 1"=40 FT.			
U. S. ENGINEER OFFICE, PROVIDENCE, R. I., MAY 1940			
SUBMITTED:	APPROVAL RECOMMENDED:	APPROVED:	
Head B. B. Brown	Principal Engineer	LT Col. W. B. Brown	
HEAD DESIGN SECTION	CHIEF, E.C. ENGINEERING DIV.	DISTRICT ENGINEER	
DESIGNED:	DRAWN:	FISCAL YEAR 1940	
Assoc. Engineer	D.W.G. - H. C. J.	FILE NO. CT-4-2477	
TRACED: P.V.S. - G.F.B.		CHECKED: W.D.R.	

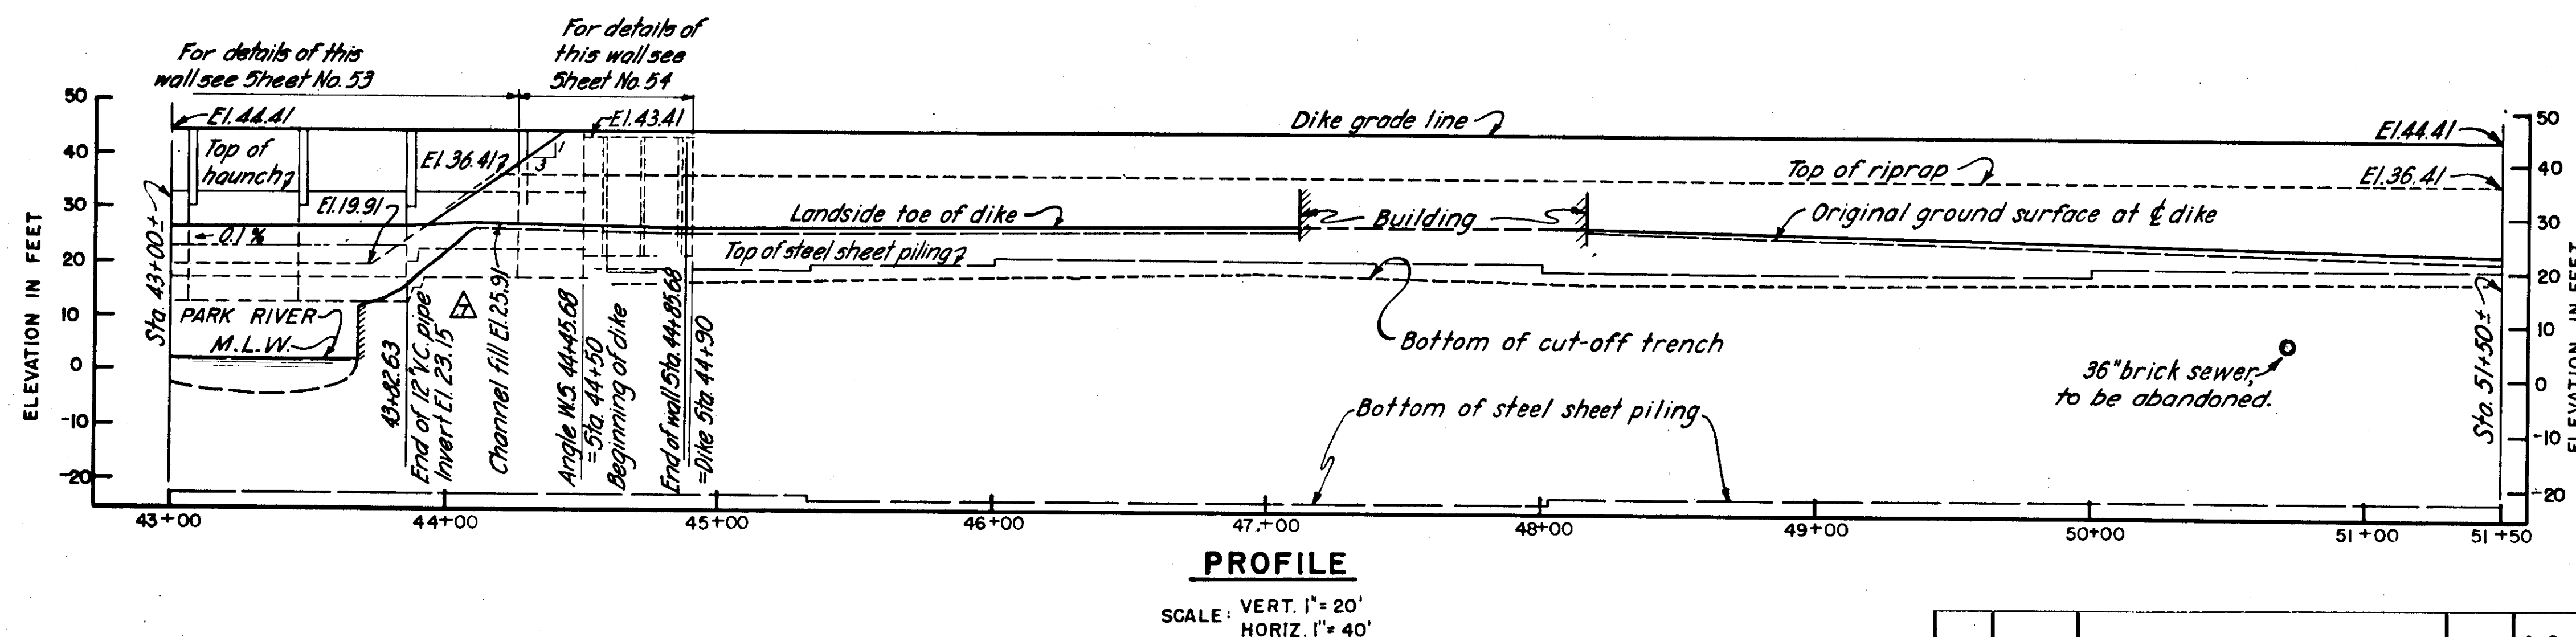

KEY	DATE	REVISION (Indicated by Δ)	REV. BY	CK. BY	AP. BY
Δ	12/11/41	Wall alignment revised	W.D.R.	W.D.R.	W.D.R.
Δ	3/10/41	Concrete wall extended	W.D.R.	W.D.R.	W.D.R.