


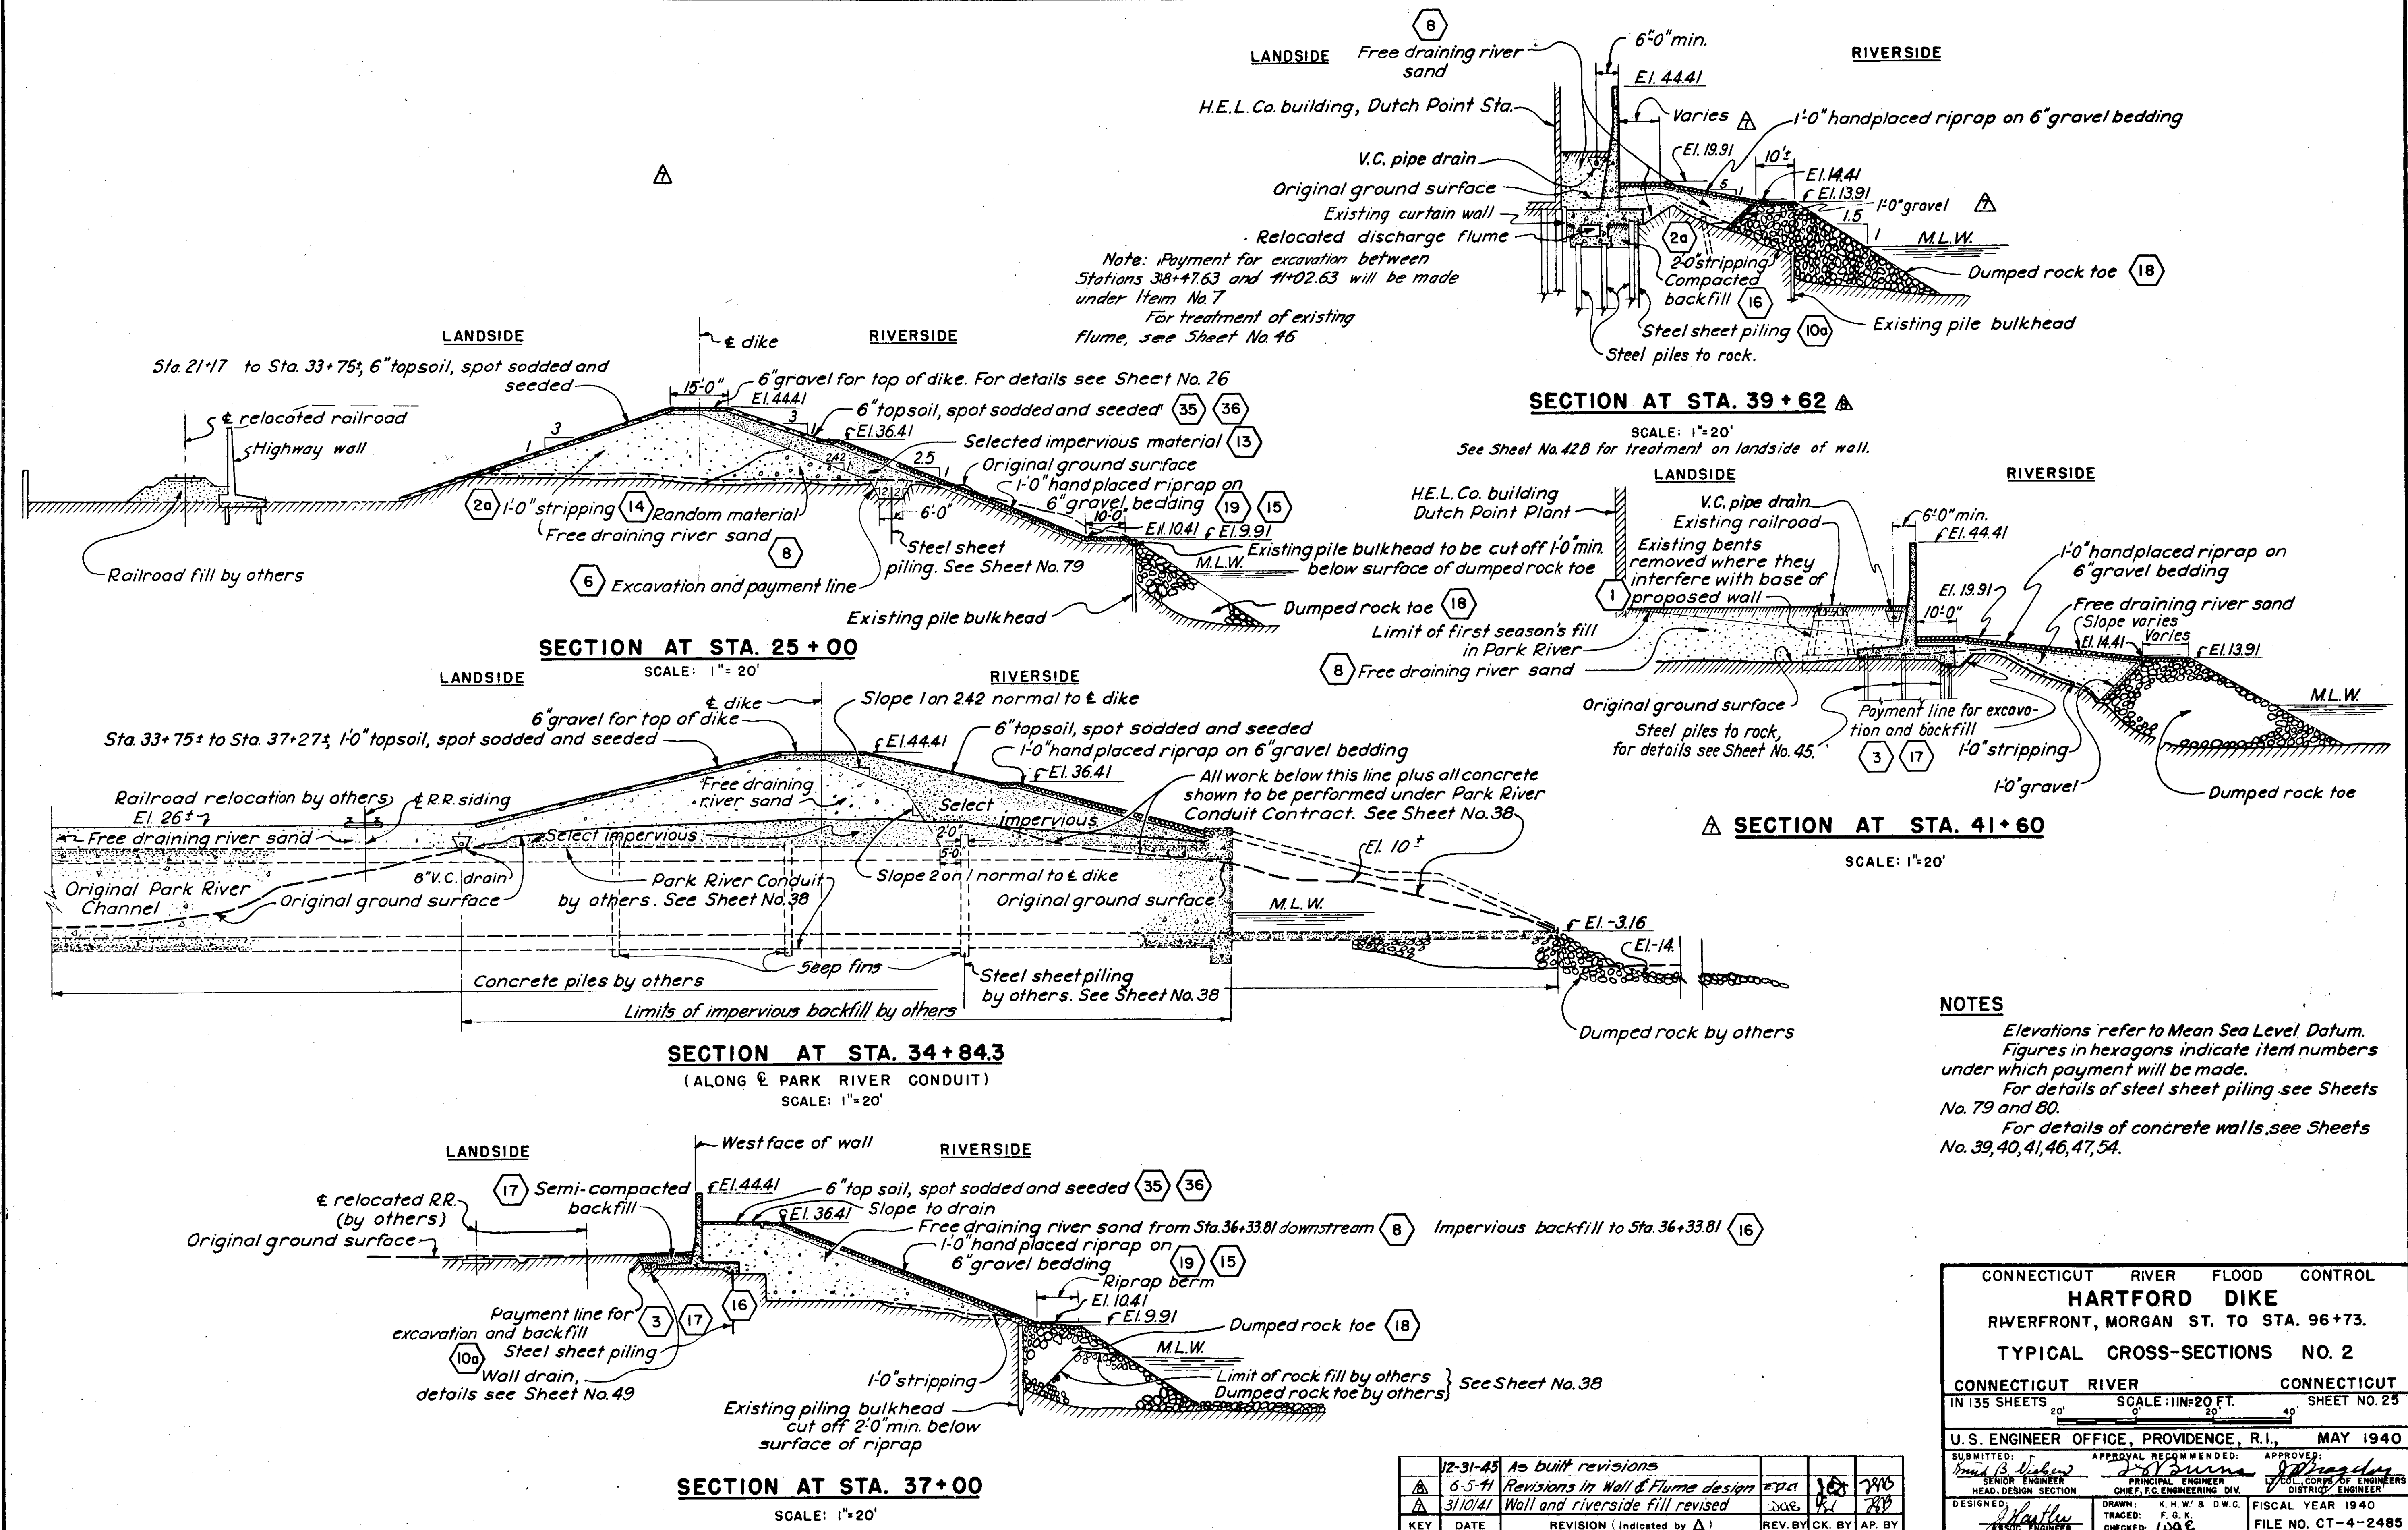

CONNECTICUT RIVER FLOOD CONTROL		
HARTFORD DIKE		
RIVERFRONT, MORGAN ST. TO STA. 96+73.		
TYPICAL CROSS-SECTIONS NO. 2		
CONNECTICUT RIVER	CONNECTICUT	
IN 135 SHEETS	SCALE: 1"=20 FT.	SHEET NO. 25
U.S. ENGINEER OFFICE, PROVIDENCE, R.I., MAY 1940		
SUBMITTED:	APPROVAL RECOMMENDED:	APPROVED:
SENIOR ENGINEER	PRINCIPAL ENGINEER	COL. CORPS OF ENGINEERS
HEAD, DESIGN SECTION	CHIEF, F.C. ENGINEERING DIV.	DISTRICT ENGINEER
DESIGNED:	DRAWN:	FISCAL YEAR 1940
TRACED:	CHECKED:	FILE NO. CT-4-2485
	W.O.B.	