
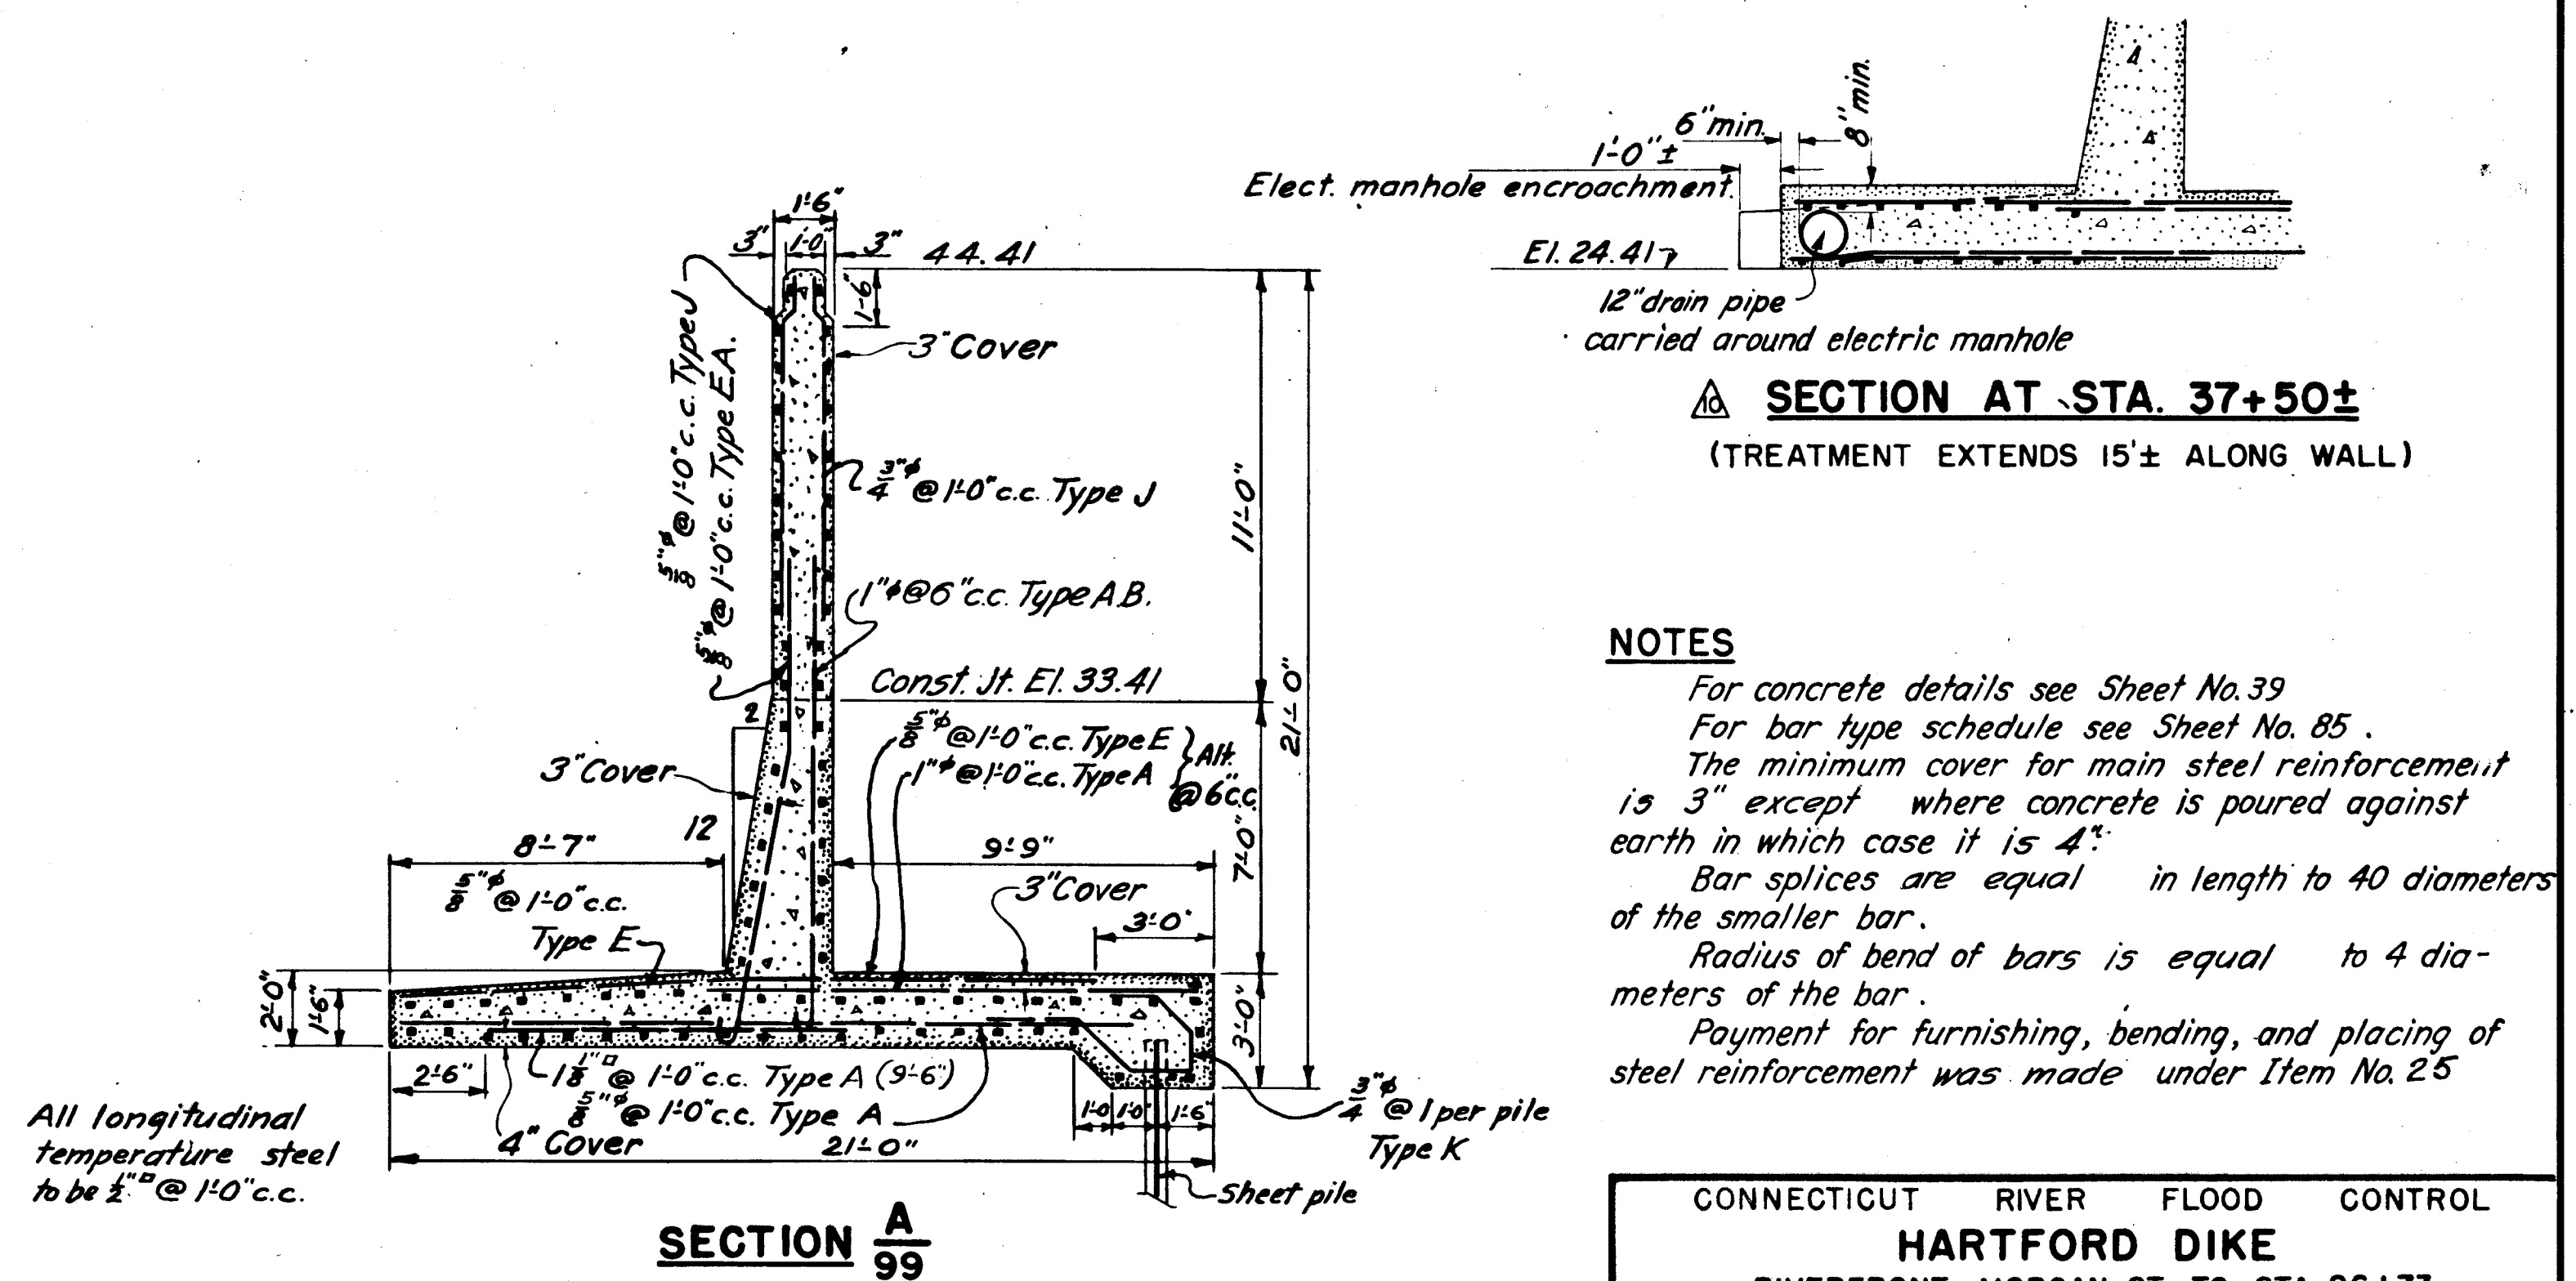


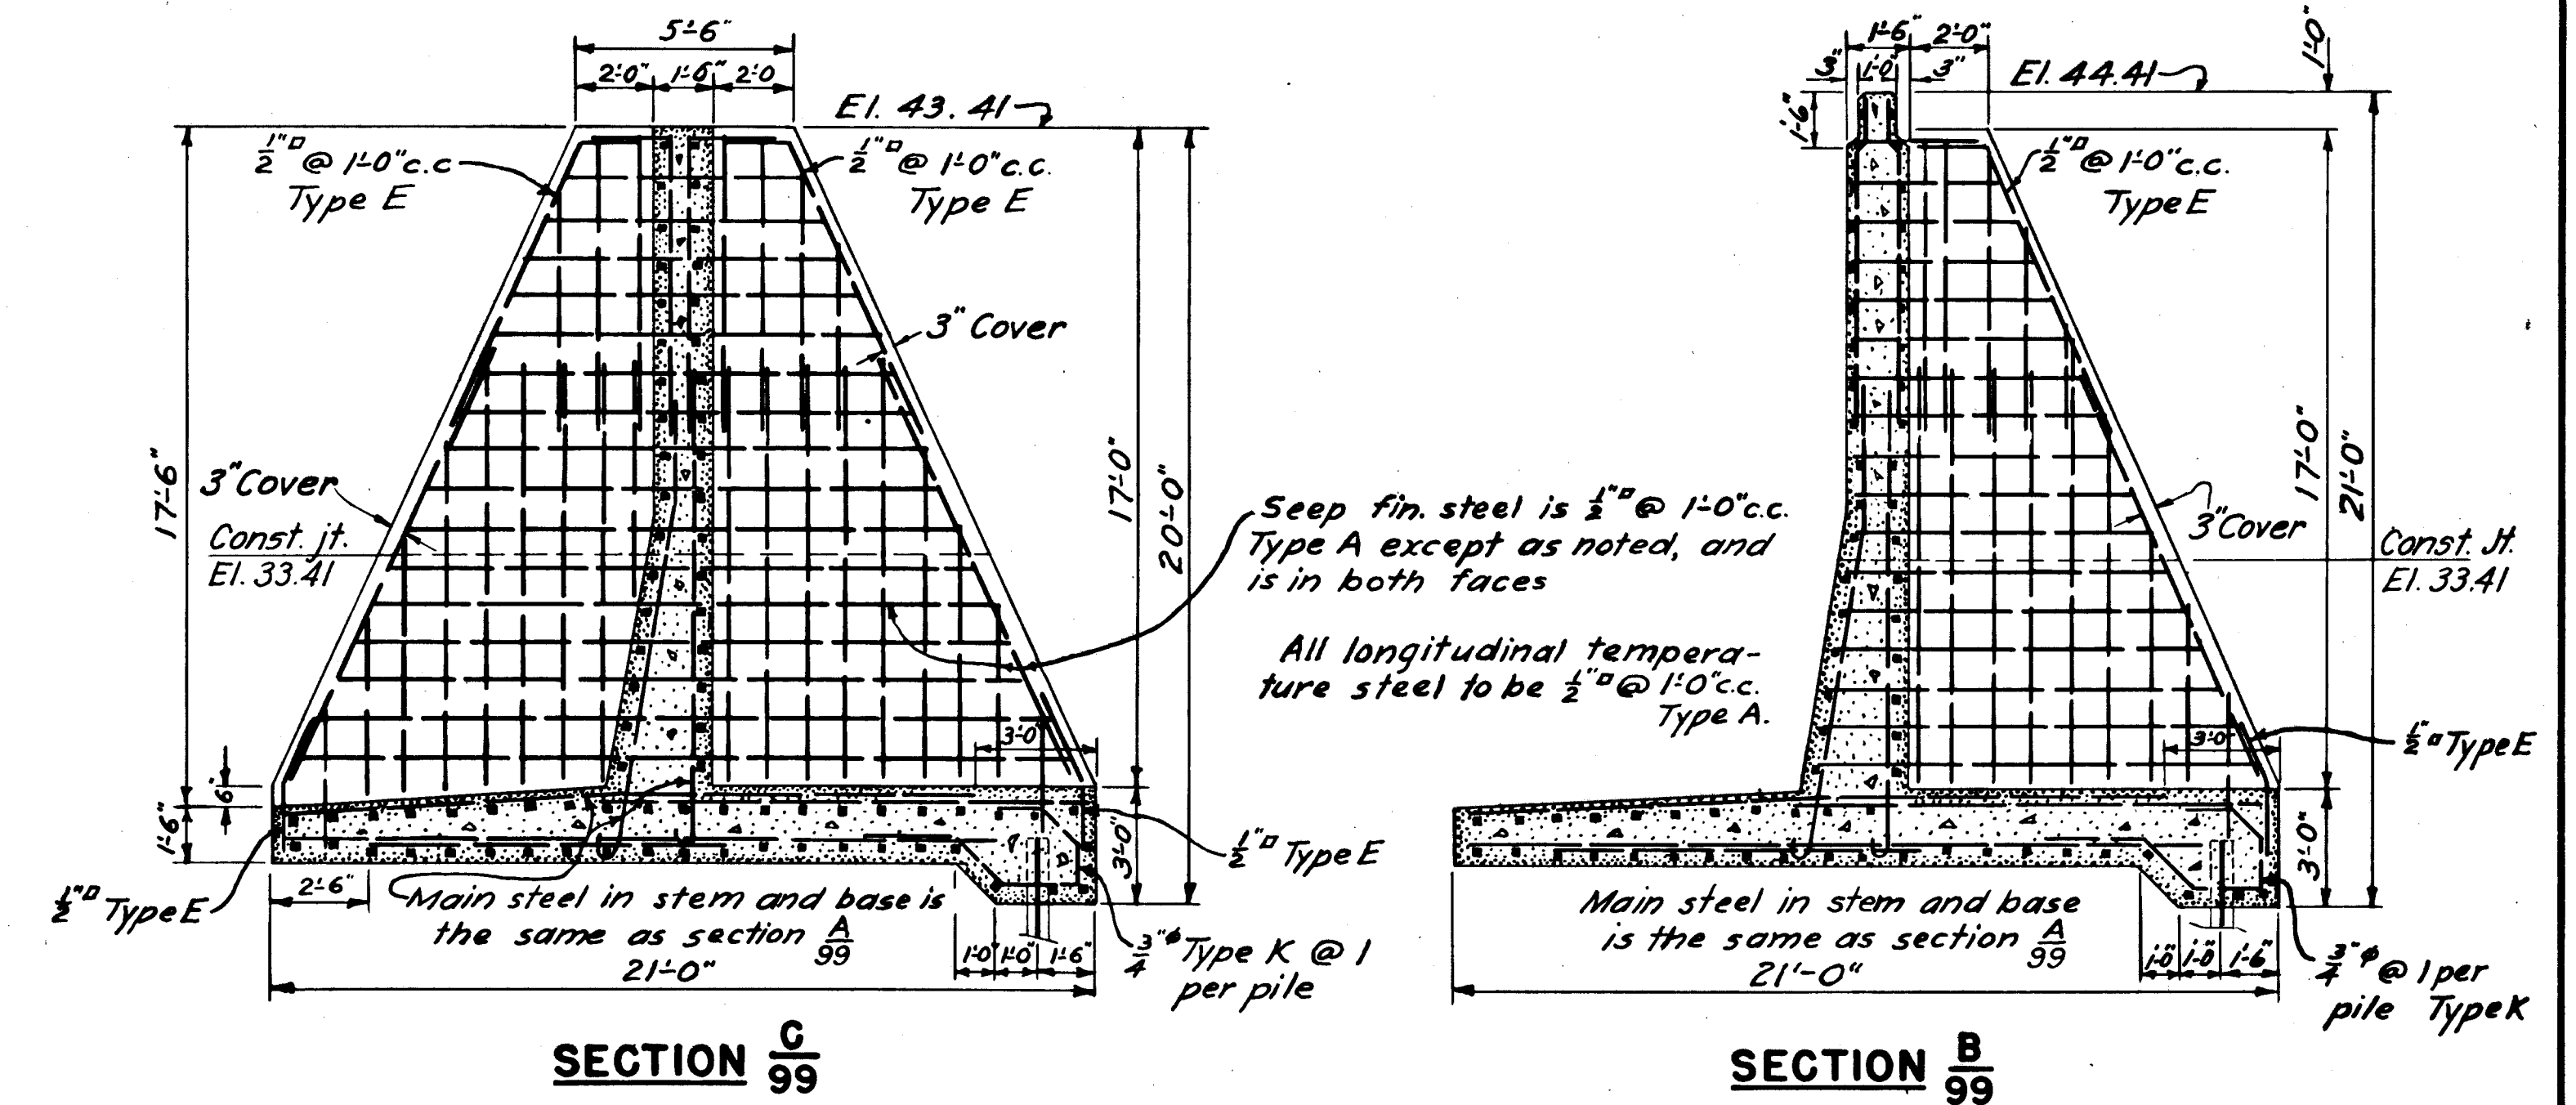

NOTES

For concrete details see Sheet No. 39
For bar type schedule see Sheet No. 85 .
The minimum cover for main steel reinforcement is 3" except where concrete is poured against earth in which case it is 4".
Bar splices are equal in length to 40 diameters of the smaller bar .
Radius of bend of bars is equal to 4 diameters of the bar .
Payment for furnishing, bending, and placing of steel reinforcement was made under Item No. 25

						SUBMITTED:	APPROVAL RECOMMENDED:	APPROVED:
	12-31-45	A5 built revisions				Kenneth B. McLean SENIOR ENGINEER HEAD, DESIGN SECTION	J.B. Burns PRINCIPAL ENGINEER CHIEF, F.G. ENGINEERING DIV.	M.C. Cragg LTCOL., CORPS OF ENGINEERS DISTRICT ENGINEER
Δ	10/6/41	Section added.	R.C.A.	J.D.	W.B.	DESIGNED:	DRAWN: O.A.K. TRACED: A.A.H. CHECKED: J.L.H.	FISCAL YEAR 1940
KEY	DATE	REVISION (Indicated by Δ)	REV. BY	OK BY	AP. BY	J.L. Howell ASSOC. ENGINEER		FILE NO. CT-4-2559