

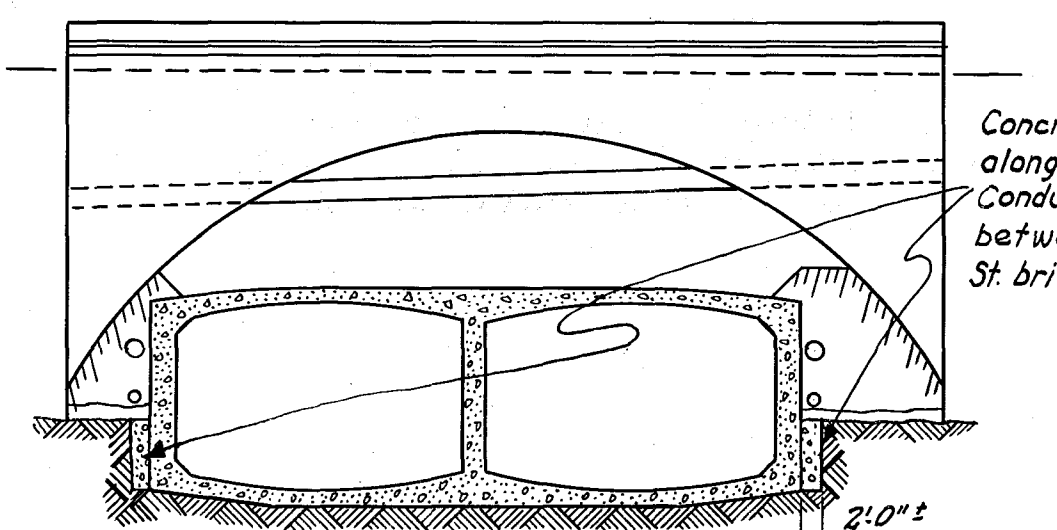
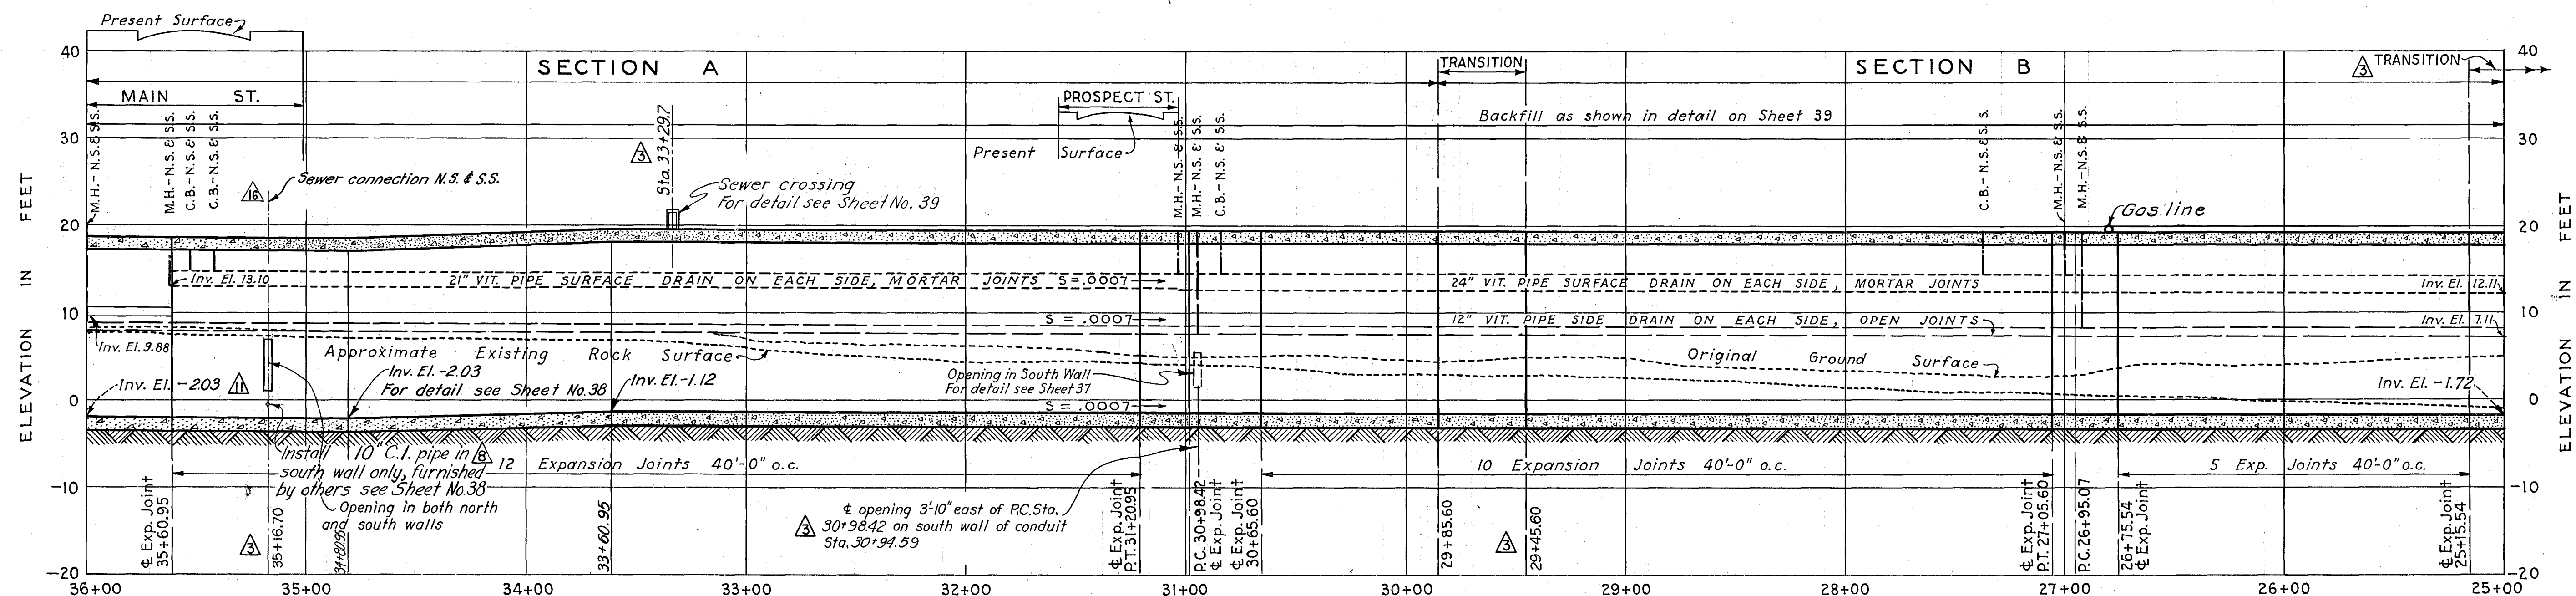


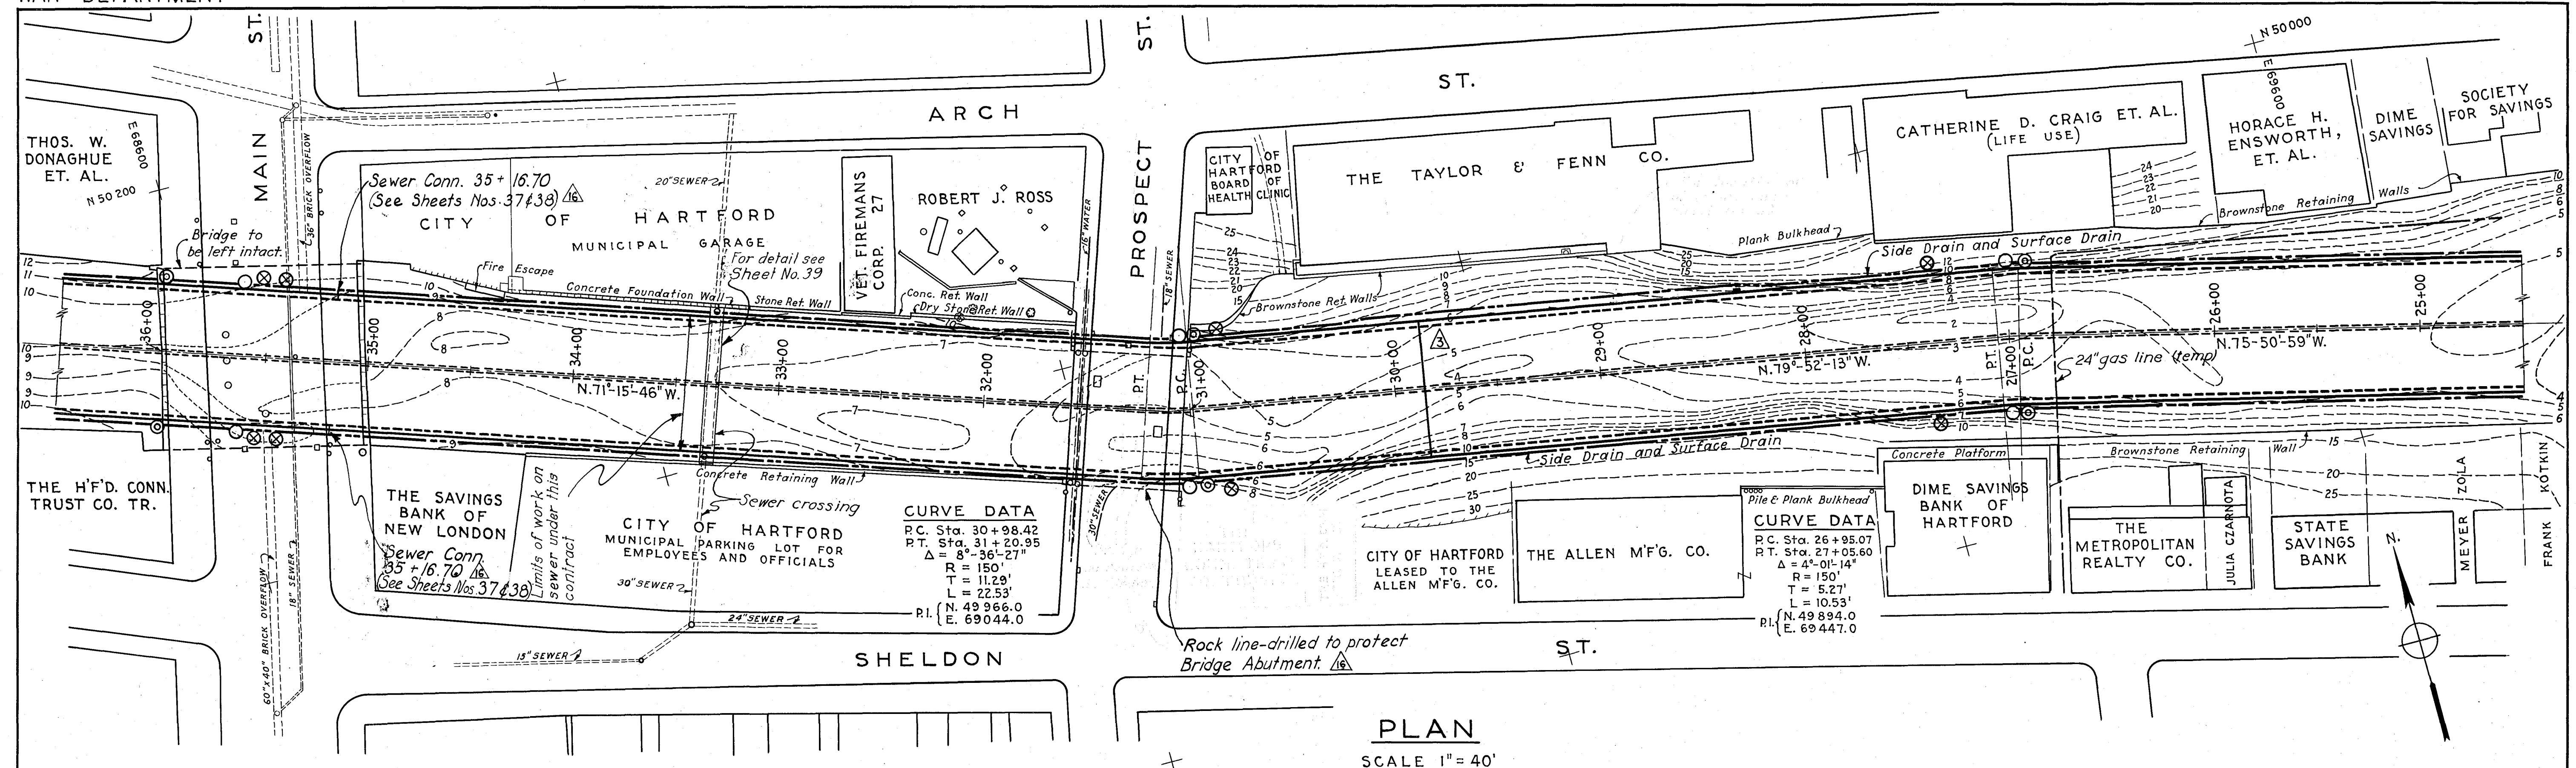

SECTION AT STA. 36+00 LOOKING EAST
SCALE 1" = 20'
METCALF & EDDY
ENGINEERS
BOSTON, MASS.

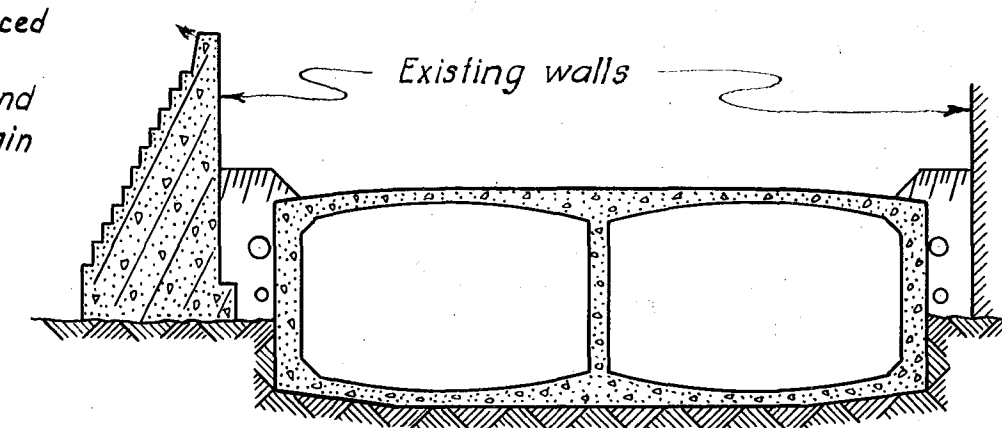

SECTION AT STA. 33+00 LOOKING WEST
SCALE 1" = 20'

CONNECTICUT RIVER FLOOD CONTROL
PARK RIVER CONDUIT
HARTFORD, CONN.

PLAN AND PROFILE NO. 3

CONNECTICUT RIVER CONNECTICUT
IN 48 SHEETS SCALE 1" = 40 FT. SHEET NO. 12

U.S. ENGINEER OFFICE PROVIDENCE, R.I. MAY 1940

REVIEWED: *W. H. Hauer* APPROVAL RECOMMENDED: *W. H. Hauer* APPROVED: *W. H. Hauer*
ENGINEER: *W. H. Hauer* PRINCIPAL ENGINEER: *W. H. Hauer* LT. COL. CORPS OF ENGINEERS
F.C. DESIGN SECTION CHIEF F.C. ENGINEERING DIV. DISTRICT ENGINEER
SUBMITTED: *W. H. Hauer* (PARTNER) TRACED BY: H.C.T. FILE NO. CT-4-2610
METCALF & EDDY CHECKED BY: H.C.T.
BOSTON, MASS.