

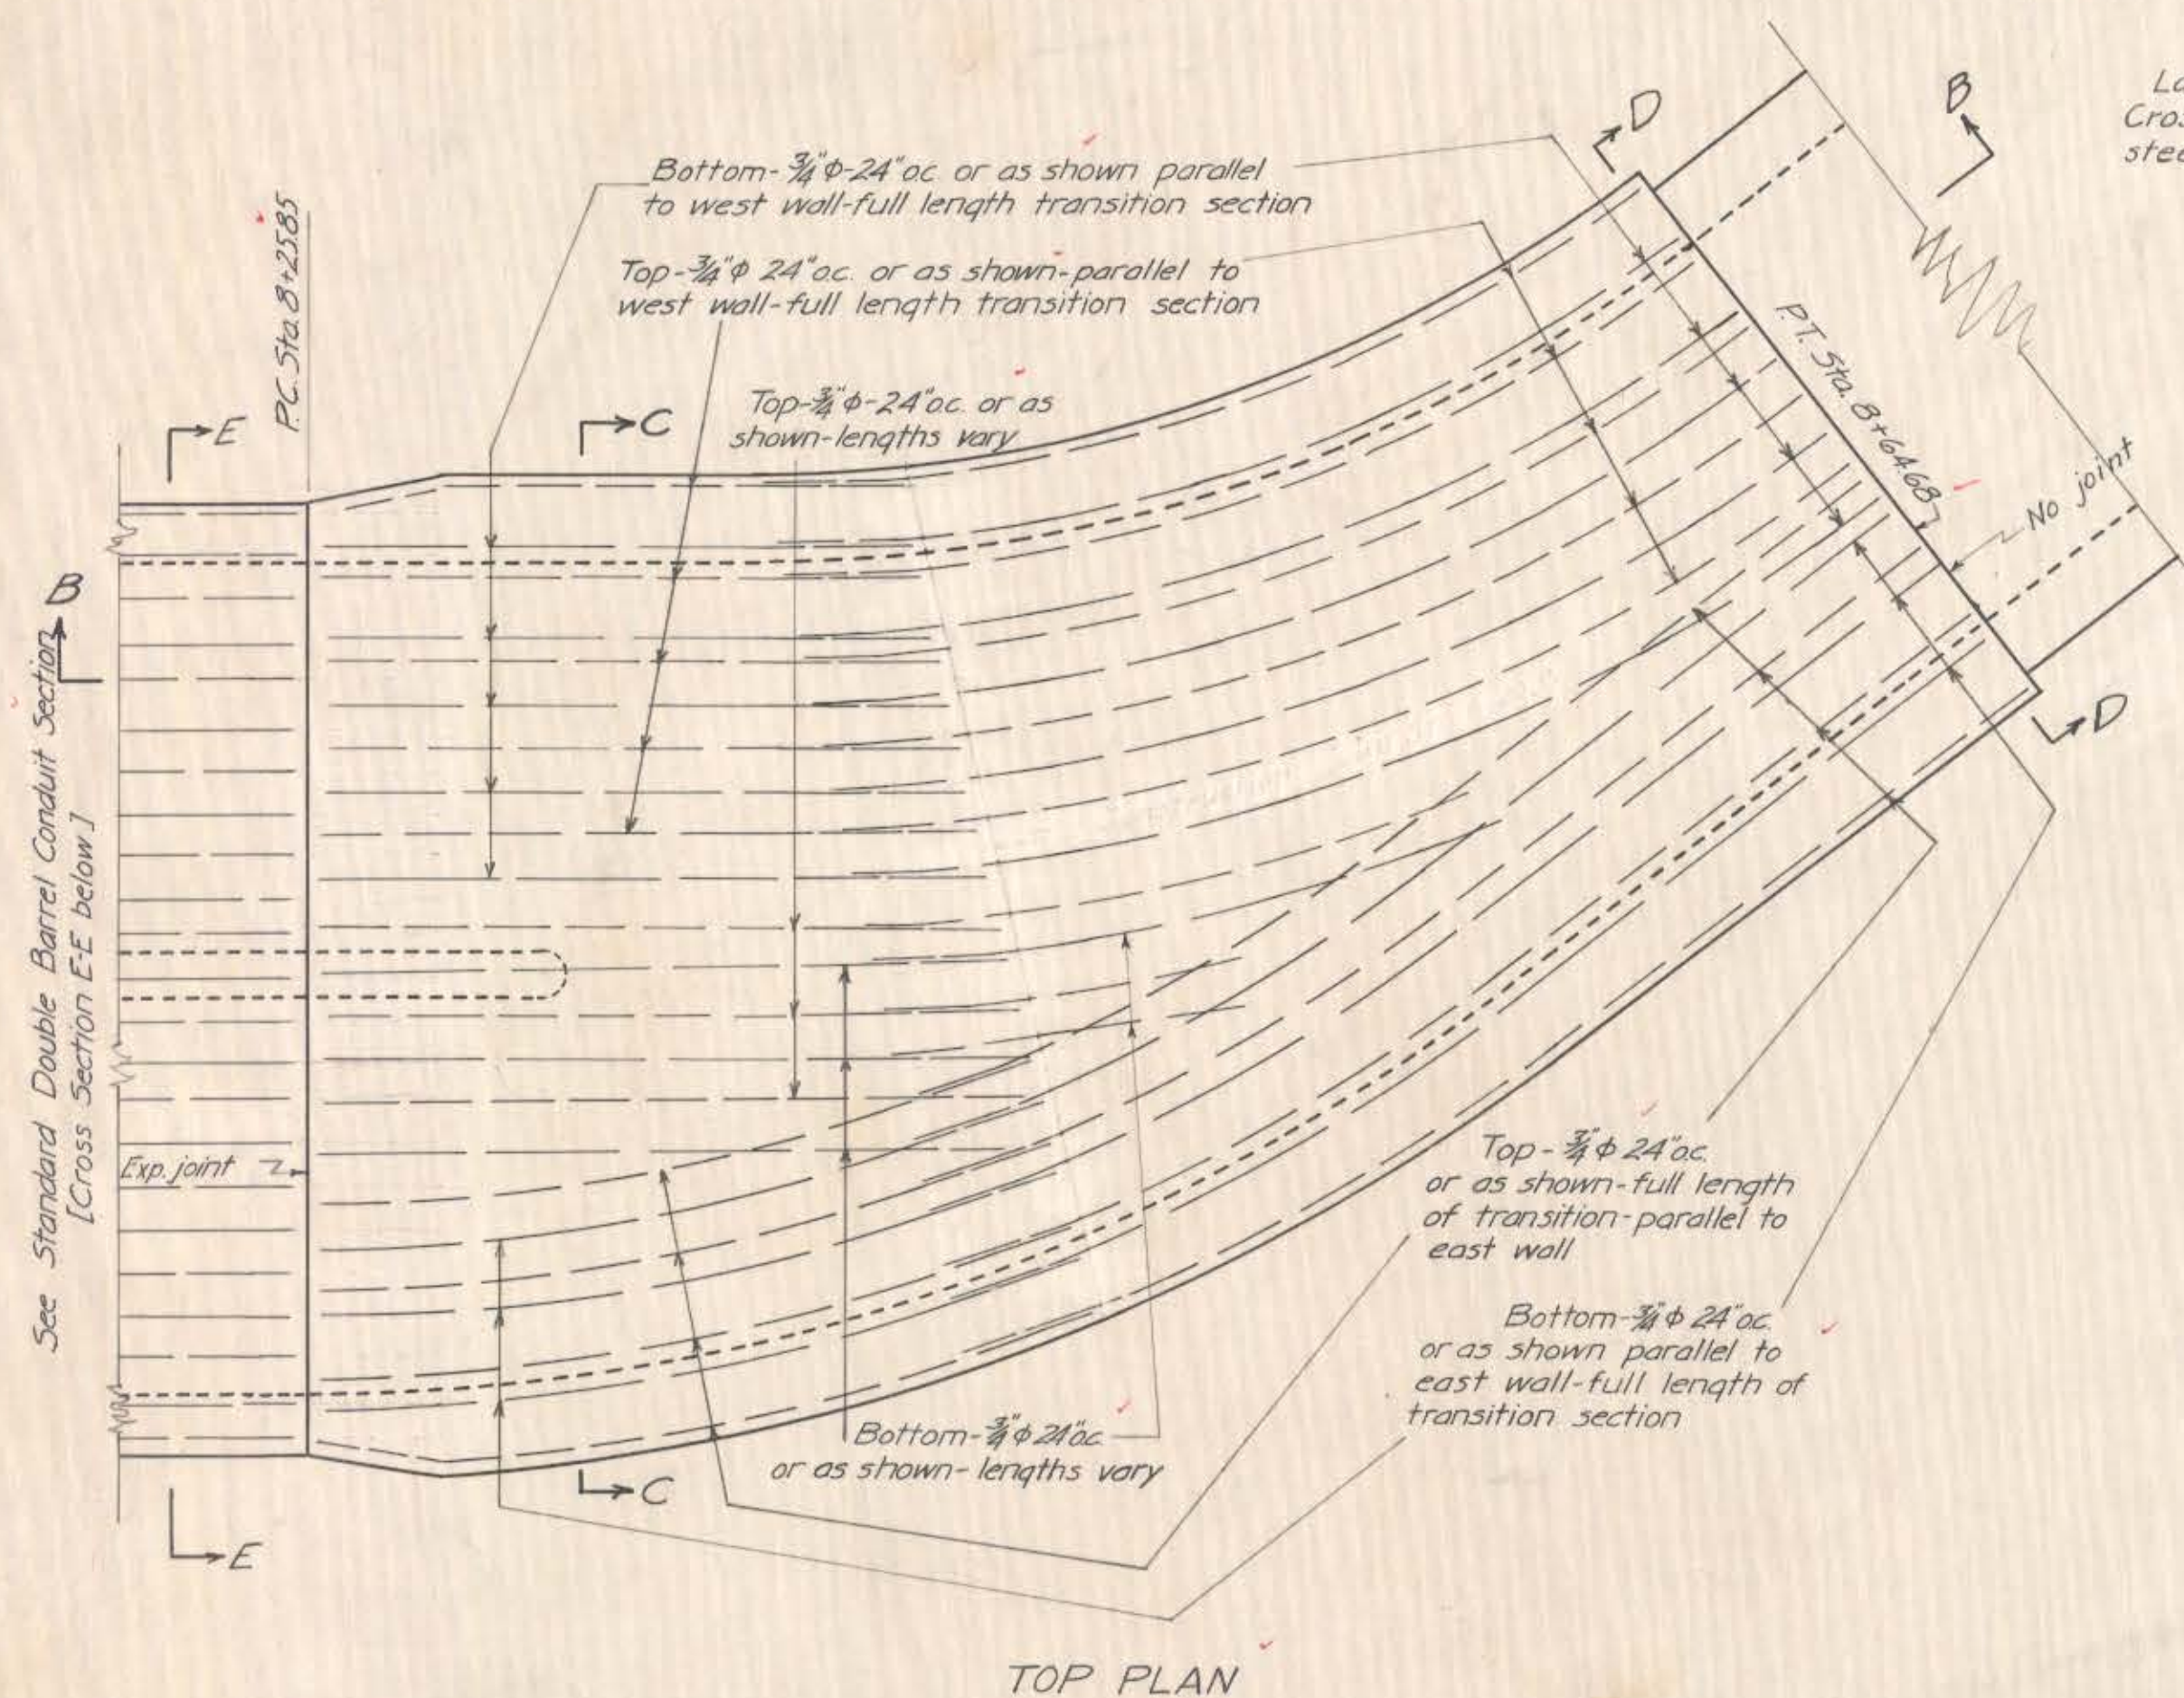
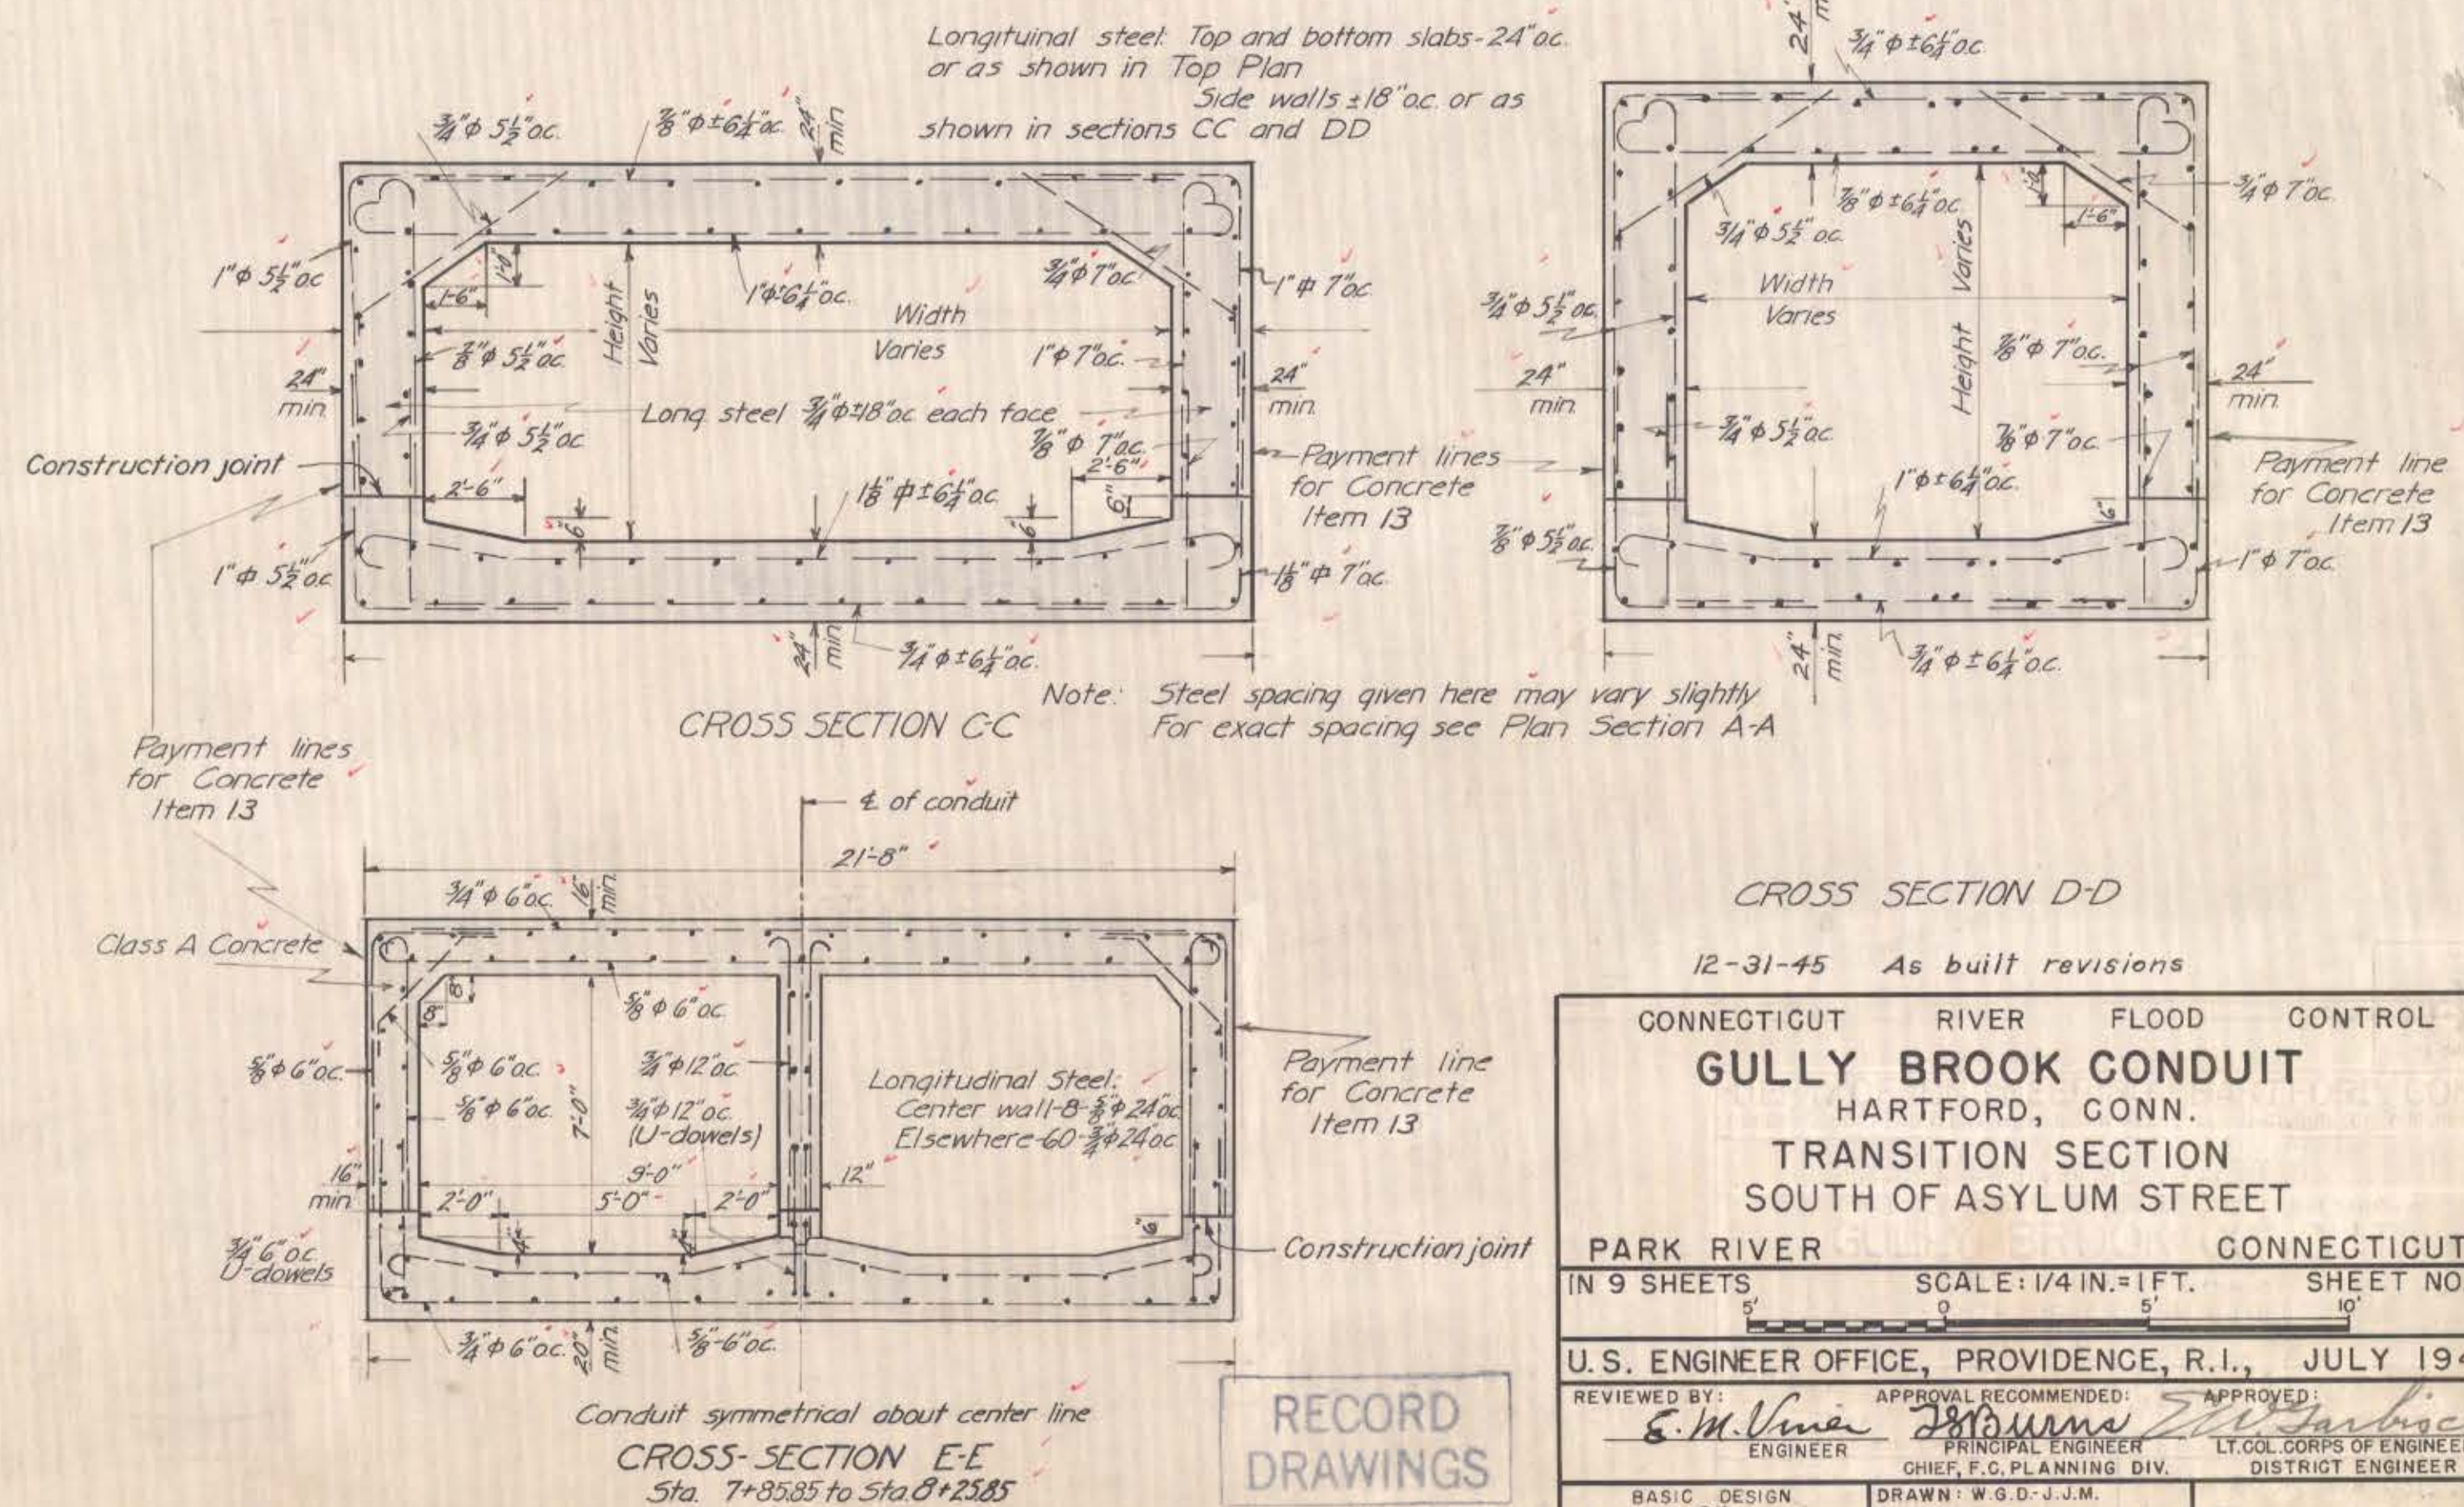


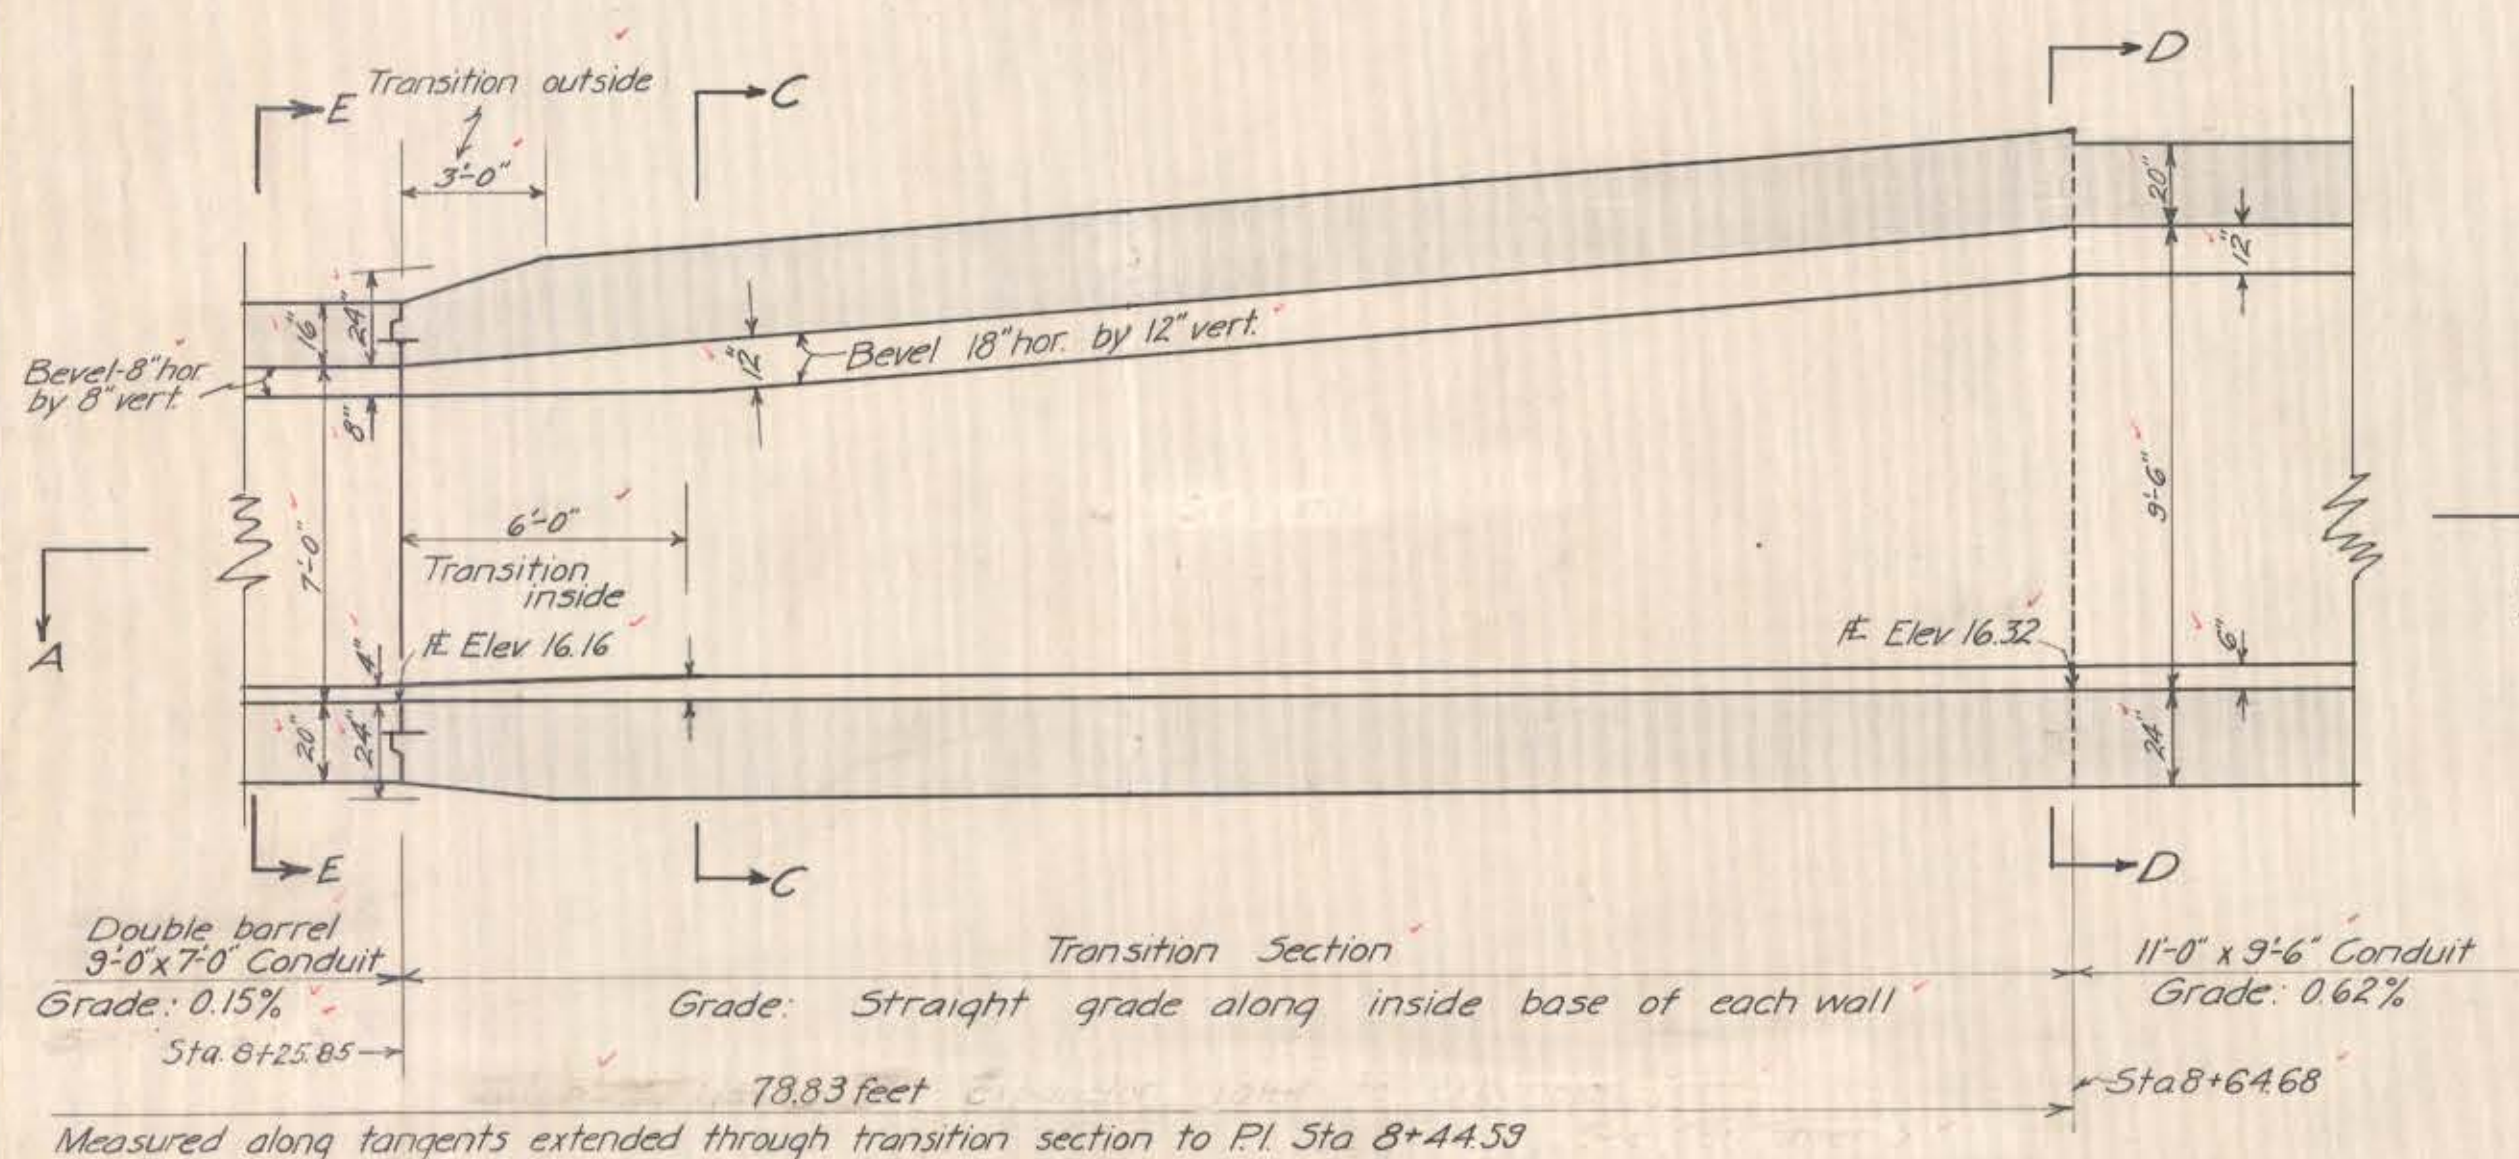

Lap longitudinal steel shown in Conduit Cross Section, sheet 3, 2'-6" with long steel shown in this transition section.

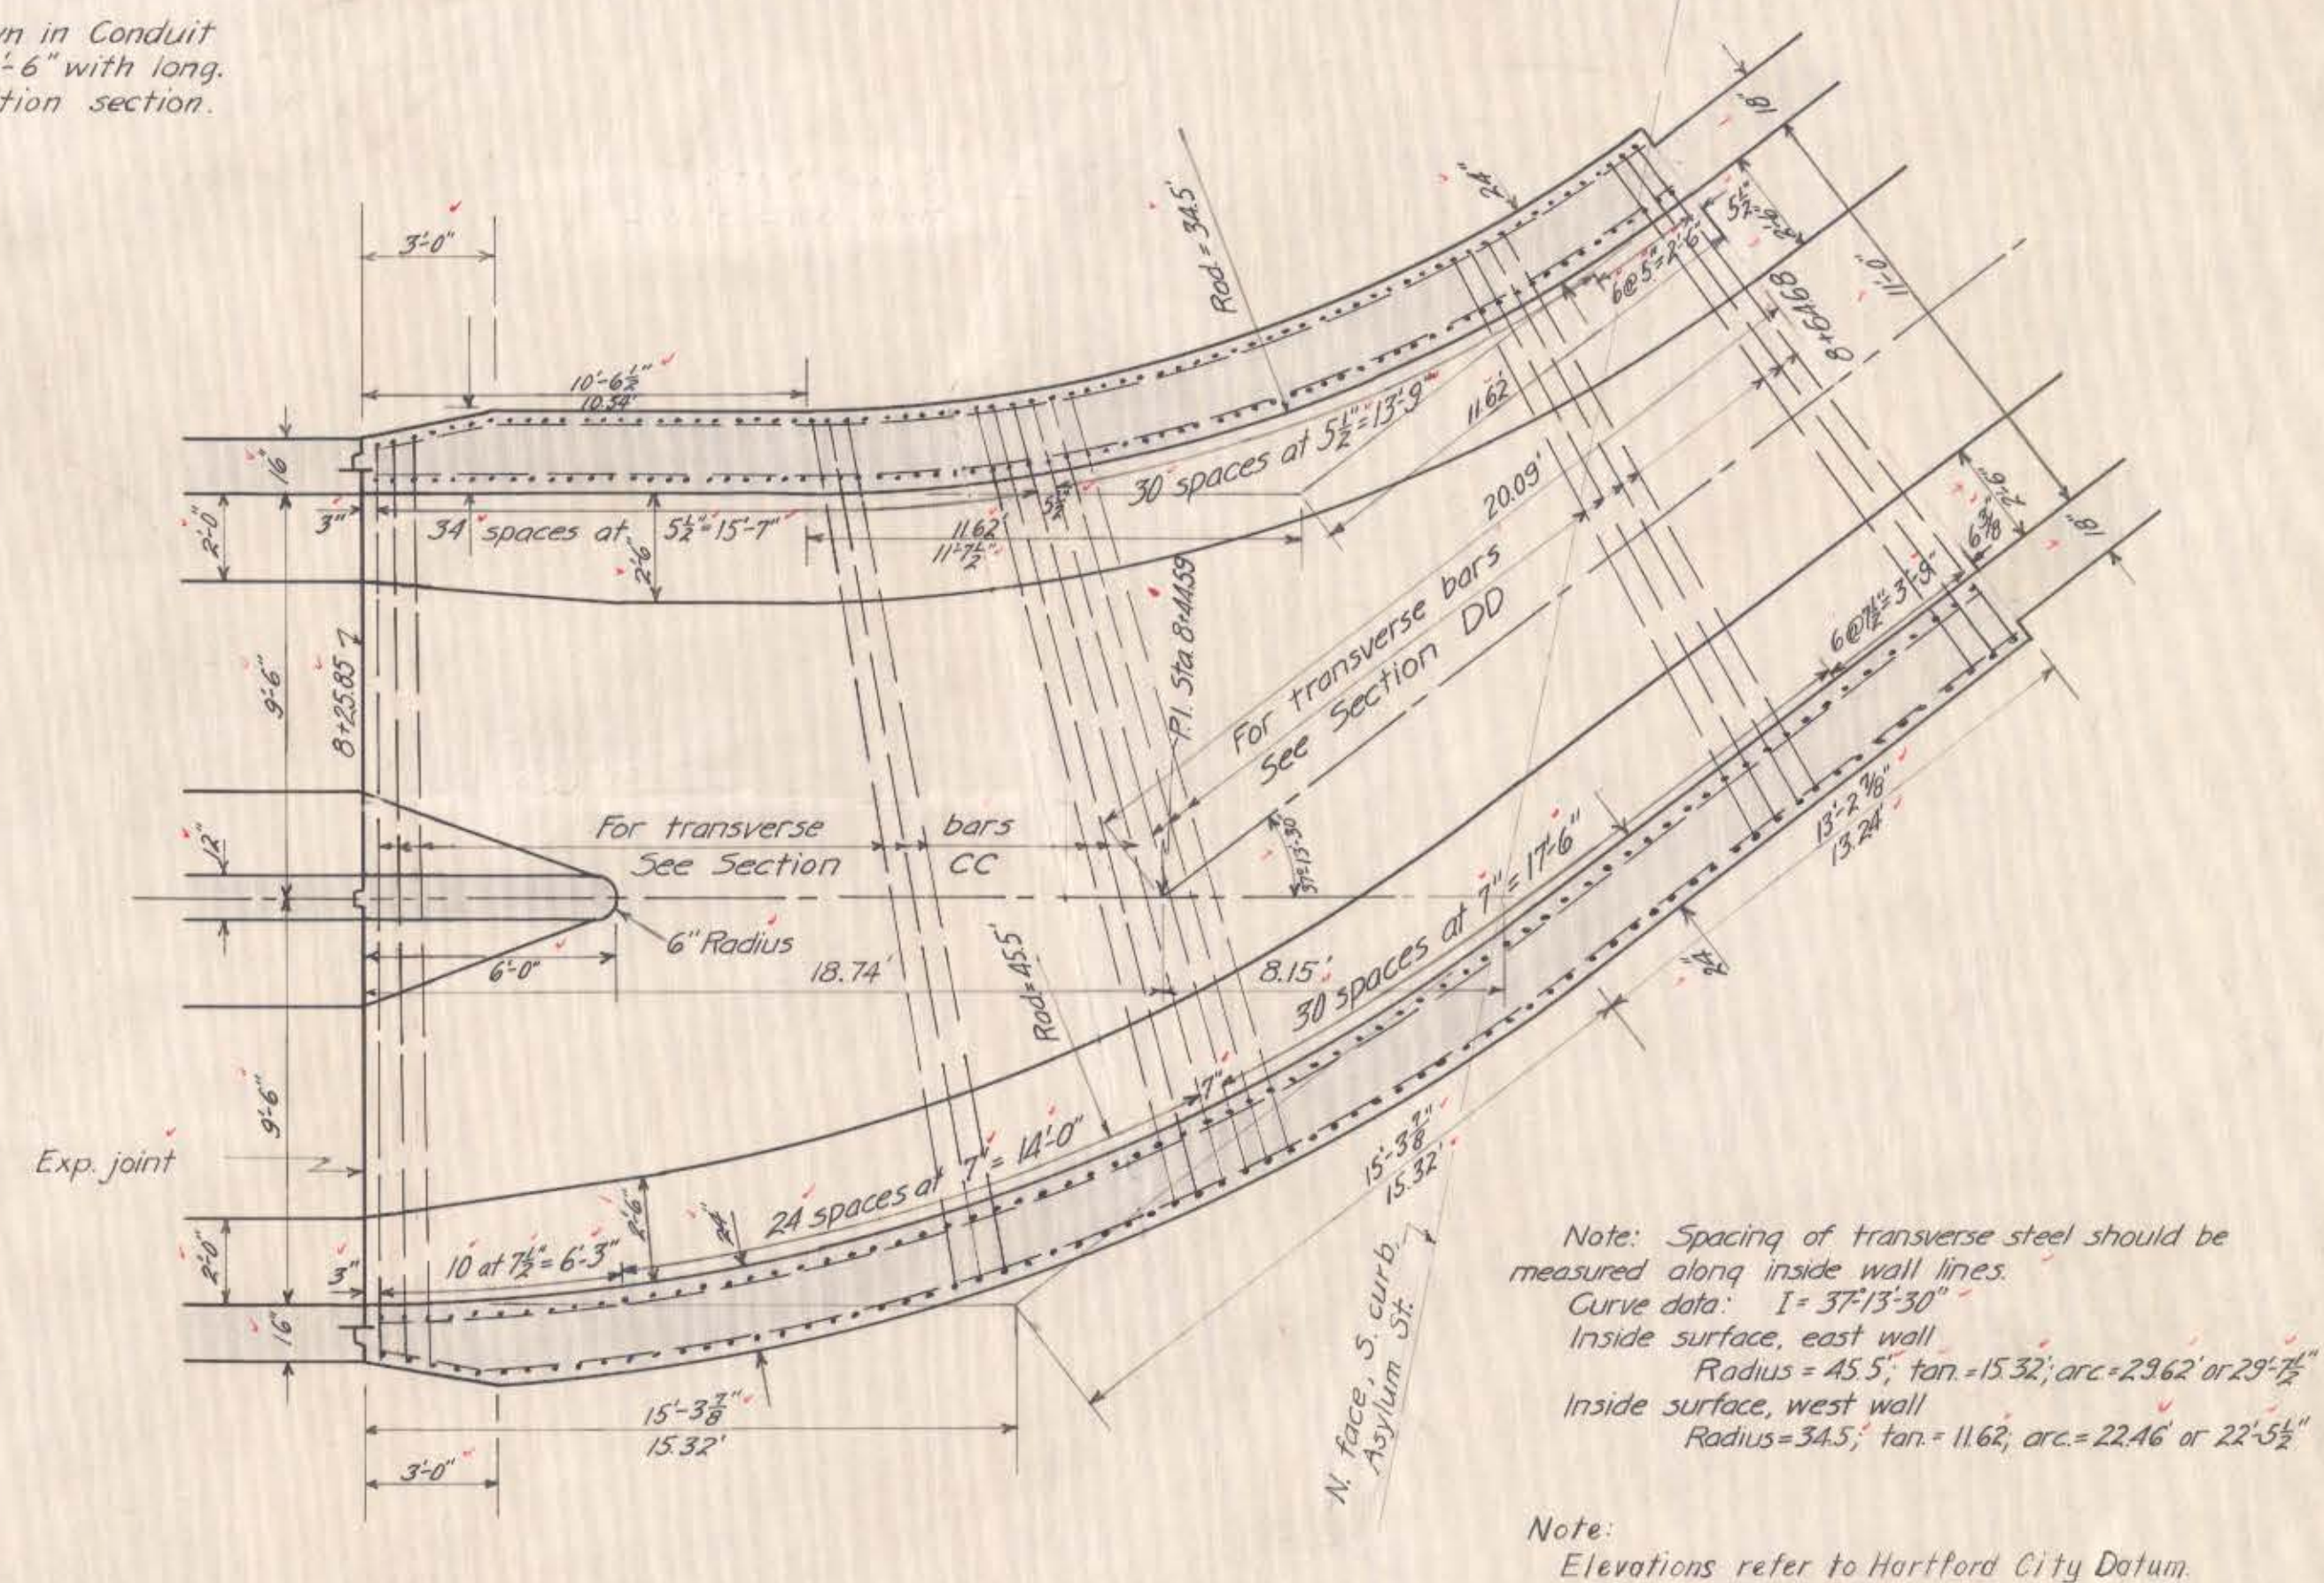

RECORD
DRAWINGS