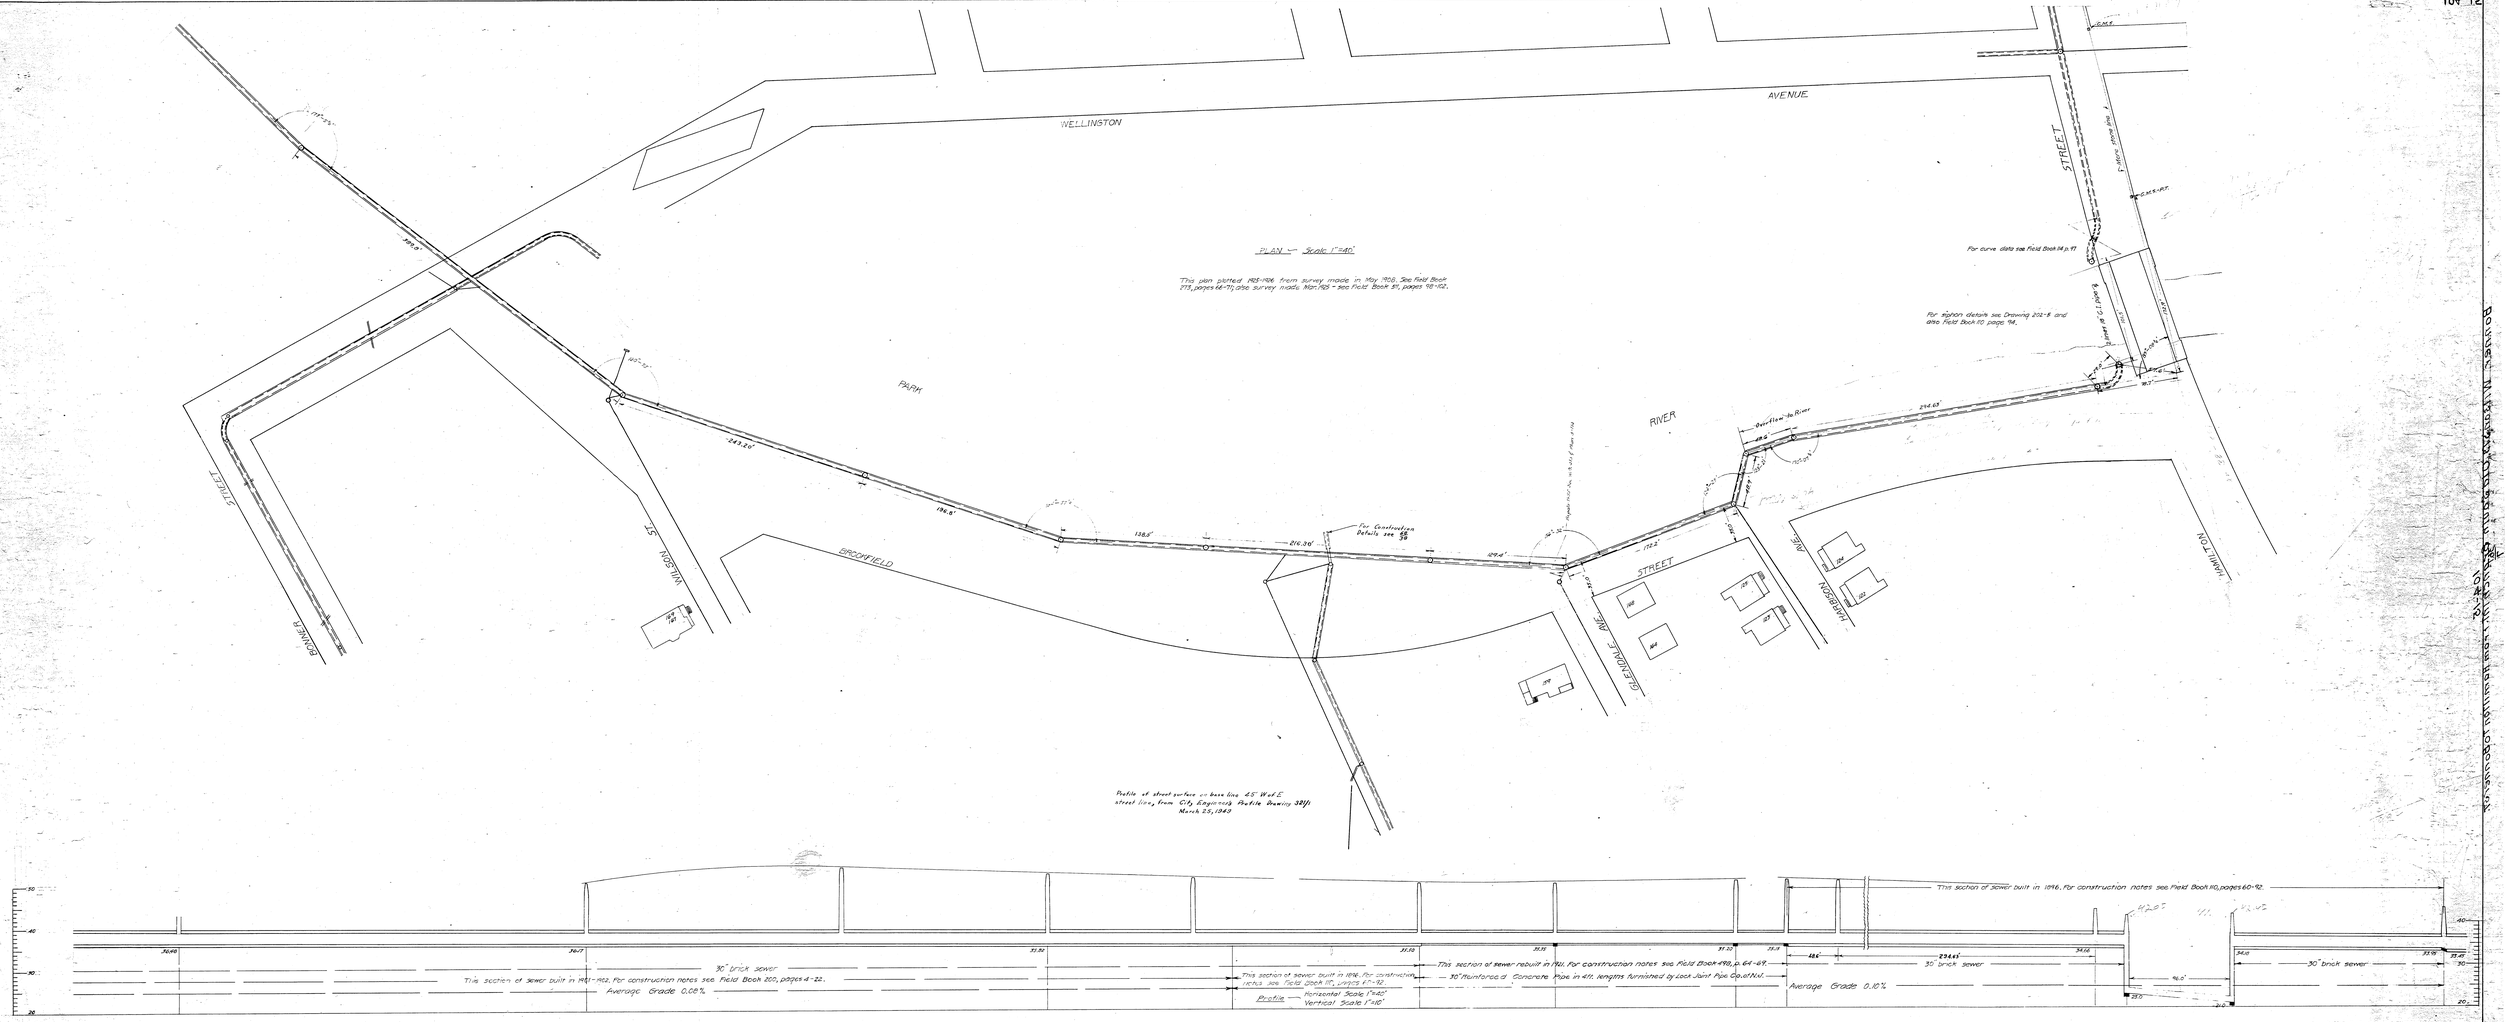

000515

Daybook No. 0[illegible]