
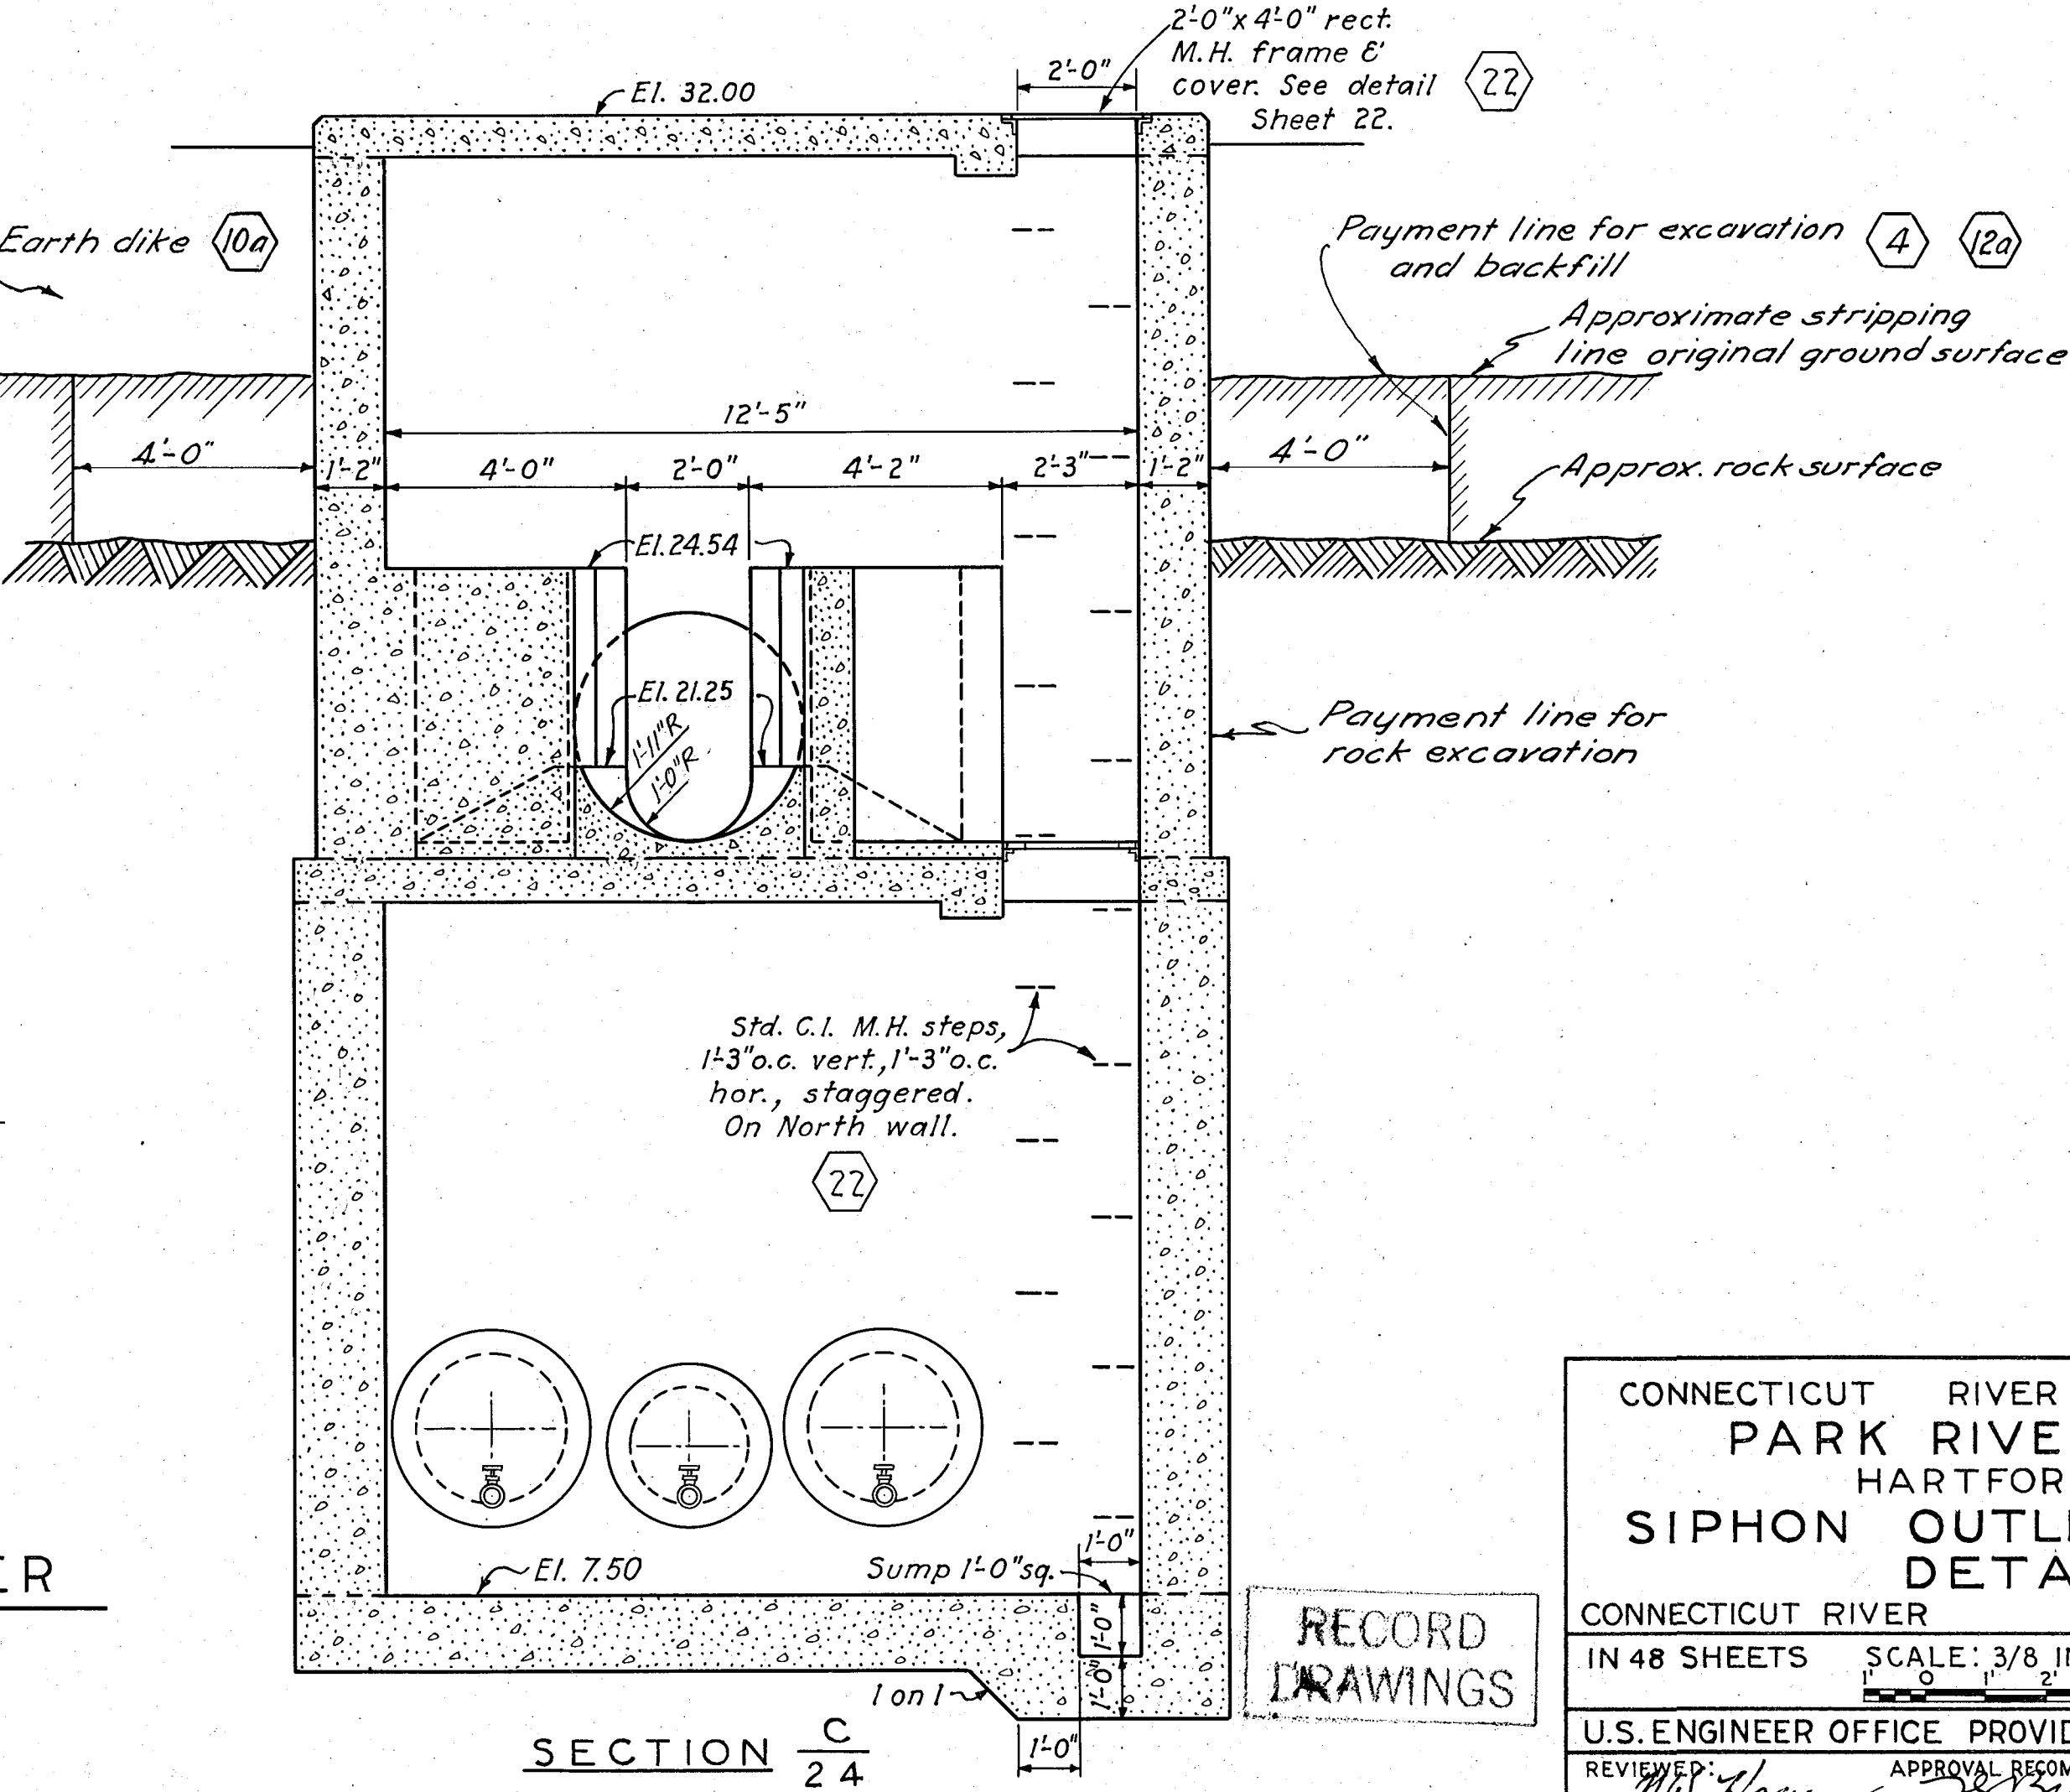
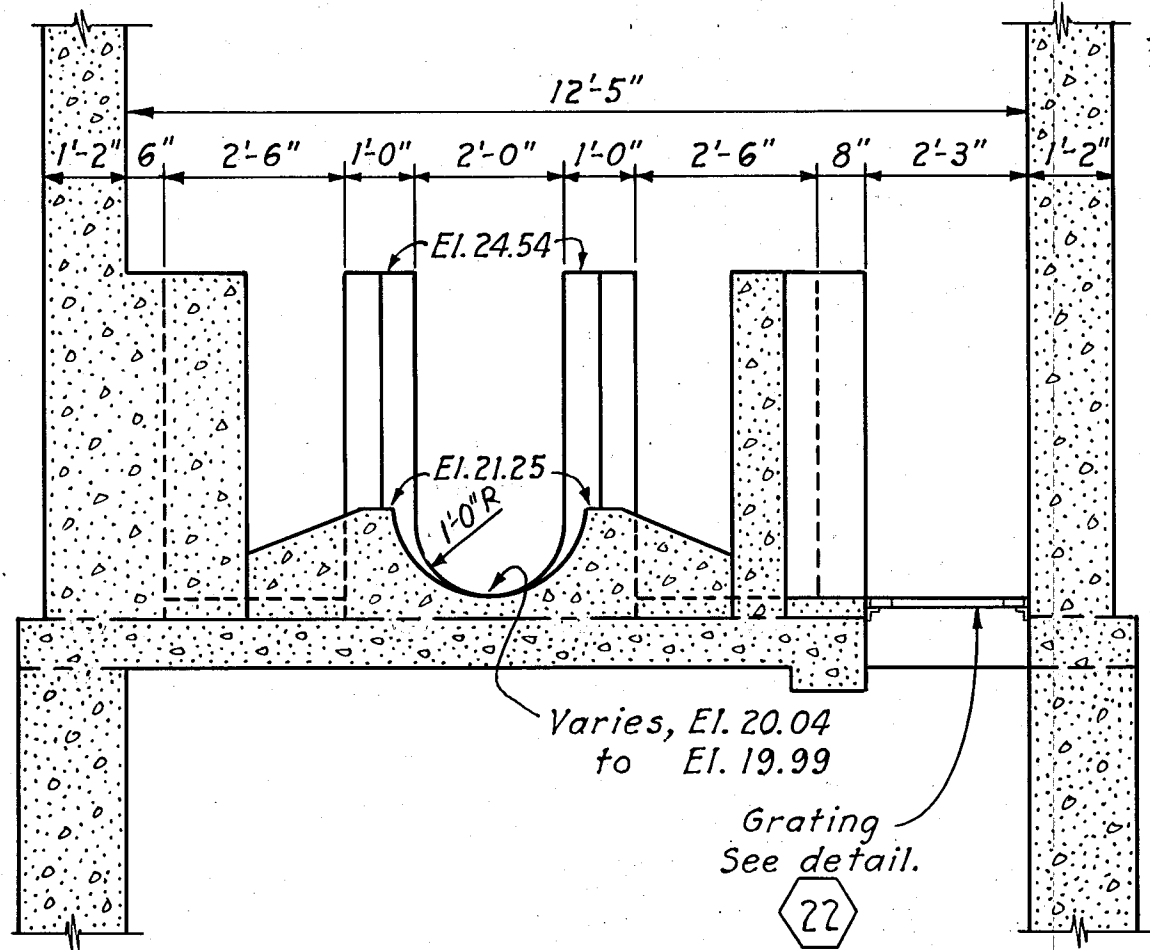
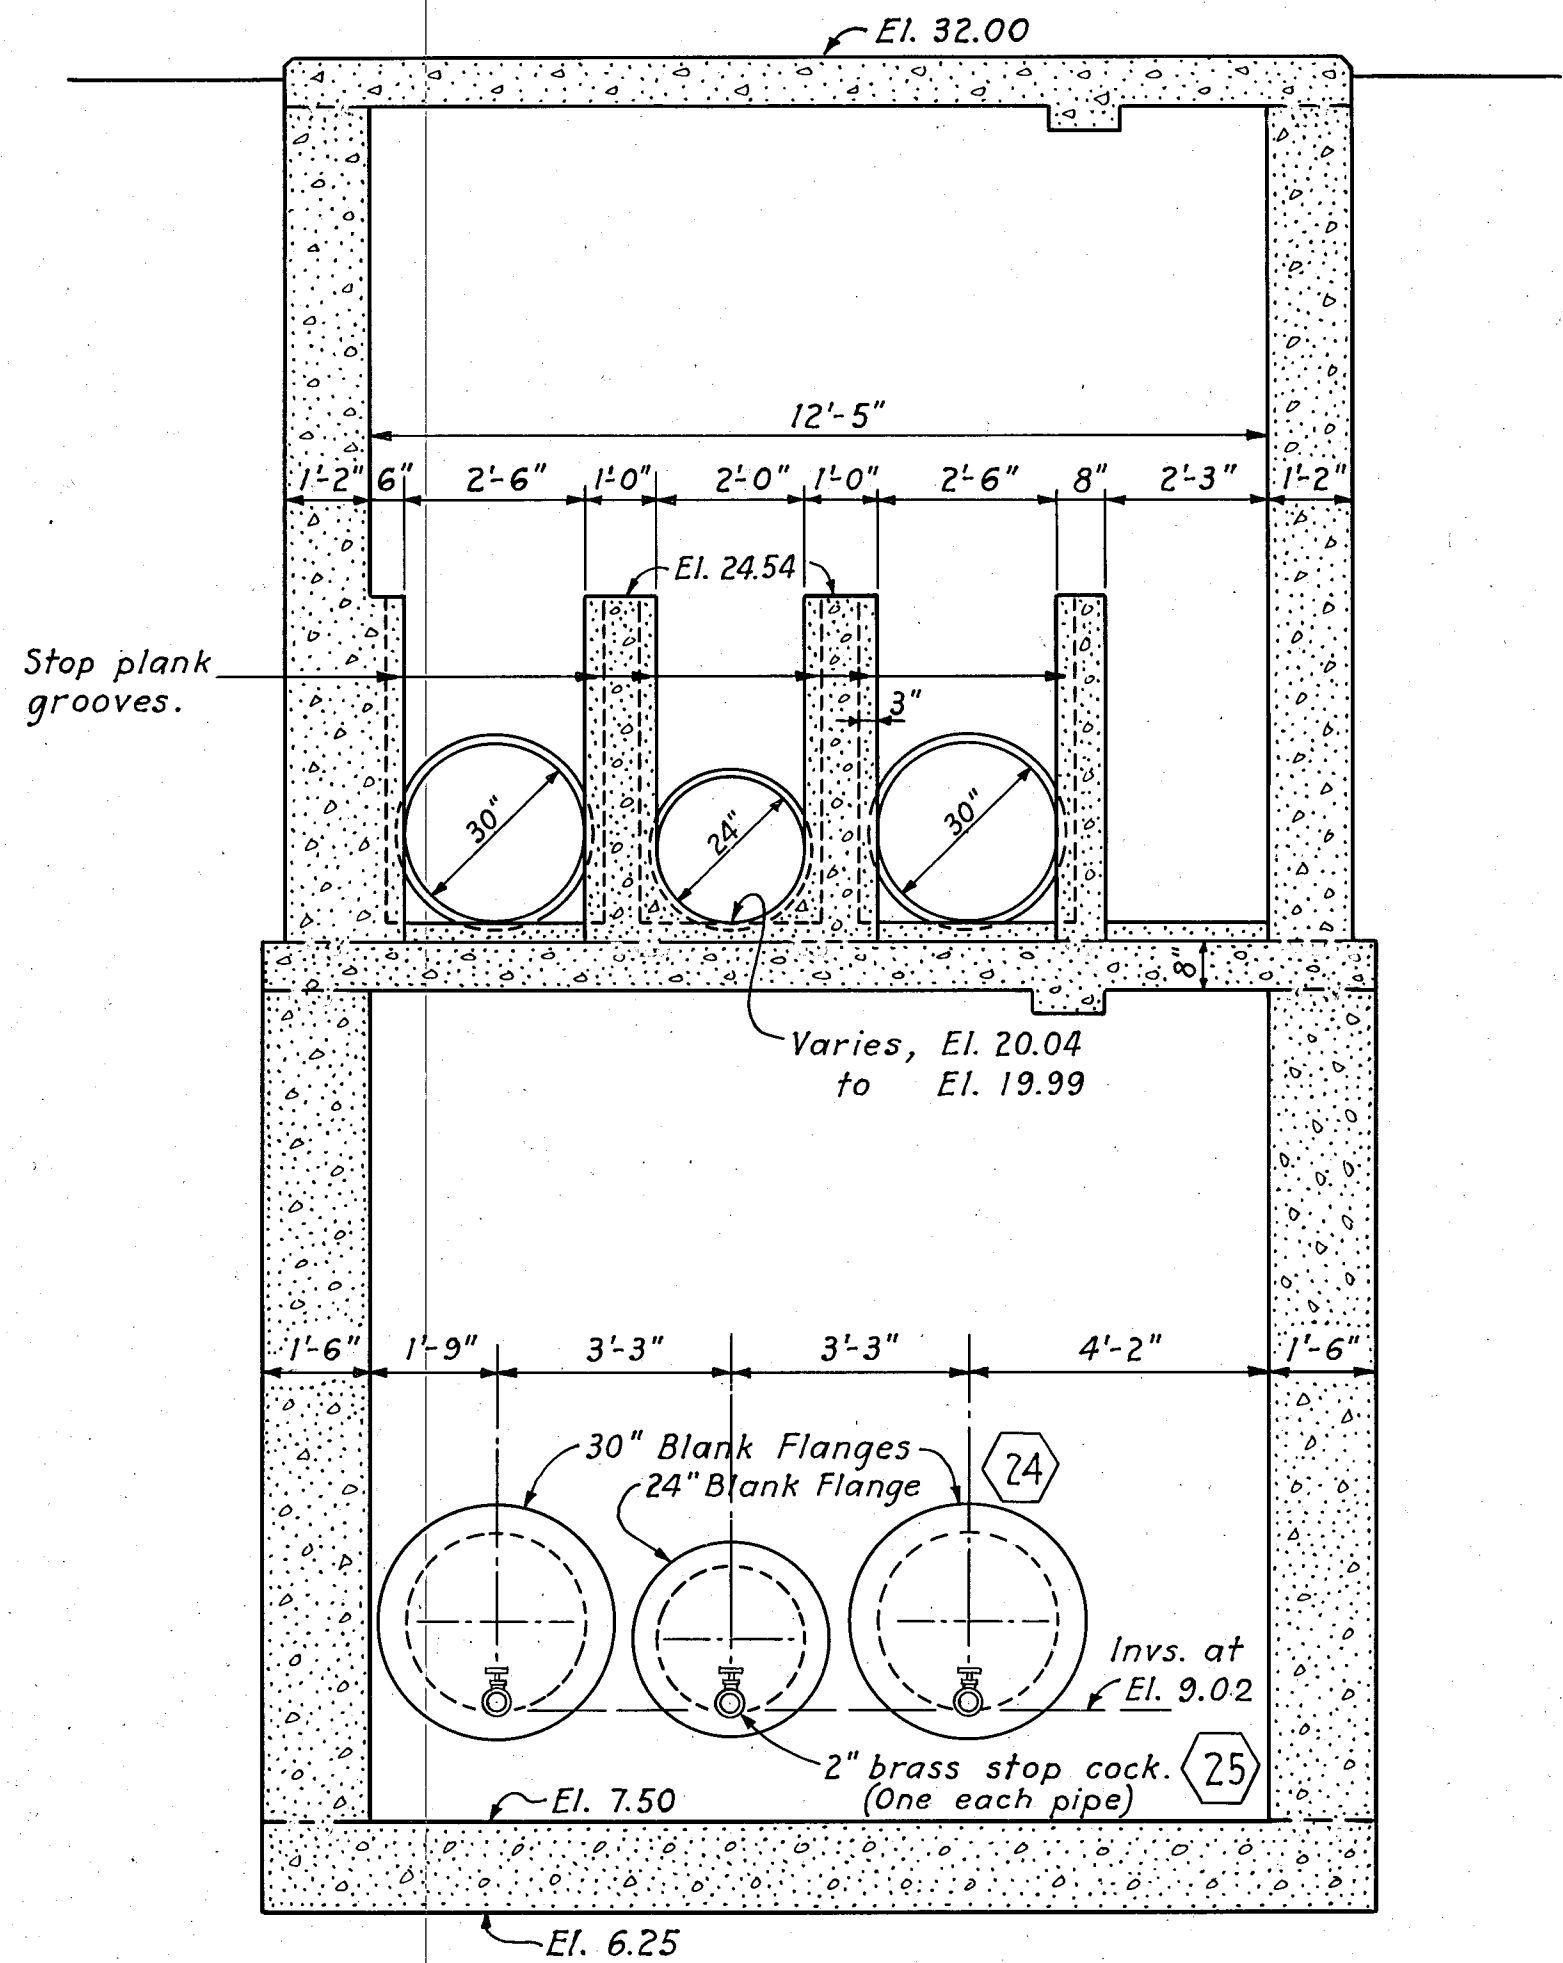
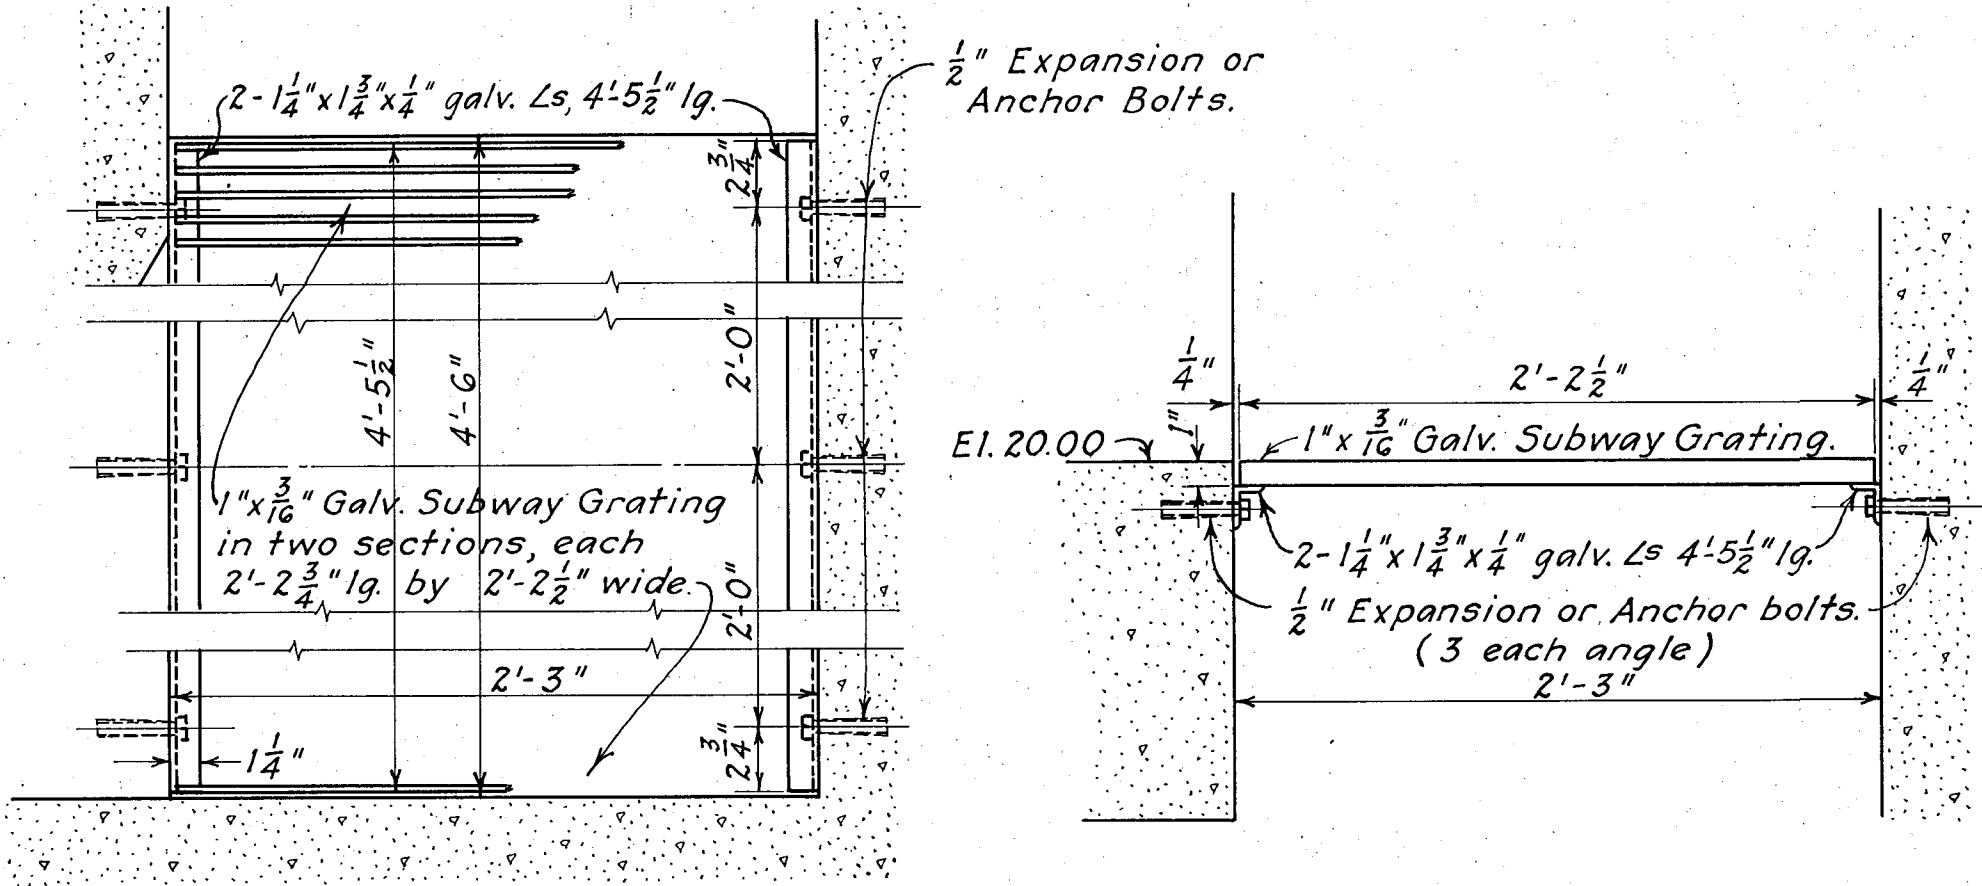
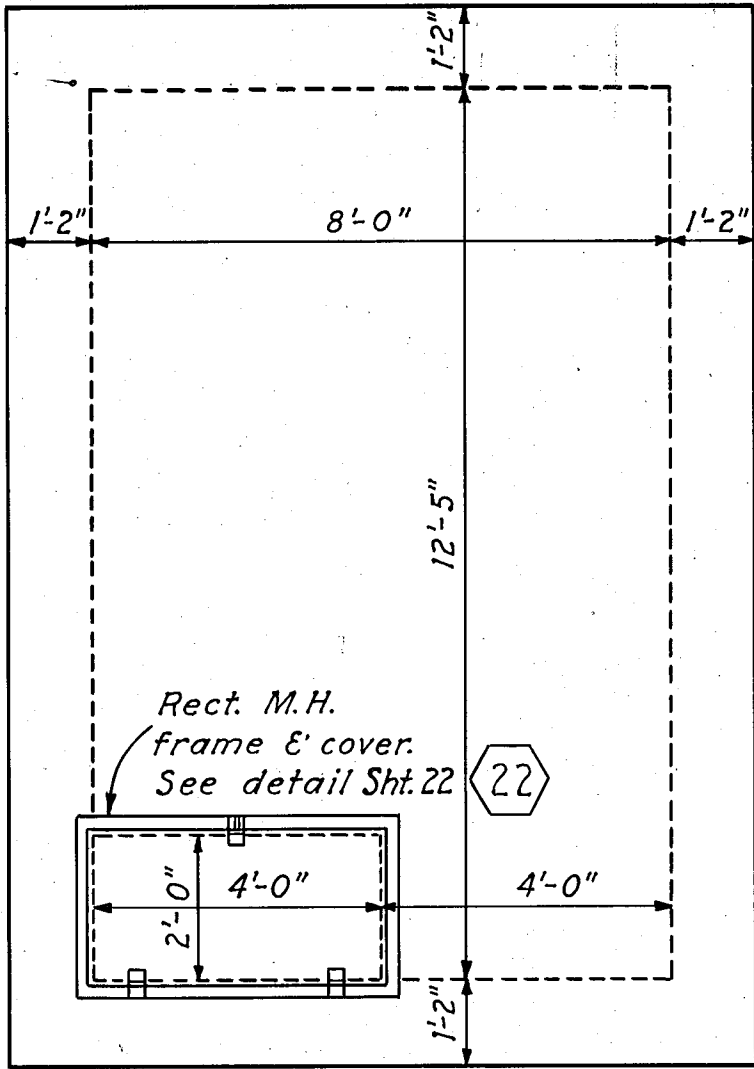


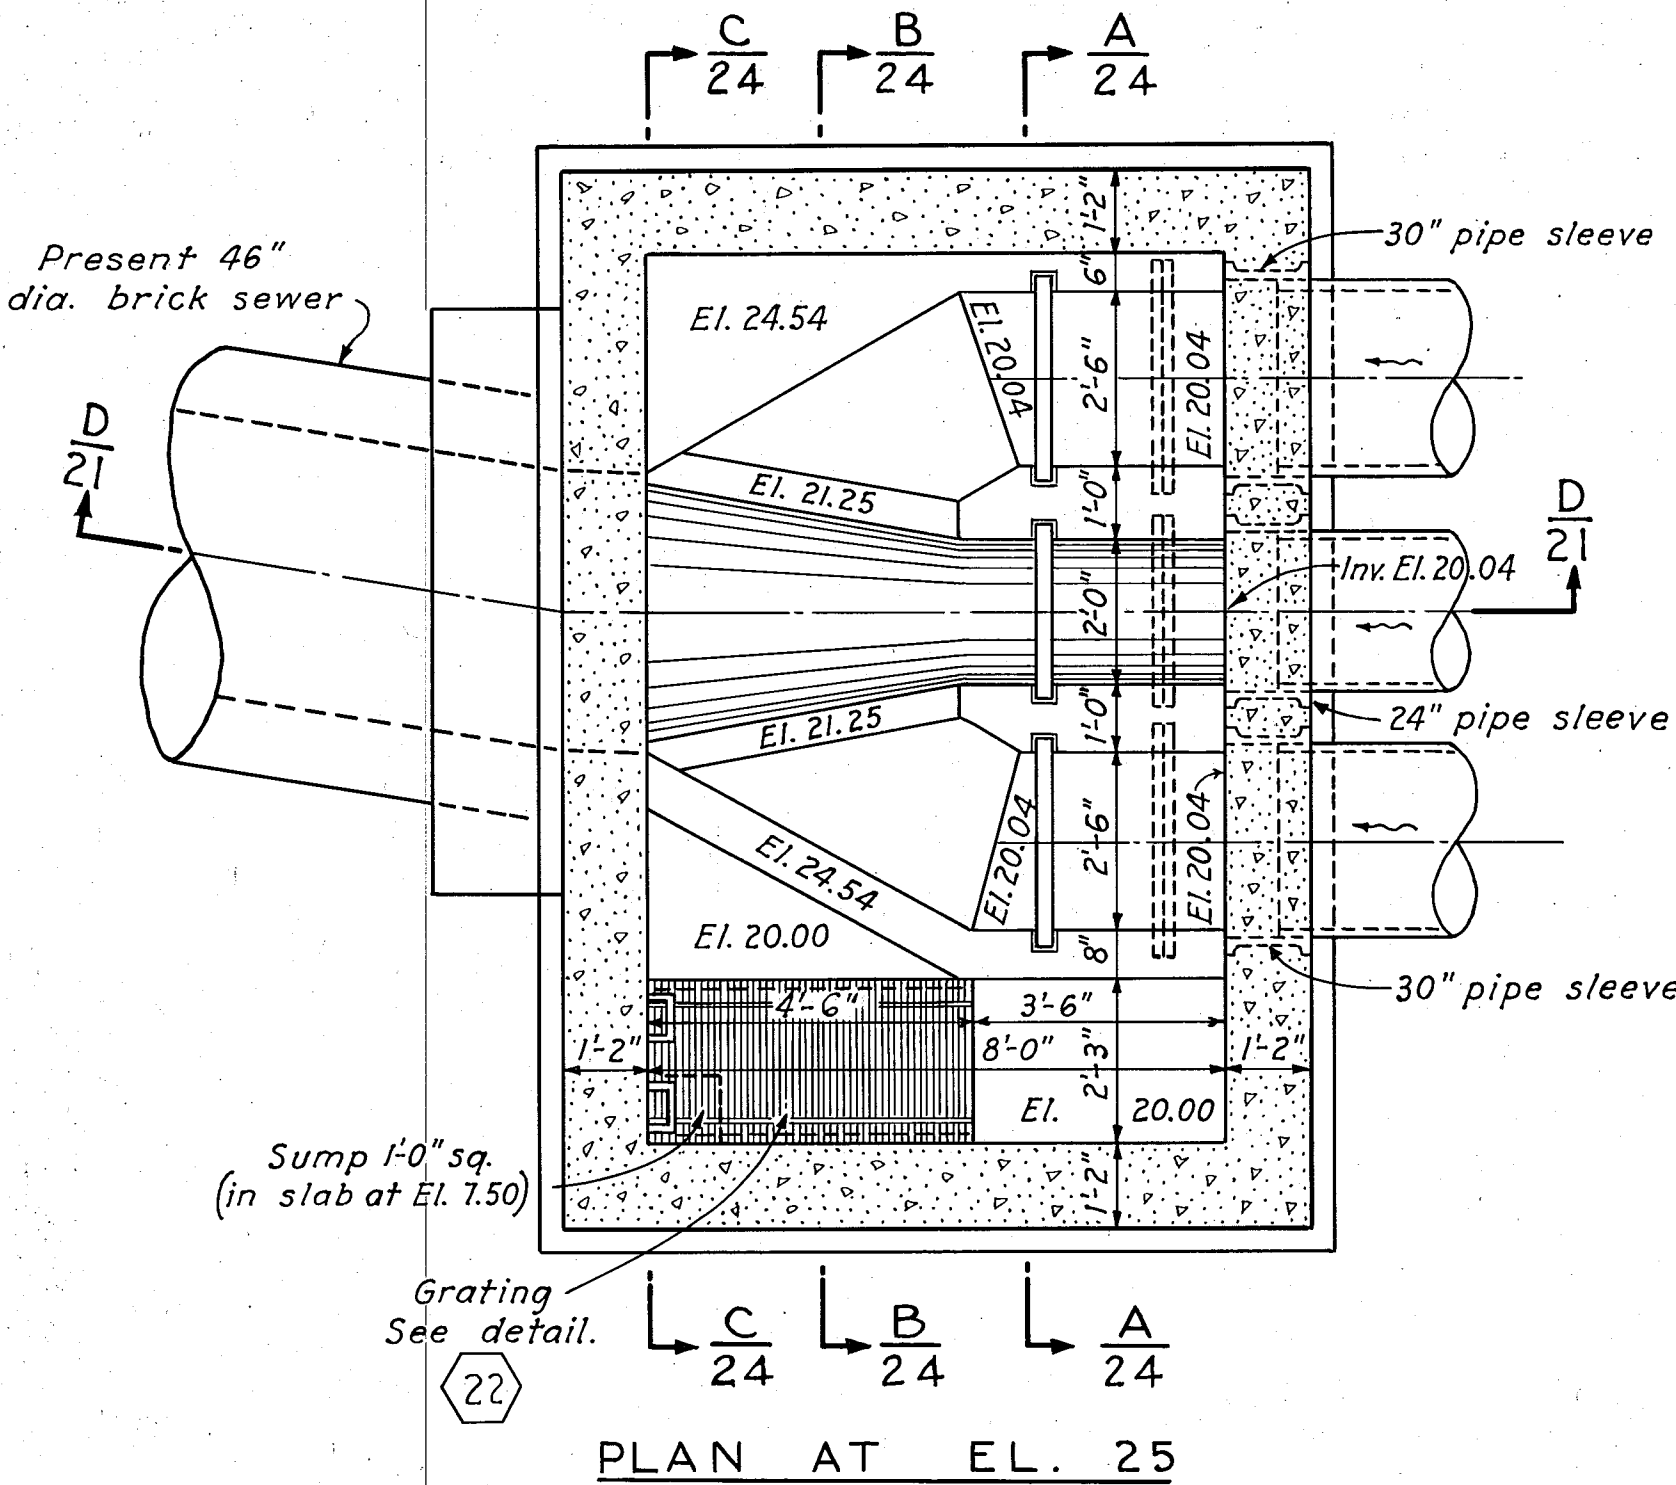

SIPHON OUTLET CHAMBER DETAILS

SCALE: 3/8" = 1'-0"

METCALF & EDDY
ENGINEERS
BOSTON, MASS.

CONNECTICUT RIVER FLOOD CONTROL
PARK RIVER CONDUIT
HARTFORD, CONN.
SIPHON OUTLET CHAMBER
DETAILS

CONNECTICUT RIVER CONNECTICUT
IN 48 SHEETS SCALE: 3/8 IN. = 1 FT. SHEET NO. 24

U.S. ENGINEER OFFICE PROVIDENCE, R.I. MAY 1940

ENGINEER PRINCIPAL ENGINEER LT. COL. CORPS OF ENGINEERS
F.C. DESIGN SECTION CHIEF F.C. ENGINEERING DIV. DISTRICT ENGINEER

METCALF & EDDY TRACED BY: H.C.T.

FILE NO. CT-4-2622