


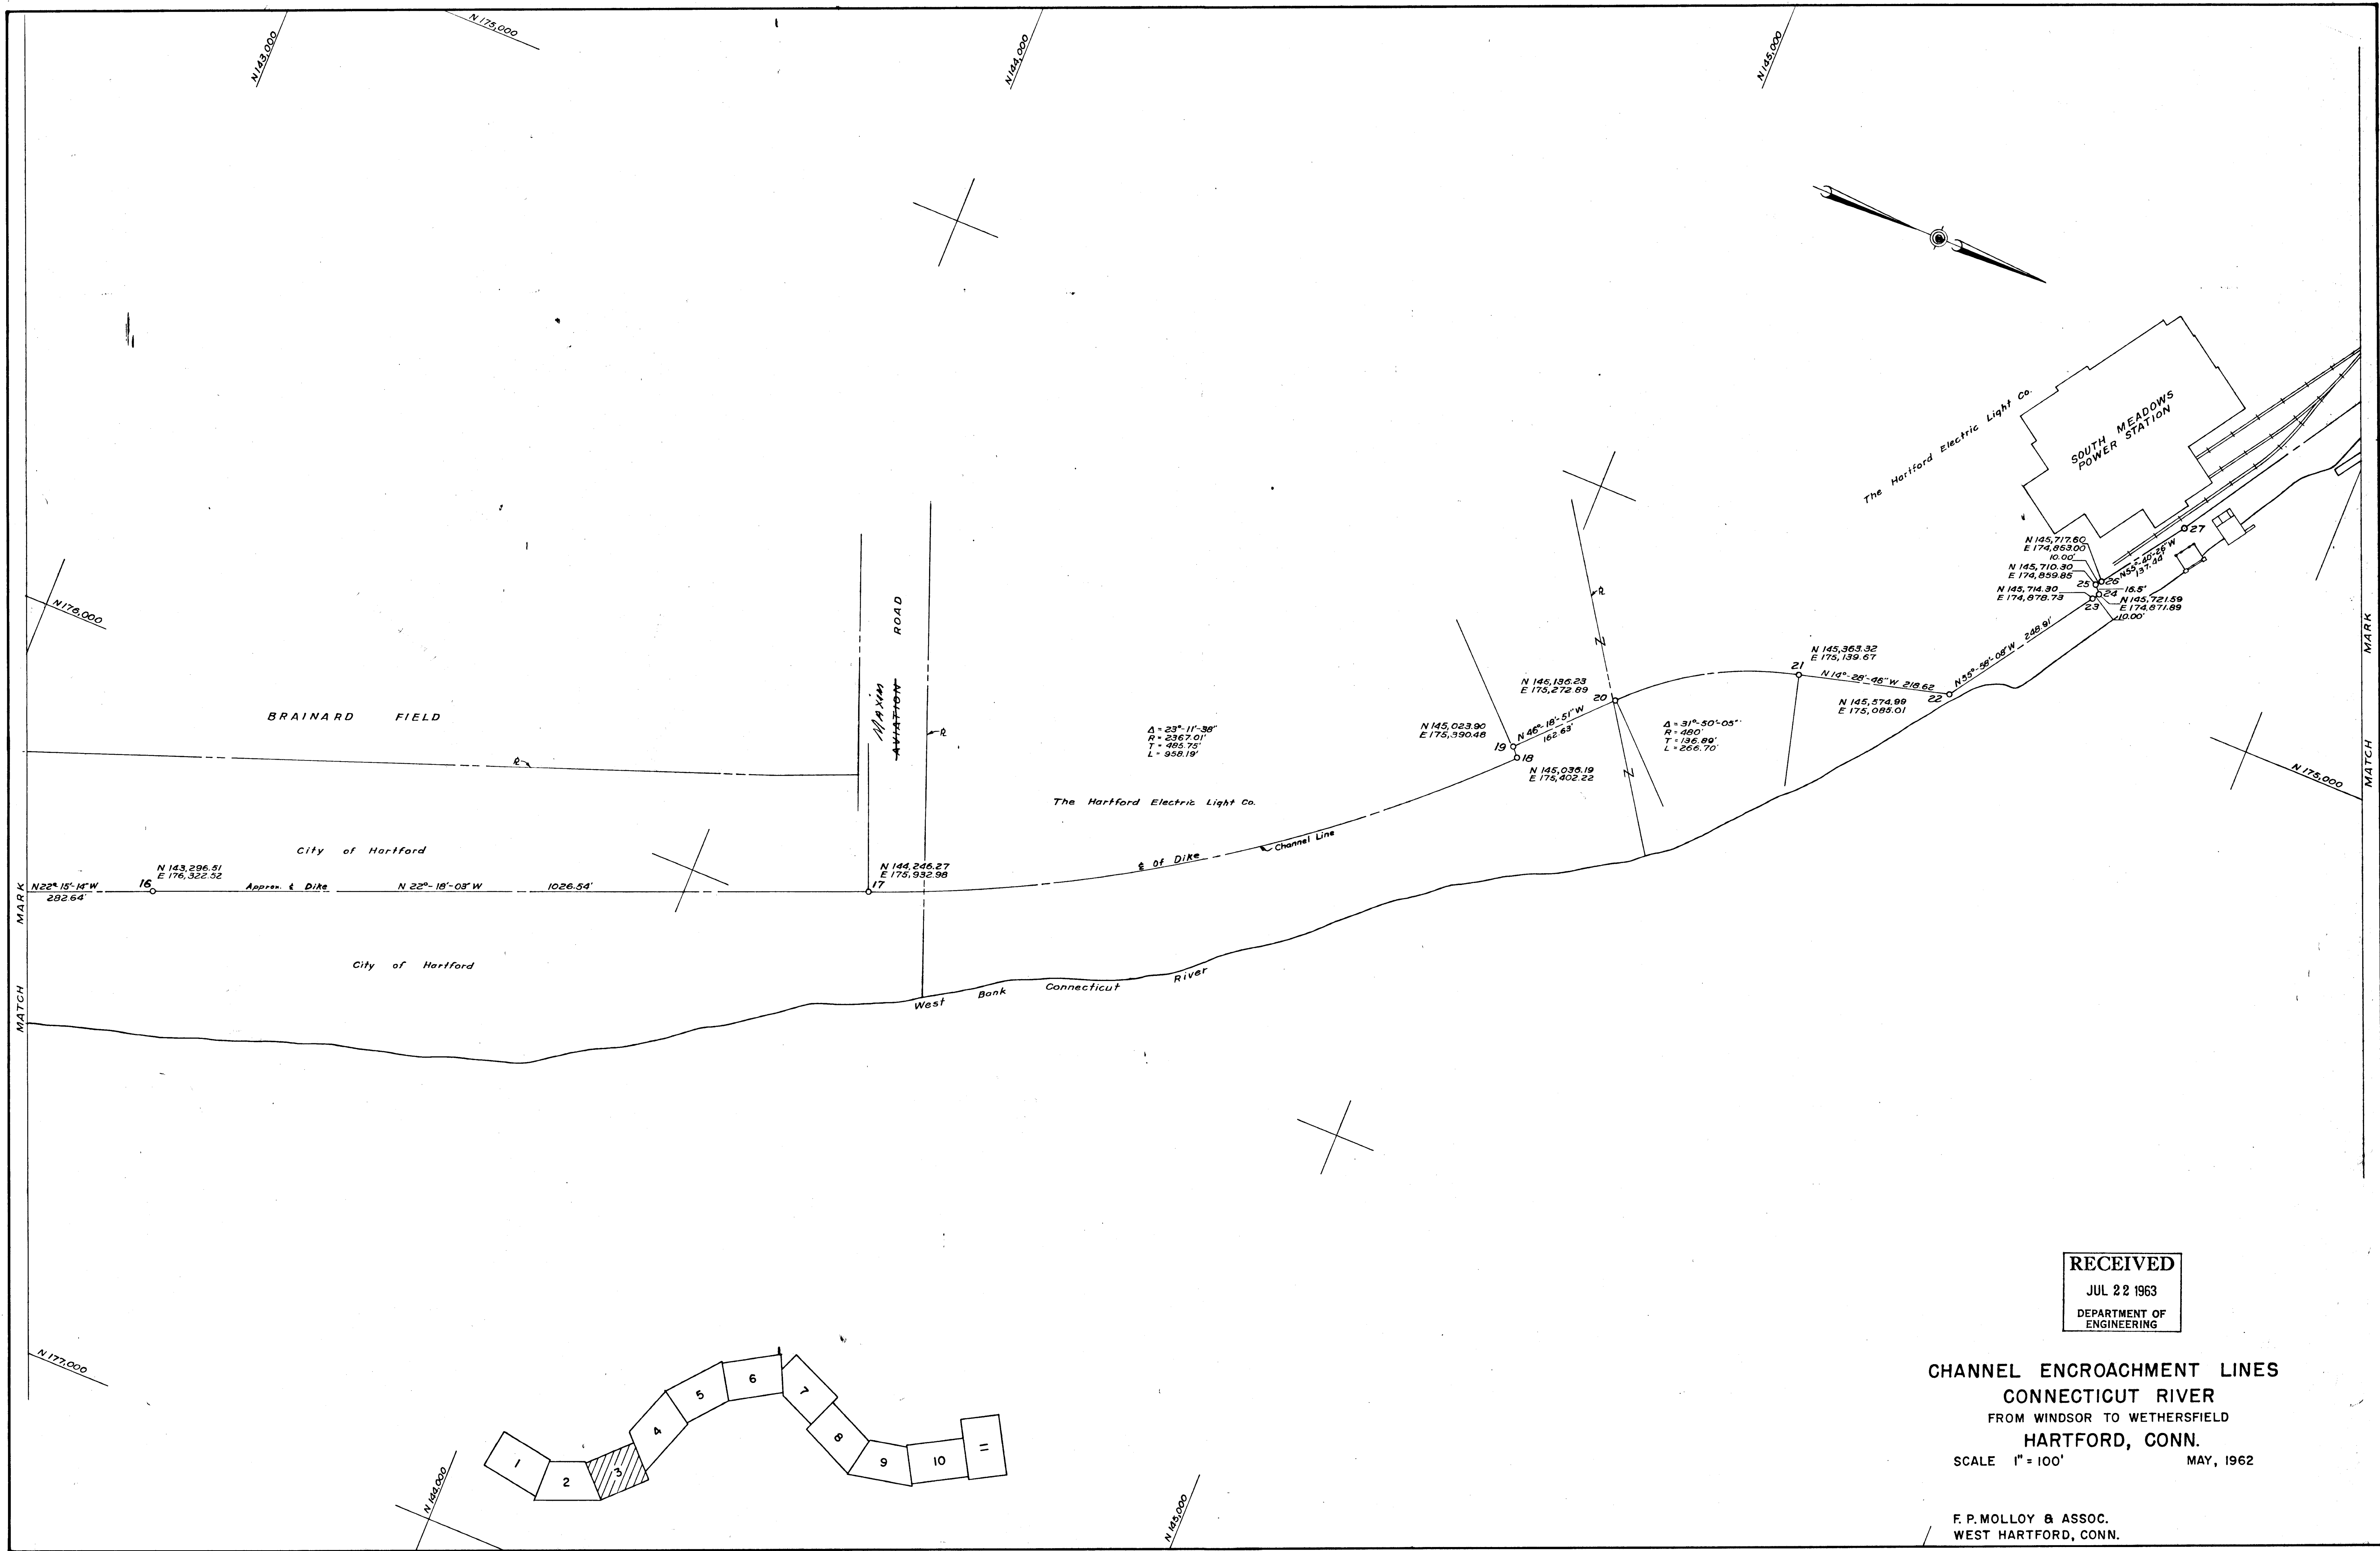

RECEIVED
JUL 22 1963
DEPARTMENT OF
ENGINEERING

CHANNEL ENCROACHMENT LINES
CONNECTICUT RIVER
FROM WINDSOR TO WETHERSFIELD
HARTFORD, CONN.
SCALE 1" = 100' MAY, 1962

F. P. MOLLOY & ASSOC.
WEST HARTFORD, CONN.