CORPS OF ENGINEERS — U. S. ARMY

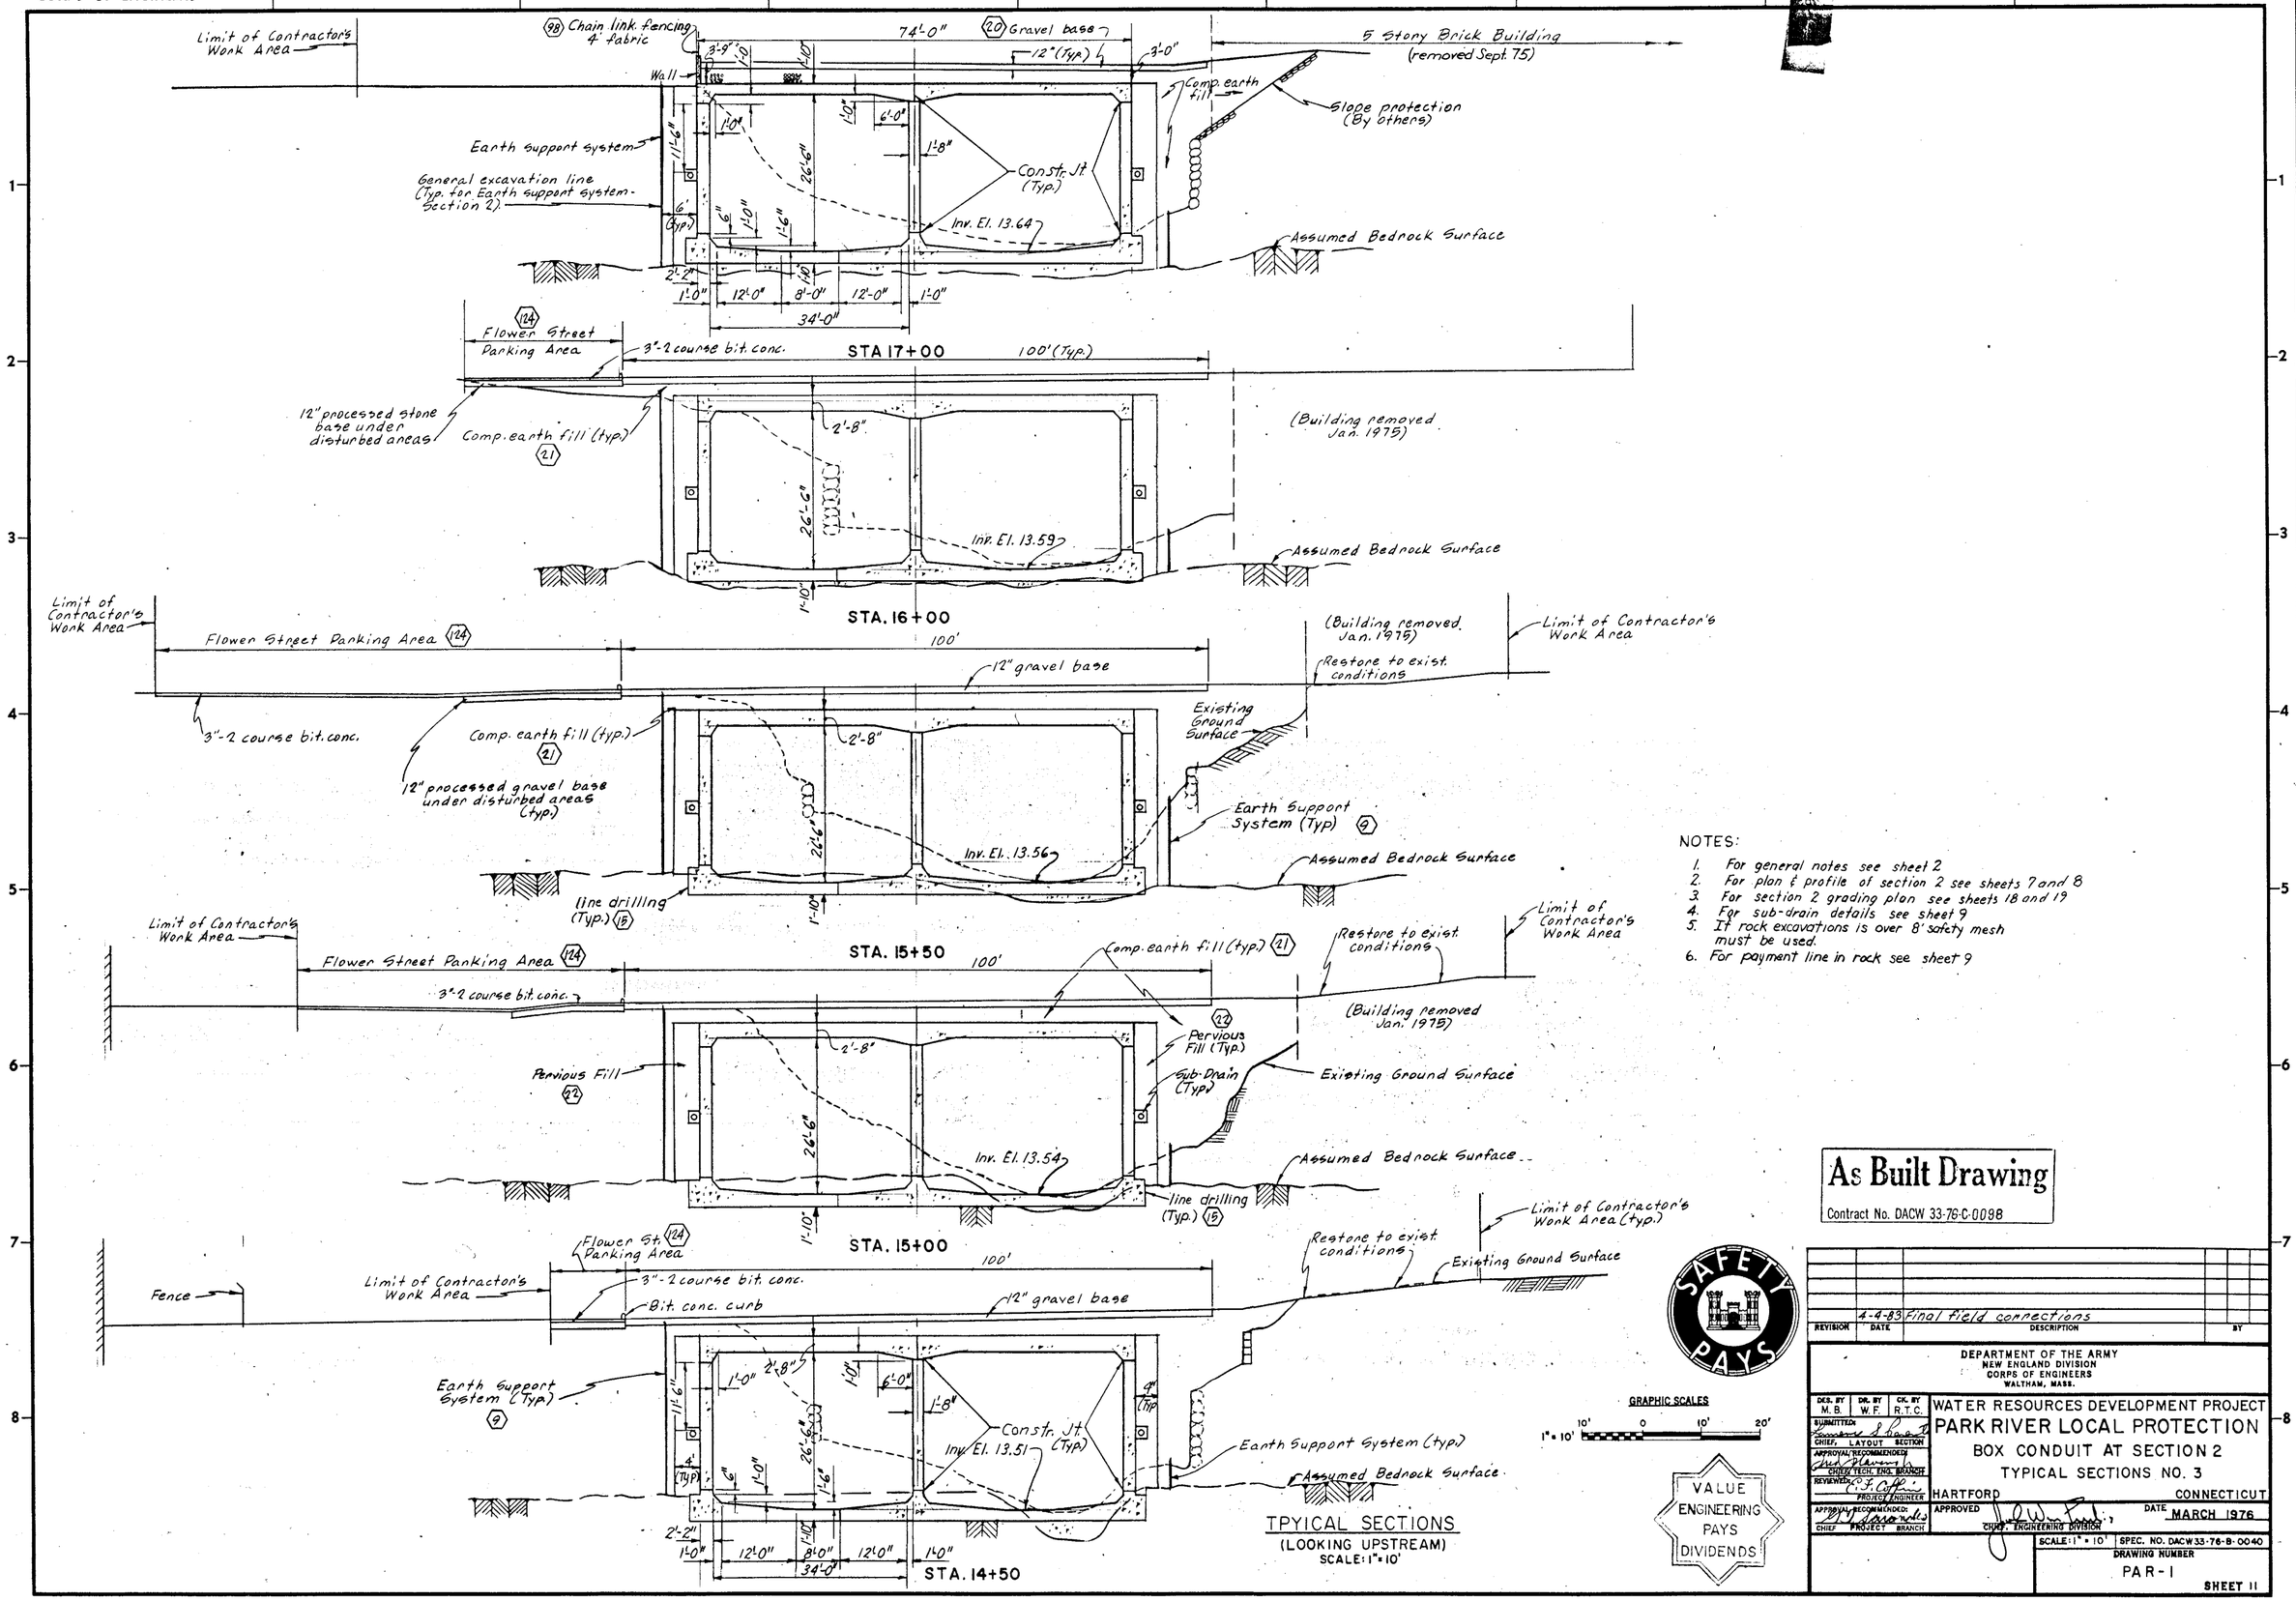


NOTES:

1. For general notes see sheet 2
2. For plan & profile of section 2 see sheets 7 and 8
3. For section 2 grading plan see sheets 18 and 19
4. For sub-drain details see sheet 9
5. If rock excavations is over 8' safety mesh must be used.
6. For payment line in rock see sheet 9

**As Built Drawing**

Contract No. DACW 33-76-C-0098

| REVISION | DATE | DESCRIPTION | BY |
|---|---|---|---|
| | 4-4-83 | Final field connections | |

DEPARTMENT OF THE ARMY
NEW ENGLAND DIVISION
CORPS OF ENGINEERS
WALTHAM, MASS.

DES. BY M.B. — DR. BY W.F. — CK. BY R.T.C.

SUBMITTED: CHIEF, LAYOUT SECTION
APPROVAL RECOMMENDED: CHIEF, TECH. ENG. BRANCH
REVIEWED: PROJECT ENGINEER
APPROVAL RECOMMENDED: CHIEF, PROJECT BRANCH
APPROVED: CHIEF, ENGINEERING DIVISION

WATER RESOURCES DEVELOPMENT PROJECT
PARK RIVER LOCAL PROTECTION
BOX CONDUIT AT SECTION 2
TYPICAL SECTIONS NO. 3

HARTFORD — CONNECTICUT

DATE MARCH 1976

SCALE: 1" = 10' — SPEC. NO. DACW33-76-B-0040

DRAWING NUMBER PAR-1

SHEET 11