



*** NOTE:**
 1. Electric lines by the Hartford Electric Light Company.
 2. Telephone lines by the Southern New England Telephone Company
 3. New street light pole bases by contractor,
 for details see Dwg. No. PAR-1, sheet 109.

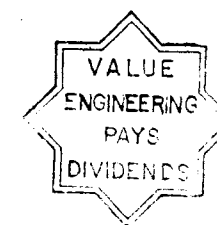

GRAPHIC SCALES

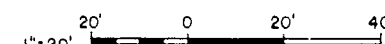

As Built Drawing

Contract No. DACW 33-76-C-0098

[illegible]