CORPS OF ENGINEERS U. S. ARMY

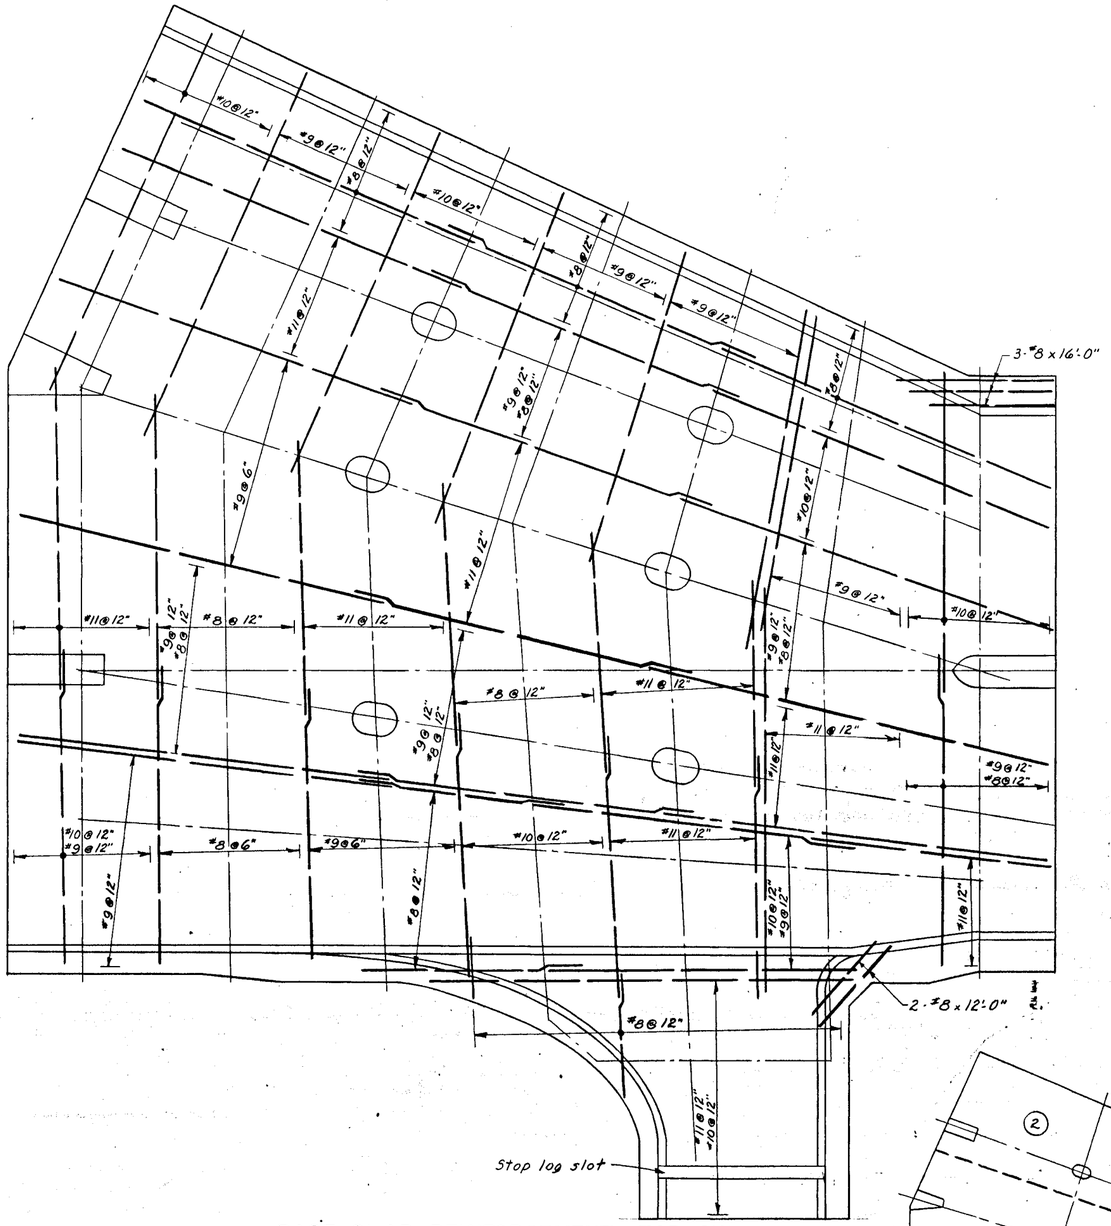

BASE SLAB REINFORCEMENT - TOP STEEL

SCALE 1/8" = 1'-0"

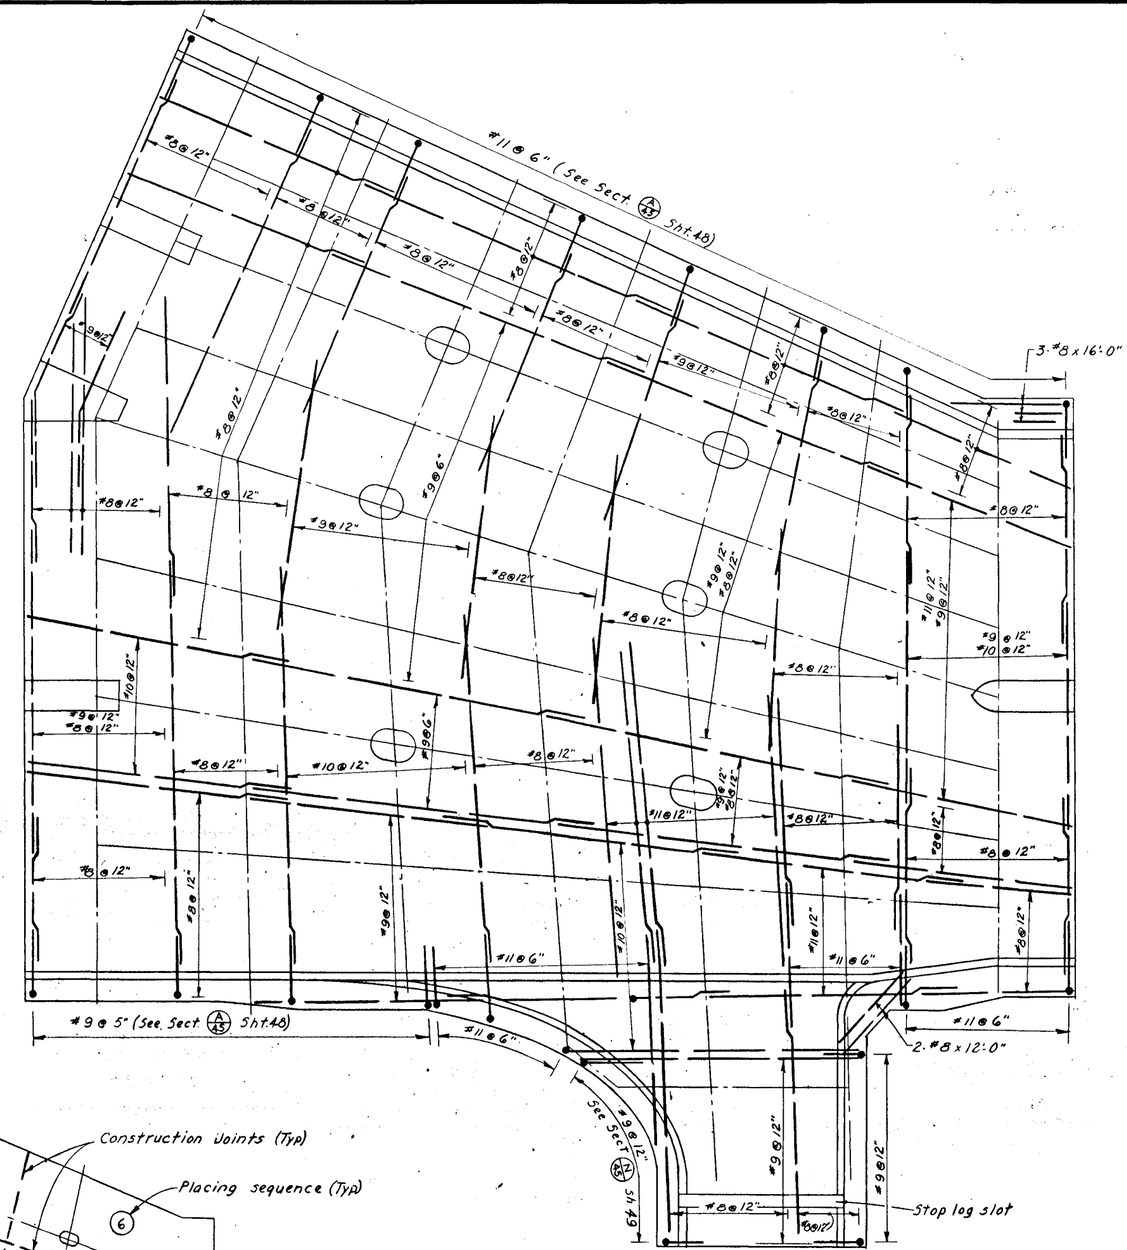

BASE SLAB REINFORCEMENT - BOTTOM STEEL

SCALE 1/8" = 1'-0"

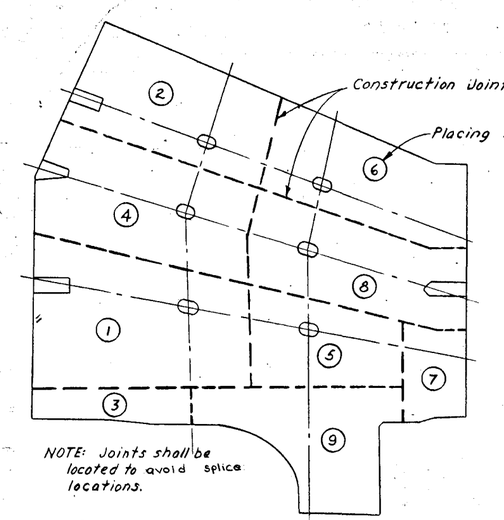

NOTE: Joints shall be located to avoid splice locations.

BASE SLAB CONSTRUCTION JOINTS AND PLACING SEQUENCE PLAN

NO SCALE

NOTES:

1. See Section A/45 Sh. 48 for wall dowels required to be placed in base slab.
2. Splices and limits of bar placing to be located at or midway between grid lines as indicated.
3. Grid lines are equally spaced between piers or between piers & walls.
4. For lengths of splices see Table, Sh. 48.
5. Spacings shown for splayed reinforcement are maximum spacings.

VALUE ENGINEERING PAYS DIVIDENDS

SAFETY PAYS

GRAPHIC SCALES

1/8" = 1'-0" 4' 0 4' 8' 12' 16' 20'

As Built Drawing

Contract No. DACW 33-76-C-0098

REVISION	DATE	DESCRIPTION	BY

DEPARTMENT OF THE ARMY
NEW ENGLAND DIVISION
CORPS OF ENGINEERS
WALTHAM, MASS.

DES. BY R.H. | DR. BY W.F. | CK. BY T.K.H.

SUBMITTED: Carney M. Terzian, CHIEF, STRUCT. SECTION

APPROVAL RECOMMENDED: CHIEF, TECH. ENG. BRANCH

REVIEWED: PROJECT ENGINEER

APPROVAL RECOMMENDED: CHIEF PROJECT BRANCH

WATER RESOURCES DEVELOPMENT PROJECT

PARK RIVER LOCAL PROTECTION

JUNCTION STRUCTURE
REINFORCEMENT DETAILS NO. 1

HARTFORD CONNECTICUT

APPROVED: CHIEF, ENGINEERING DIVISION DATE MARCH 1976

SCALE AS SHOWN | SPEC. NO. DACW 33-76-B-0040

DRAWING NUMBER PAR-1

SHEET 46