




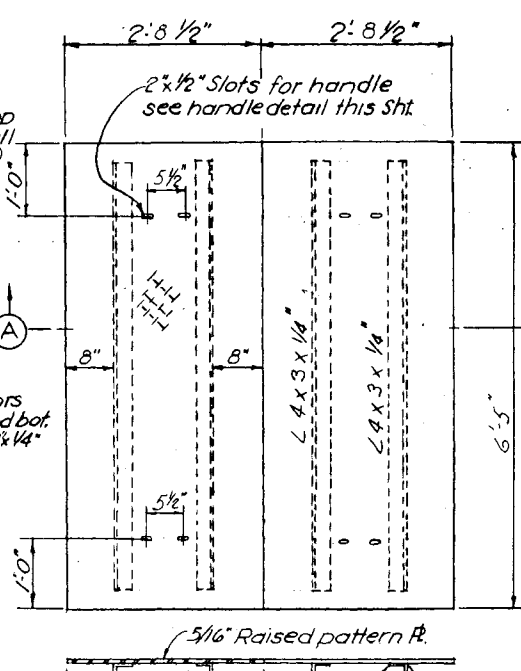


SECTION A-A
COVER FOR FRAME- E

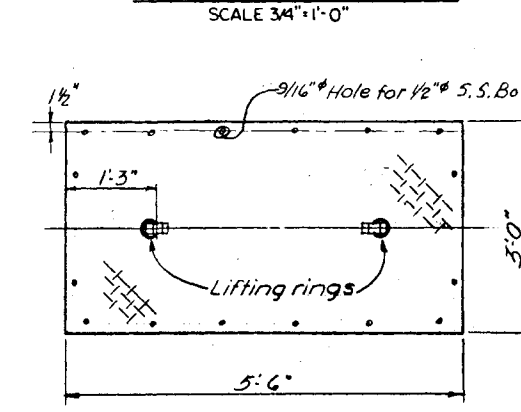


COVER F-2
SCALE 3/4"=1'-0"

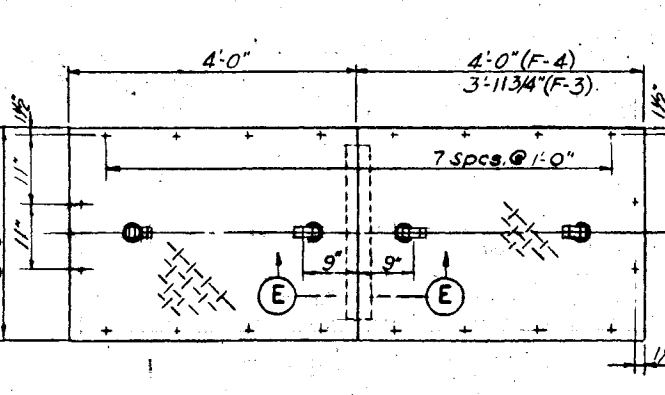


COVER F-3-F-4
SCALE 3/4" = 1'-0"

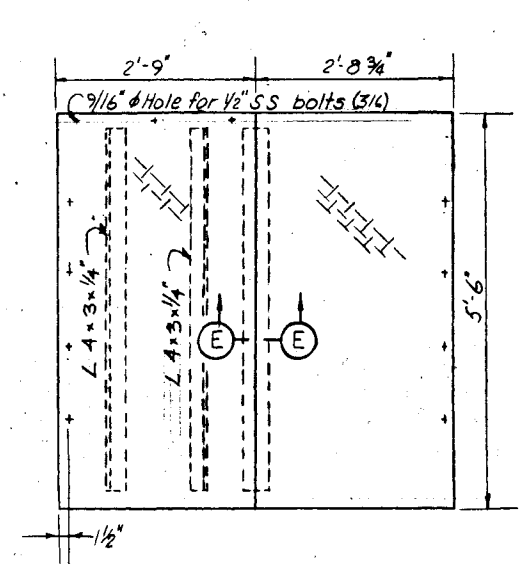


COVER F-5
SCALE 3/4" = 1'-0"

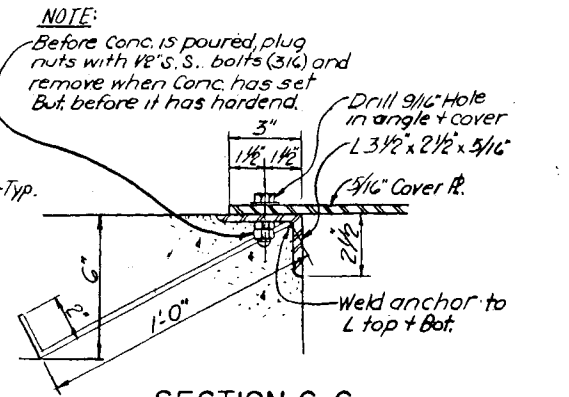


SECTION C-C
SCALE 3" = 1'-0"

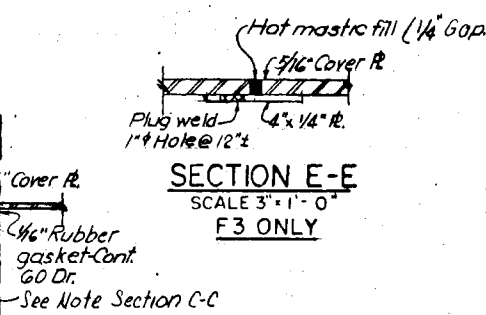


SECTION E-E
SCALE 3" = 1' - 0"

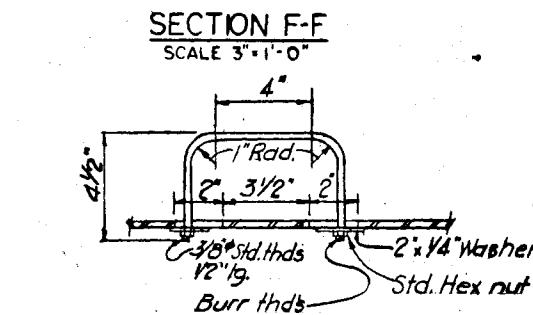


HANDLE FOR COVERS
SCALE 3" = 1'-0"

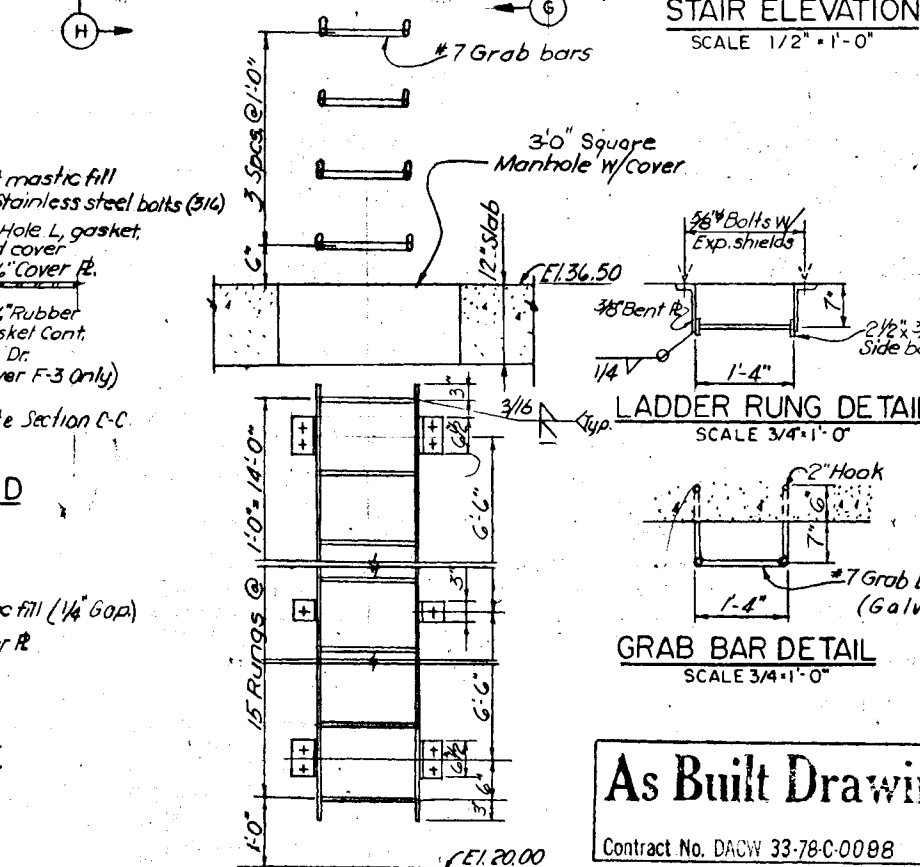

LADDER RUNG DETAIL
SCALE 3/4" = 1'-0"

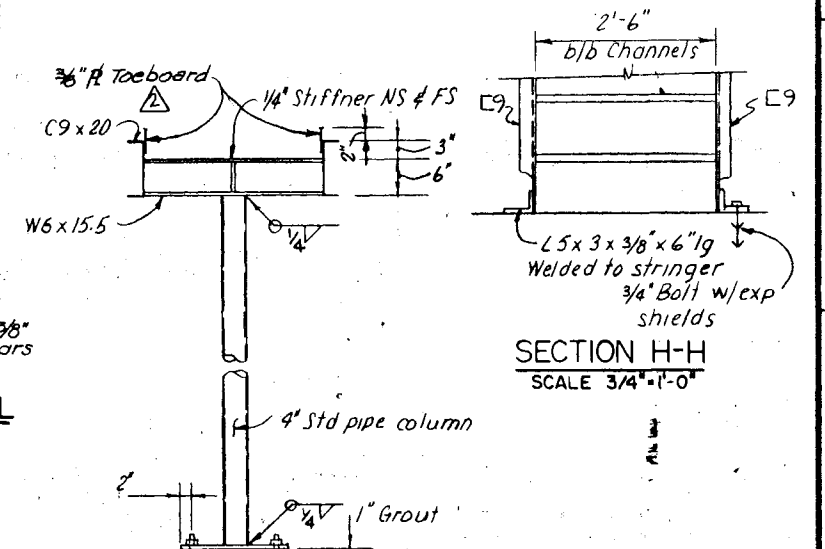


SECTION H-H
SCALE 3/4" = 1'-0"

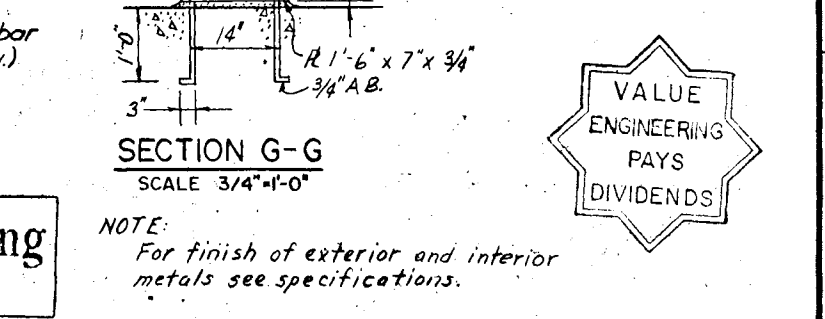


SECTION G-G
SCALE 3/4"=1'-0"

NOTE:
For finish of exterior and interior
metals see specifications.

Contract No. DACW 33-78-C-0098

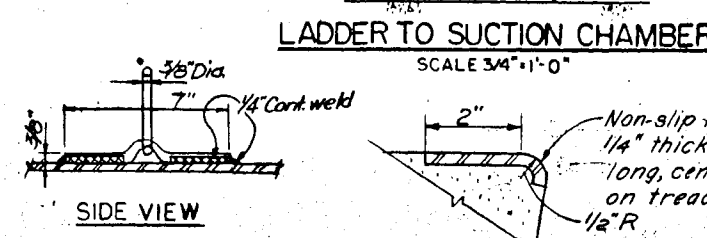


LADDER TO SUCTION CHAMBER

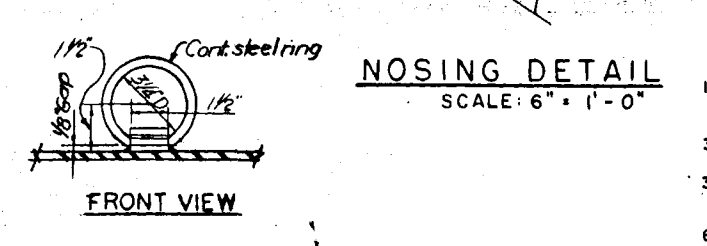


NOSING DETAIL
SCALE: 6" = 1'-0"



GRAPHIC SCALES

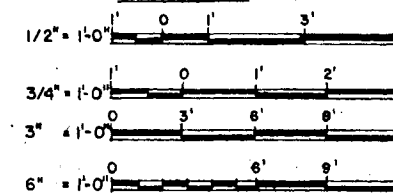

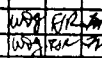5-12-78			Toeboards added @ landing		
12-27-77			REVISED RAILING HEIGHT		
REVISION	DATE	DESCRIPTION			
					
DEPARTMENT OF THE ARMY NEW ENGLAND DIVISION CORPS OF ENGINEERS WALTHAM, MAEE					
DES. BY	DR. BY	CHK. BY	WATER RESOURCES DEVELOPMENT PROJECT PARK RIVER LOCAL PROTECTION POPE PARK PUMPING STATION STRUCTURAL MISCELLANEOUS DETAILS HARTFORD CONNECTICUT		
W.R.	S.D.	W.R.			
SUBMITTER					
NAME, TITLE, SECTION					
APPROVAL RECOMMENDATION			PROF. ENGINEER CHIEF, TECH. ENG. BRANCH  PROF. ENGINEER CHIEF, PROJECT BRANCH		
REVIEWER					
APPROVED					
DATE					
APPROVED AND FORWARDED  CHIEF, PROJECT BRANCH			APPROVED  CHIEF, ENGINEERING DIVISION		
			DRAWING NUMBER PAR - 1		
			SPEC. NO. DACW33-76-B-0040 SHEET 71		