


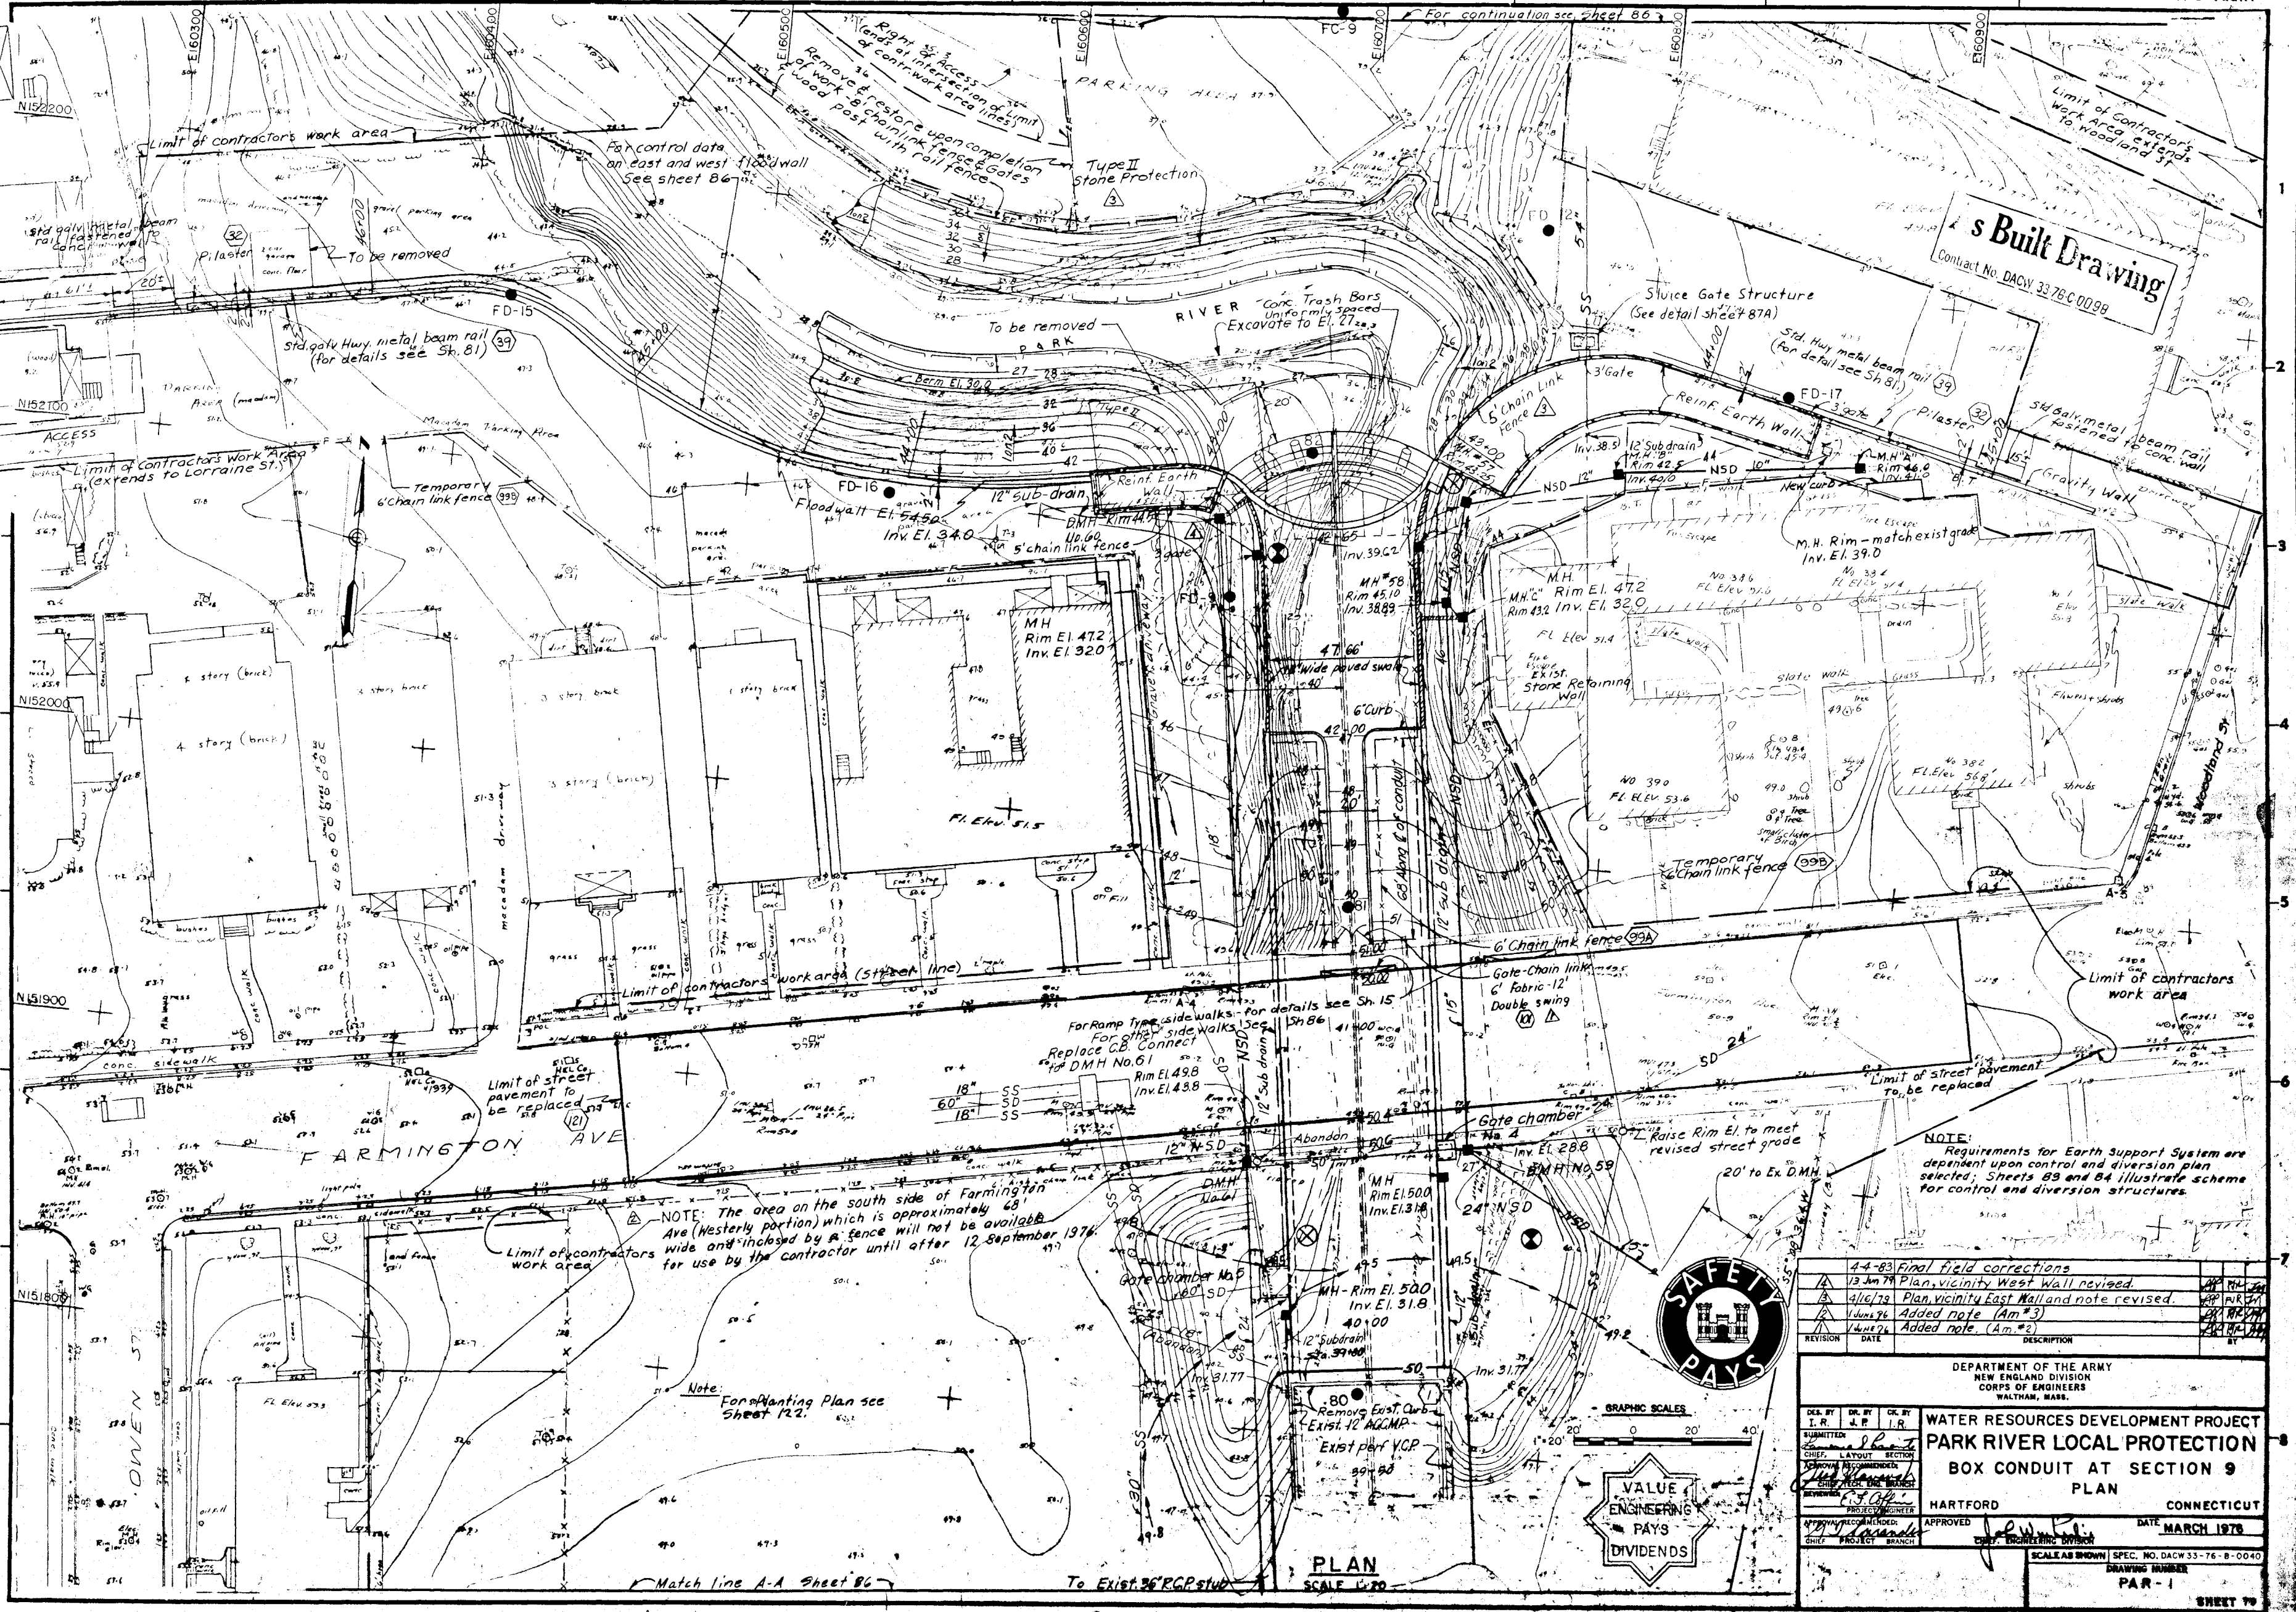

s Built Drawing
Contract No. DACW 33-78-C-0088

NOTE:
Requirements for Earth Support System are dependent upon control and diversion plan selected; Sheets B3 and B4 illustrate scheme for control and diversion structures.

4-4-83 Final field corrections			
REVISION	DATE	DESCRIPTION	BY

DEPARTMENT OF THE ARMY
NEW ENGLAND DIVISION
CORPS OF ENGINEERS
WALTHAM, MASS.

WATER RESOURCES DEVELOPMENT PROJECT
PARK RIVER LOCAL PROTECTION
BOX CONDUIT AT SECTION 9
PLAN

HARTFORD	CONNECTICUT
APPROVED <i>[Signature]</i>	DATE <u>MARCH 1976</u>

SCALE AS SHOWN SPEC. NO. DACW 33-76-B-0040
DRAWING NUMBER
PAR-1
SHEET 70