
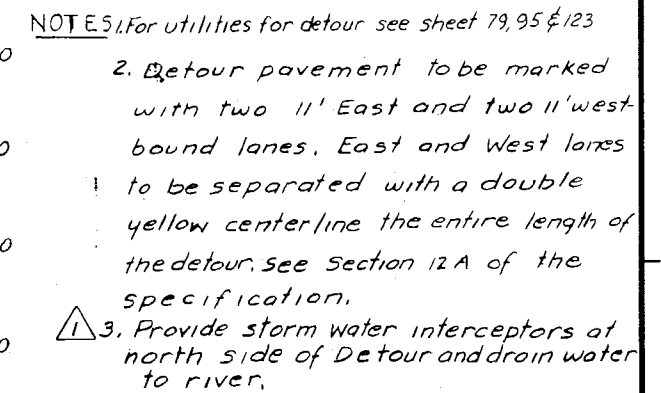


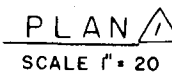

Contract No. DACW 33-76-C-0098

[illegible]