


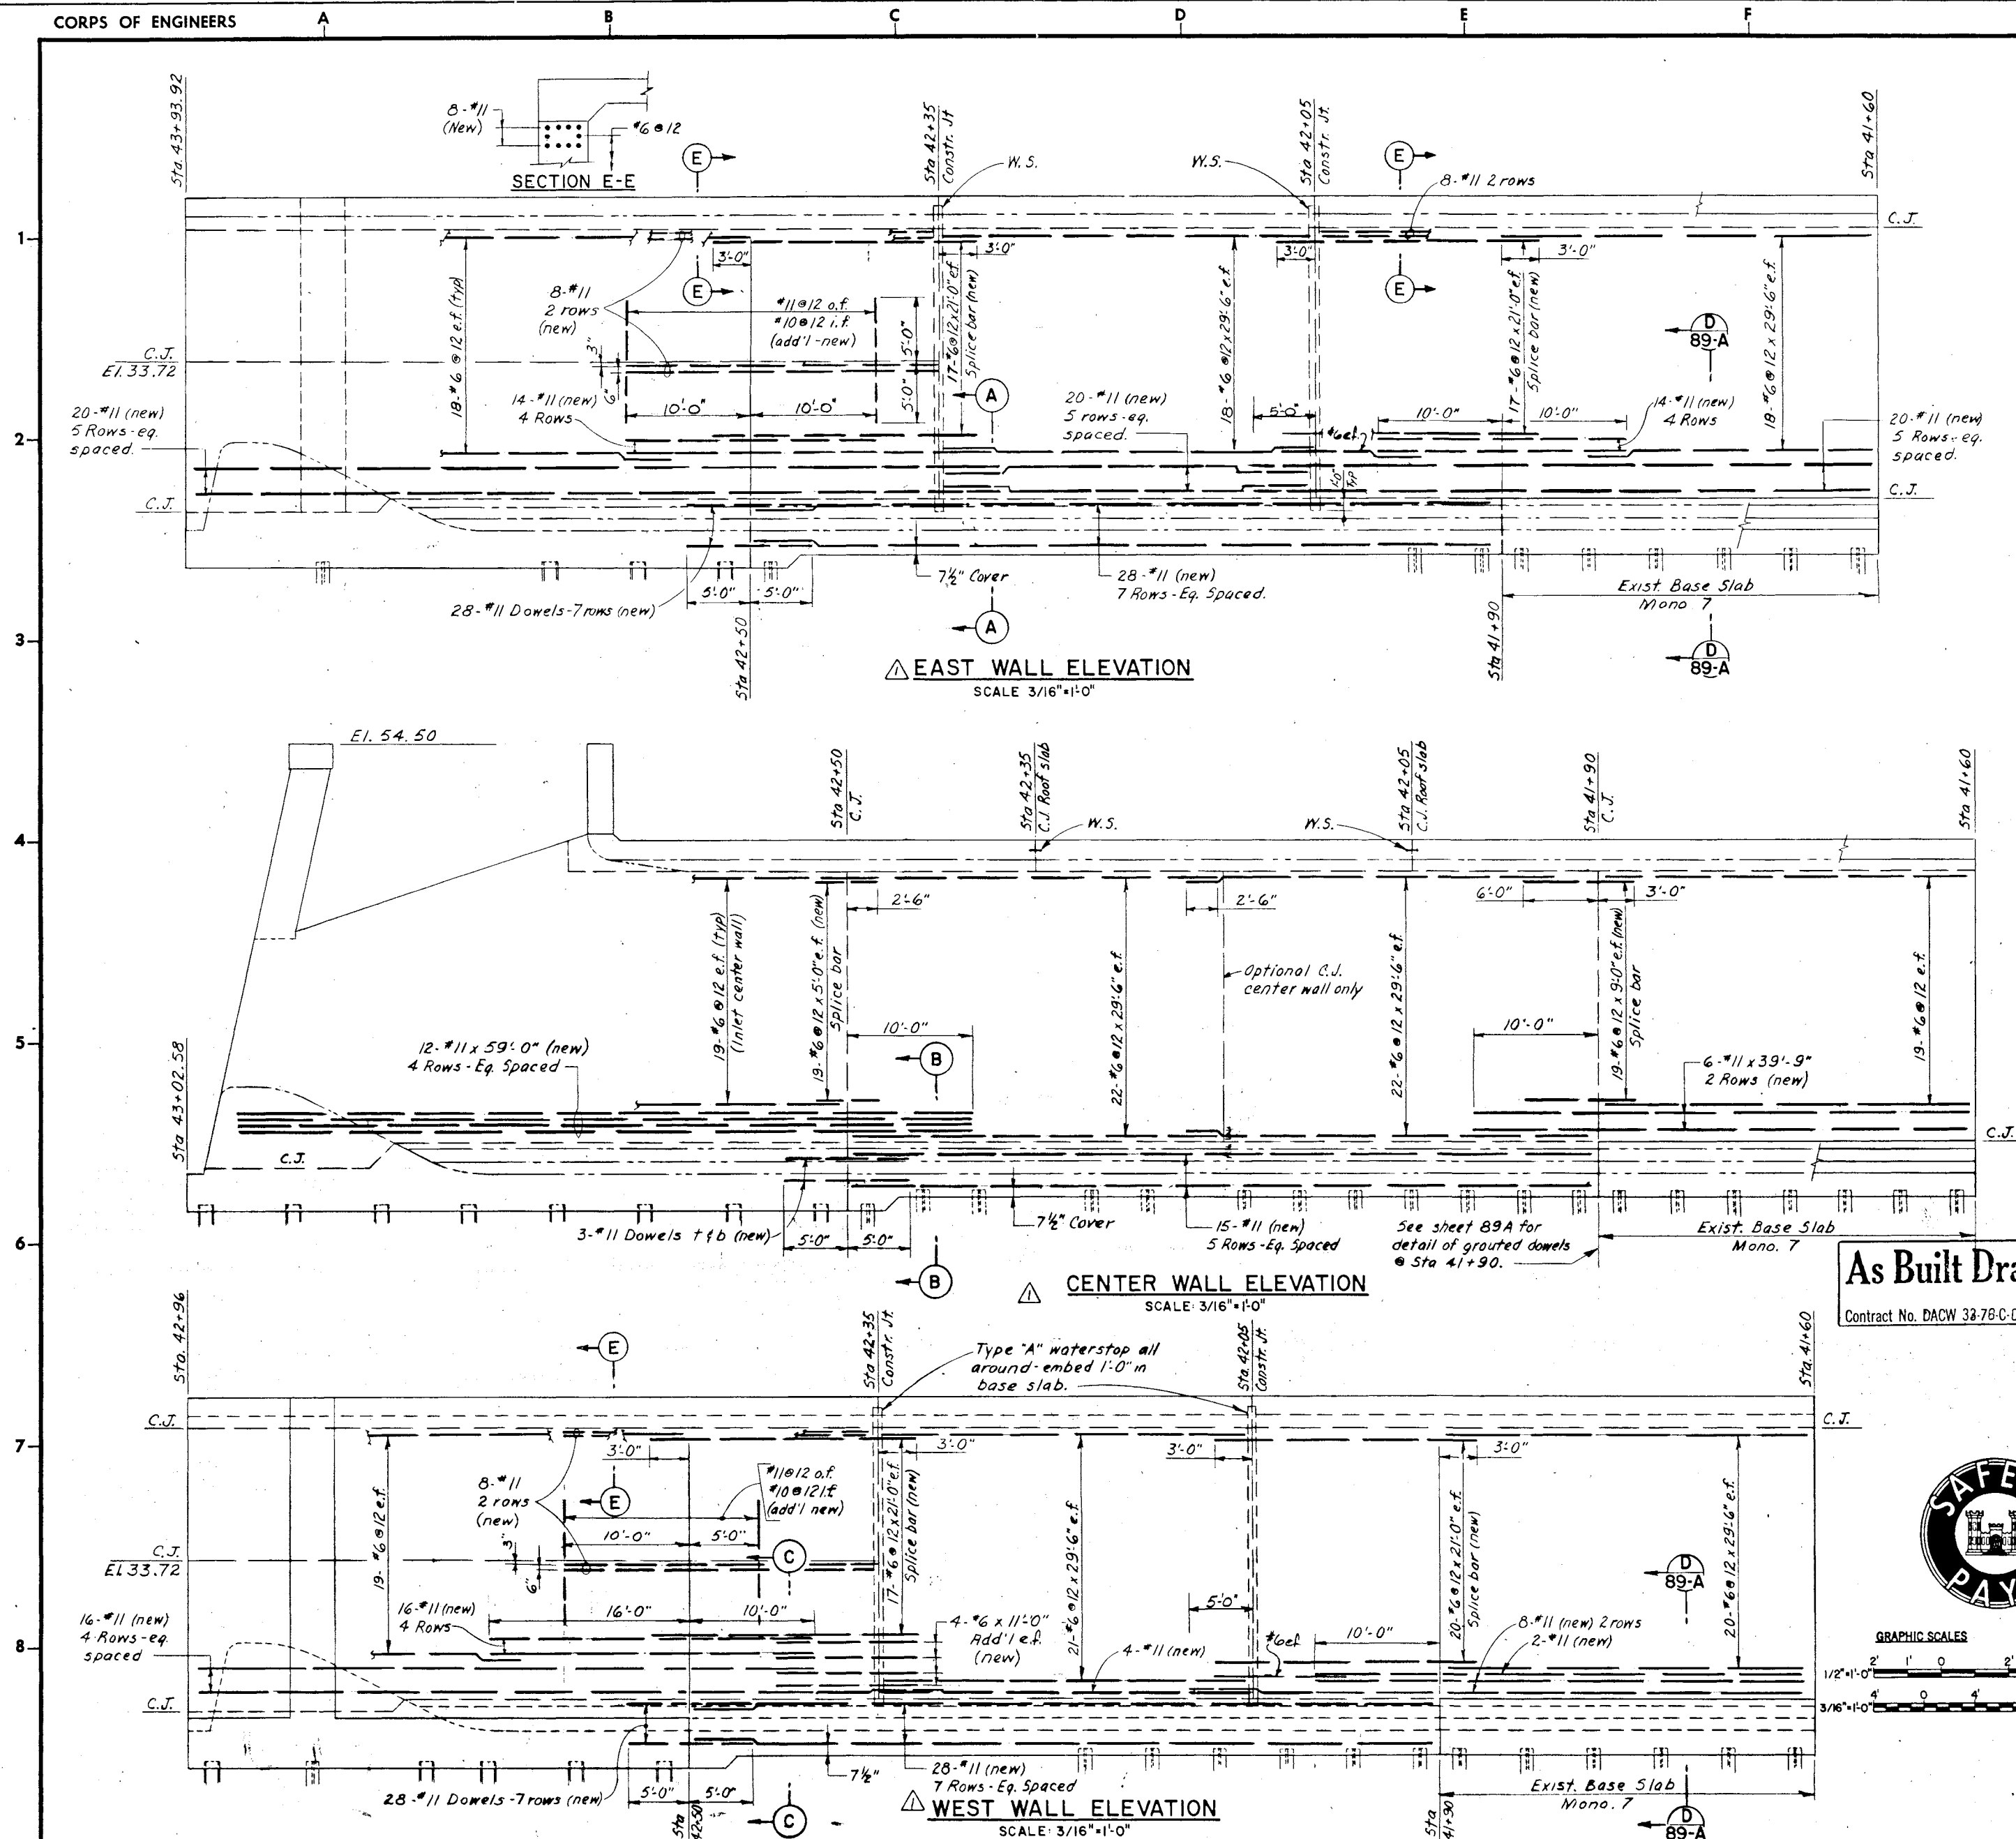

REVISION	DATE	DESCRIPTION	BY
1	9/8/79	Revised due to construction procedure	W. J. L.

DEPARTMENT OF THE ARMY
NEW ENGLAND DIVISION
CORPS OF ENGINEERS
WALTHAM, MASS.

**WATER RESOURCES DEVELOPMENT PROJECT
PARK RIVER LOCAL PROTECTION**

**INLET STRUCTURE
PART PLAN AND REINFORCEMENT DETAILS**

HARTFORD CONNECTICUT
DATE JAN 1979

SCALE: AS SHOWN | SPEC. NO. DACW 33-78-B-0040
DRAWING NUMBER
PAR - I
SHEET 89B