


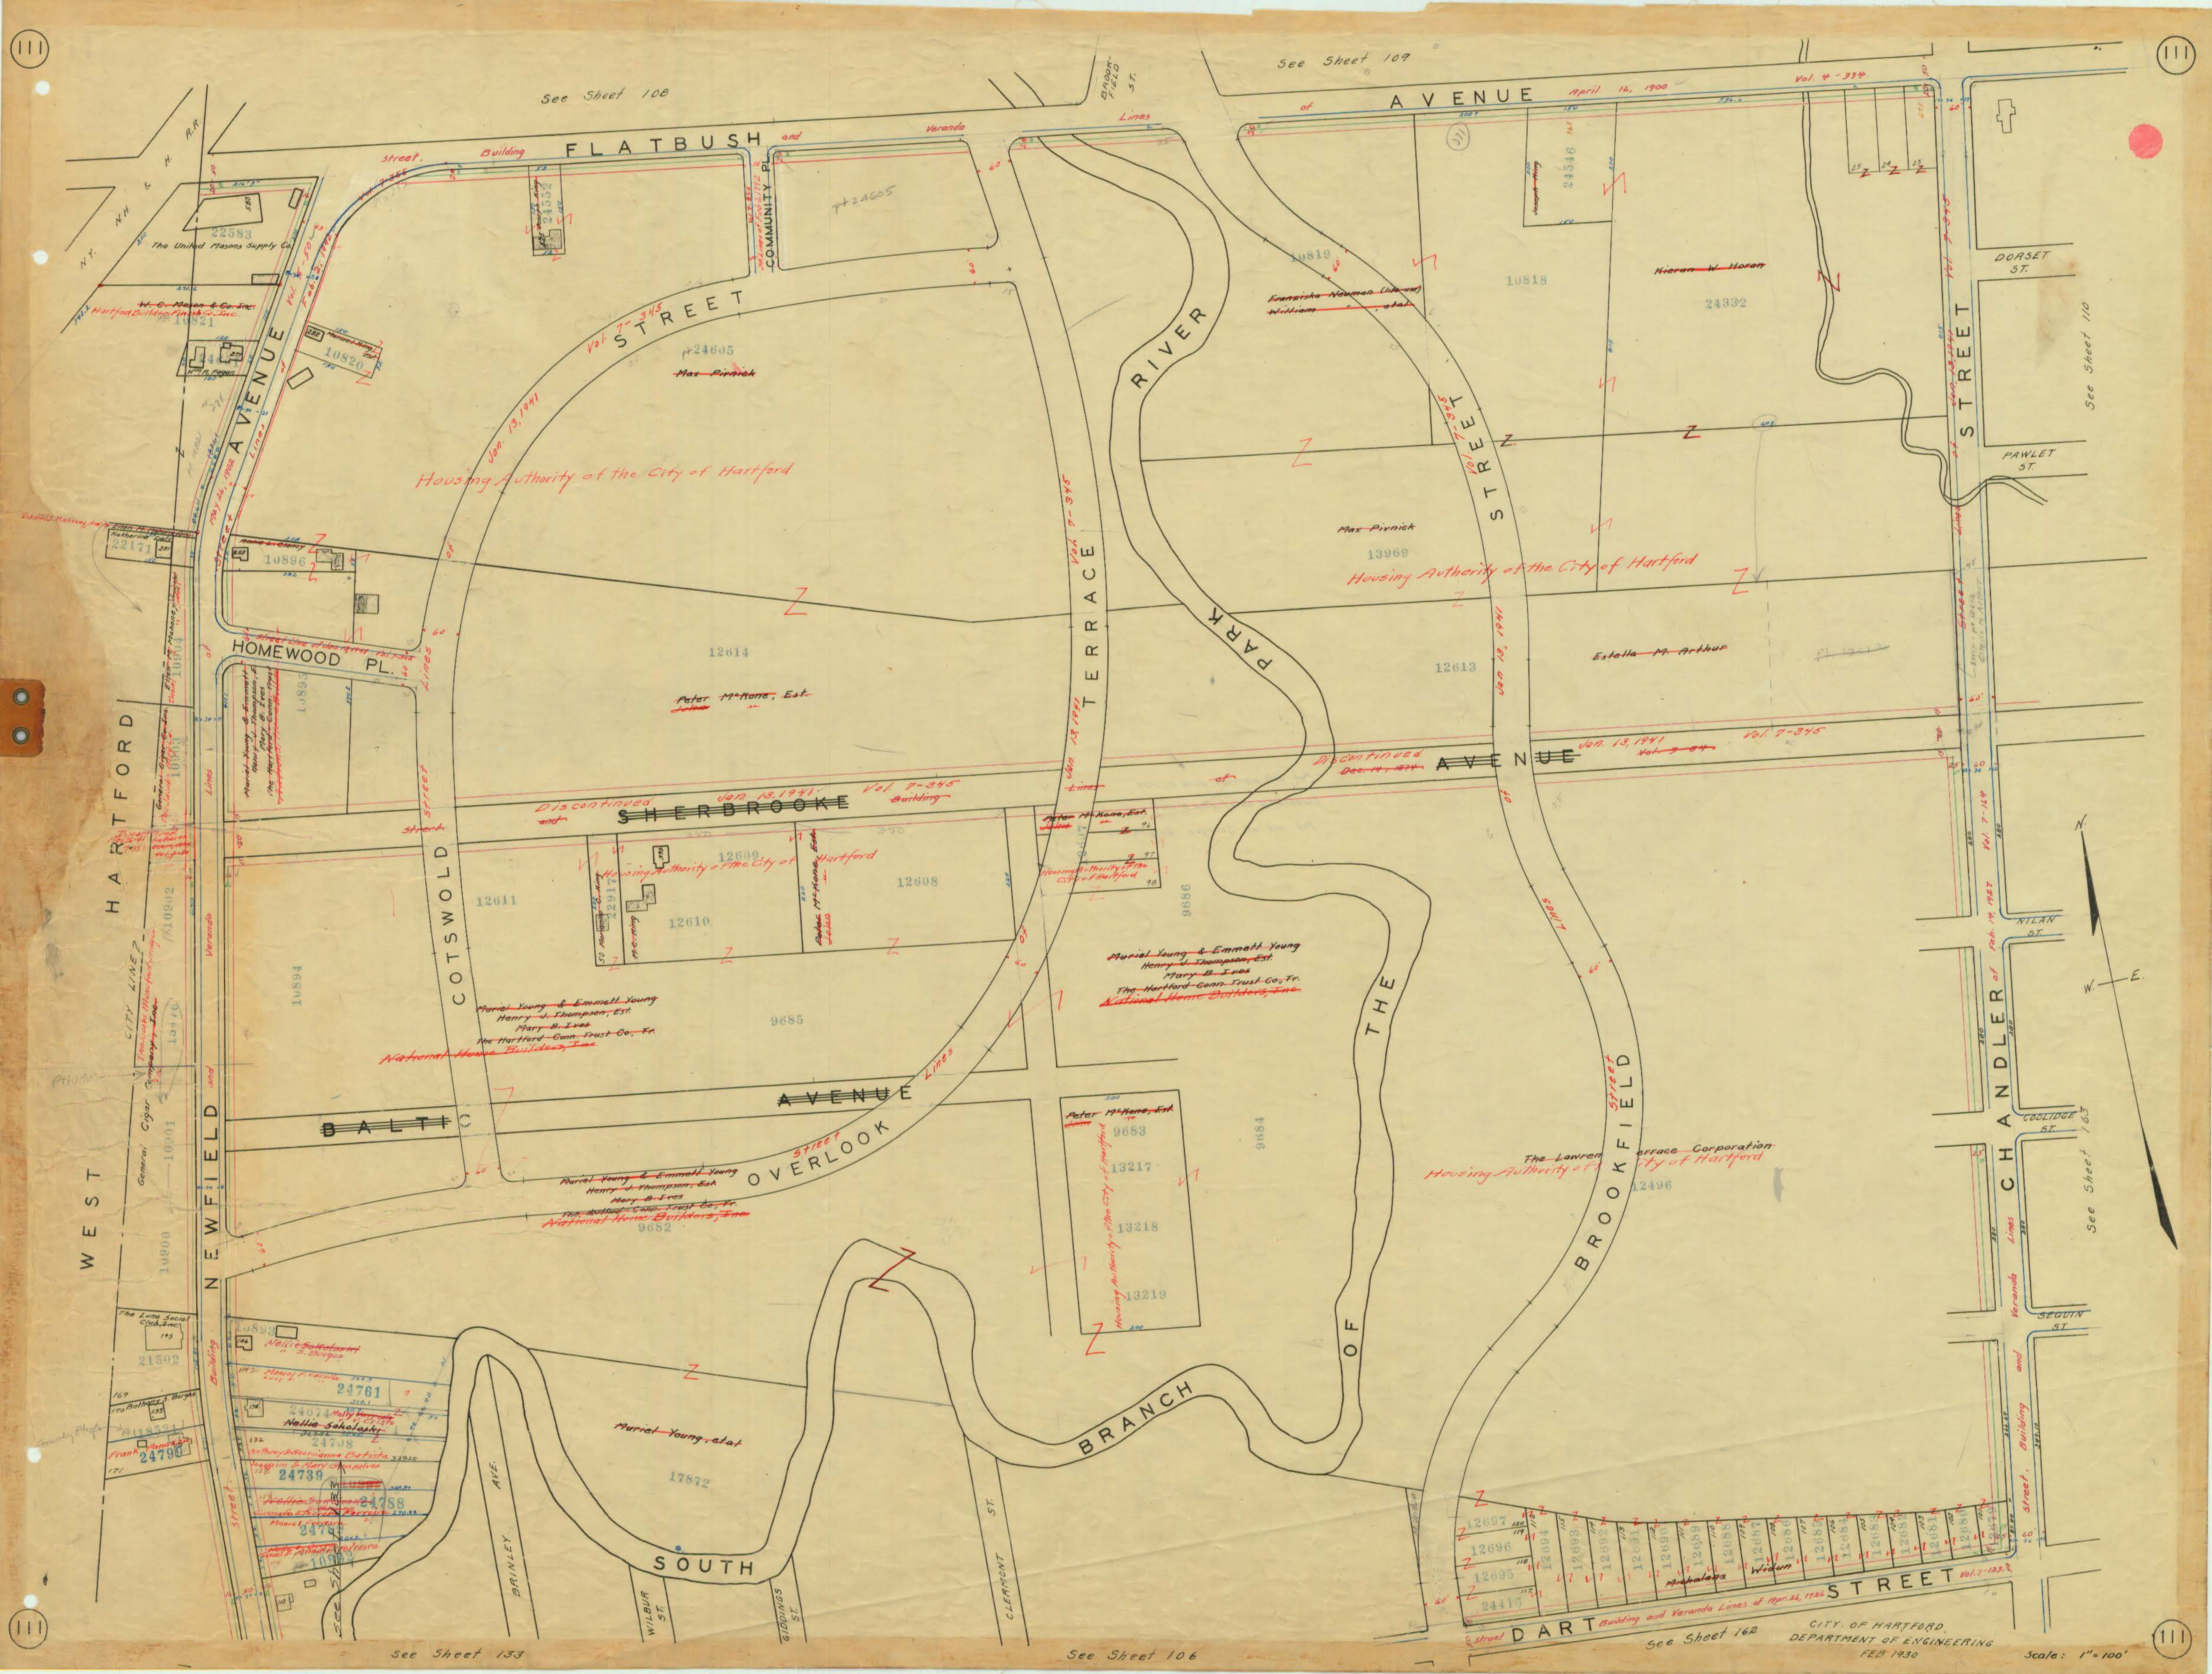

See Sheet 108

See Sheet 109

See Sheet 110

See Sheet 163

See Sheet 133

See Sheet 106

See Sheet 162

CITY OF HARTFORD
DEPARTMENT OF ENGINEERING
FEB 1930

Scale: 1"=100'